


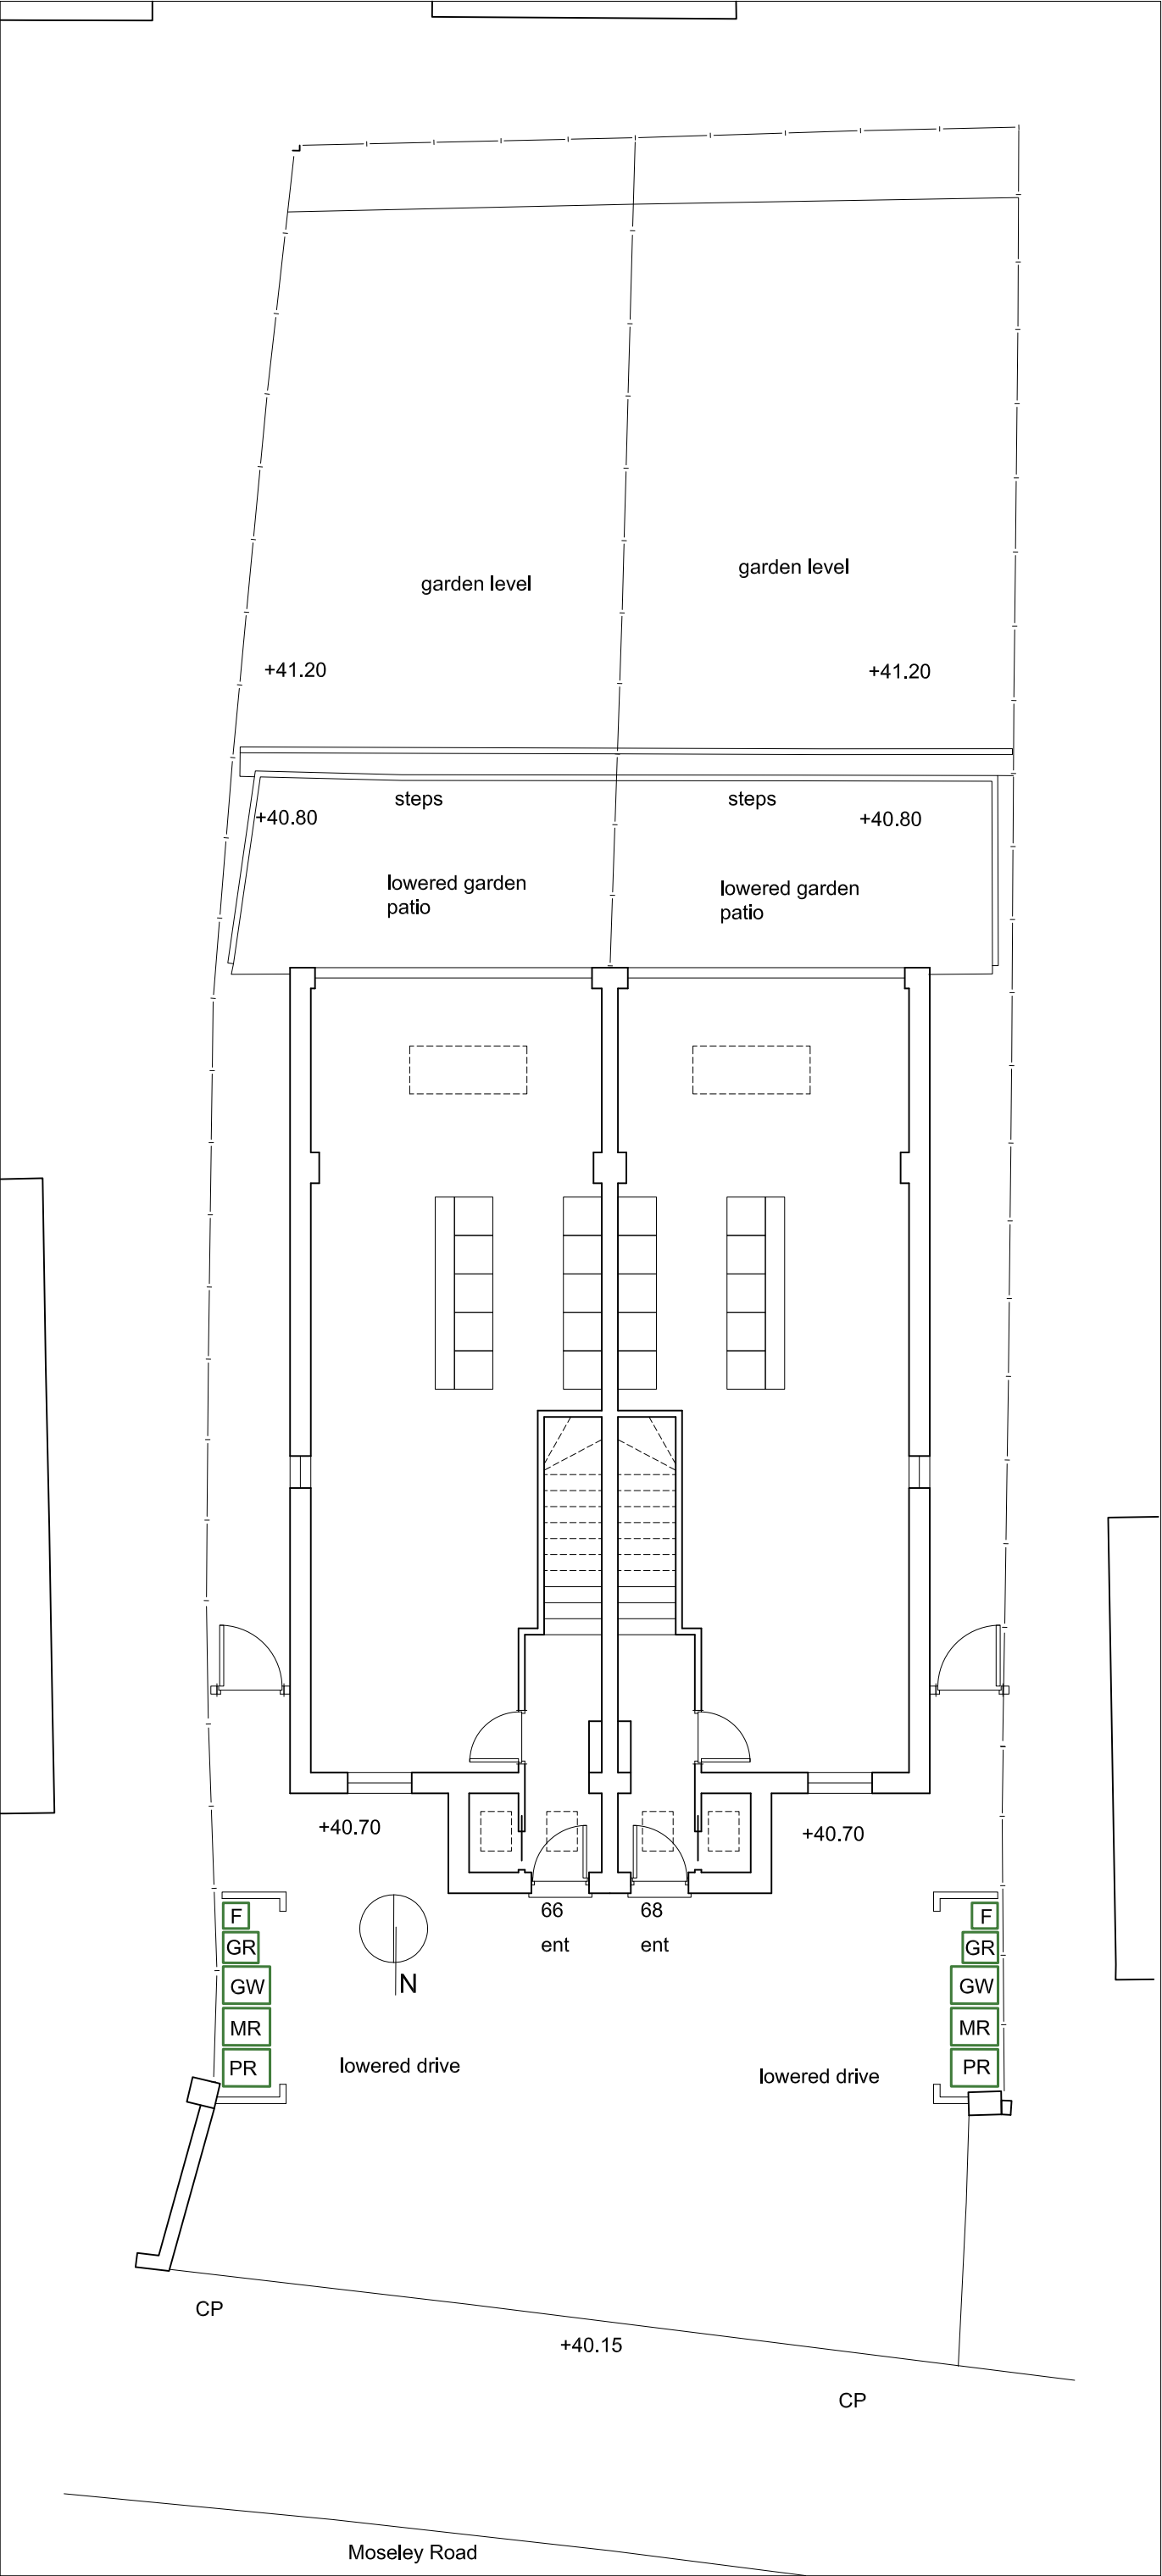

KEY		
F	Food Waste	23 Litres
GW	Garden Waste	240 Litres
GR	General Refuse	140 Litres
MR	Mixed Recycling	240 Litres
PR	Pulpable Recycling	240 Litres
CP	Collection Point	

PROJECT			66 & 68 Moseley rd, Fallowfield.	
SCALE	1 : 200 @ A2		CLIENT	AIRSHACK LTD
DWG No.	169-SK-GL1 - Rev A		DRAWING TITLE	As built Site plan
CONTRACT NO.	STAGE CODE	REV.	sj simon james architect	
169	sketch	-		
ISSUED	20/07/24	-		
	01/11/24	a		