




1 Proposed Ground Floor
1 : 50

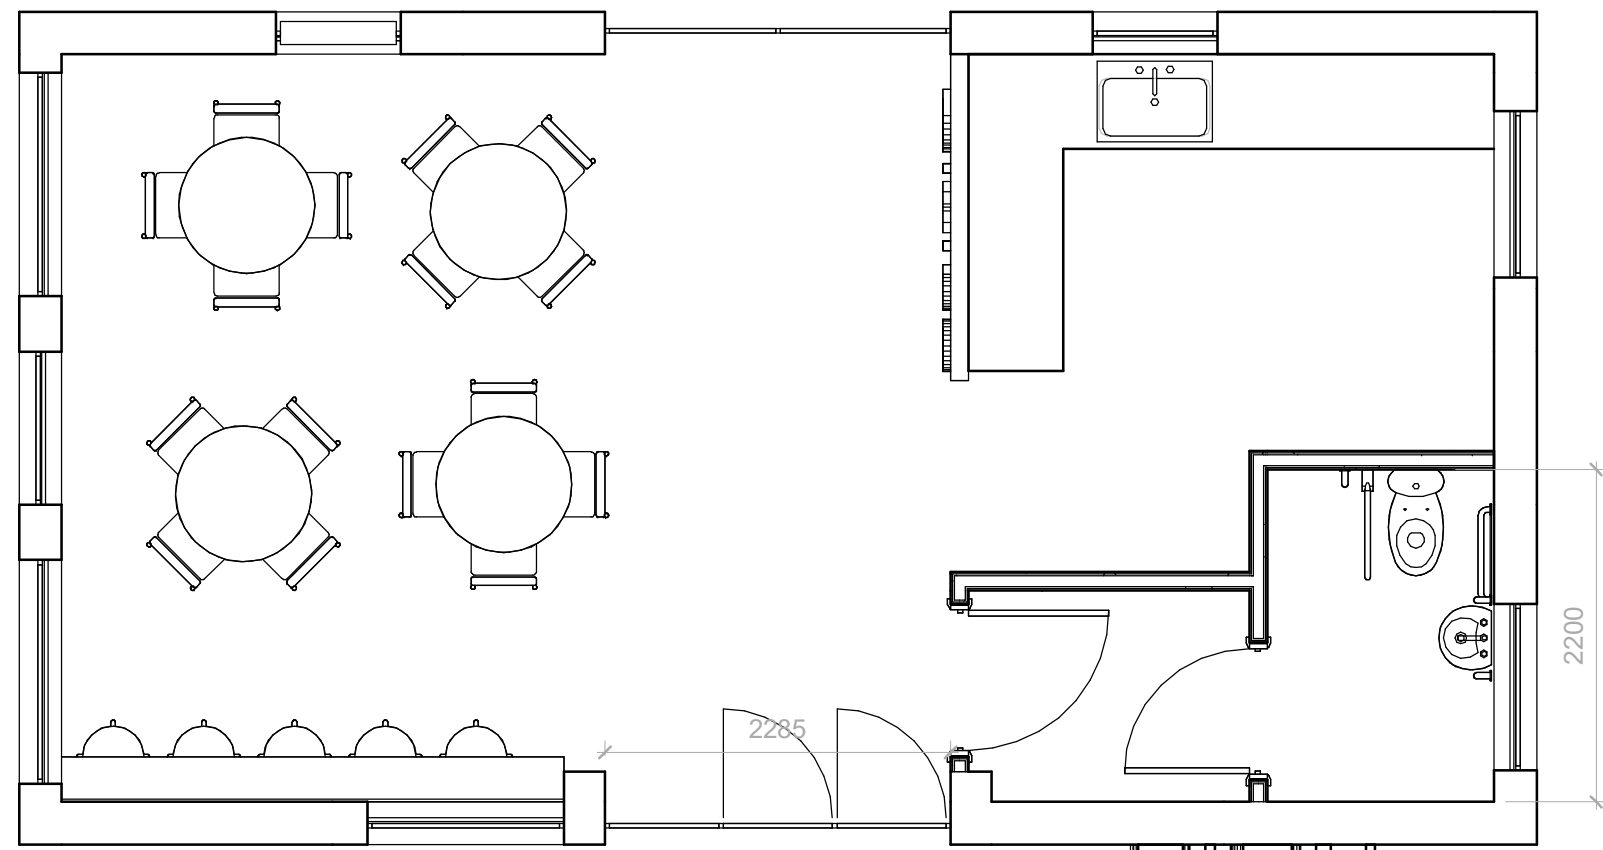


Container bar

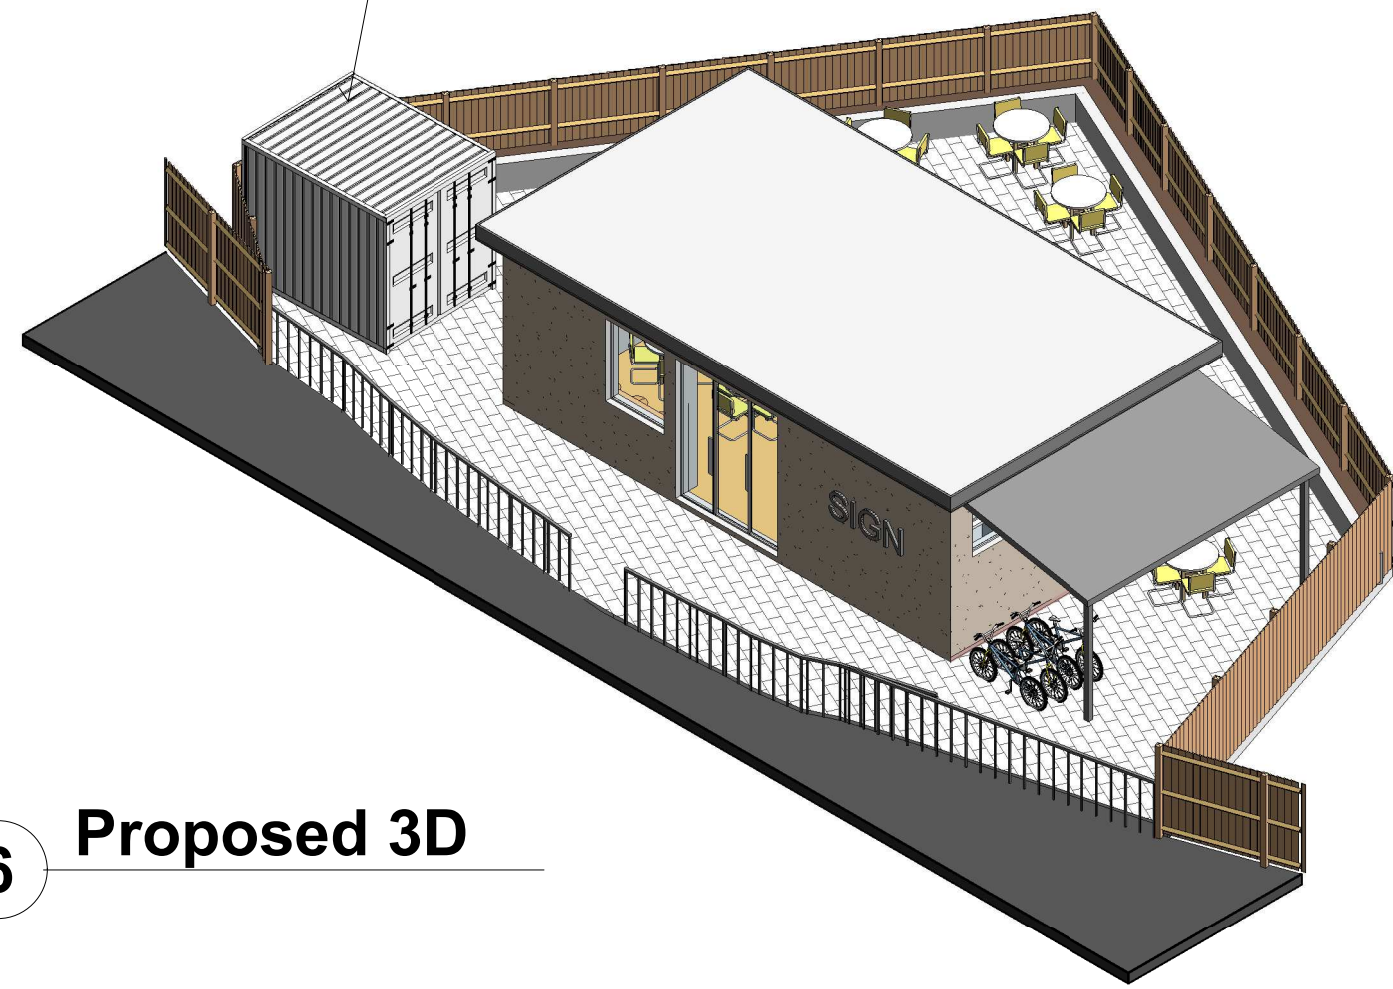

6 Proposed 3D

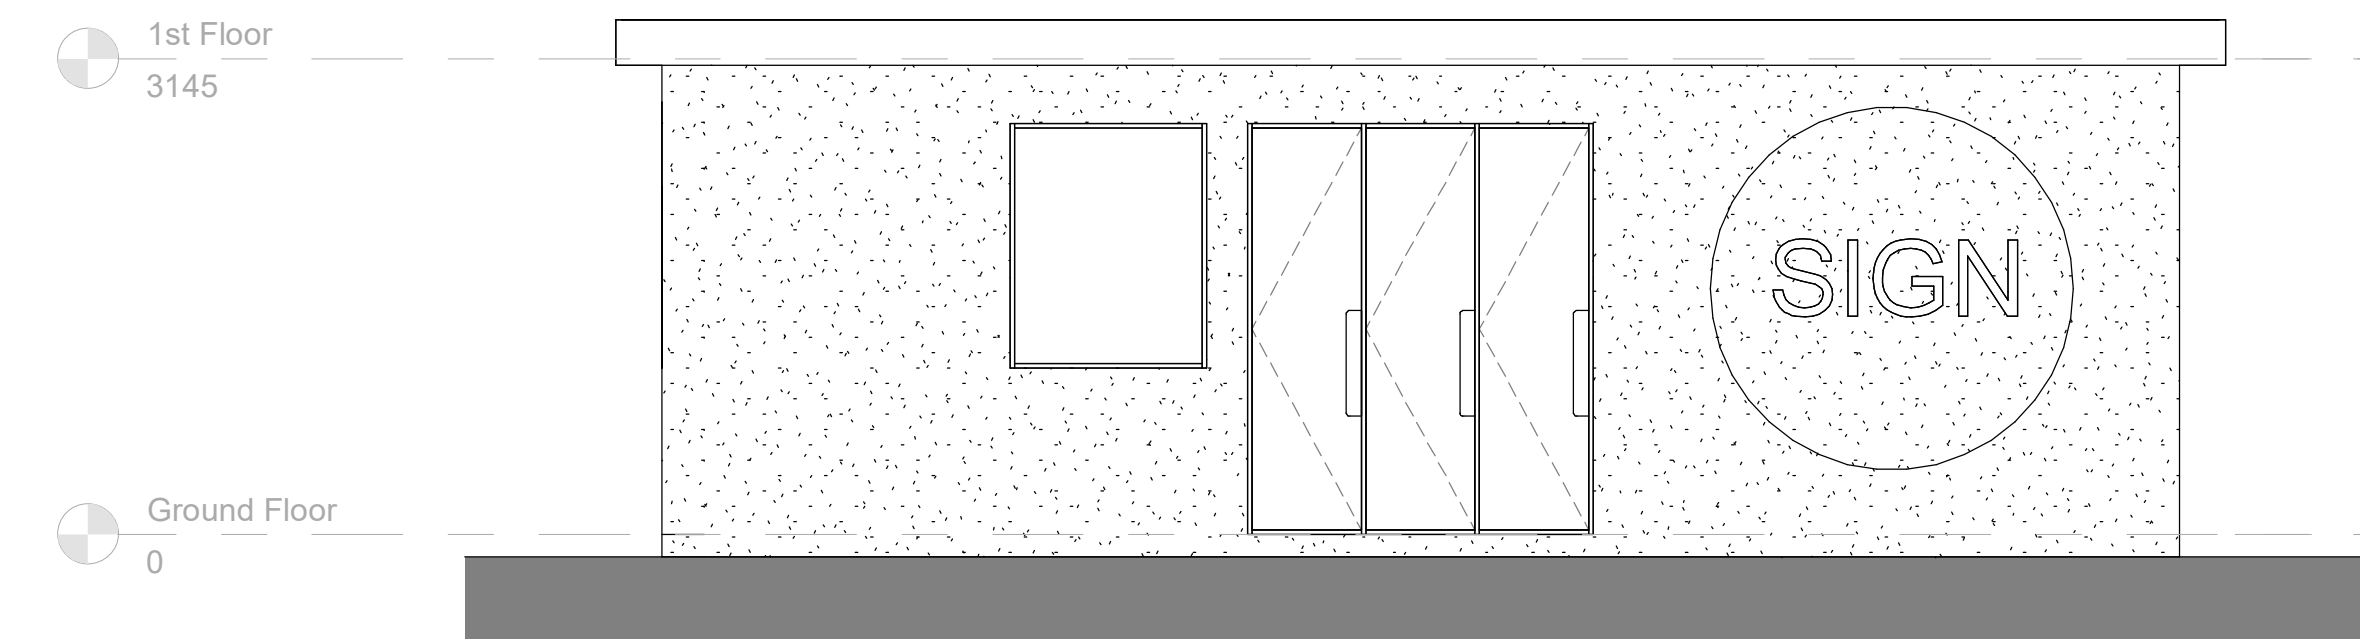

2 Proposed Front Elevation
1 : 50

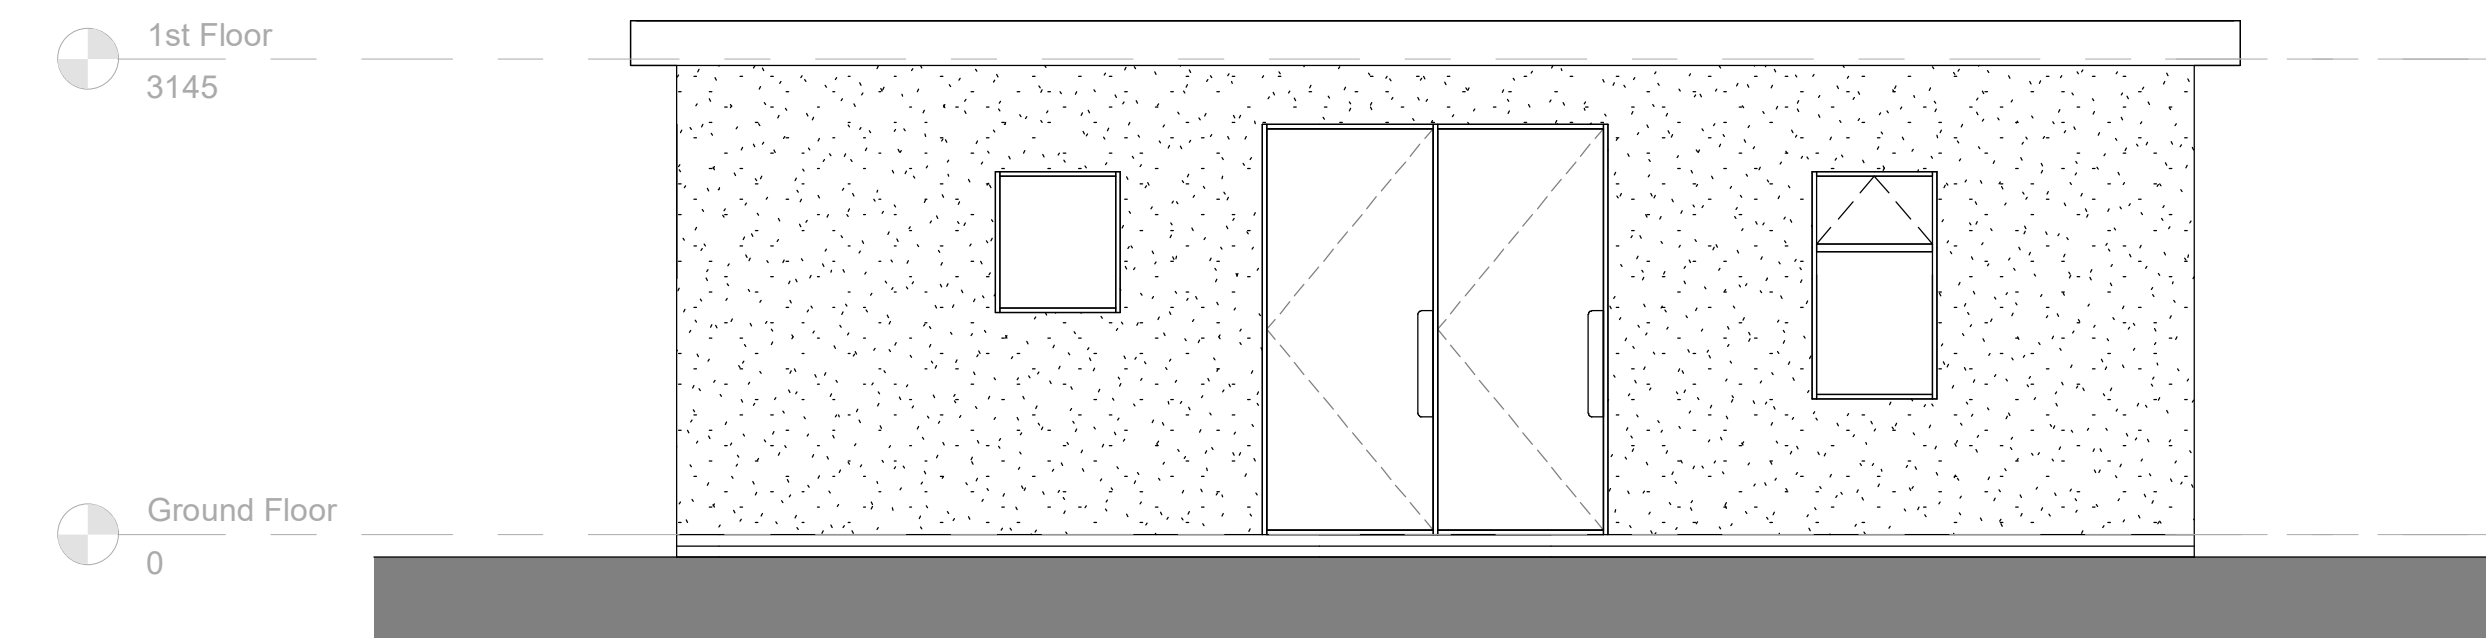


4 Proposed Rear Elevation
1 : 50




Location for parked vehicles
to be just after the double
yellow lines

proposed waiting for
delivery

3 Proposed LHS Elevation
1 : 50

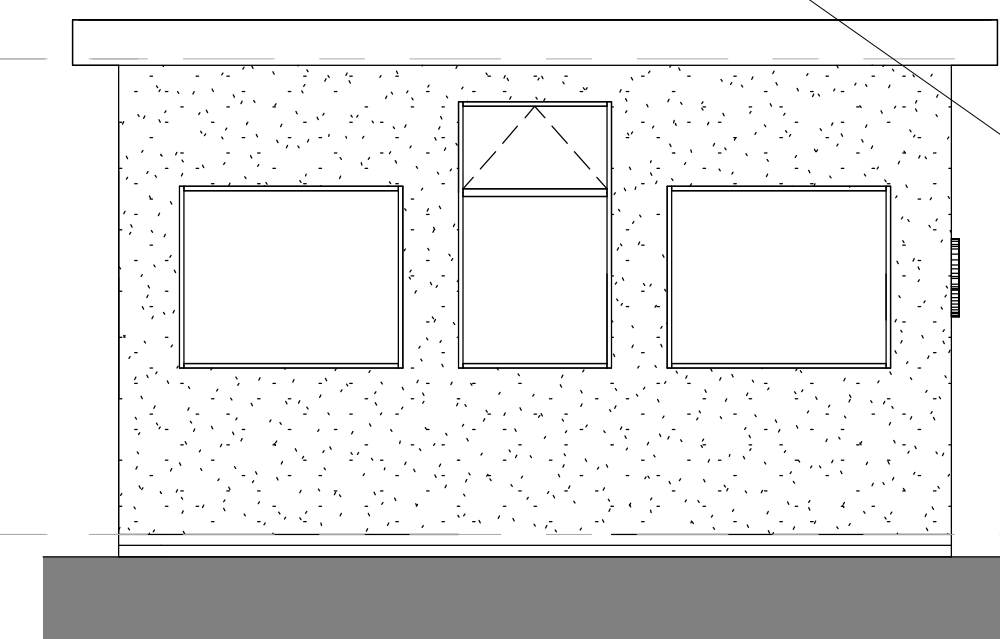

5 Proposed RHS Elevation
1 : 50

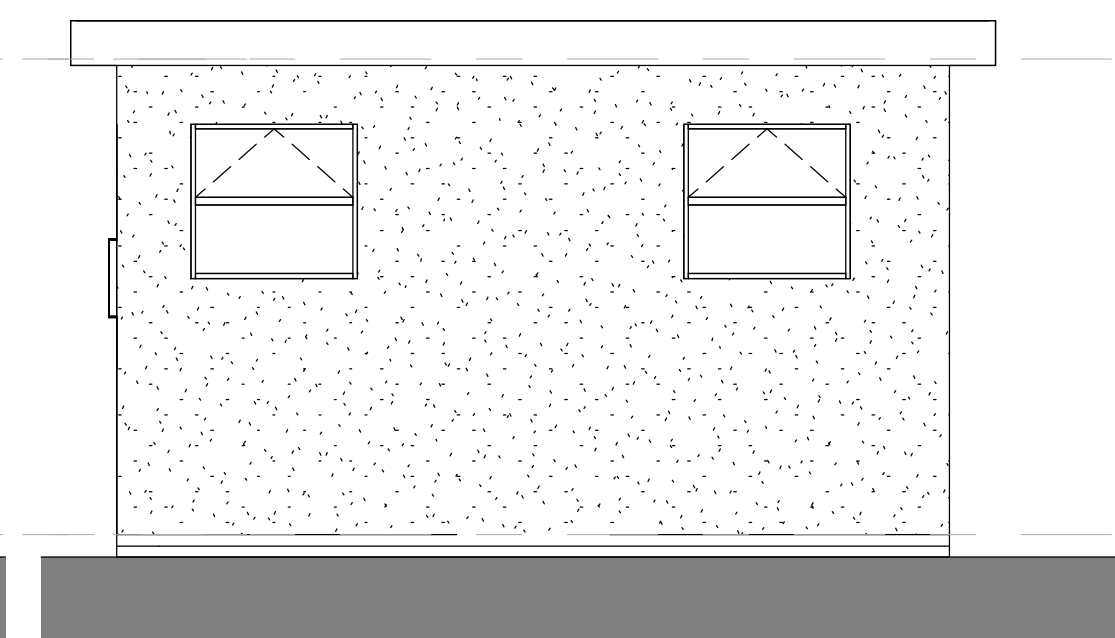

7 Proposed Site Plan
1 : 200

NOTES


ALL DIMENSIONS AND LEVELS ARE TO BE CHECKED ON SITE

ANY DISCREPANCIES ARE TO BE REPORTED TO THE PROJECT MANAGER BEFORE ANY WORK COMMENCES

THIS DRAWING SHALL NOT BE SCALED TO ASCERTAIN ANY DIMENSIONS WORK TO FIGURED DIMS ONLY

THIS DRAWING SHALL NOT BE REPRODUCED WITHOUT EXPRESS WRITTEN PERMISSION FROM Clarkes Bespoke Design LTD.

Container bar

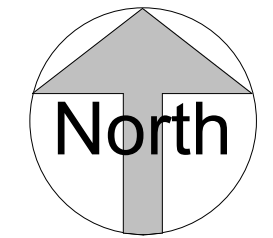

Raised Planters from sleepers

Bike Store

Bin Store


AB4	02.09.24	BC	ELEVATIONS UPDATED AS BUILT
AB3	01.01.24	BC	updated junction added
AB2	11.05.23	BC	Bin collection location added
AB1	01.12.22	BC	updated as built
P3	01.02.20	BC	Security Shutters added
P2	10.12.19	BC	External seating and bike store added
P1	11.11.19	BC	First Issue

Rev No.	Rev Date	Rev By	Description
---------	----------	--------	-------------

project
Divine


location
Corner Alexandra Road/
Withington Road
Brooks Bar
Manchester M15 5PQ

client
Mr Costello / Mrs Torpey

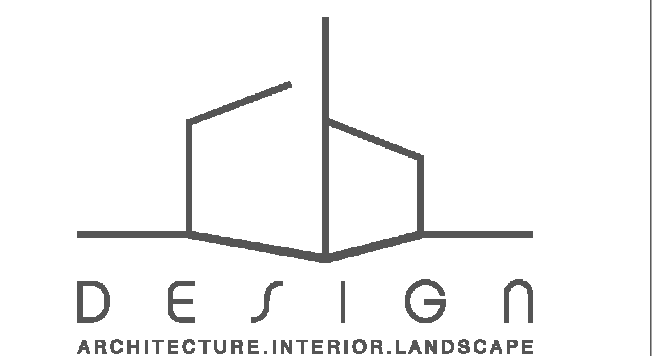

T: 07402264305 E: growing@clarkesdesign.co.uk
www.clarkesdesign.co.uk

As Proposed Plans - Elevations
and Site plan

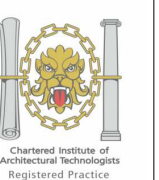

dwg purpose

scale	As indicated	drawn	BC	checked	BC
@ sheet size	A1	rev date	02.09.24		
19-073		PL-002		AB4	
job number		drawing number		revision	