



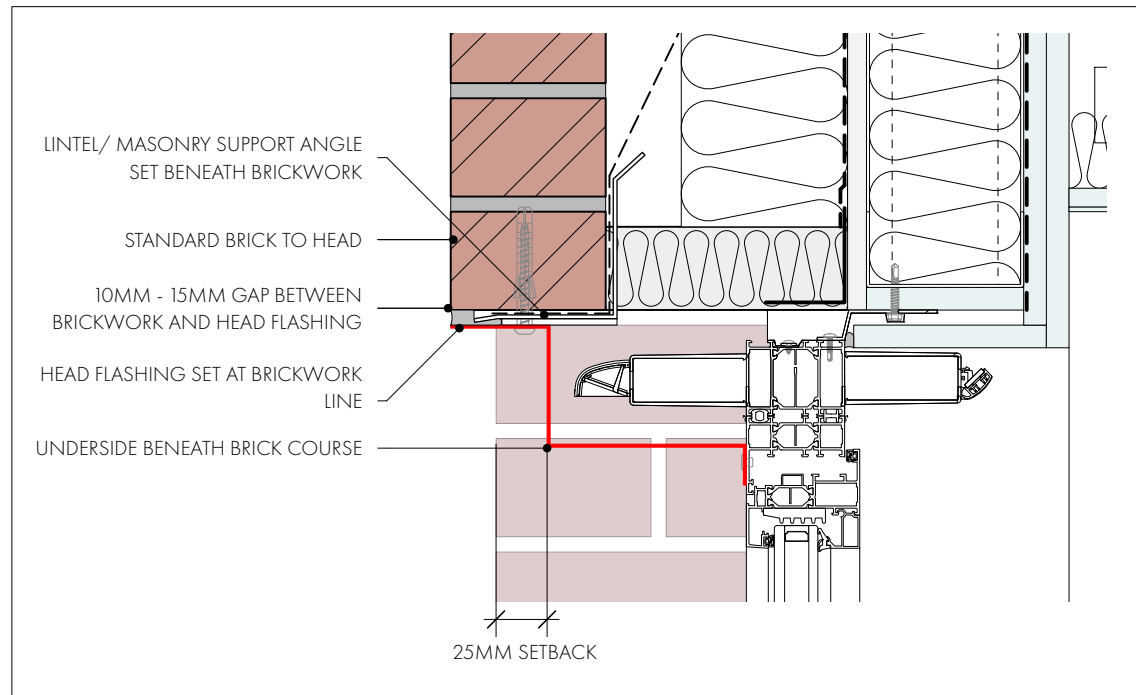

AS BUILT_TRICKLE VENT FLASHING DETAIL
1:10@A3

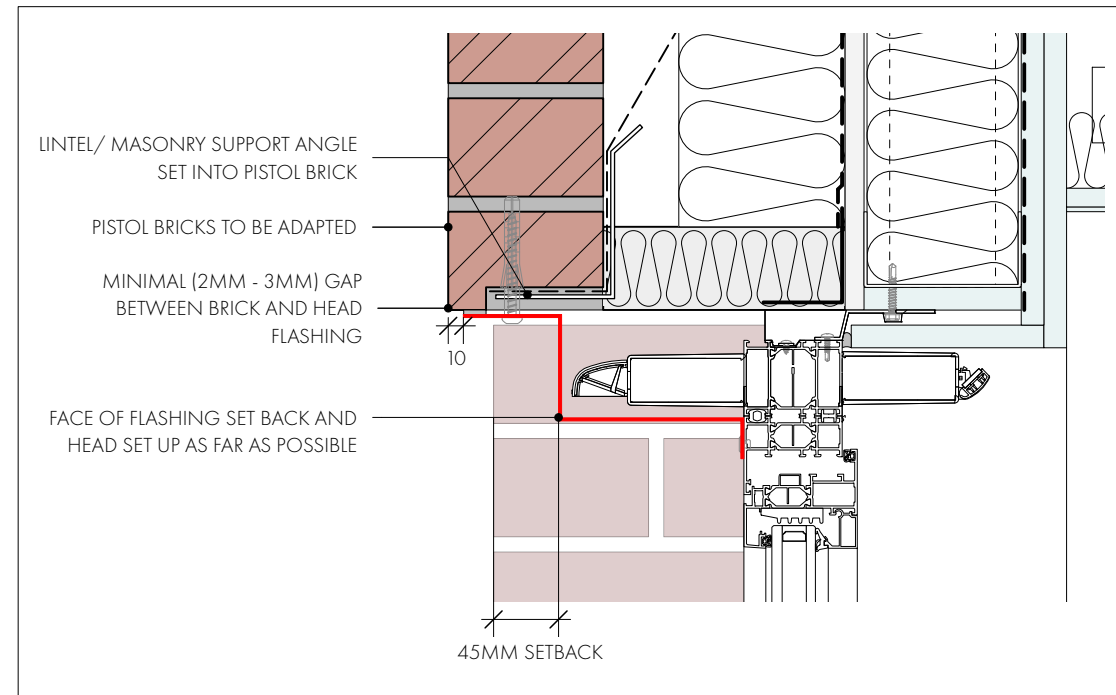

PROPOSED_TRICKLE VENT FLASHING DETAIL
1:10@A3



AS BUILT_TRICKLE VENT FLASHING MOCKUP (SITE PHOTO)



PROPOSED_TRICKLE VENT FLASHING MOCKUP (PHOTO MONTAGE)

OMIArchitects

www.omiarchitects.com

LAYSTALL STREET – NEW BUILD APARTMENTS

TRICKLE VENT COVER

1383 | SK001 | MAY' 22 | 1:25 @A3