


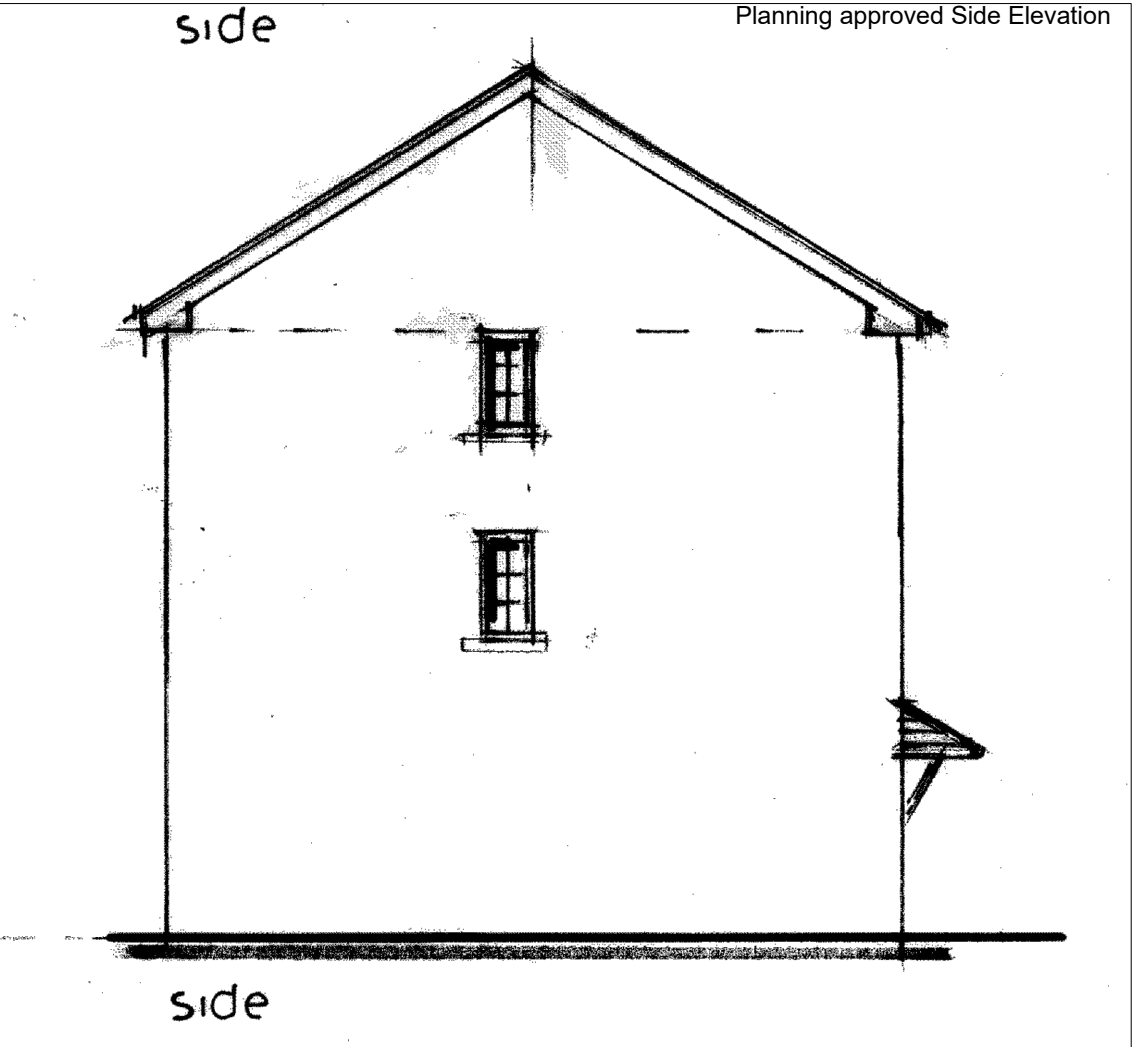
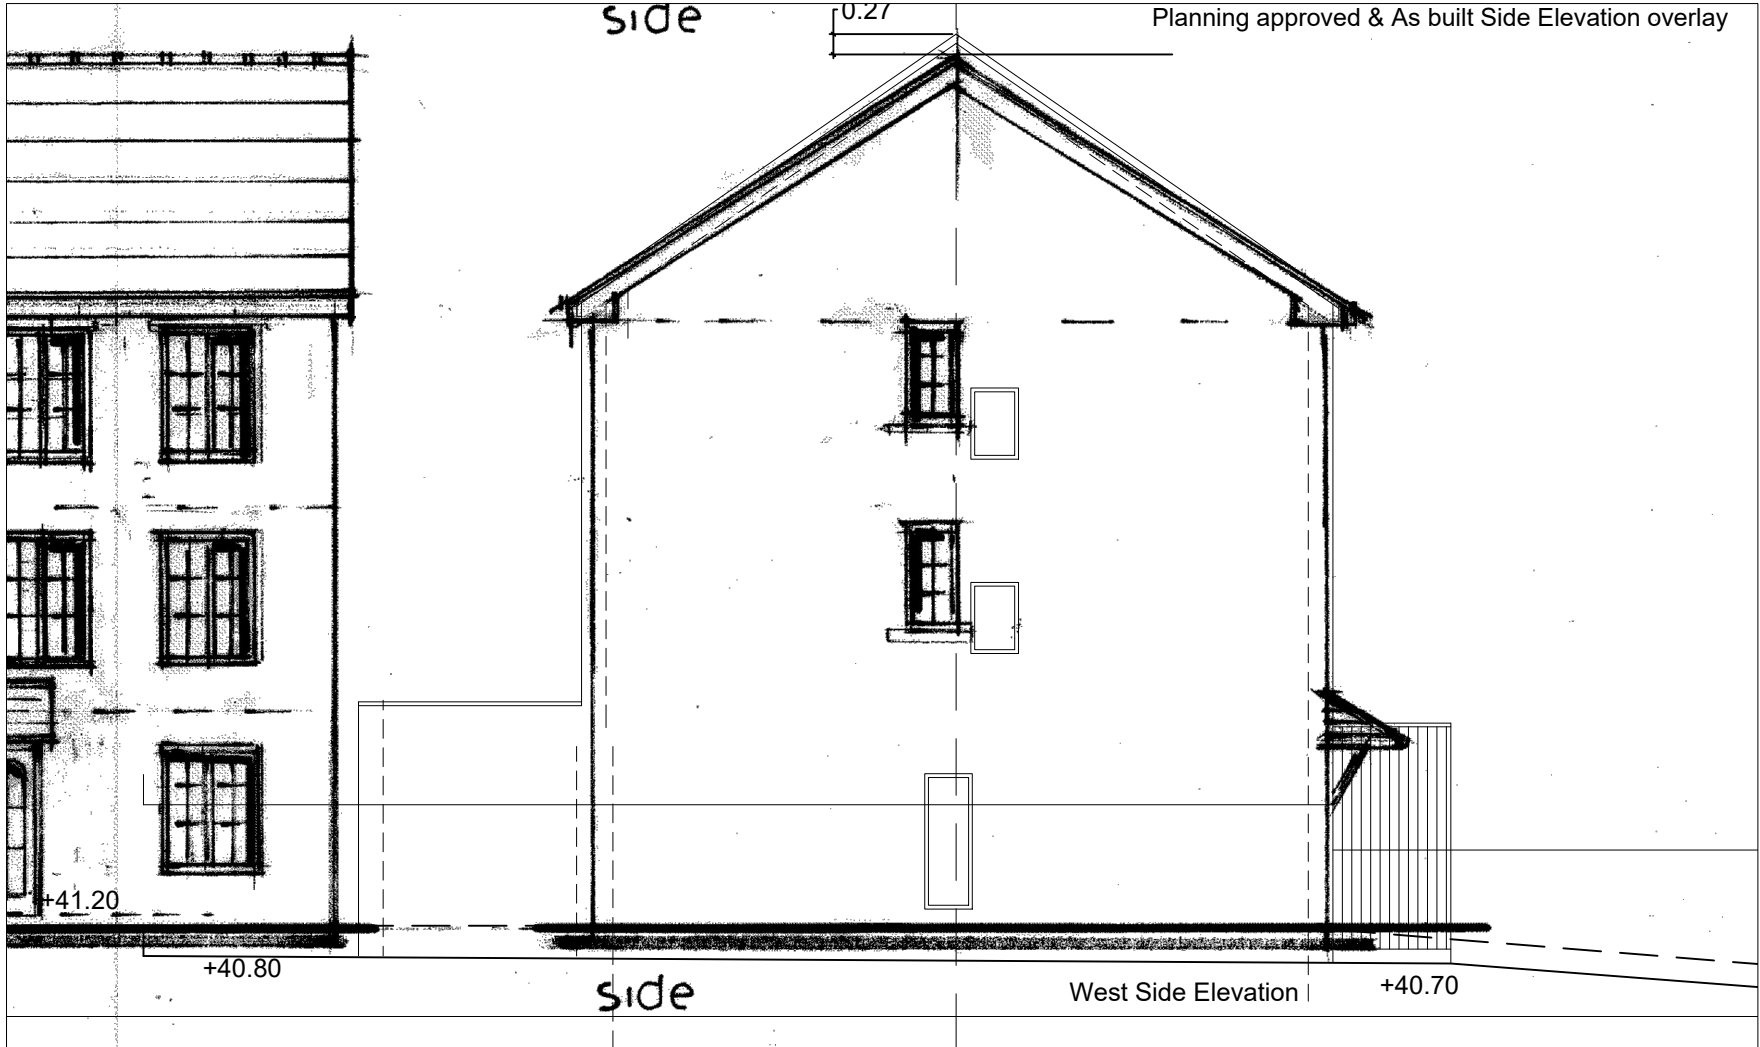


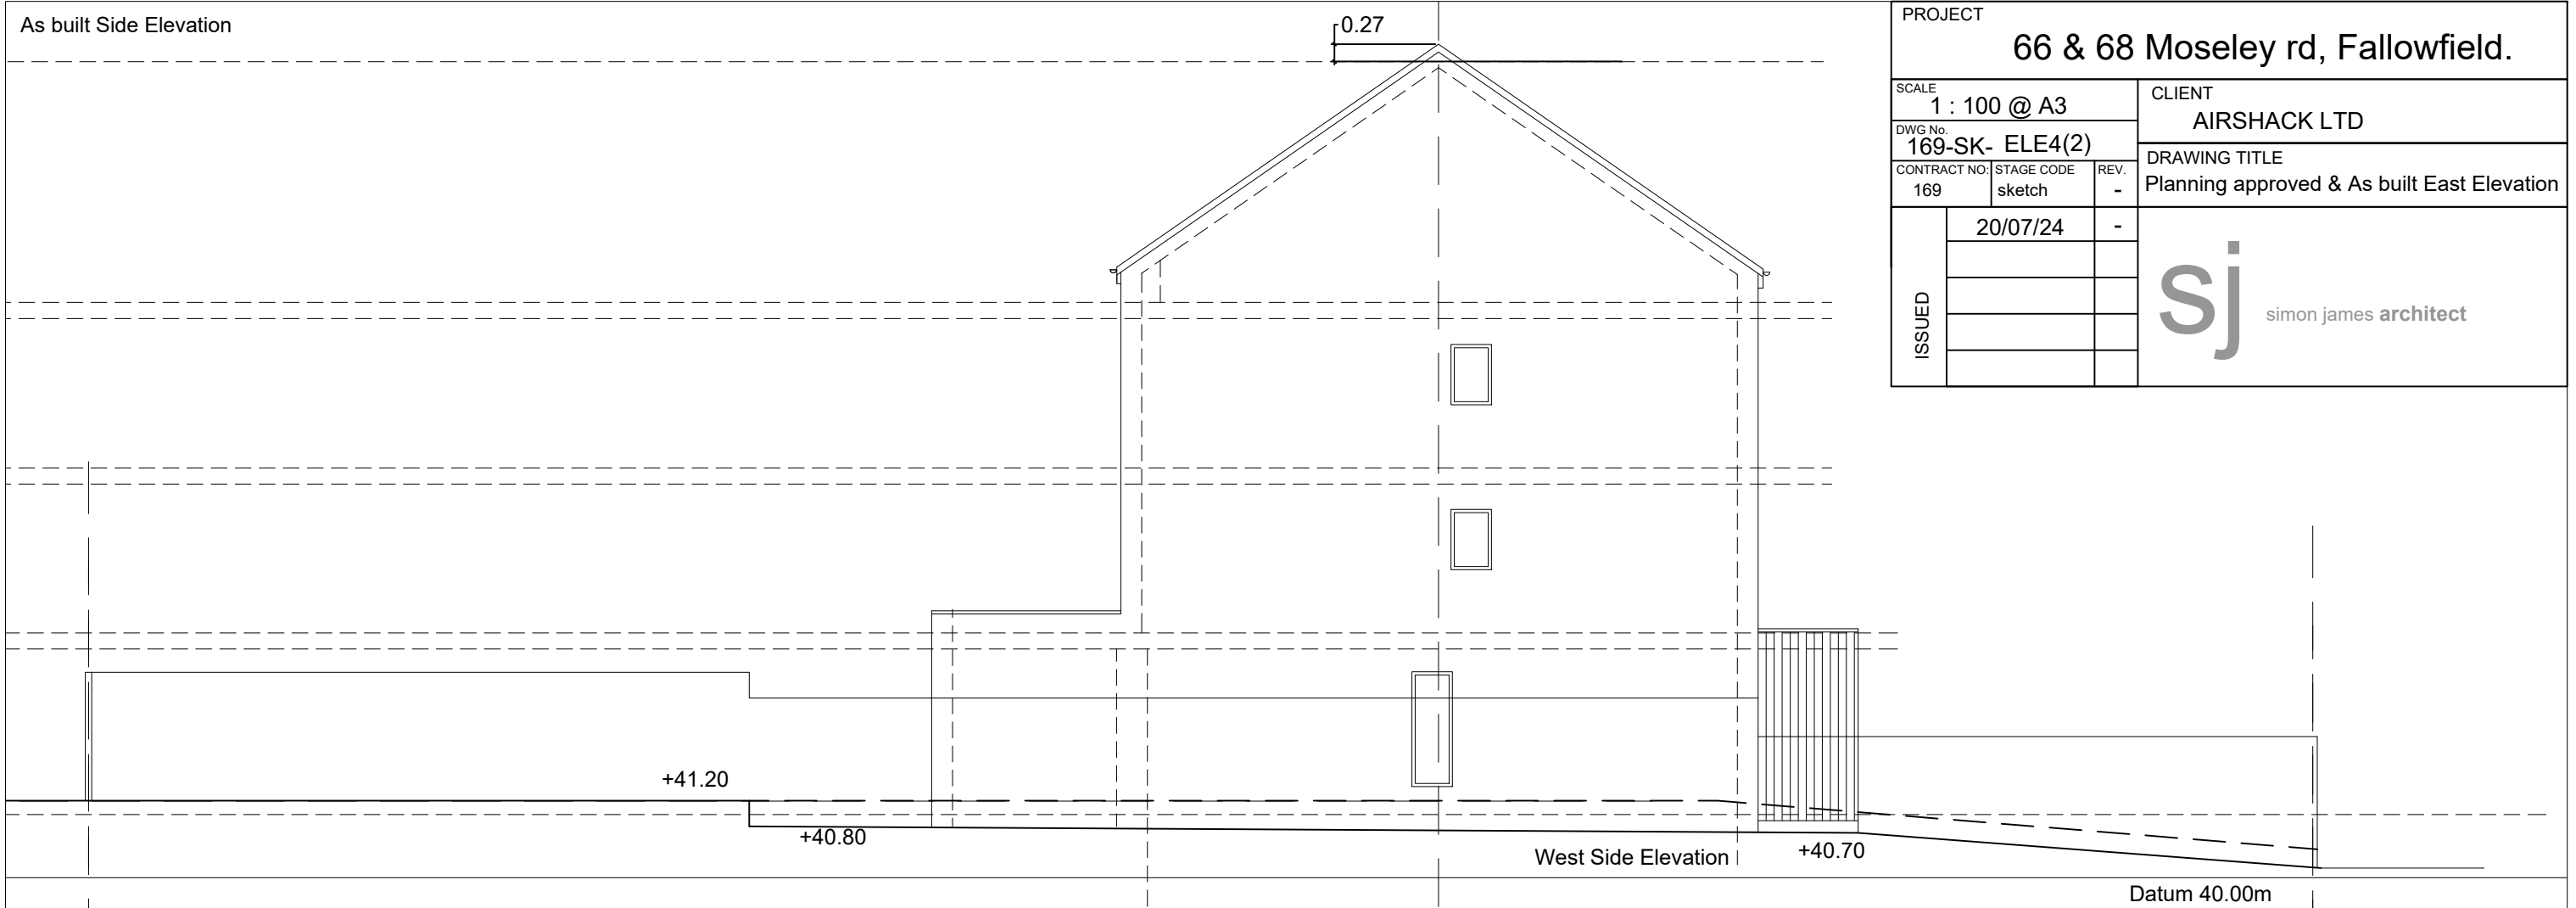


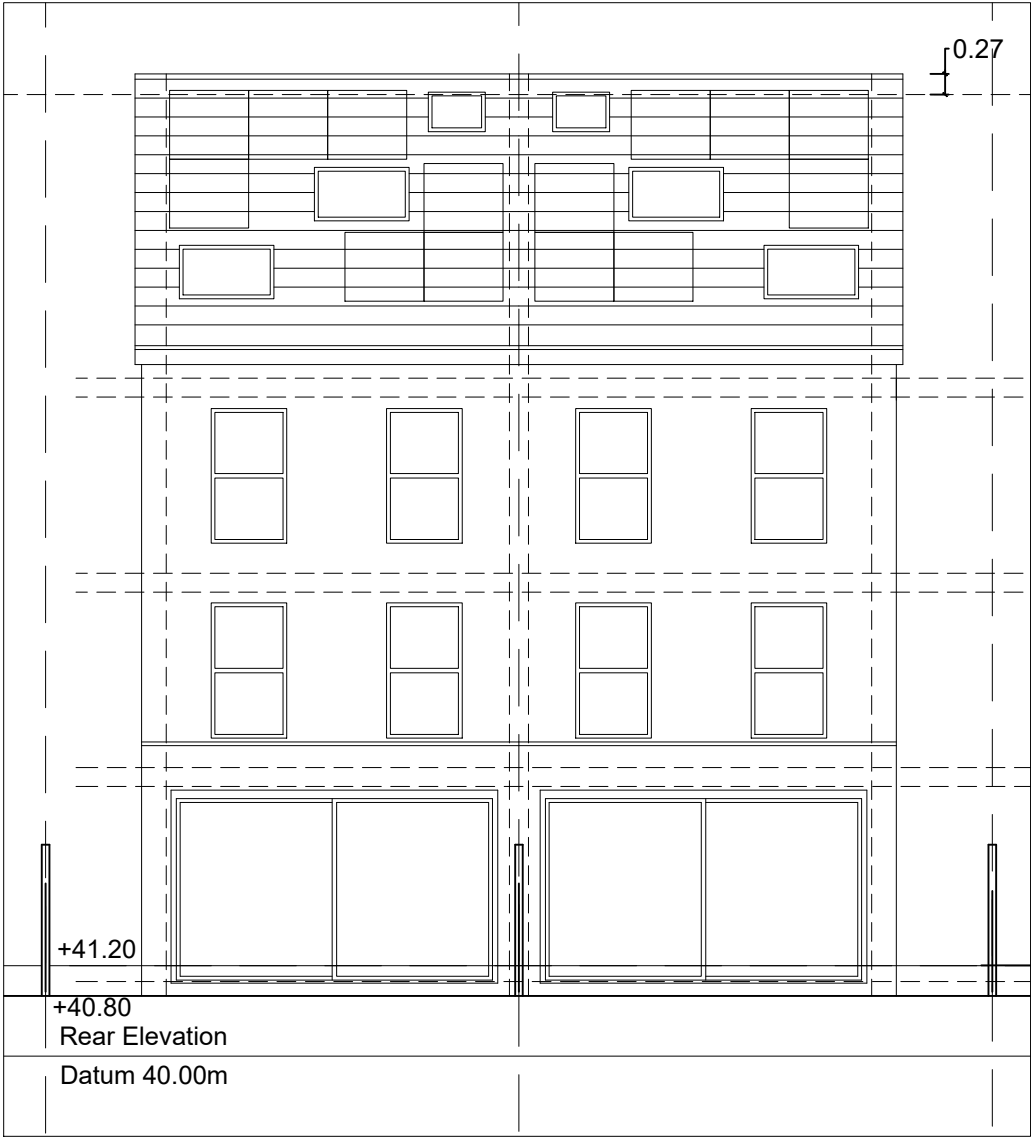

As built Rear Elevation

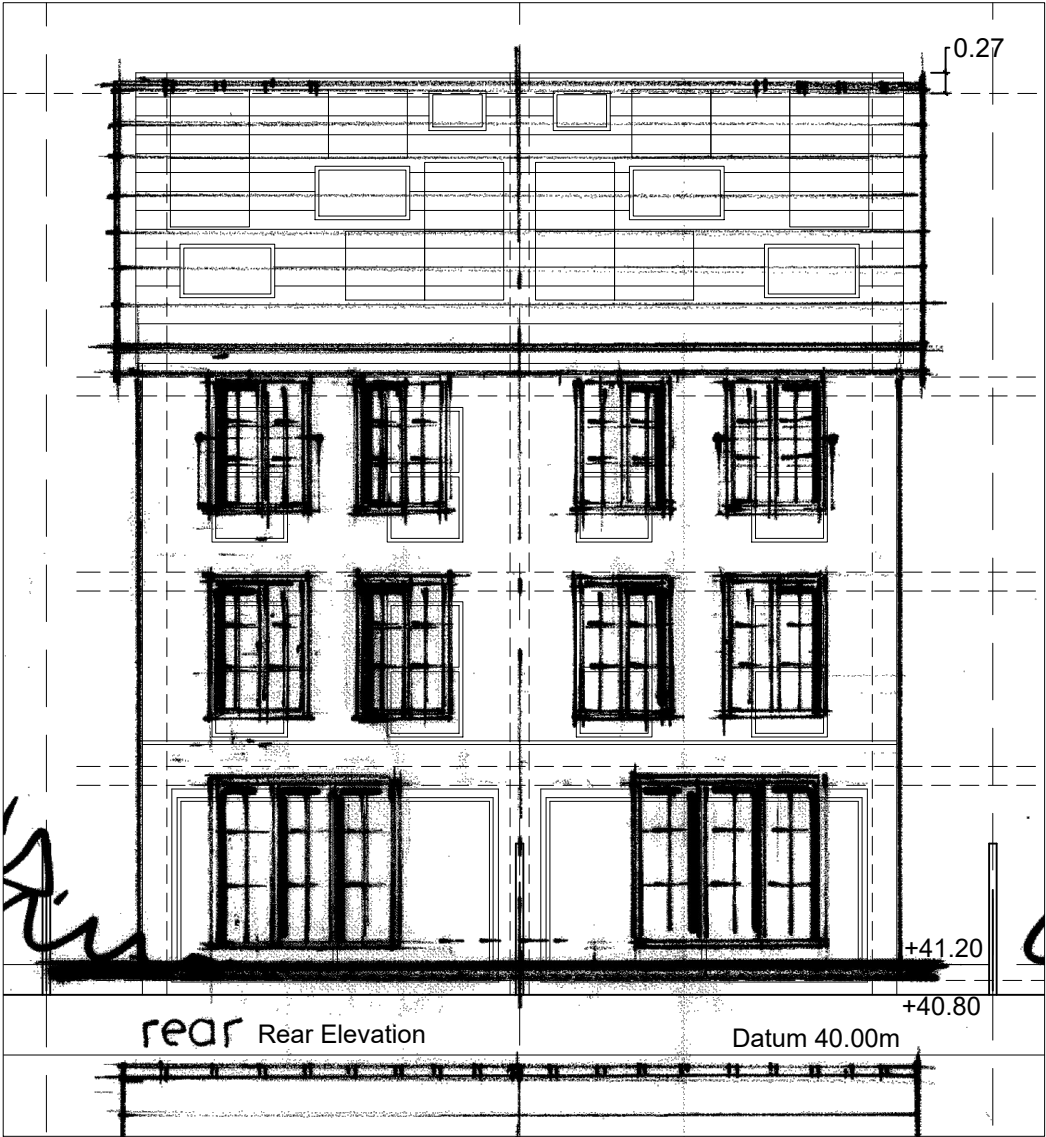


Planning approved & As built Rear Elevation overlay

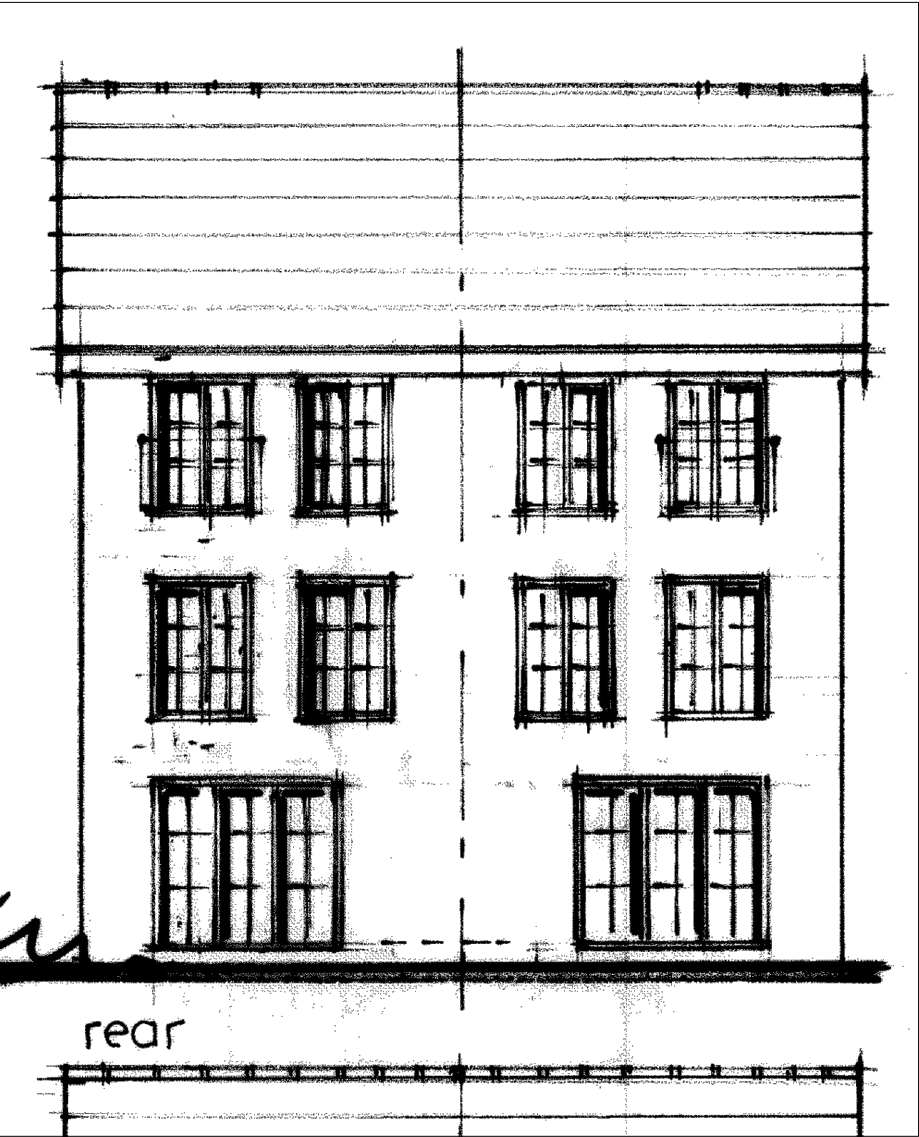


Planning approved Rear Elevation


PROJECT			66 & 68 Moseley rd, Fallowfield.		
SCALE		CLIENT			
1 : 100 @ A3		AIRSHACK LTD			
DWG No.		DRAWING TITLE			
169-SK-ELE3(2)					
CONTRACT NO.	STAGE CODE	REV.	Planning approved & As built Rear Elevation		
169	sketch	-			
ISSUED	20/07/24	-	sj simon james architect		

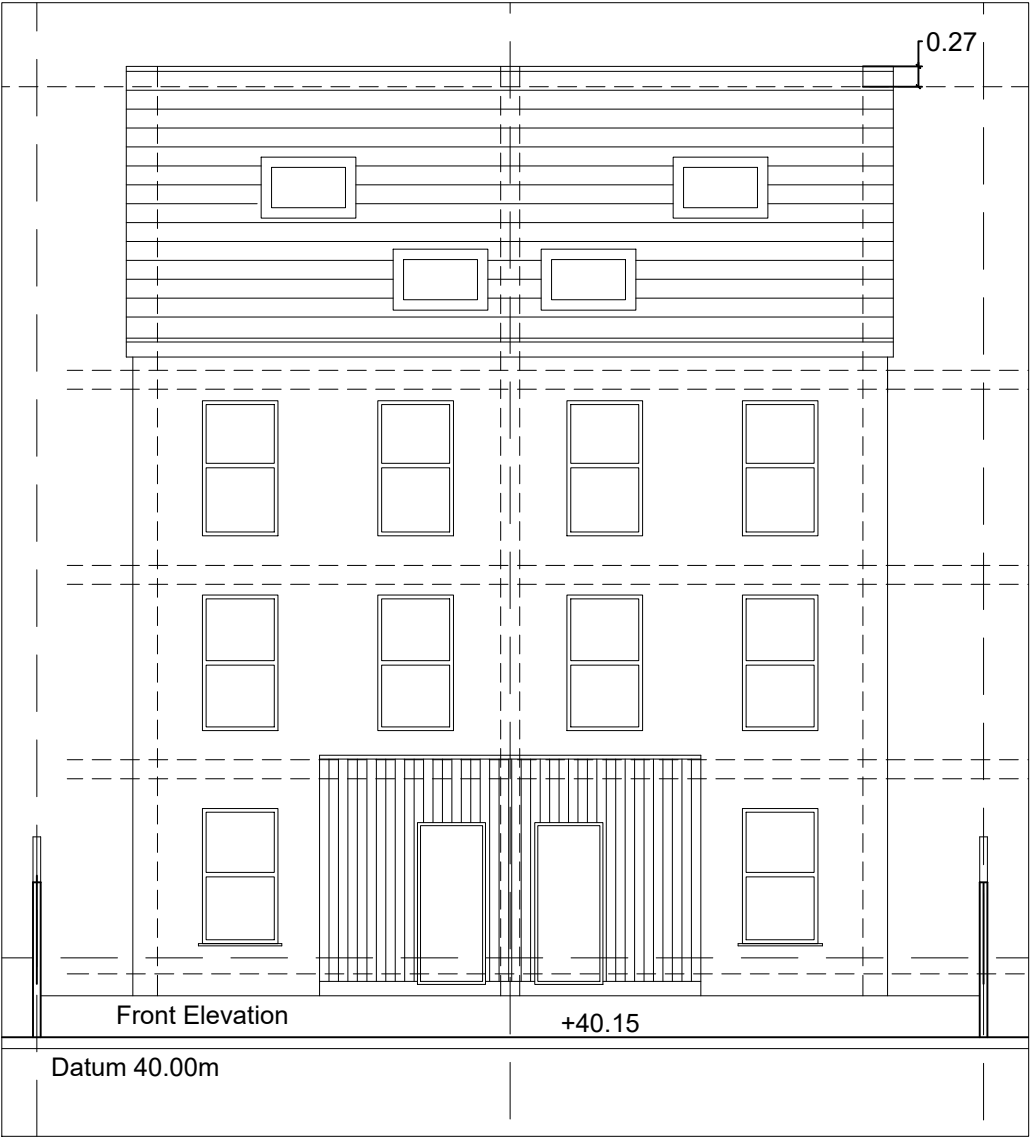

As built Front Elevation

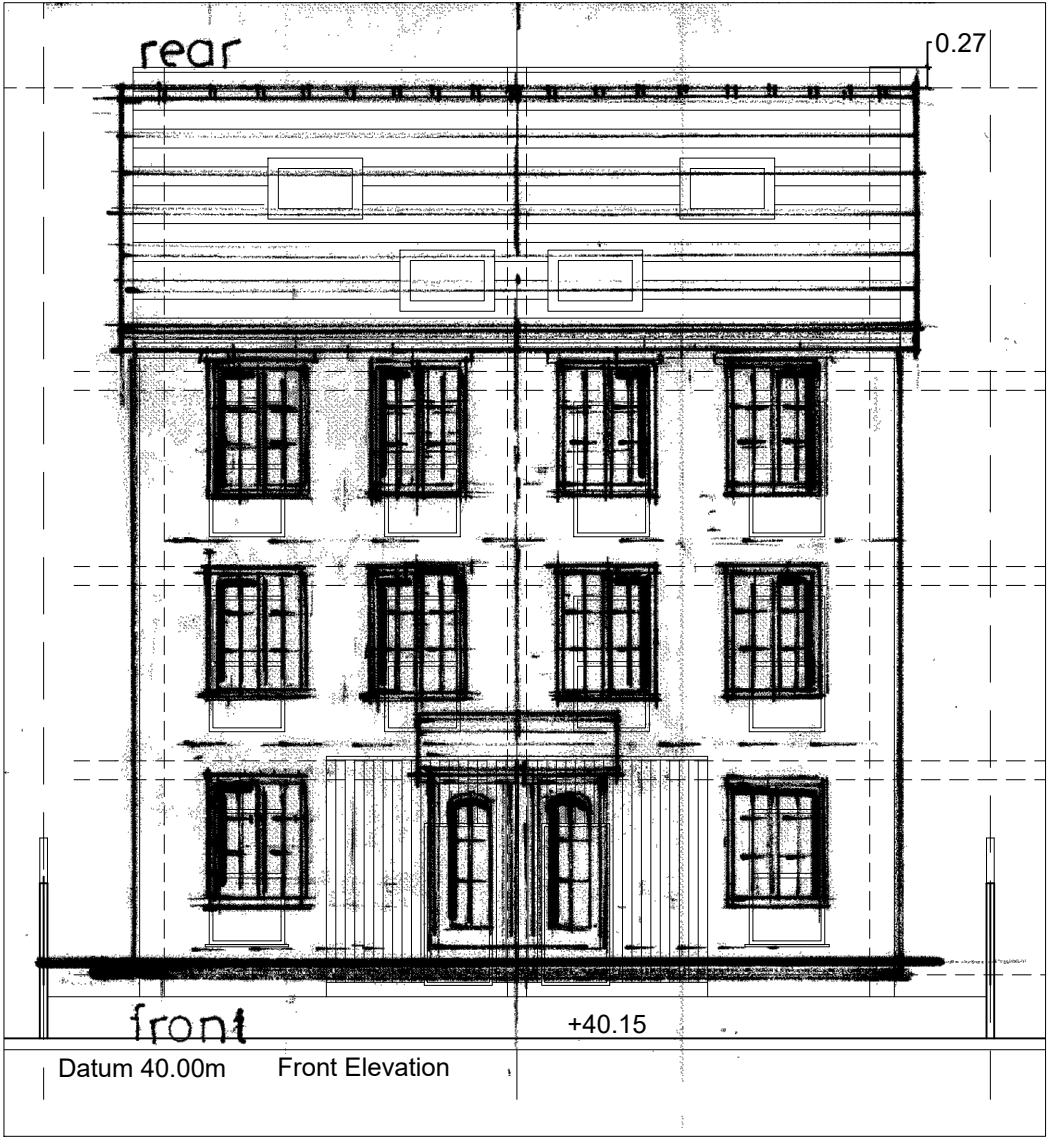

Planning approved & As built Front Elevation overlay

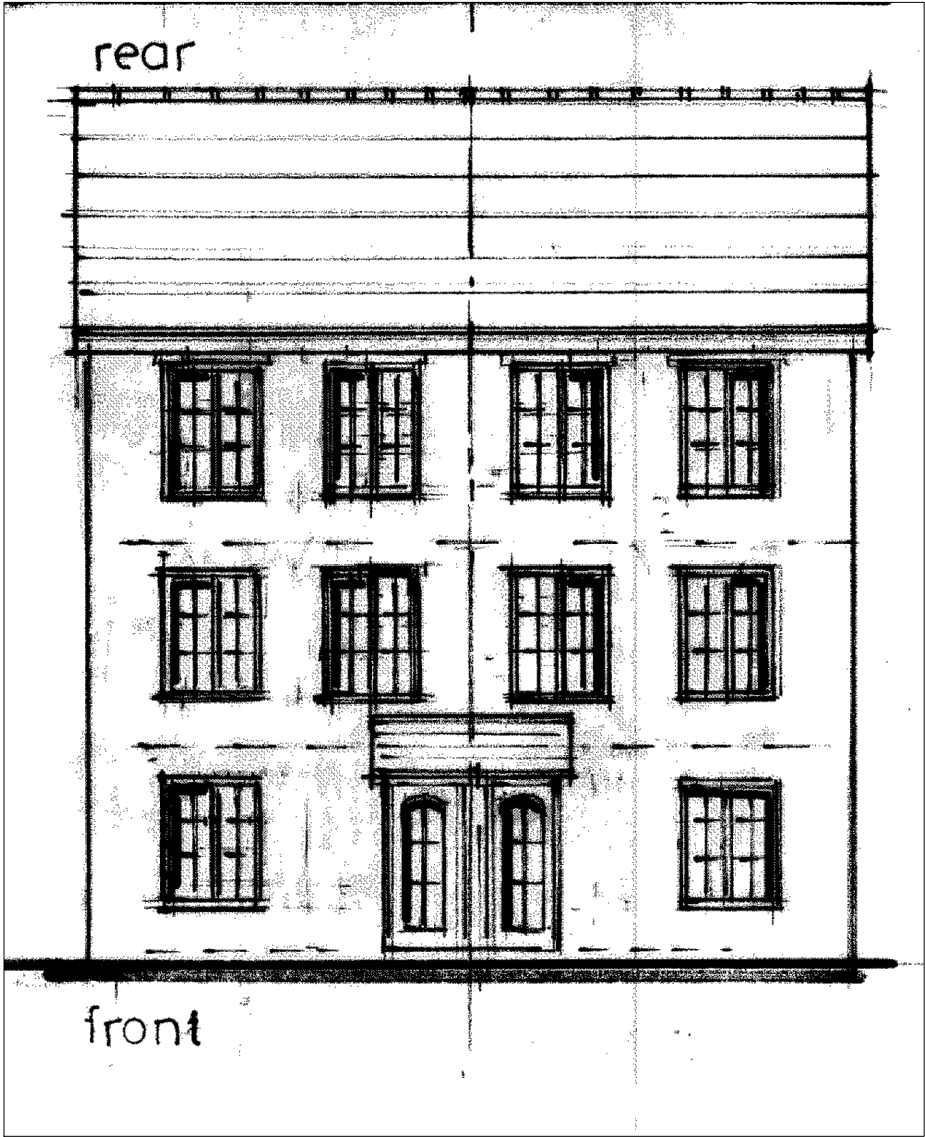

Planning approved Front Elevation

PROJECT				66 & 68 Moseley rd, Fallowfield.	
SCALE		1 : 100 @ A3		CLIENT	
DWG No.		169-SK-ELE2(2)		AIRSHACK LTD	
CONTRACT NO.		STAGE CODE	REV.	DRAWING TITLE	
169		sketch	-	Planning approved & As built Front Elevation	
ISSUED	20/07/24		-	sj simon james architect	

