



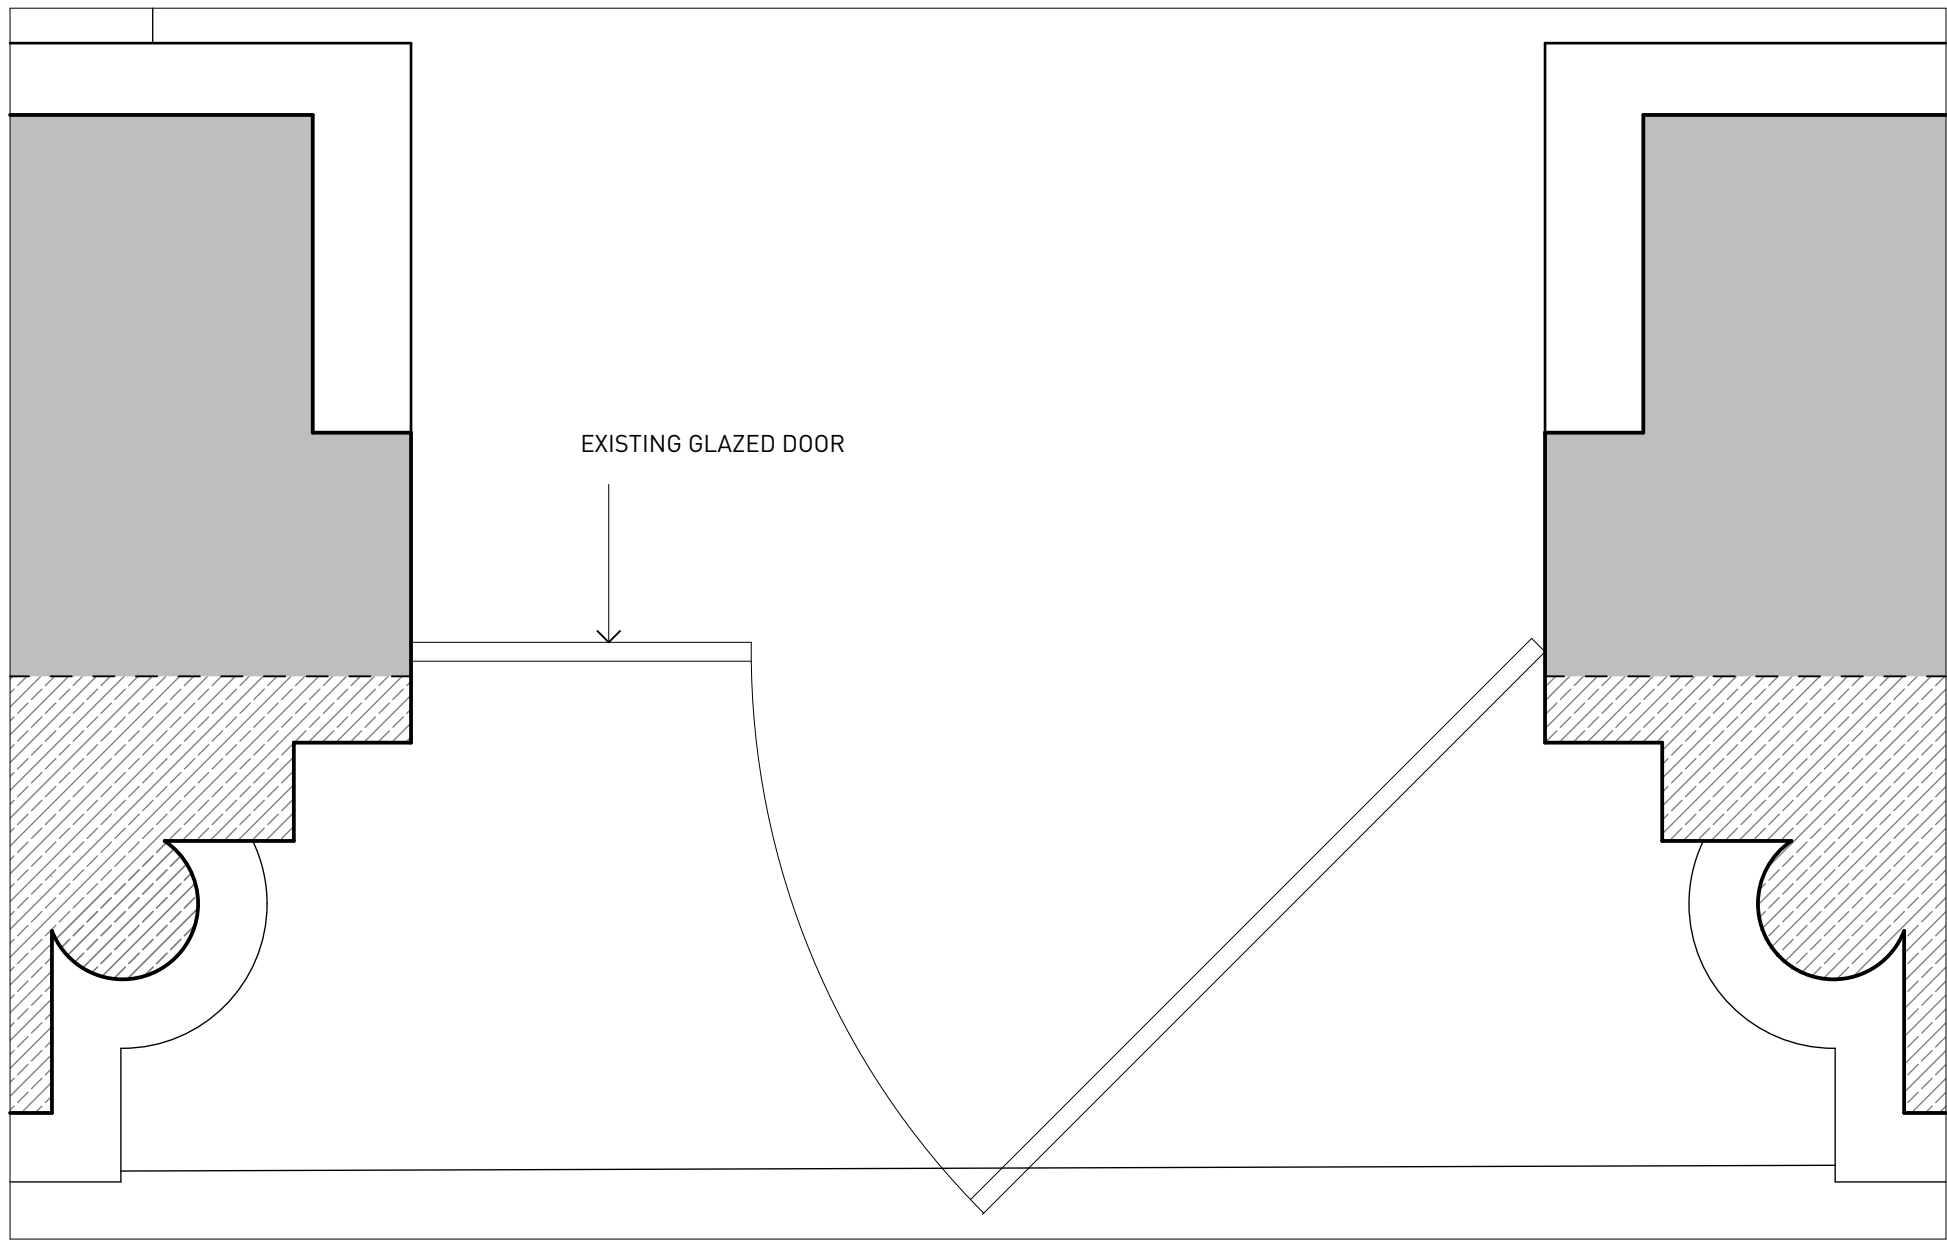

EXISTING PART PLAN - 1:10

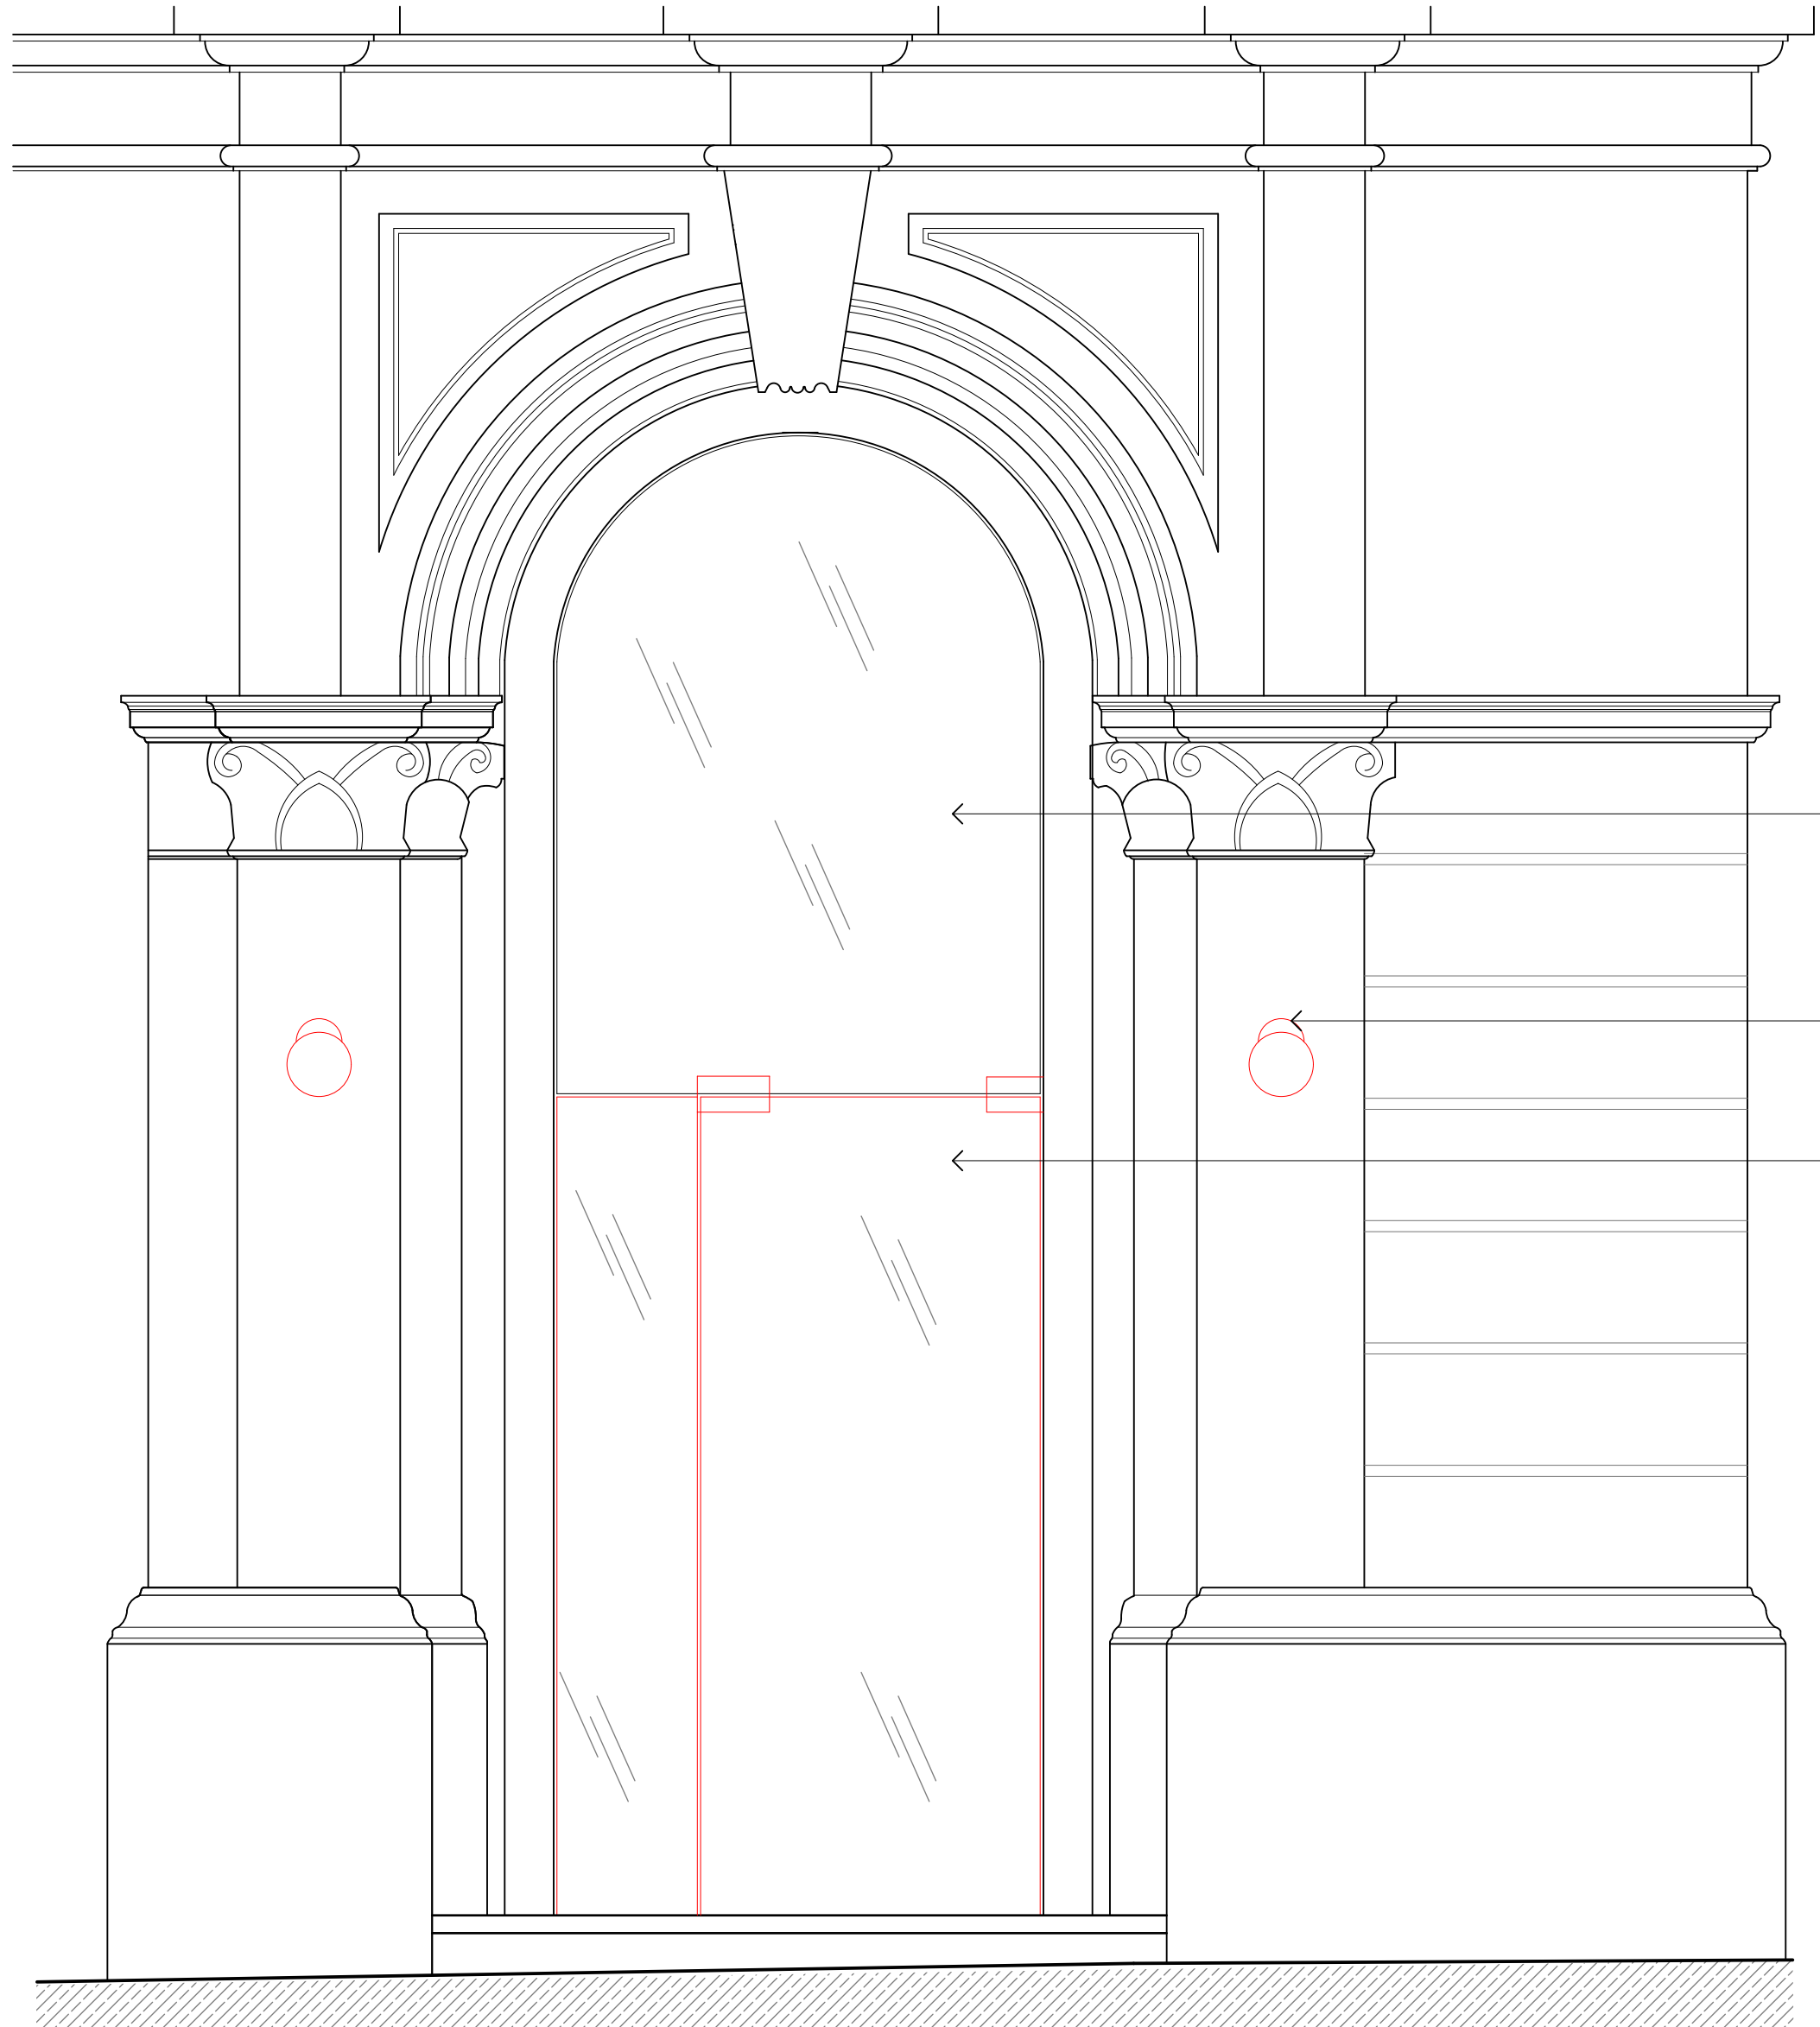

EXISTING ENTRANCE DOORS - PETER STREET ELEVATION 1:20


EXISTING GLAZED FAN LIGHT ABOVE DOOR TO BE RETAINED

EXISTING LIGHTS TO BE REMOVED AND REPLACED WITH NEW FITTING (REFER TO 23-161 JD-01 FOR DETAIL)

EXISTING GLAZED DOOR NOTED IN RED TO BE REMOVED, FITTINGS CAREFULLY REMOVED TO AVOID DAMAGE TO EXISTING MASONRY AND AREA MADE GOOD READY FOR NEW INSTALLATION OF NEW DOORS

EXISTING WALL LIGHT FIXING LOCATIONS TO BE UTILISED TO ALLOW FOR CABLES AND FIXING POINT OF NEW WALL LIGHTS

RED DASHED LINE INDICATES EXISTING FIXING LOCATIONS. LOCATIONS TO BE USED TO FIX MENU CASE BACK TO EXISTING BUILDING WHERE POSSIBLE AND ALLOW FOR ANY CABLES TO BE FED THROUGH

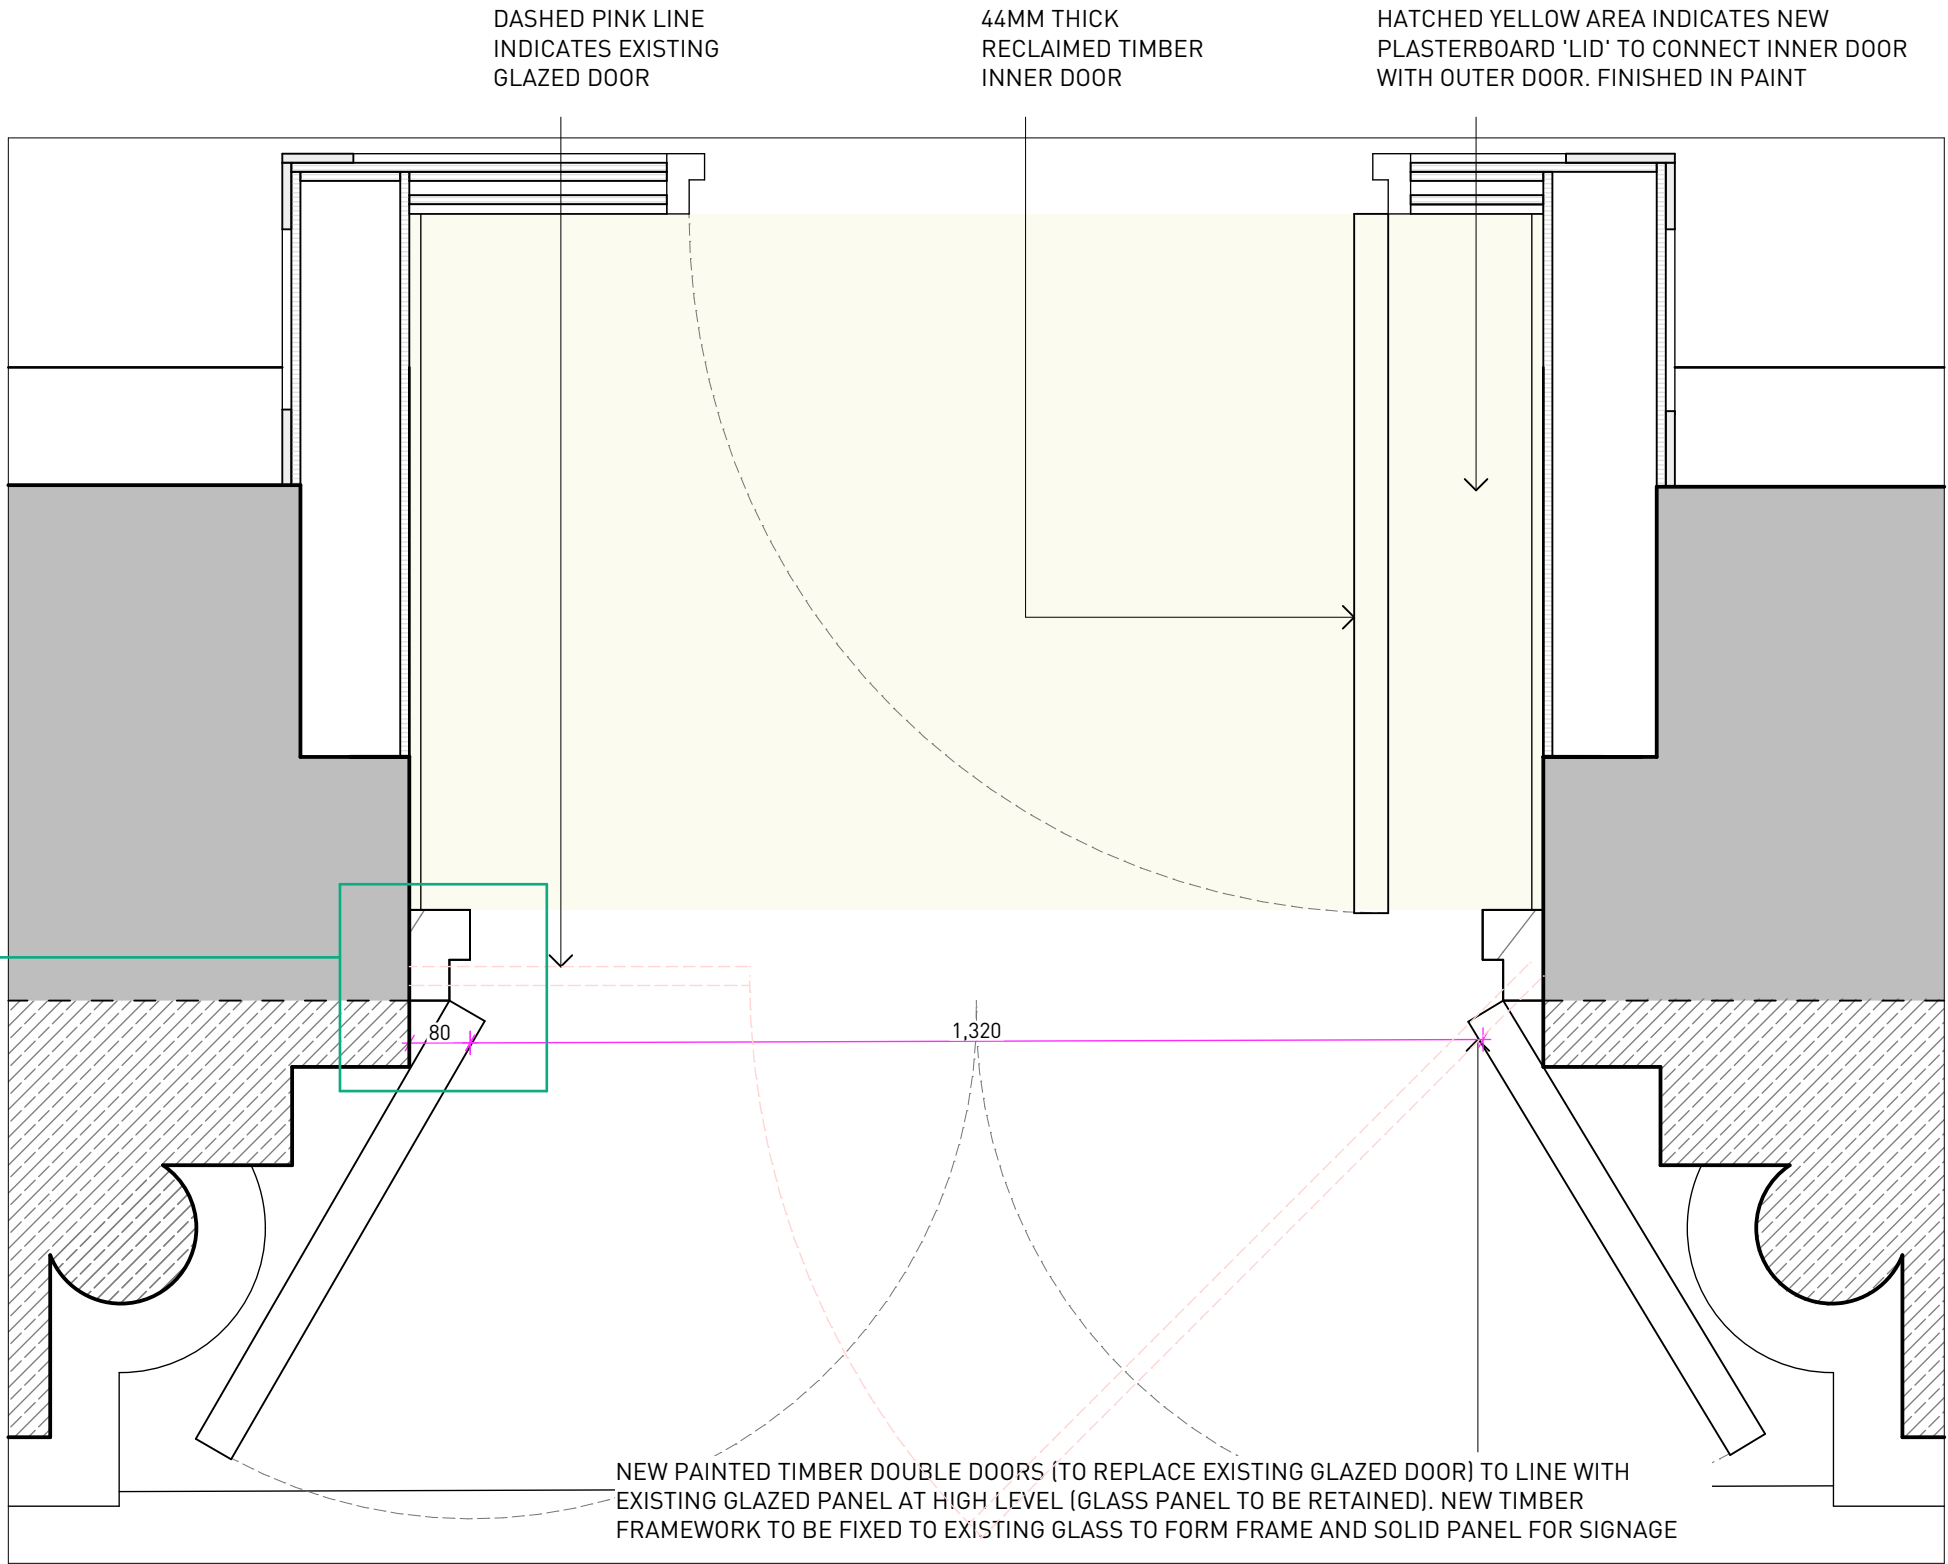

PROPOSED PART PLAN - 1:10



PROPOSED ENTRANCE DOORS - PETER STREET ELEVATION 1:20

1. THE DRAWINGS SHOW DESIGN INTENT ONLY AND SHOULD NOT BE RELIED ON FOR CONSTRUCTION.
2. ALL DIMENSIONS TO BE CHECKED ON-SITE PRIOR TO CONSTRUCTION OR PRODUCTION. CONSTRUCTION DETAILS TO BE CONFIRMED BY CONTRACTOR/ MANUFACTURER BY SUBMITTING SHOP DRAWINGS FOR DESIGNER'S APPROVAL.
3. ALL DIMENSIONS ARE IN MM UNLESS OTHERWISE NOTED.
4. DESIGN/DRAWING IS NOT TO BE SCALED FOR PRODUCTION AND CONSTRUCTION PURPOSES.
5. ALL DISCREPANCIES AND OMISSIONS ON-SITE MUST BE REPORTED FOR COMMENTS OR APPROVAL BY THE DESIGNER AND/OR CLIENT PRIOR TO COMMENCING WORK.
6. ALL ELECTRICAL LIGHTING, HVAC AND PLUMBING ISSUES TO BE REFERRED TO ENGINEER'S DRAWINGS.
7. ALL PROPOSALS ARE SUBJECT TO APPROVAL BY STATUTORY AUTHORITIES AND ANY NECESSARY ALTERATIONS SHOULD BE MADE IF REQUIRED TO COMPLY WITH STATUTORY REQUIREMENTS.
8. ALL DESIGN CONCEPTS AND DRAWINGS ARE THE PROPERTY OF OTHER SIDE STUDIO LTD AND ARE COVERED BY COPYRIGHT. NO REPRODUCTIONS, ADAPTATIONS AND/OR COPIES MAY BE MADE WITHOUT WRITTEN PERMISSION OF OTHER SIDE STUDIO LTD.

PLANNING:
ENTRANCE DOOR
DETAILS 1/2

PROJECT NO.
23-161

DRAWING NO.
JD-02

SCALE
1:20

REV.
G

SHEET SIZE
A1

OTHER SIDE
GRAFTON HOUSE
67 LOUGHBROUGH ROAD,
WEST BRIDGEFORD, NOTTINGHAM, NG2 7LA
STUDIO @ OTHERSIDE.CO.UK

PLANNING			BLACKLOCK		
REV.	DATE	COMMENT	FREETRADE EXCHANGE, 37 PETER ST, WCR M2 5GB		
B	19/02/24	UPDATED TO SUIT COMMENTS			
C	29/02/24	UPDATED TO SUIT COMMENTS			
D	15/03/24	UPDATED TO SUIT COMMENTS			
E	02/07/24	UPDATED TO SUIT COMMENTS			
F	11/07/24	UPDATED TO SUIT COMMENTS			
G	14/07/24	UPDATED TO SUIT COMMENTS			