
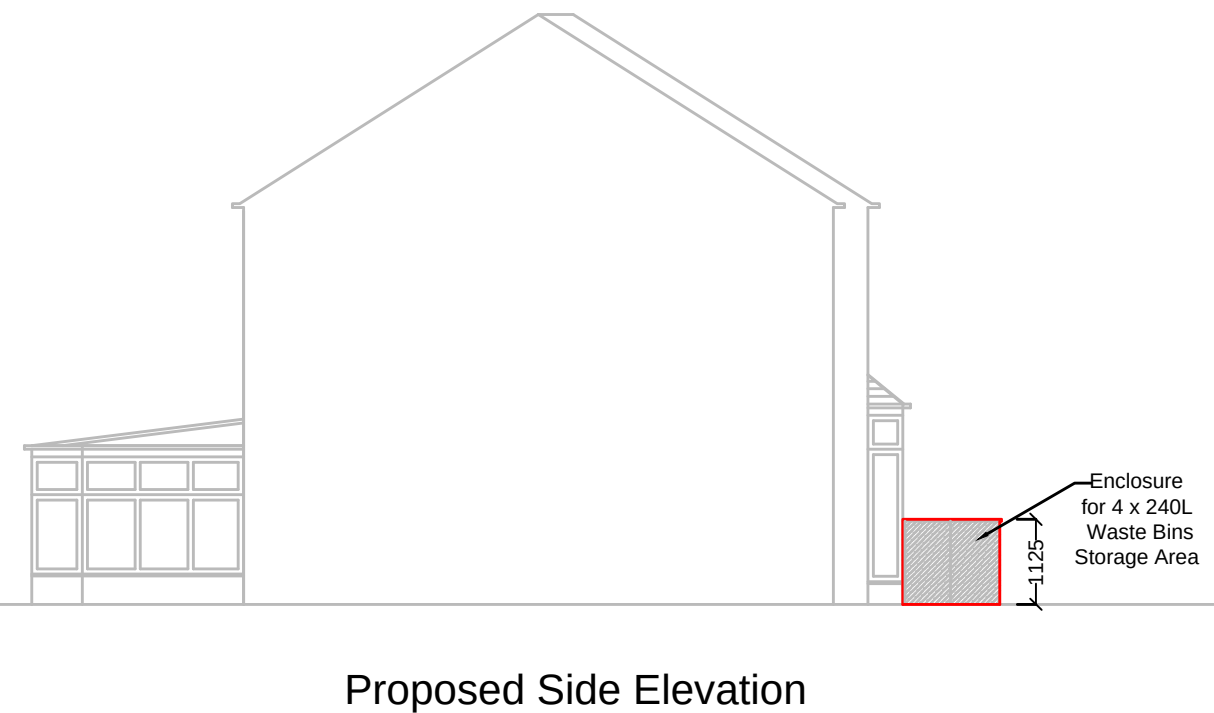
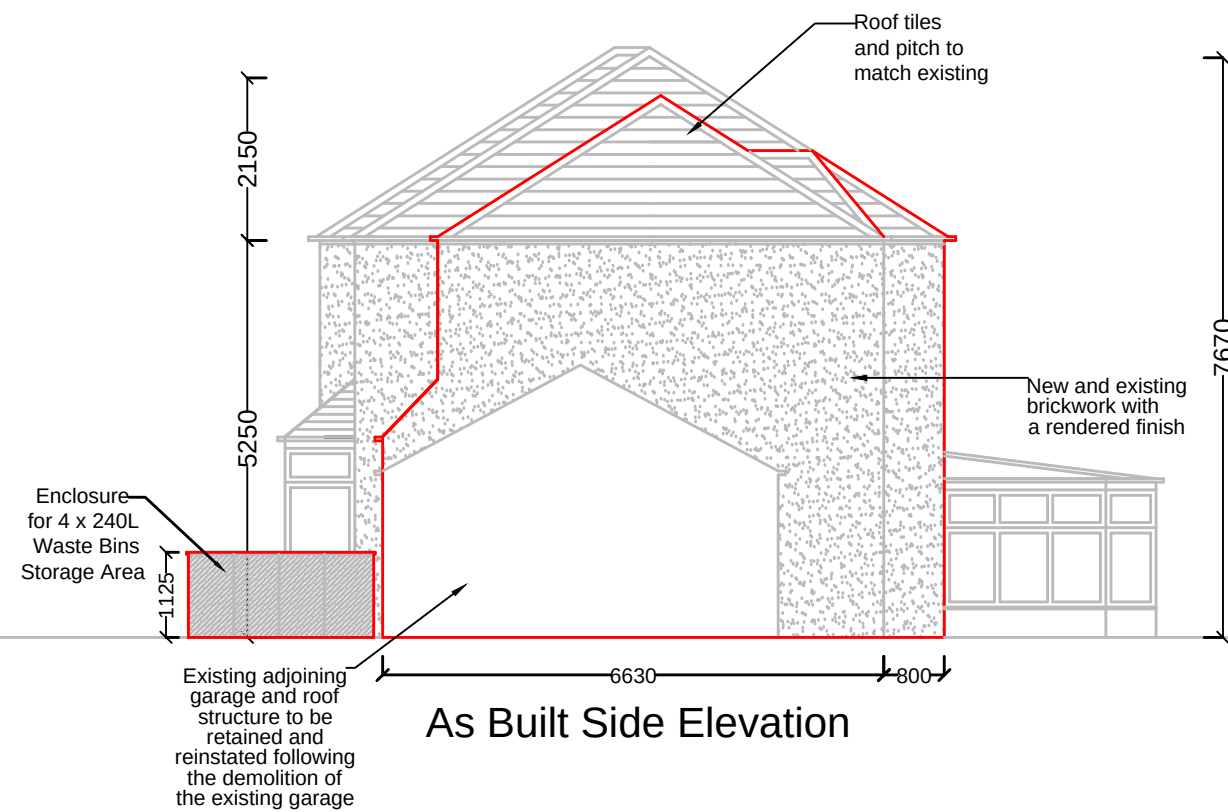
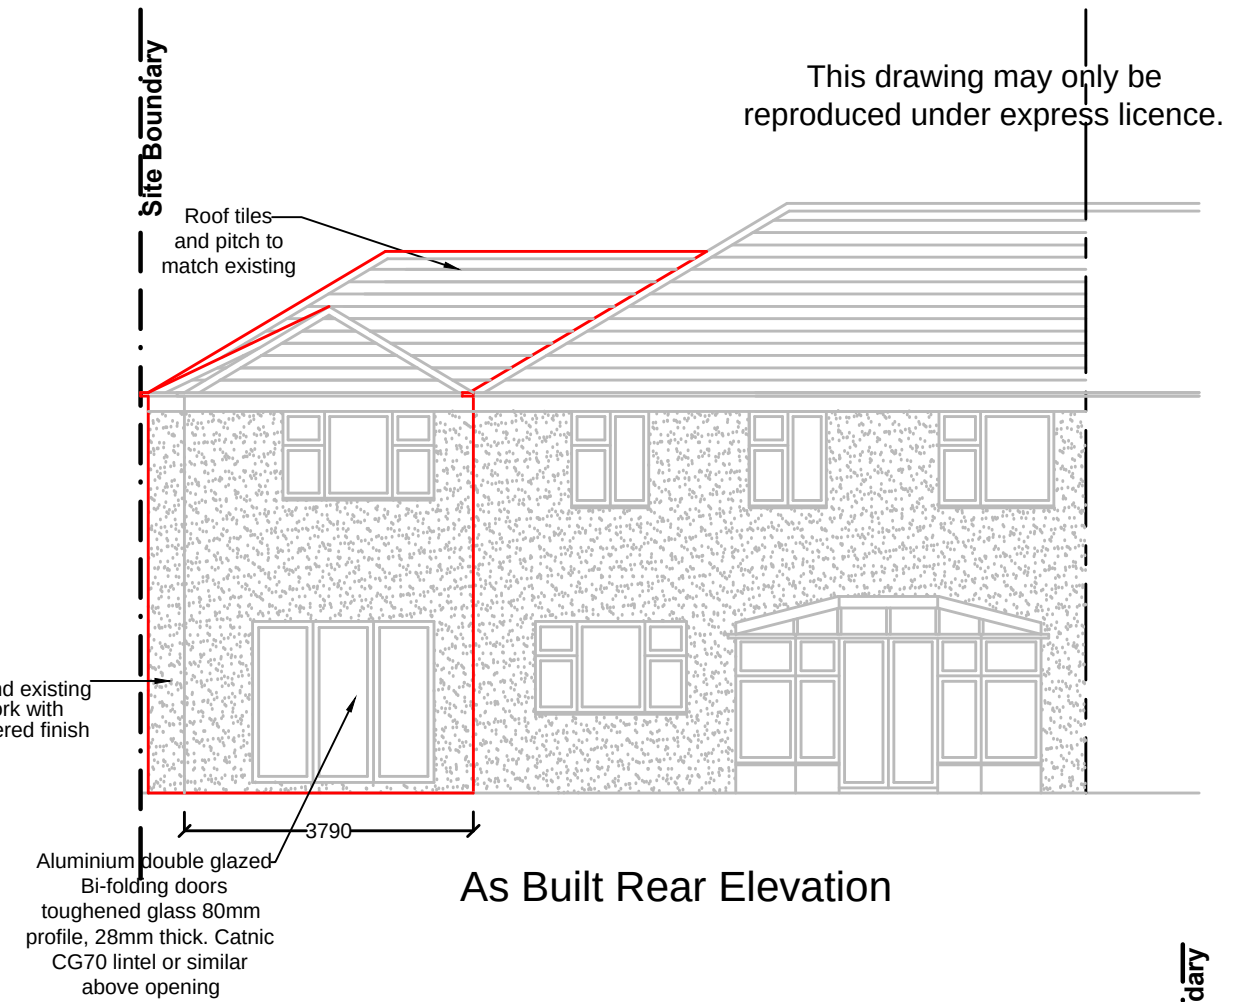


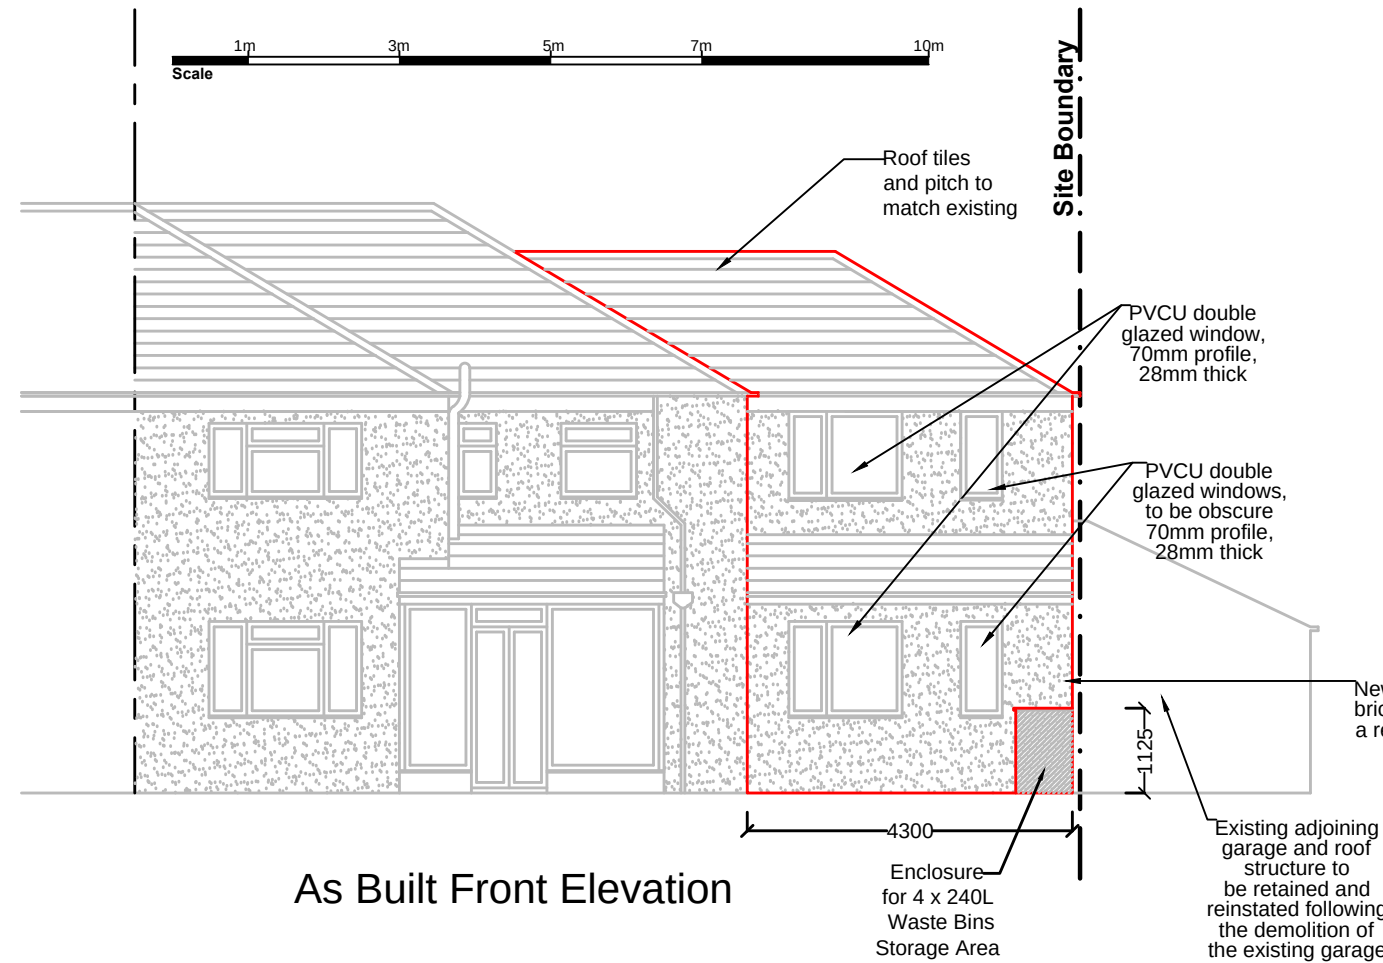

This drawing may only be reproduced under express licence.

Project Name:
Proposed Double Storey Side Extension

Drawing Name:
As Built Elevations

Project Address:
13 Shawdene Road,
Northenden,
Manchester, M22 4BY

Project Ref: MK/PA092002

Date: 25.06.24

Scale: 1:100

Paper Size: A3

Sheet:
04

Rev: 01