



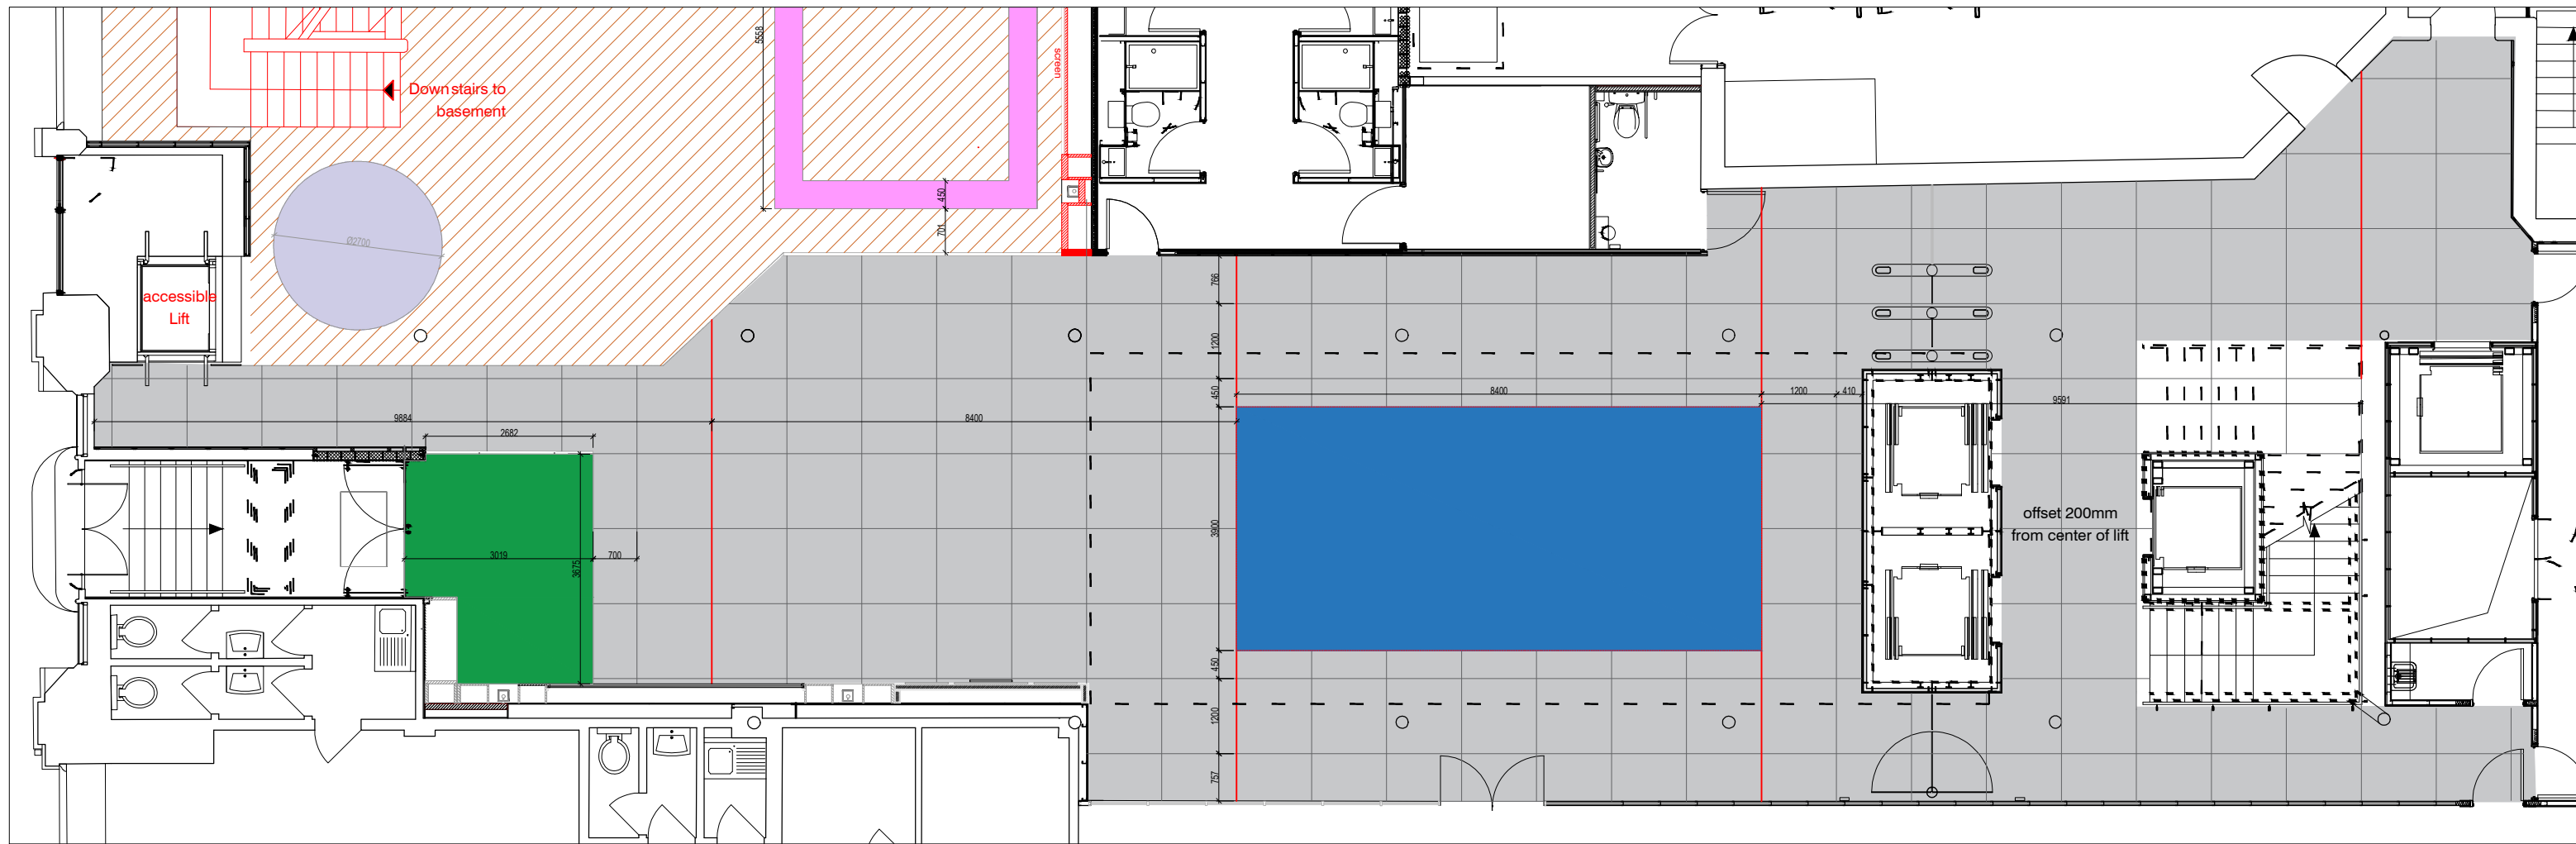

Ground Floor Tile Plan
Scale : 1:100

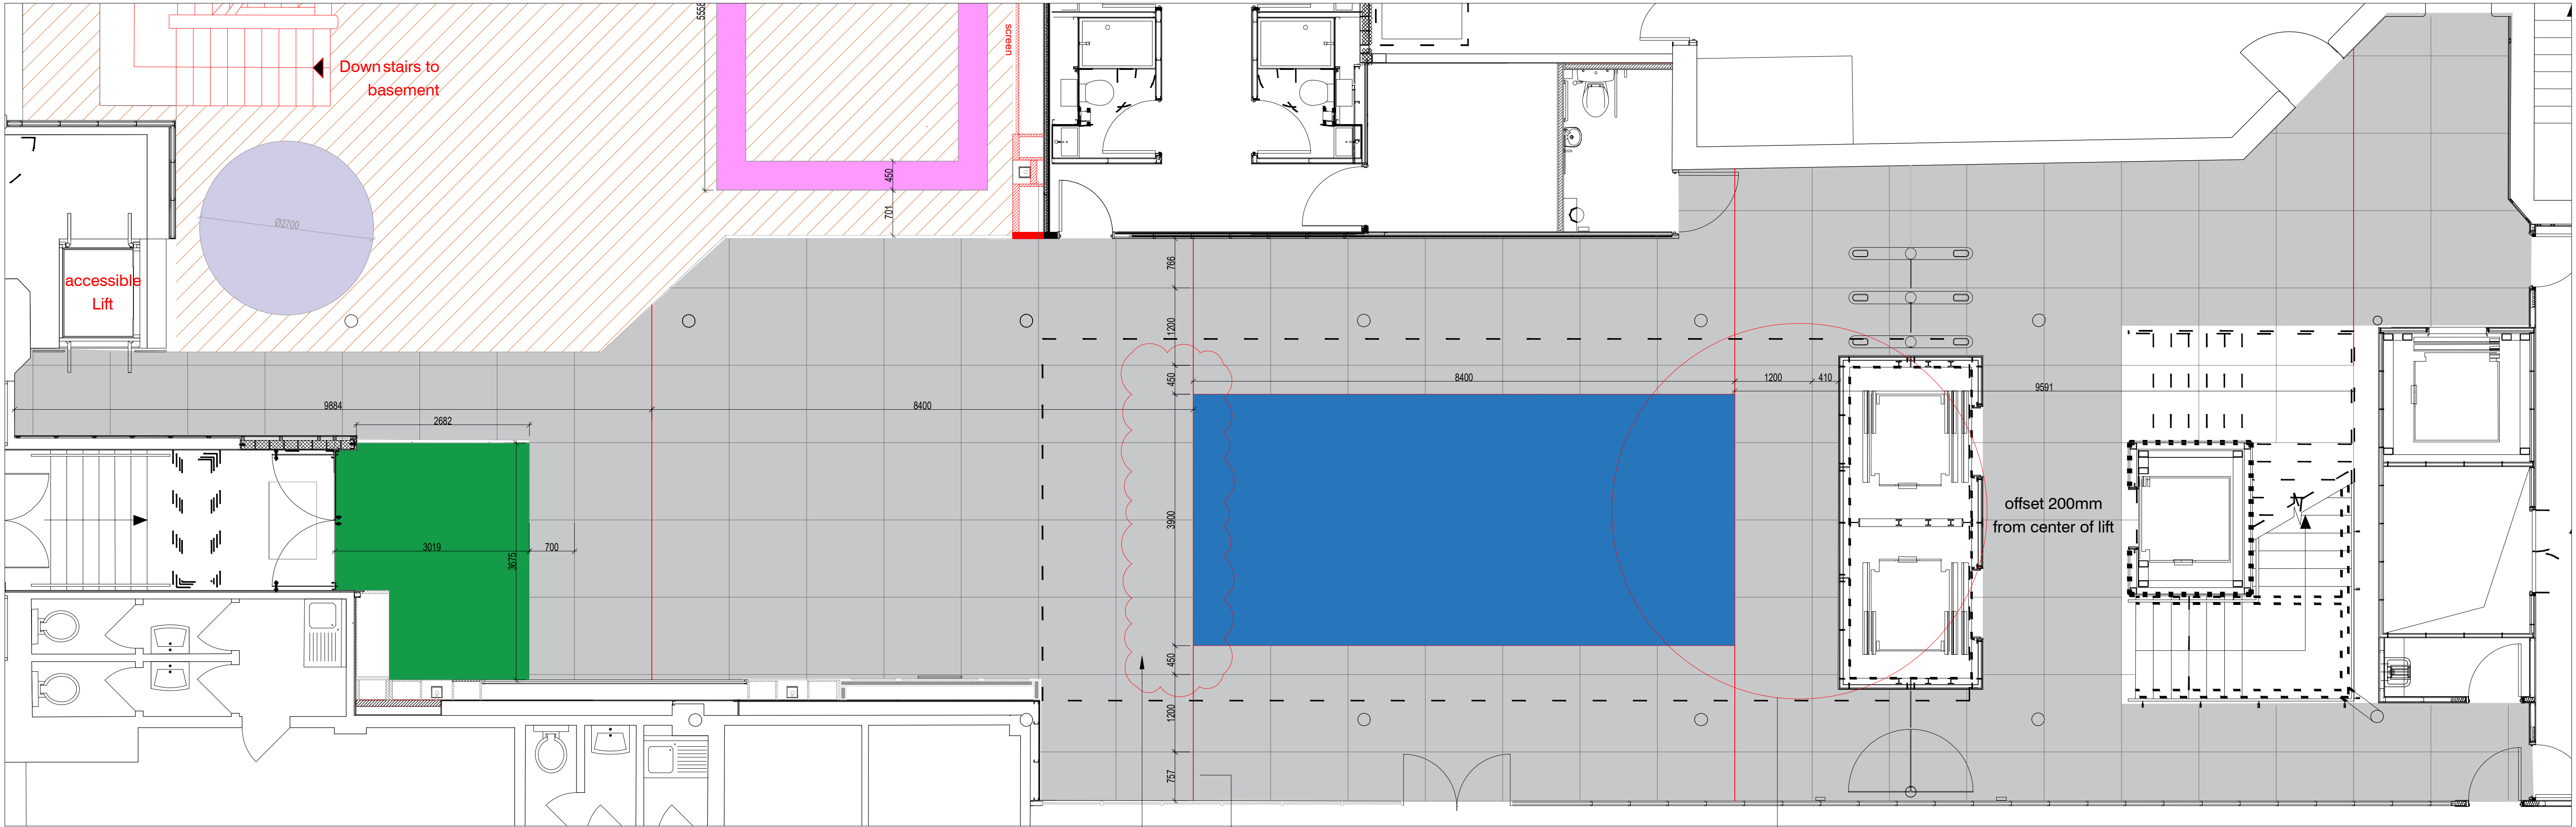

Tile Setting Out
Scale: 1:50

PROPOSED NEW FLOOR FINISHES

FF01. Porcelanosa Bottega Acero 120 x 120 (Interiors)	Area 215 m2
FF05. Newhay Carpets: Bespoke Rug design. Ref: 22155_012	Area 33 m2
FF06: Primary Barrier Matting - Gradus, Esplanade 6000 Matting Colour: Nightfall	Area 10 m2

Redline denotes
movement joints

Revision Cloud: Amended rug insert by 100mm
to give 50mm tolerance either side for fit out

Set from center of lifts:
laser set tiles for accuracy

Note: Contractor to specify
Carpet underlay to central rug
area & slimline trim

OBI

www.obiproperty.co.uk

All dimensions are in millimetres unless stated otherwise. No dimensions to be scaled from drawings. All dimensions to be checked on site prior to manufacture.

Any discrepancies between drawings and site conditions are to be reported to the contract manager.

This drawing is to be read in conjunction with all relevant Structural Engineers and Mechanical & Electrical Engineers drawings and specification.

© COPYRIGHT
The copyright in this drawing is vested in OBI Property Ltd and no licence or assignment of any kind has been, or is, granted to any third party whether by provision of copies or originals of the drawings or otherwise unless otherwise agreed in writing.

B	Amended carpet inset size	06/03/24	EK	
A	Amended setting out & movement joints	01/03/24	EK	
-	First Issue	26/04/23	EK	
REV	DESCRIPTION	DATE	BY	CHK

CLIENT NAME

Philip J Davis Holdings Plc

PROJECT NAME

Seventdale House

DWG TITLE:

Ground Floor - Floor Finishes - Tile
Setting Out

DWG NO:	17_003	REVISION:	B
SCALE	1 : 100 @A1	DRAWN:	RG

DWG STATUS:

STAGE 5

© OBI Property Limited
80 Mosley Street, Manchester, M2 3FX
t: 0161 237 1717 e: info@obiproperty.co.uk

OBI