



STEELWORK ELEVATION
Scale - 1:10

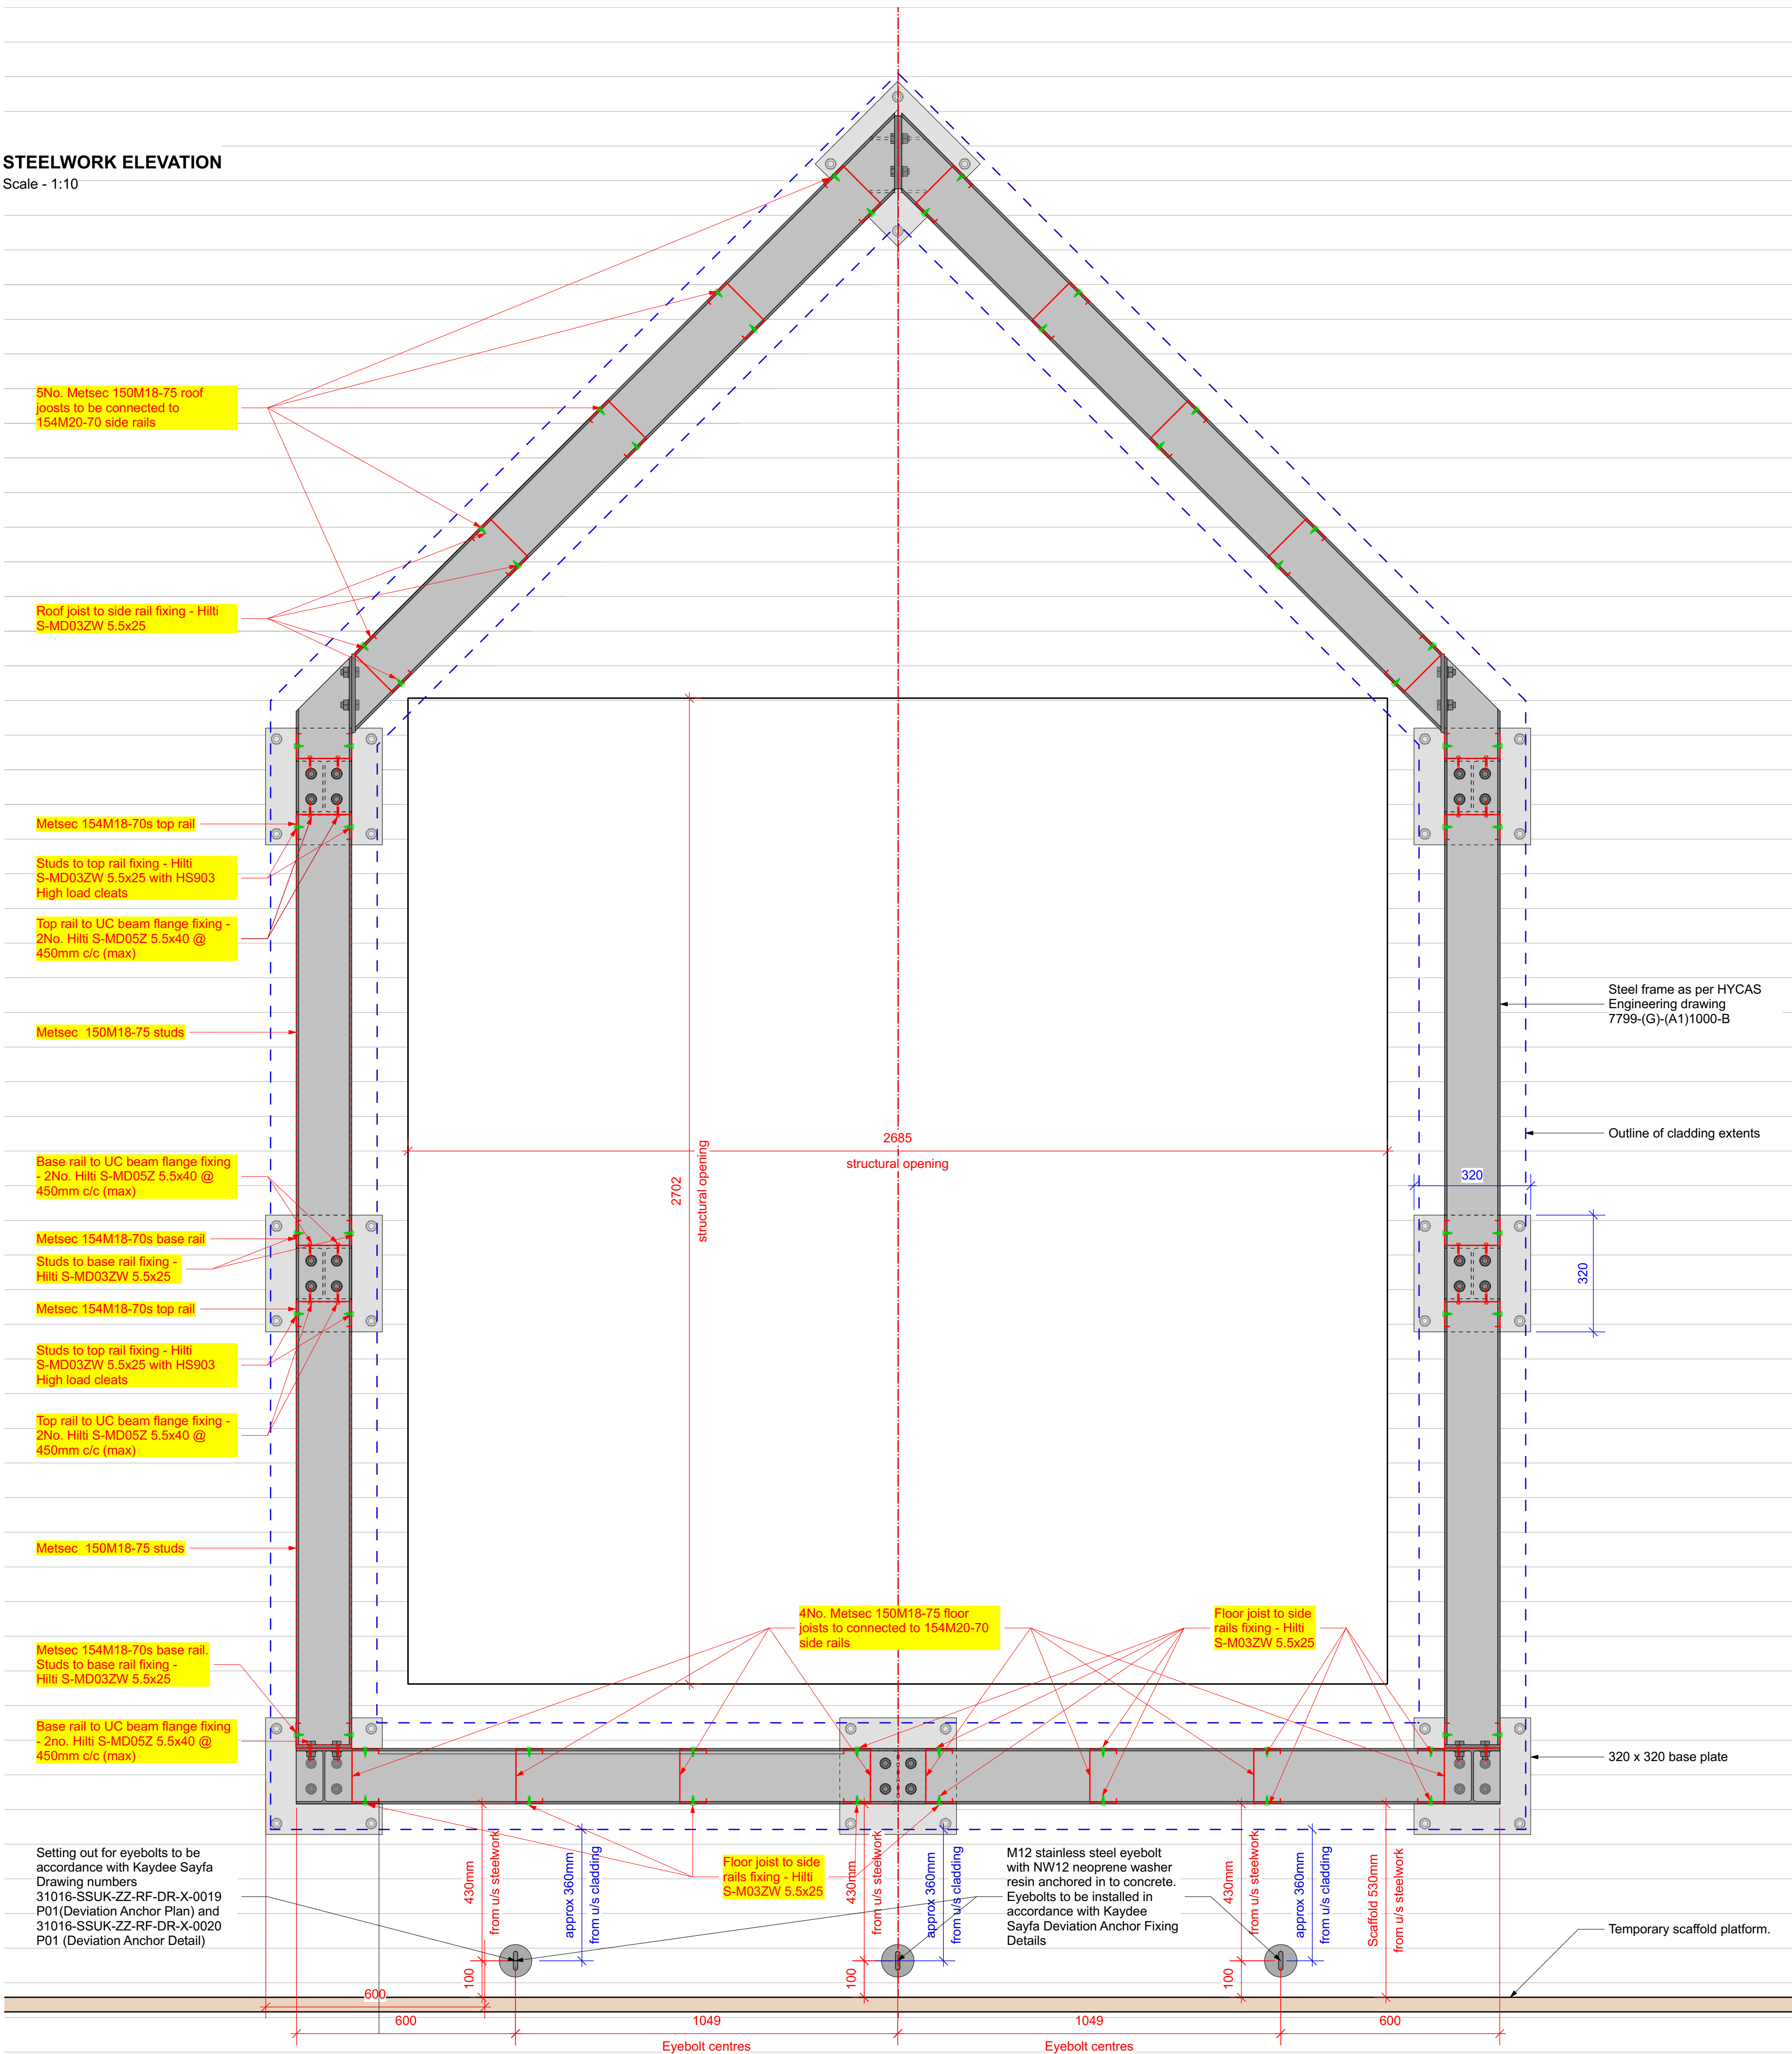

STEELWORK SECTION
Scale - 1:10

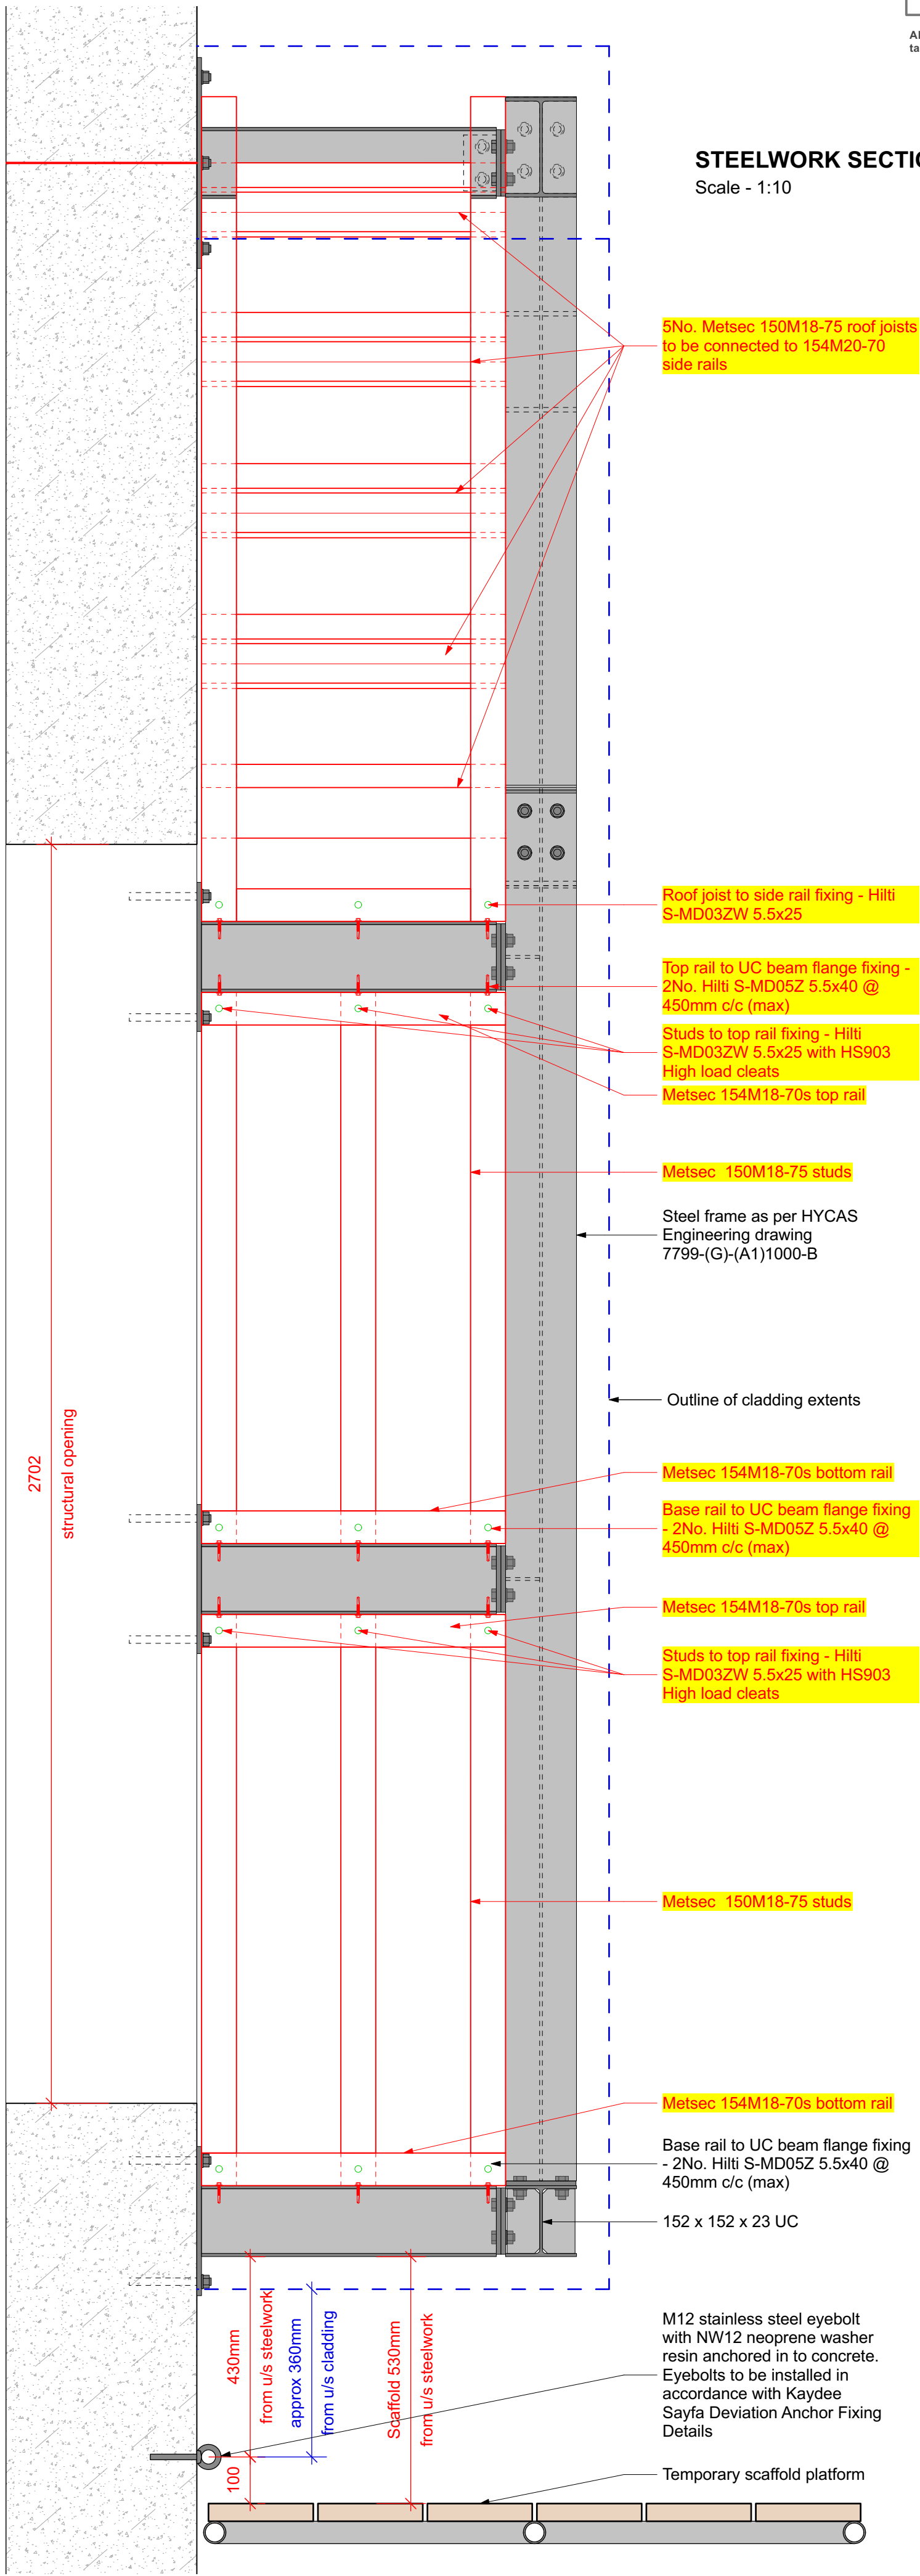

Notes

All contractors, subcontractors and/or specialists are responsible for taking and checking all dimensions relating to their work on site.

KEY:

Notes highlighted in yellow are MJM Consulting specification as per MJM marked up dated 14.03.24

Rev.	Date	Description	By	Appr.
C1	07.05.24	Drawing updated with MJM comments dated 14.03.24	PB	RG
P1	12.03.24	Initial drawing issue	PB	RG

Client	Deansgate SOF Alliance Hotel Co Ltd.
Project	TREEHOUSE HOTEL MANCHESTER
Document reference	THM1-001-011-DR-A-3.33
Status	CONSTRUCTION
Drawing	11th Floor Gable Treehouse Steelwork Elevation
Scale	1:10 @ A1
Date	12/04/24
By	PB
Approved	RG
Synergy Job No.	SA813
Synergy Drawing No.	3.33
Revision	C1

Copyright Synergy Architects Limited. The information contained in this document may not be used, reproduced or distributed, in whole or in part, without the written consent of Synergy Architects. Only parties to which this document has been intentionally issued by Synergy Architects may use the information. Synergy Architects will not accept responsibility for any consequence of its unauthorised use.