



VISUAL SCALE 1:100 @ A3

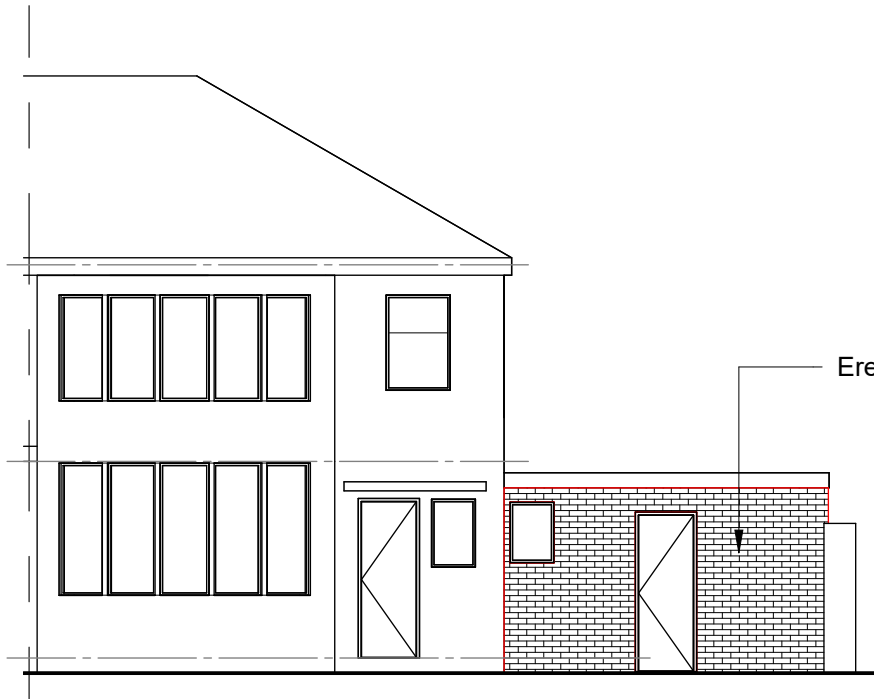


01_P-Elevation
1 : 100

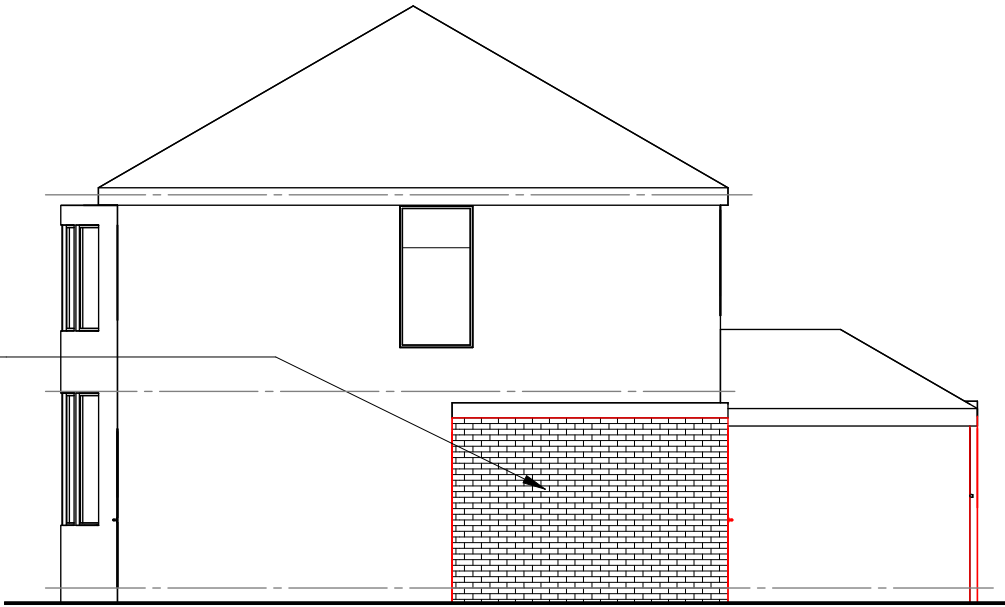


02_P-Elevation
1 : 100

Erect outer skin brick wall
around the asbuilt
structure

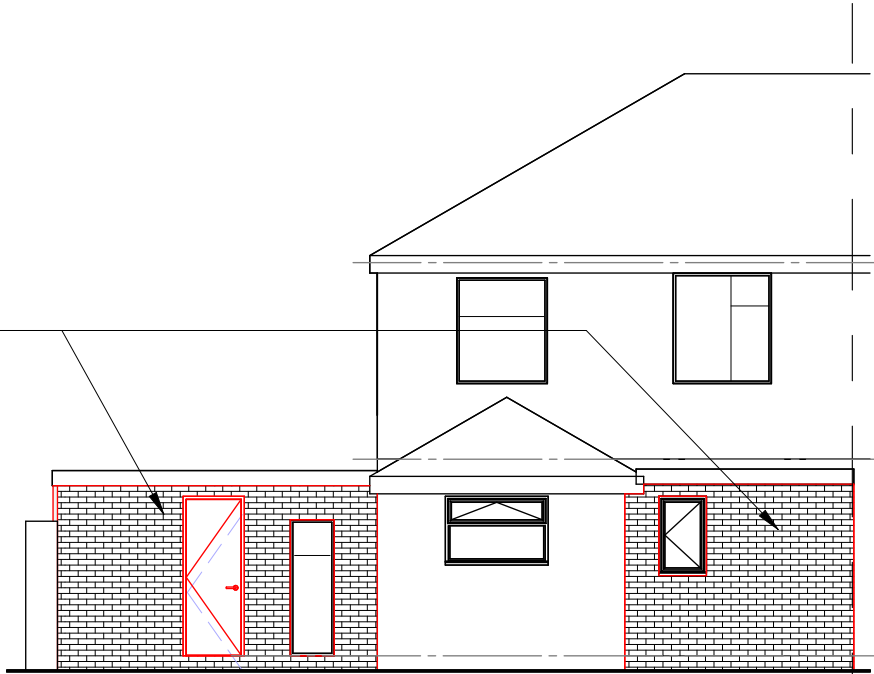

03_P-Elevation
1 : 100

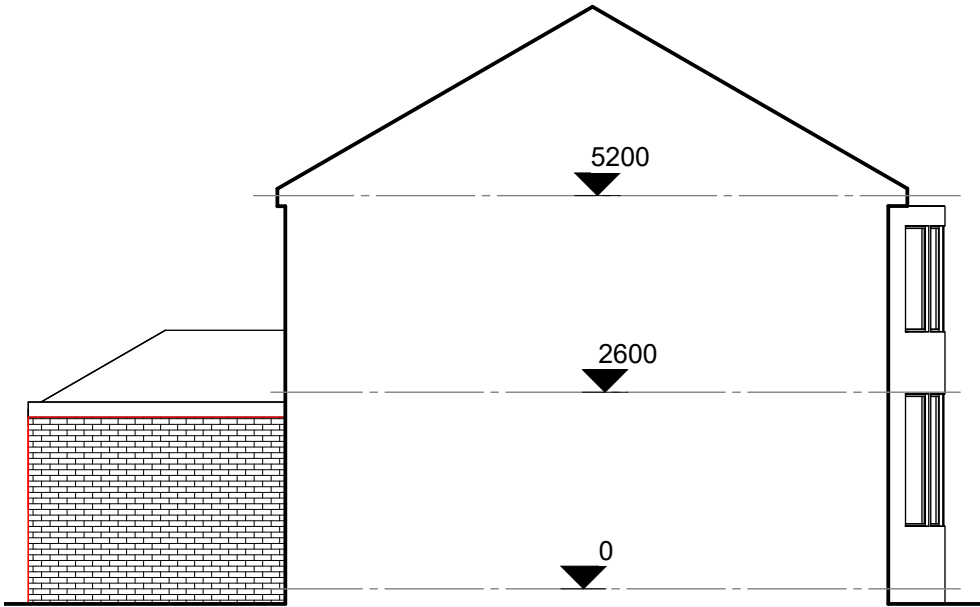

04_P-Elevation
1 : 100

COPYRIGHT © ALL RIGHTS RESERVED BY VIKAS ALYAS LTD. DO NOT SCALE FROM DRAWING. DRAWING INDICATES DESIGN INTENT ONLY. REPORT ANY DISCREPANCIES TO CLIENT / VA LTD. NOT TO BE USED FOR CONSTRUCTION UNLESS STATED SO. TO BE READ IN CONJUNCTION WITH OTHER DRAWINGS OR SPECIFICATION WHERE PROVIDED.



0161 511 8479

vikas@architek.uk
916 Stockport Road, Levenshulme, Manchester, M19 3AB

No.	Description	Date
P1	Issue to Planning	25.06.2024

PROJECT		ADDRESS		CLIENT	
Retrospective single storey extension to side and rear elevations		1232_94 Parrs Wood Rd, Manchester M20 4RP		Mr Ismail Altaf	
Manchester City Council		SHEET		Date 25.06.2024	Project number 1232
PURPOSE OF ISSUE Planning		Retrospective Elevations		Scale (@ A3) 1 : 100	REV
				Drawn by VA	DRAWING NUMBER
				Checked by VA	A104
					P1