
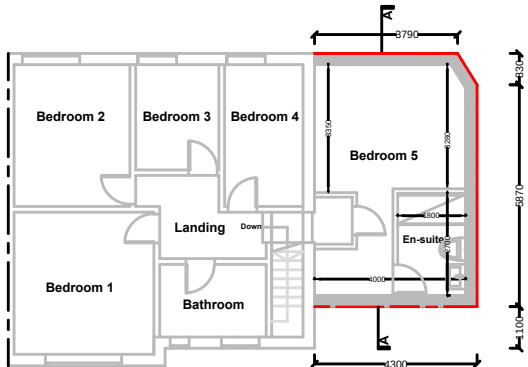
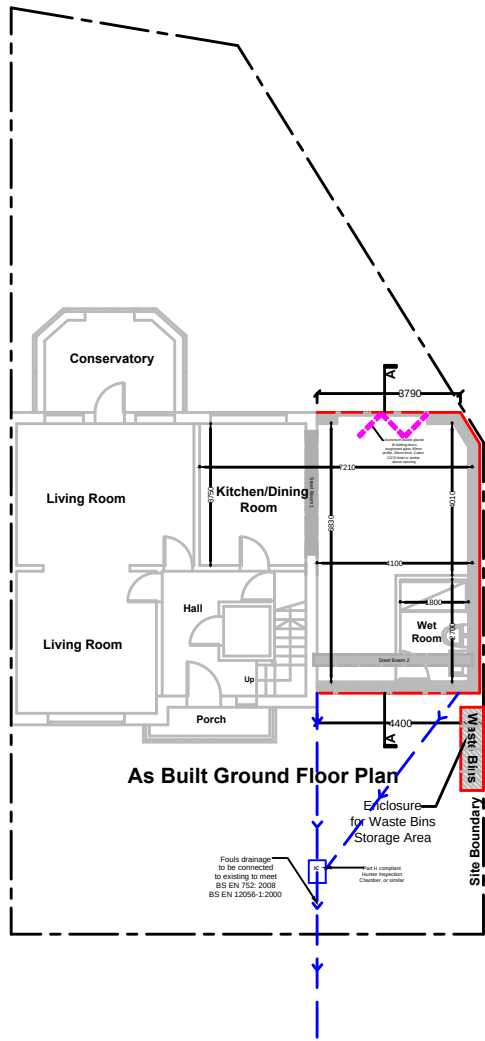
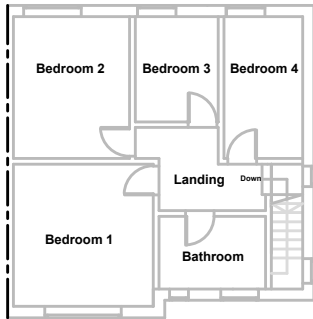


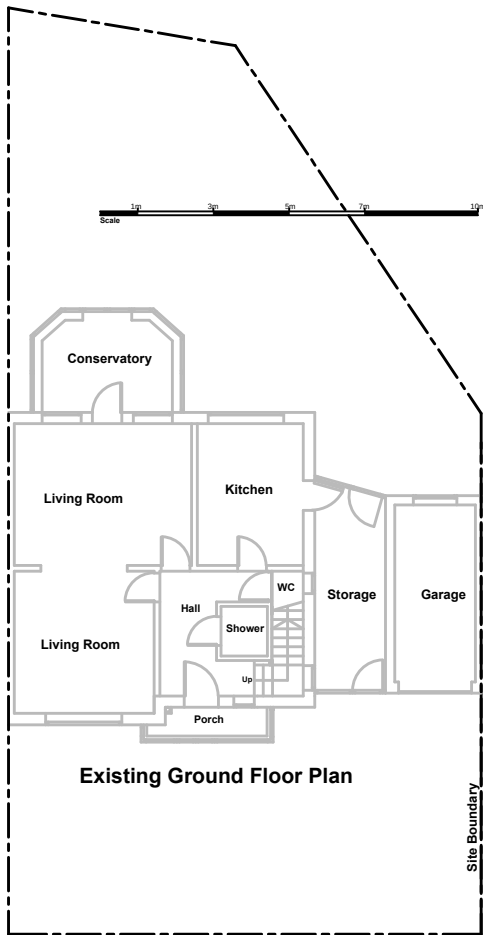

Project Name:
Proposed Double Storey Side Extension

Drawing Name:
Existing & As Built Site Plans

Project Address:
13 Shawdene Road,
Northenden,
Manchester, M22 4BY

Project Ref: MK/PA092002

Date: 25.06.24

Scale: 1:200

Paper Size: A3

Sheet:

01

Rev: