

This drawing shall not be scaled.
Work from the dimensions shown. In the drawing or given in relevant specifications

1No. CLEANERS POWER SOCKET INTRODUCED

NO CHANGES TO HEATING OR VENTILATION IN THIS ROOM.

REMOVE EXISTING LIGHTING. PROVIDE AND INSTALL NEW SUSPENDED LED LUMINAIRES AND CONNECT TO EXISTING POWER AND CONTROLS. SELECT LUMINAIRES TO ACHIEVE A LIGHTING LEVEL OF 300 LUX AND A UNIFORMITY OF 0.6 OVER THE TASK AREA.

FITTINGS TO BE CONSISTENT WITH OTHER REFURBISHED SPACES AND TO BE AGREED WITH THE ARCHITECT.

PRECEDENT PHOTOGRAPHS.



REMOVE DADO.

NO CHANGES TO HEATING OR VENTILATION IN THIS ROOM.

ANY CEILING MOUNTED SERVICES SUCH AS SMOKE DETECTOR / FIRE ALARM TO BE CAREFULLY RELOCATED TO THE SOFFIT. ADDITIONAL DETECTORS TO BE PROVIDED IF NECESSARY TO MAINTAIN COVERAGE.





REMOVE EXISTING LIGHTING. PROVIDE AND INSTALL NEW SUSPENDED LED LUMINAIRES AND CONNECT TO EXISTING POWER AND CONTROLS. SELECT LUMINAIRES TO ACHIEVE A LIGHTING LEVEL OF 300 LUX AND A UNIFORMITY OF 0.6 OVER THE TASK AREA.

FITTINGS TO BE CONSISTENT WITH OTHER REFURBISHED SPACES AND TO BE AGREED WITH THE ARCHITECT.

NO CHANGES TO HEATING OR VENTILATION IN THIS ROOM.

PROVIDE POWER TO 1NO. MEETING POD VIA VERTICAL CONDUIT IN ALCOVE BEHIND POD.

PRECEDENT PHOTOGRAPHS.

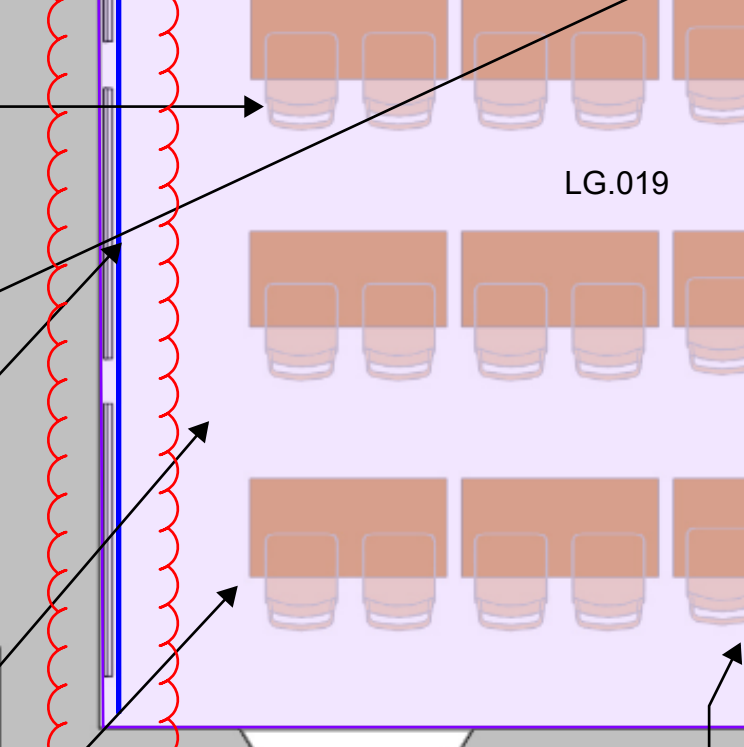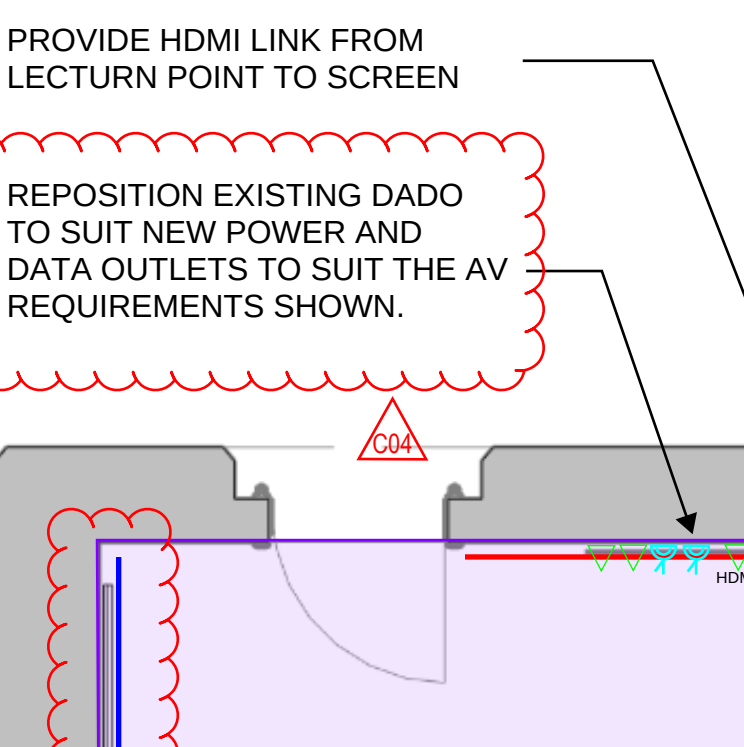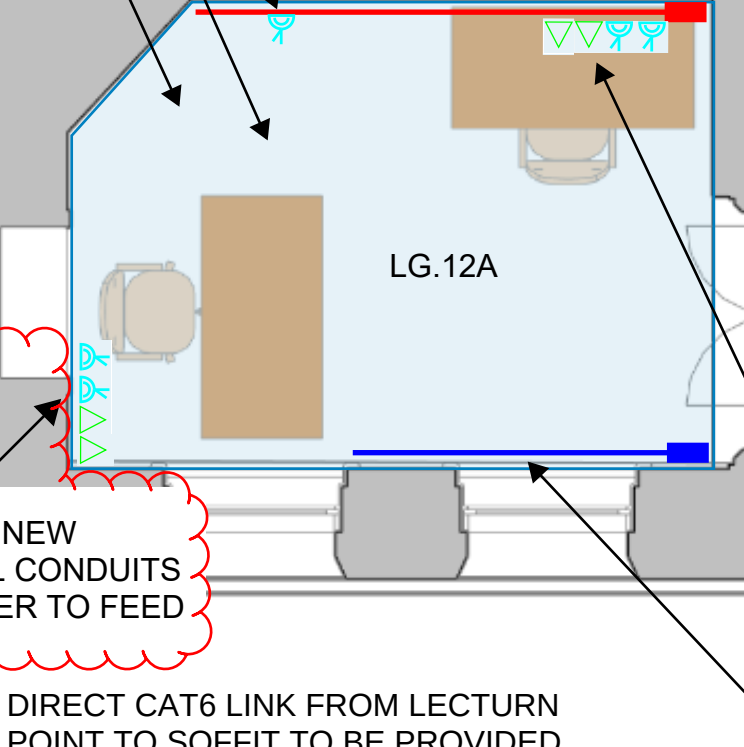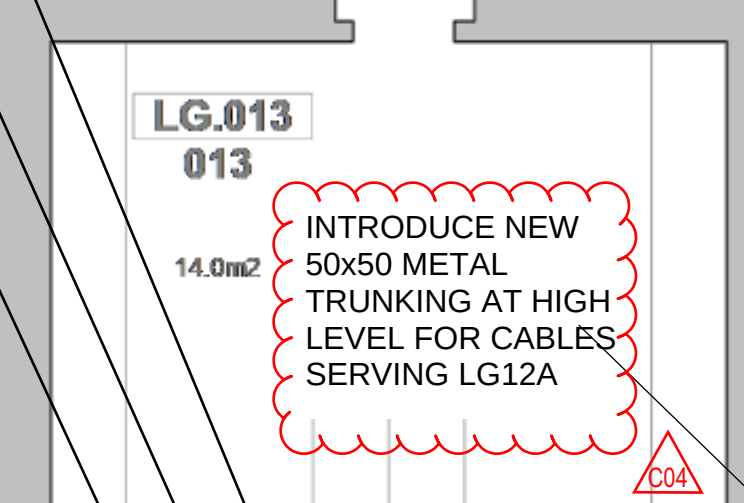

REMOVE DADO.

NO CHANGES TO HEATING OR VENTILATION IN THIS ROOM.

ANY CEILING MOUNTED SERVICES SUCH AS SMOKE DETECTOR / FIRE ALARM TO BE CAREFULLY RELOCATED TO THE SOFFIT. ADDITIONAL DETECTORS TO BE PROVIDED IF NECESSARY TO MAINTAIN COVERAGE.





REMOVE EXISTING LIGHTING. PROVIDE AND INSTALL NEW SUSPENDED LED LUMINAIRES AND CONNECT TO EXISTING POWER AND CONTROLS. SELECT LUMINAIRES TO ACHIEVE A LIGHTING LEVEL OF 300 LUX AND A UNIFORMITY OF 0.6 OVER THE TASK AREA.

FITTINGS TO BE CONSISTENT WITH OTHER REFURBISHED SPACES AND TO BE AGREED WITH THE ARCHITECT.

NO CHANGES TO HEATING OR VENTILATION IN THIS ROOM.

PROVIDE POWER TO 1NO. MEETING POD VIA VERTICAL CONDUIT IN ALCOVE BEHIND POD.

PRECEDENT PHOTOGRAPHS.

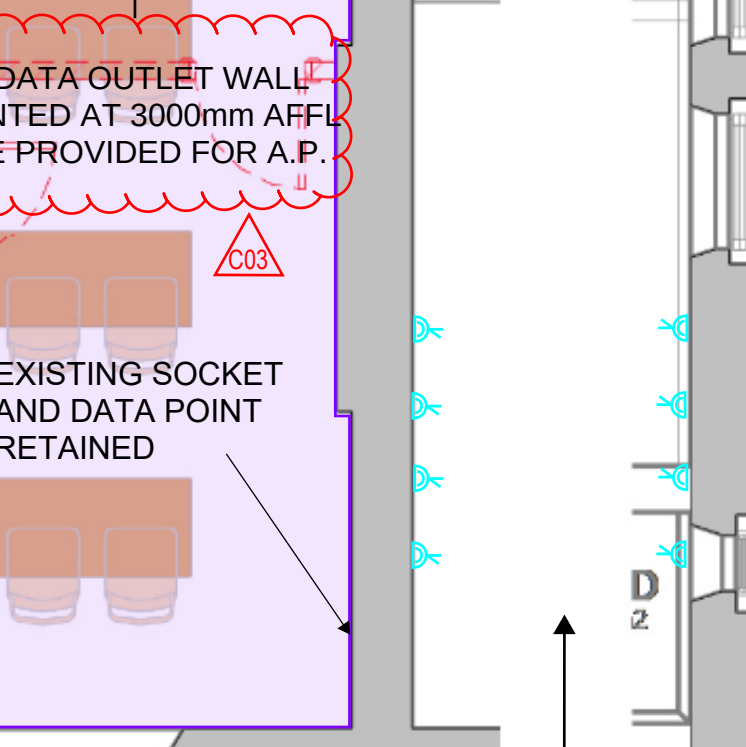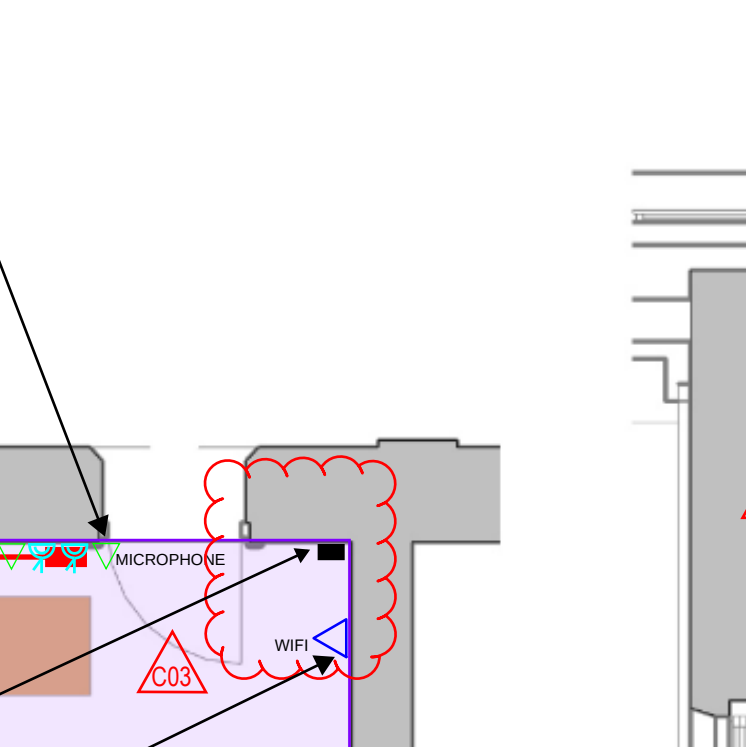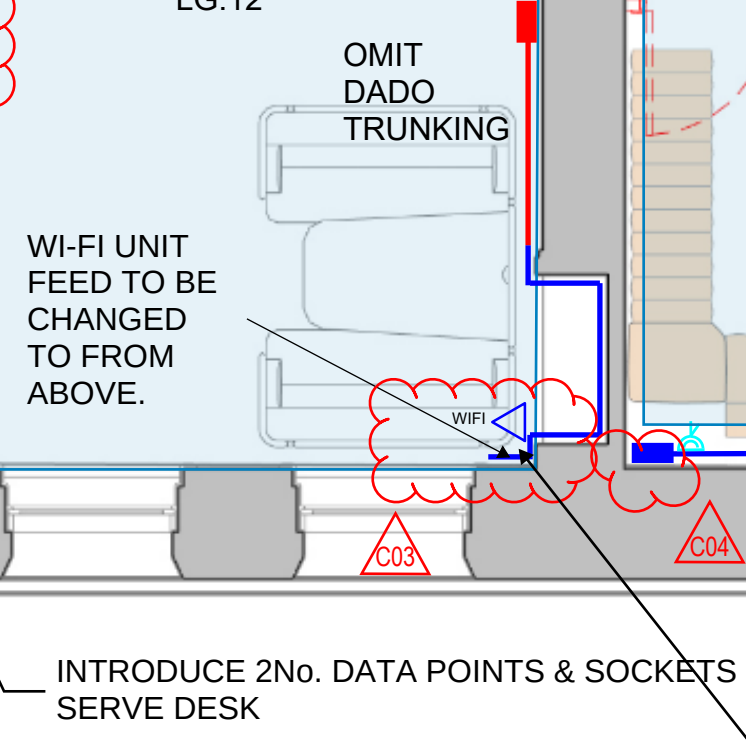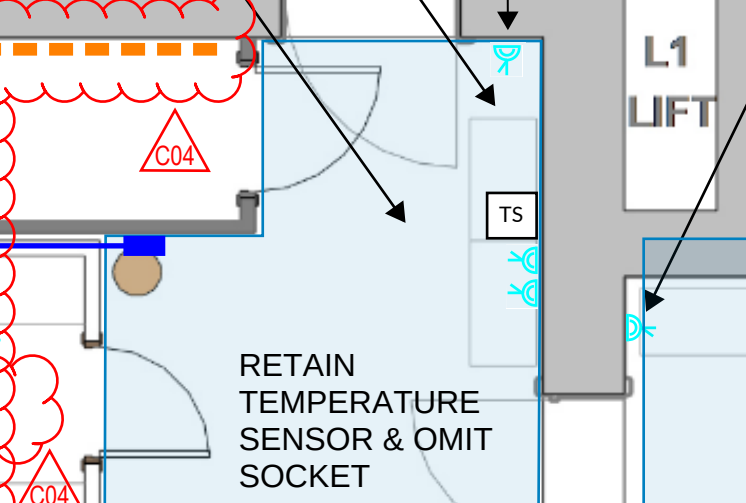

REMOVE DADO.

NO CHANGES TO HEATING OR VENTILATION IN THIS ROOM.

ANY CEILING MOUNTED SERVICES SUCH AS SMOKE DETECTOR / FIRE ALARM TO BE CAREFULLY RELOCATED TO THE SOFFIT. ADDITIONAL DETECTORS TO BE PROVIDED IF NECESSARY TO MAINTAIN COVERAGE.





REMOVE EXISTING LIGHTING. PROVIDE AND INSTALL NEW SUSPENDED LED LUMINAIRES AND CONNECT TO EXISTING POWER AND CONTROLS. SELECT LUMINAIRES TO ACHIEVE A LIGHTING LEVEL OF 300 LUX AND A UNIFORMITY OF 0.6 OVER THE TASK AREA.

FITTINGS TO BE CONSISTENT WITH OTHER REFURBISHED SPACES AND TO BE AGREED WITH THE ARCHITECT.

NO CHANGES TO HEATING OR VENTILATION IN THIS ROOM.

PROVIDE POWER TO 1NO. MEETING POD VIA VERTICAL CONDUIT IN ALCOVE BEHIND POD.

PRECEDENT PHOTOGRAPHS.

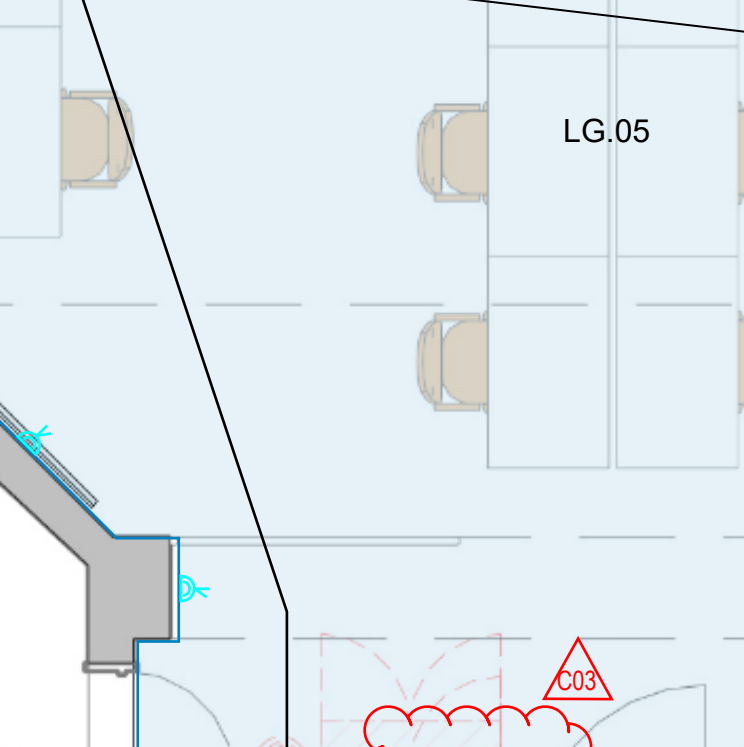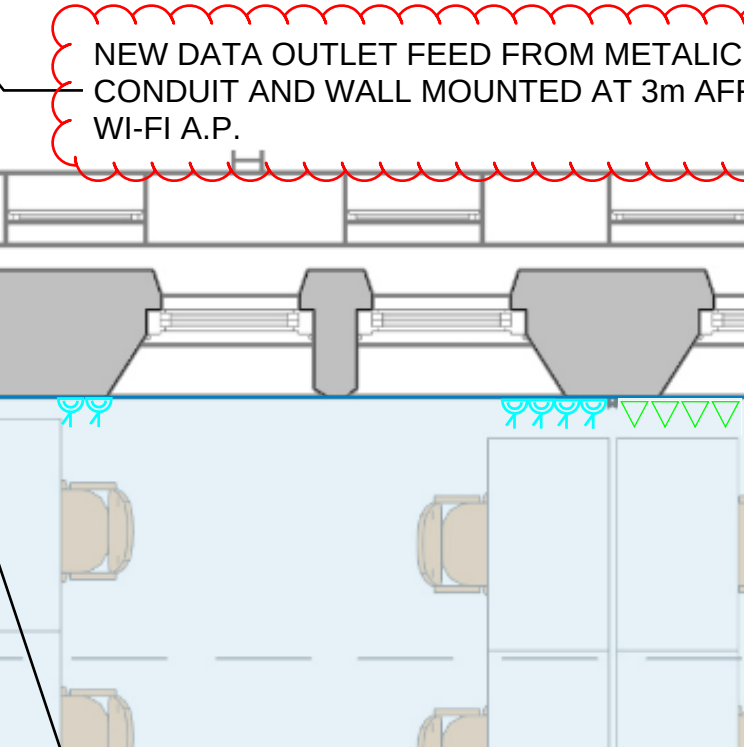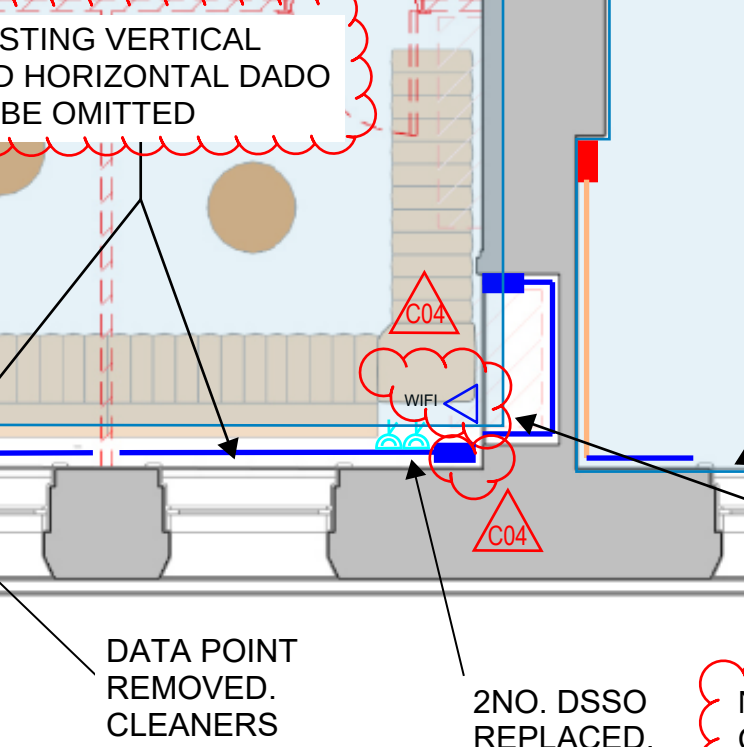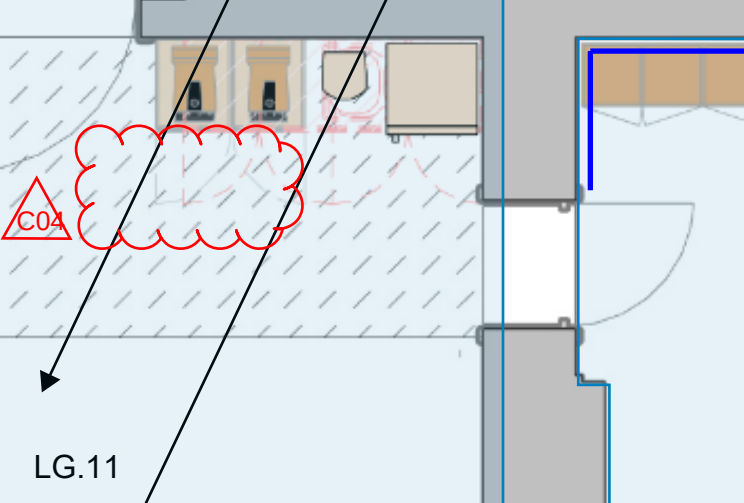

REMOVE DADO.

NO CHANGES TO HEATING OR VENTILATION IN THIS ROOM.

ANY CEILING MOUNTED SERVICES SUCH AS SMOKE DETECTOR / FIRE ALARM TO BE CAREFULLY RELOCATED TO THE SOFFIT. ADDITIONAL DETECTORS TO BE PROVIDED IF NECESSARY TO MAINTAIN COVERAGE.





REMOVE EXISTING LIGHTING. PROVIDE AND INSTALL NEW SUSPENDED LED LUMINAIRES AND CONNECT TO EXISTING POWER AND CONTROLS. SELECT LUMINAIRES TO ACHIEVE A LIGHTING LEVEL OF 300 LUX AND A UNIFORMITY OF 0.6 OVER THE TASK AREA.

FITTINGS TO BE CONSISTENT WITH OTHER REFURBISHED SPACES AND TO BE AGREED WITH THE ARCHITECT.

NO CHANGES TO HEATING OR VENTILATION IN THIS ROOM.

PROVIDE POWER TO 1NO. MEETING POD VIA VERTICAL CONDUIT IN ALCOVE BEHIND POD.

PRECEDENT PHOTOGRAPHS.

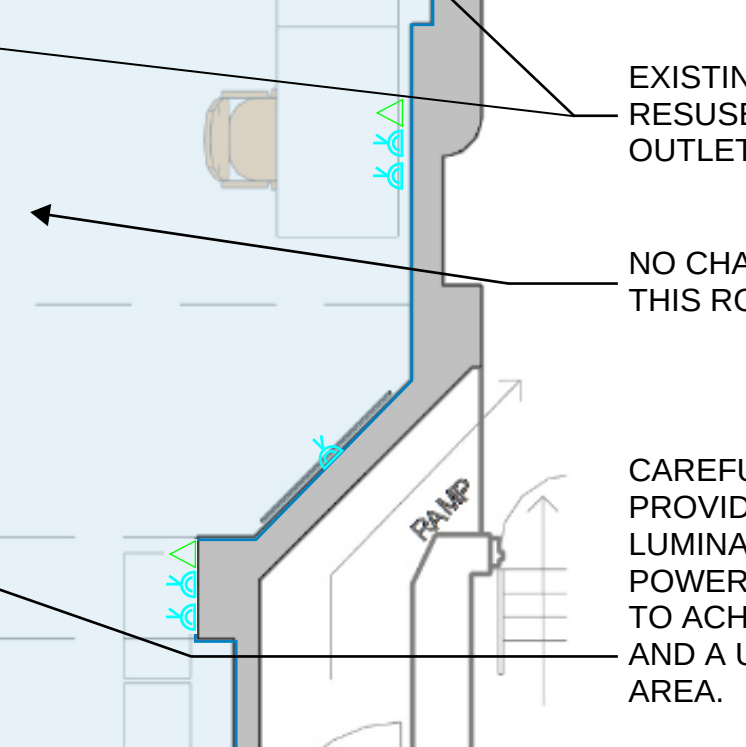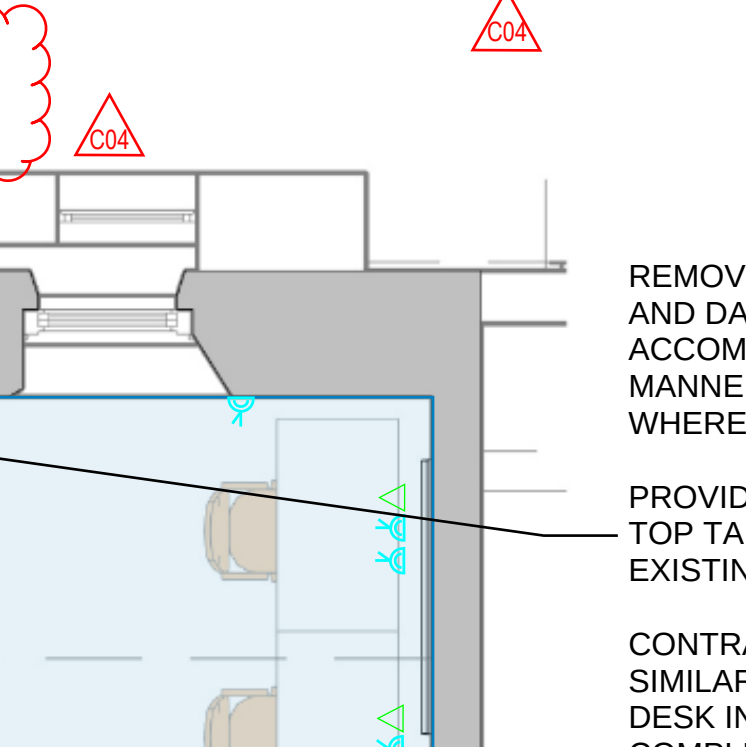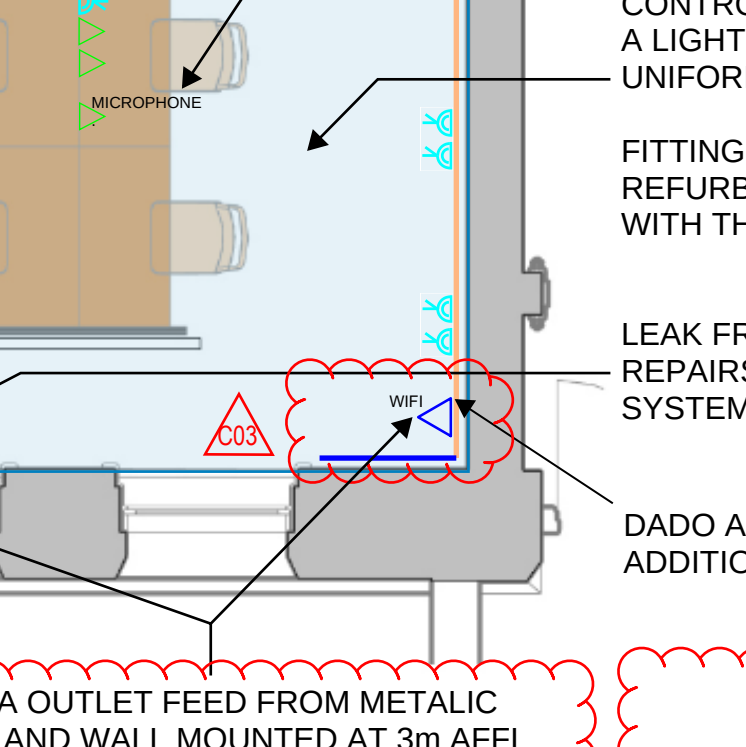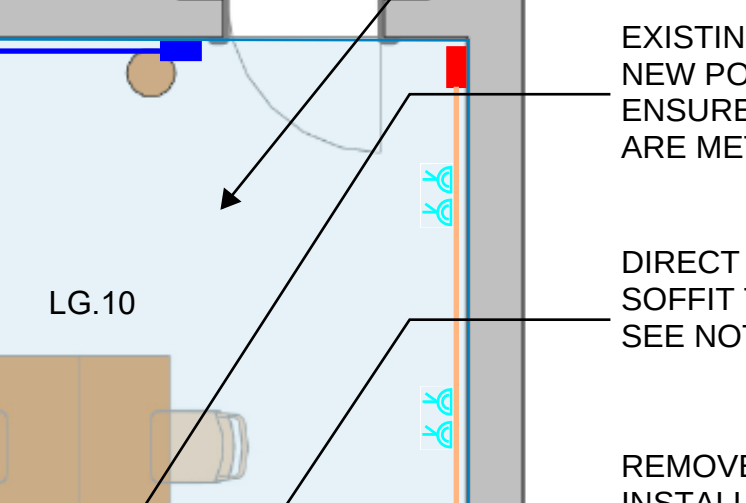

REMOVE DADO.

NO CHANGES TO HEATING OR VENTILATION IN THIS ROOM.

ANY CEILING MOUNTED SERVICES SUCH AS SMOKE DETECTOR / FIRE ALARM TO BE CAREFULLY RELOCATED TO THE SOFFIT. ADDITIONAL DETECTORS TO BE PROVIDED IF NECESSARY TO MAINTAIN COVERAGE.





REMOVE EXISTING LIGHTING. PROVIDE AND INSTALL NEW SUSPENDED LED LUMINAIRES AND CONNECT TO EXISTING POWER AND CONTROLS. SELECT LUMINAIRES TO ACHIEVE A LIGHTING LEVEL OF 300 LUX AND A UNIFORMITY OF 0.6 OVER THE TASK AREA.

FITTINGS TO BE CONSISTENT WITH OTHER REFURBISHED SPACES AND TO BE AGREED WITH THE ARCHITECT.

NO CHANGES TO HEATING OR VENTILATION IN THIS ROOM.

PROVIDE POWER TO 1NO. MEETING POD VIA VERTICAL CONDUIT IN ALCOVE BEHIND POD.

PRECEDENT PHOTOGRAPHS.

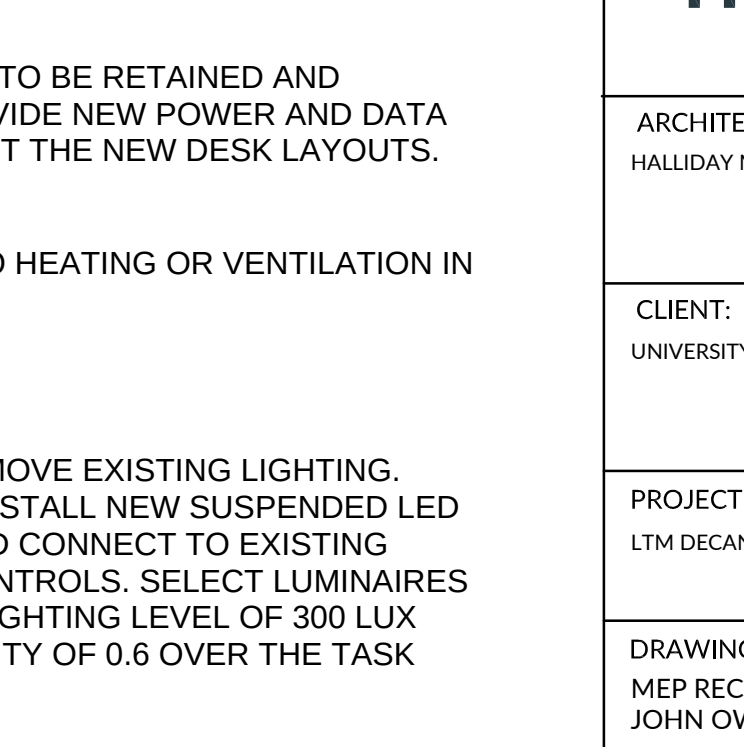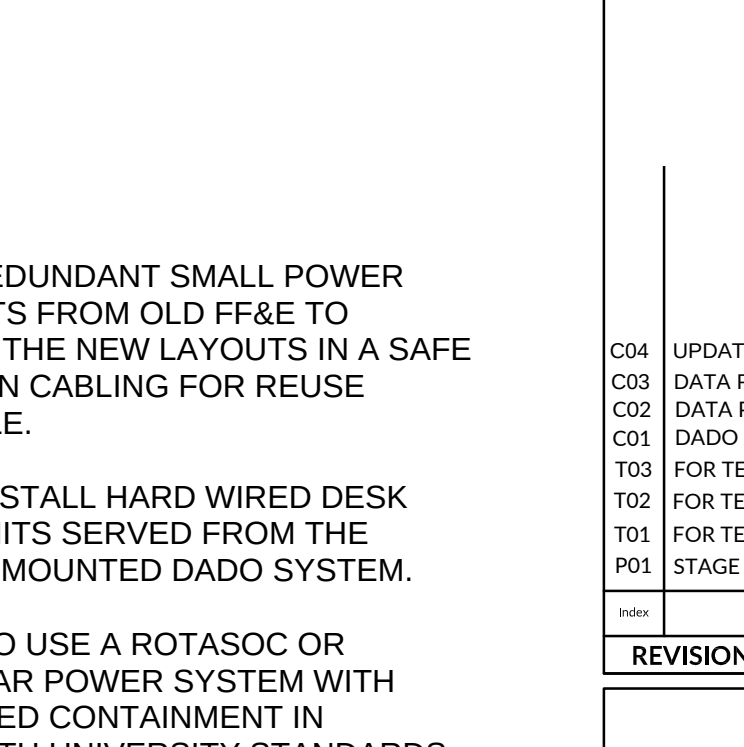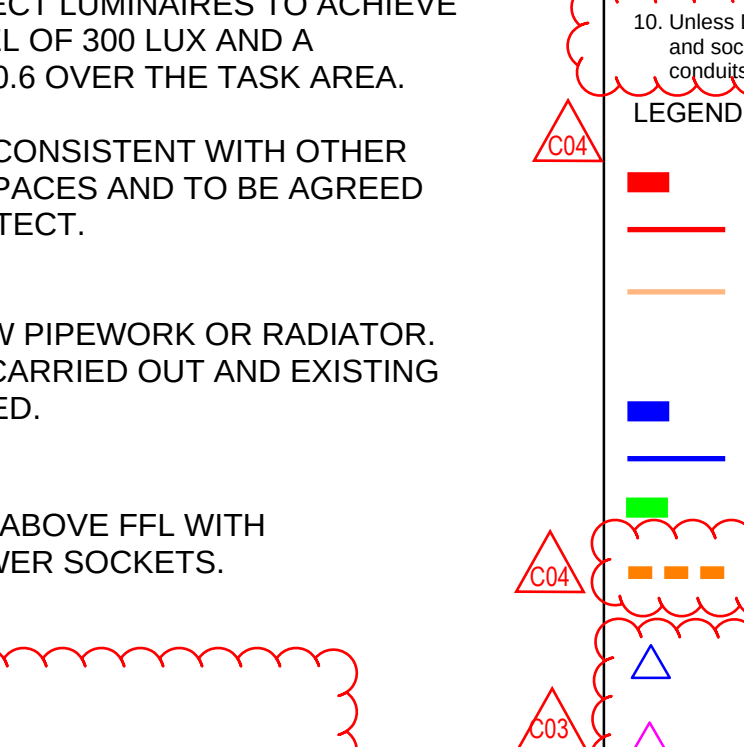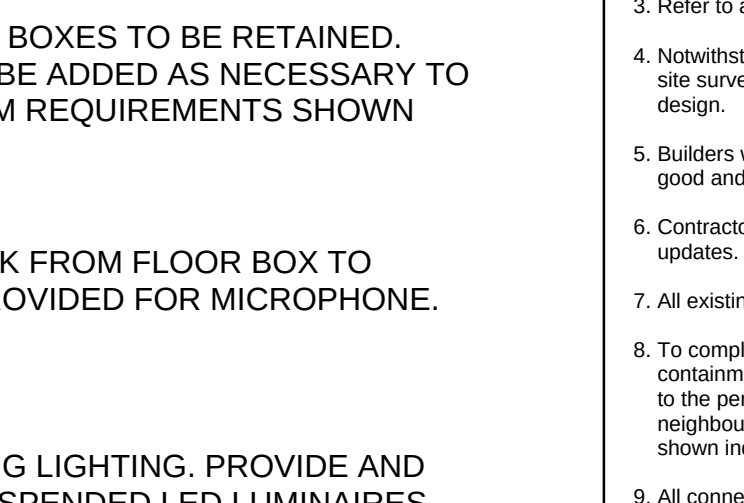

REMOVE DADO.

NO CHANGES TO HEATING OR VENTILATION IN THIS ROOM.

ANY CEILING MOUNTED SERVICES SUCH AS SMOKE DETECTOR / FIRE ALARM TO BE CAREFULLY RELOCATED TO THE SOFFIT. ADDITIONAL DETECTORS TO BE PROVIDED IF NECESSARY TO MAINTAIN COVERAGE.

CDM Regulations:

In addition to any information included in this drawing or the model from which it is derived, refer also to the project CDM Risk Register for information on residual risks.

General Notes:

- The drawing does not necessarily show all the information needed to interpret the design intent or the construction details.
- The drawing contains information from more than one source and must be read in conjunction with all relevant specifications.
- Any apparent drafting errors and differences between other drawings and specifications shall be brought to our attention.

Project Notes:

- The Contractor shall take full responsibility for the detailed design process and allow for the verification of all information provided on the design intent drawings.
- Refer to architect's information for final positions and heights of equipment.
- Refer to as-built layouts for further information on existing services
- Notwithstanding the above, the contractor shall allow for a detailed site survey to verify MEP positions and locations prior to completing design.
- Builders work in connection including holes through walls, making good and fire stopping, as necessary for a complete installation.
- Contractor to provide as-installed drawings and O&M manual updates.
- All existing data points to be retained and kept active.
- To comply with the Listed Building Consent all wiring and containment must be installed in an unobtrusive manner and routed to the perimeter of rooms where possible. The precedent in neighbouring, recently refurbished spaces must be followed as shown indicatively on the precedent photographs.
- All connections for AV equipment including HDMI and microphone connections to be agreed and coordinated with the University's AV Development & Installation Coordinator.
- Unless Dado trunking is provided for mounting the data ports and sockets, all other outlets would be feed from metallic G.I conduits with painted out to match wall color.

LEGEND

- EXISTING VERTICAL DADO RETAINED.
- EXISTING HORIZONTAL DADO RETAINED.
- EXISTING HORIZONTAL DADO LOWERED TO 450mm ABOVE FFL WITH NO. OF EXISTING SOCKETS RETAINED.
- EXISTING VERTICAL DADO OMITTED.
- EXISTING HORIZONTAL DADO OMITTED.
- NEW VERTICAL DADO.
- NEW 50mm x 50mm METAL TRUNKING
- NEW 2 GANG RJ45 DATA OUTLET FOR WI-FI A.P.
- EXISTING 2 GANG RJ45 DATA OUTLET FOR WI-FI A.P.

CDM	Update as per comment	EY	RCM	RCM	05/24
C04	DATA POINTS FOR WI-FI A.P	EY	RCM	RCM	05/24
C02	DATA POINTS AMENDED	LW	RCM	RCM	05/24
C01	DADO ALTERATIONS ADDED	HW	RCM	RCM	03/24
T03	FOR TENDER	RCM	SM	RCM	02/24
T02	FOR TENDER	RCM	SM	RCM	02/24
T01	FOR TENDER	RCM	SM	RCM	02/24
P01	STAGE 2 - FOR COMMENT	RCM	SM	RCM	01/24
Notes	Description	Designed	Reviewed	Authorised	Date
REVISIONS:					

HOARE LEA H.

ARCHITECT:
HALLIDAY MEACHAM

CLIENT:
UNIVERSITY OF MANCHESTER

PROJECT TITLE:
LTM DECANT STRATEGY

DRAWING TITLE:
MEP RECONFIGURATIONS
JOHN OWENS BUILDING

TENDER ISSUE

PERSON RESPONSIBLE FOR:

Design: RCM	Review:	Authorising Issue: RCM
Project No: 04/06198	Date: 15.02.24	Scale @ A1: NTS
DRAWING NUMBER:	Status:	Rev:
0406198-HLEA-01-B1-DR-U-001	S2	C02