




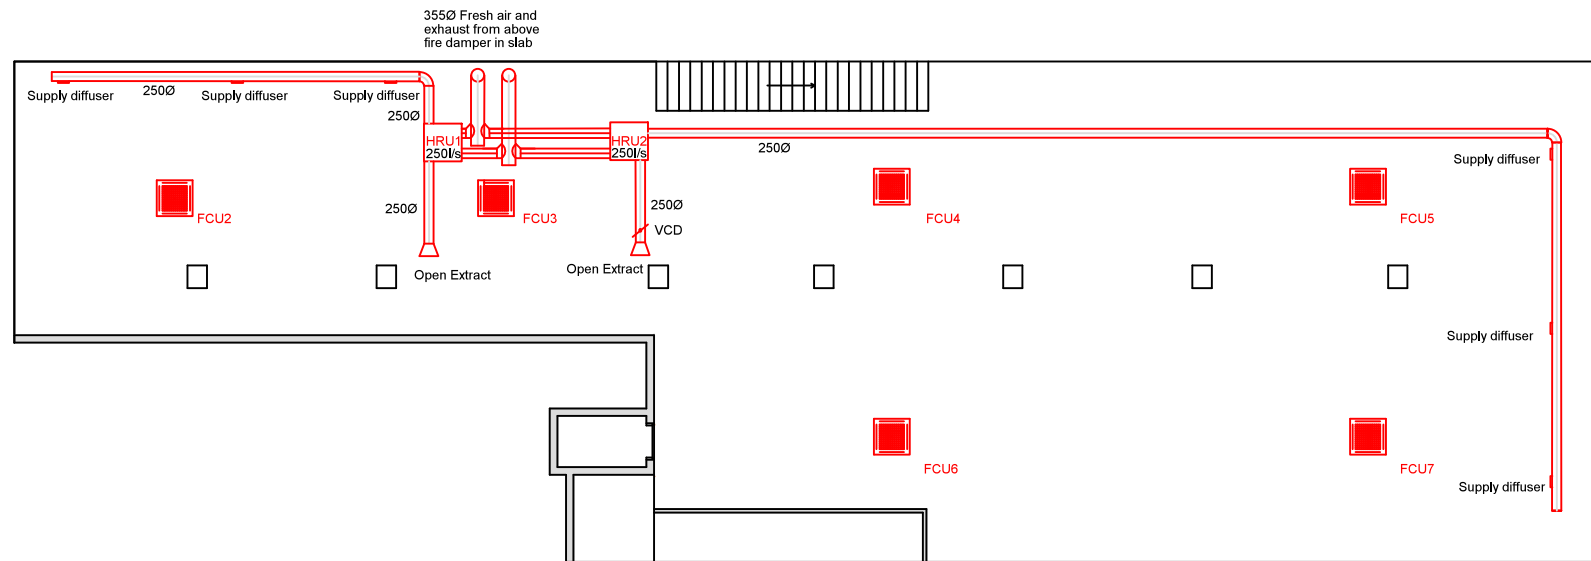

PROPOSED BASEMENT FLOOR - SCALE 1:100

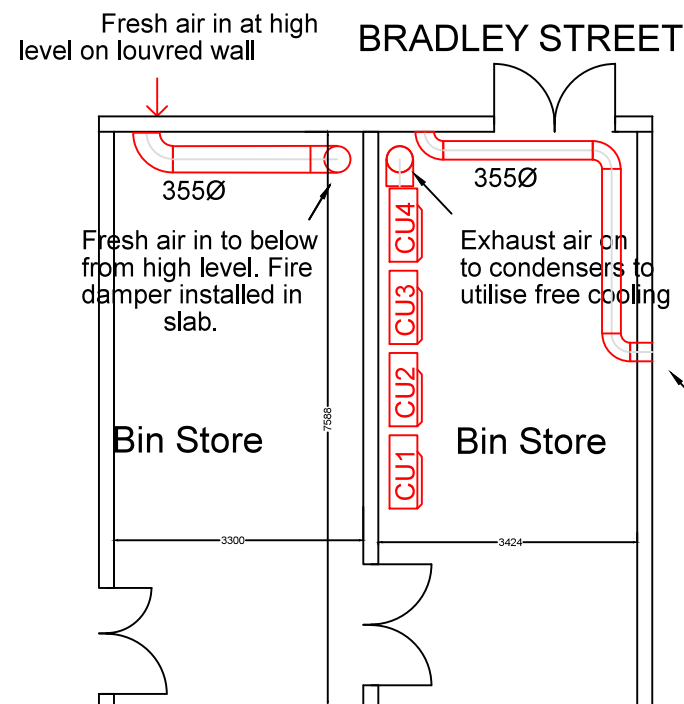

PROPOSED BIN STORE AREA - SCALE 1:50

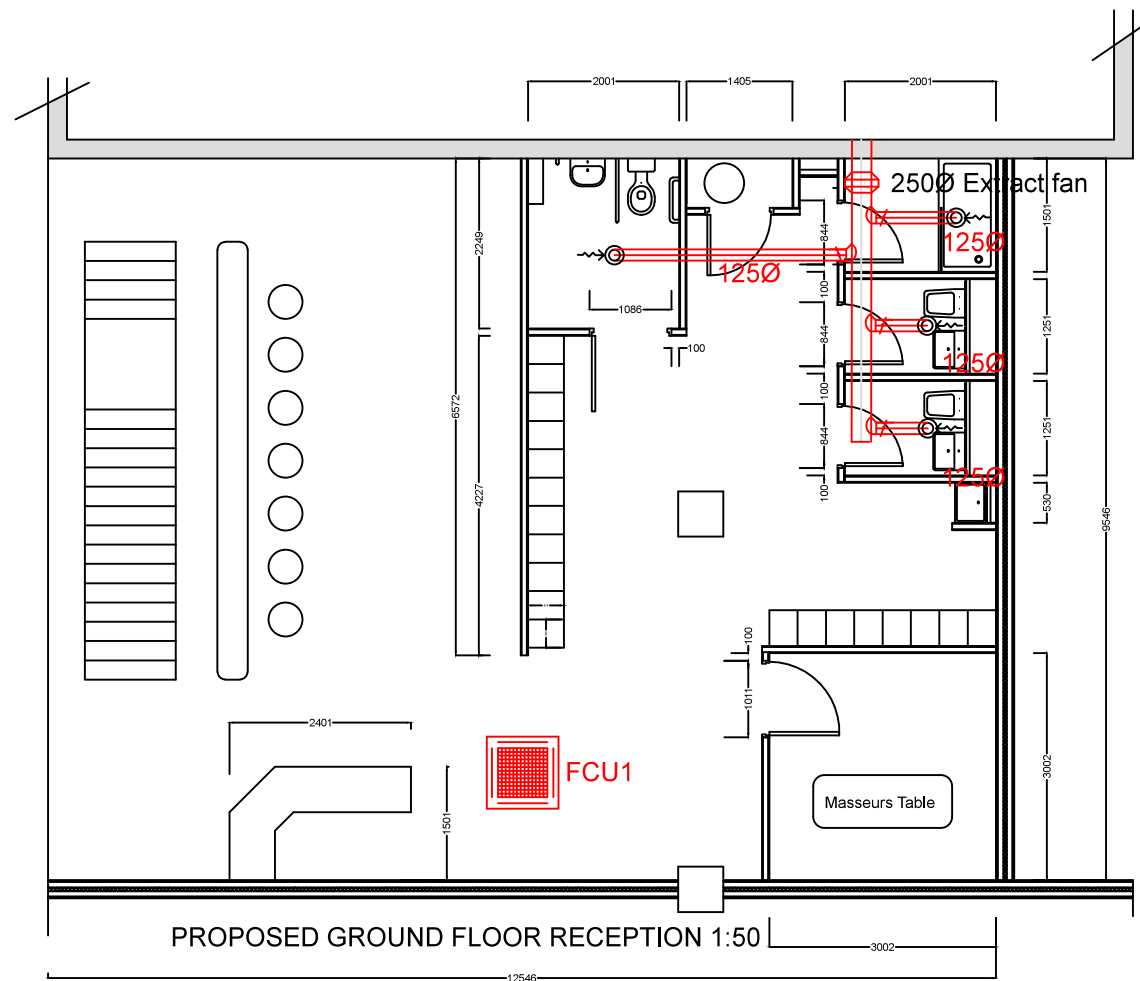

PROPOSED GROUND FLOOR RECEPTION 1:50

Property Precision Services Ltd 20 Plumley Road Handflorth Wilmslow SK9 3RR			
STATUS	AS INSTALLED		
CLIENT	PH PROJECTS		
CONTRACT	VENTILATION FEDERATION GYM SPEAR STREET, MANCHESTER		
TITLE	VENTILATION AND AIR CONDITIONING LAYOUT GROUND AND BASEMENT FLOOR		
DRAWN BY	NB	SCALE	SEE DRAWING @ A1
DATE	23-10-23	APPROVED	-
DRG. No.	V6107/M01		REV.
			-