


VISUAL SCALE 1:100 @ A3




01_E-Elevation
1 : 100

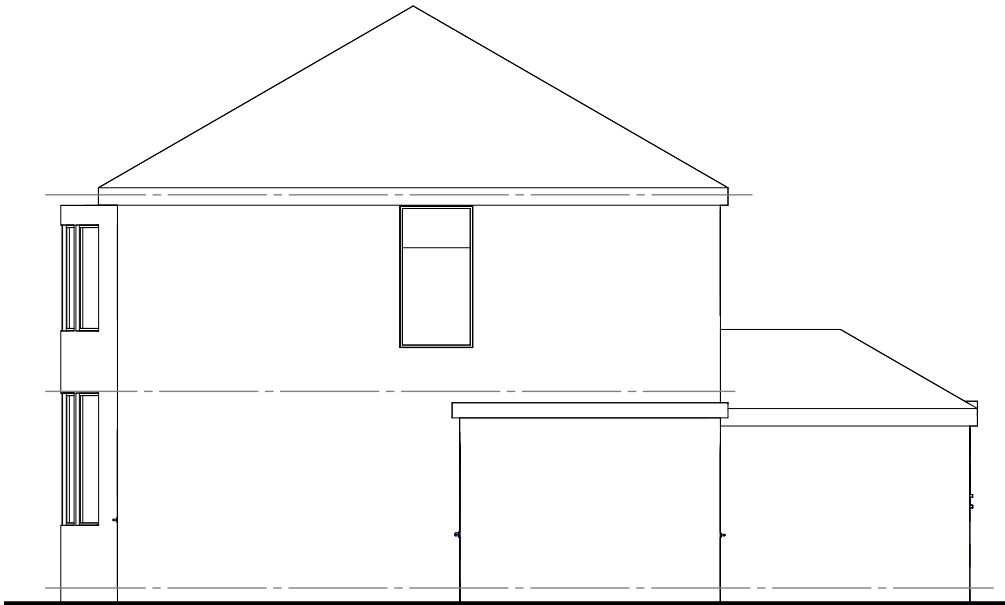

02_E-Elevation
1 : 100



03_E-Elevation
1 : 100

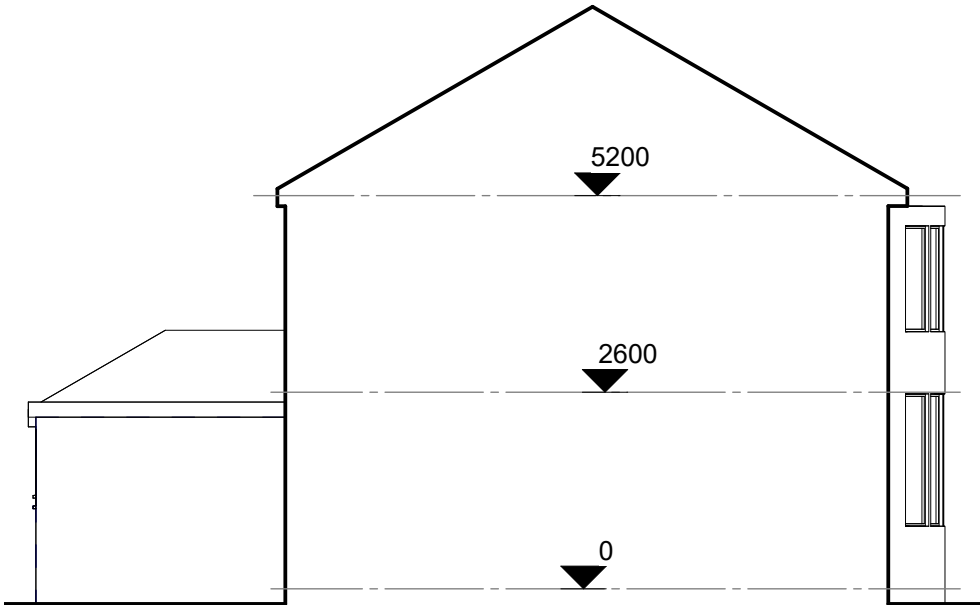

04_E-Elevation
1 : 100

COPYRIGHT © ALL RIGHTS RESERVED BY VIKAS ALYAS LTD. DO NOT SCALE FROM DRAWING. DRAWING INDICATES DESIGN INTENT ONLY. REPORT ANY DISCREPANCIES TO CLIENT / VA LTD. NOT TO BE USED FOR CONSTRUCTION UNLESS STATED SO. TO BE READ IN CONJUNCTION WITH OTHER DRAWINGS OR SPECIFICATION WHERE PROVIDED.



0161 511 8479

vikas@architek.uk
916 Stockport Road, Levenshulme, Manchester, M19 3AB

No.	Description	Date
P1	Issue to Planning	25.06.2024

PROJECT	
Retrospective single storey extension to side and rear elevations	
Manchester City Council	PURPOSE OF ISSUE Planning

ADDRESS	1232_94 Parrs Wood Rd, Manchester M20 4RP
SHEET	Asbuilt Elevations

CLIENT		
Mr Ismail Altaf		
Date 25.06.2024	Project number 1232	Scale (@ A3) 1 : 100
Drawn by VA	DRAWING NUMBER A103	REV
Checked by VA		P1