


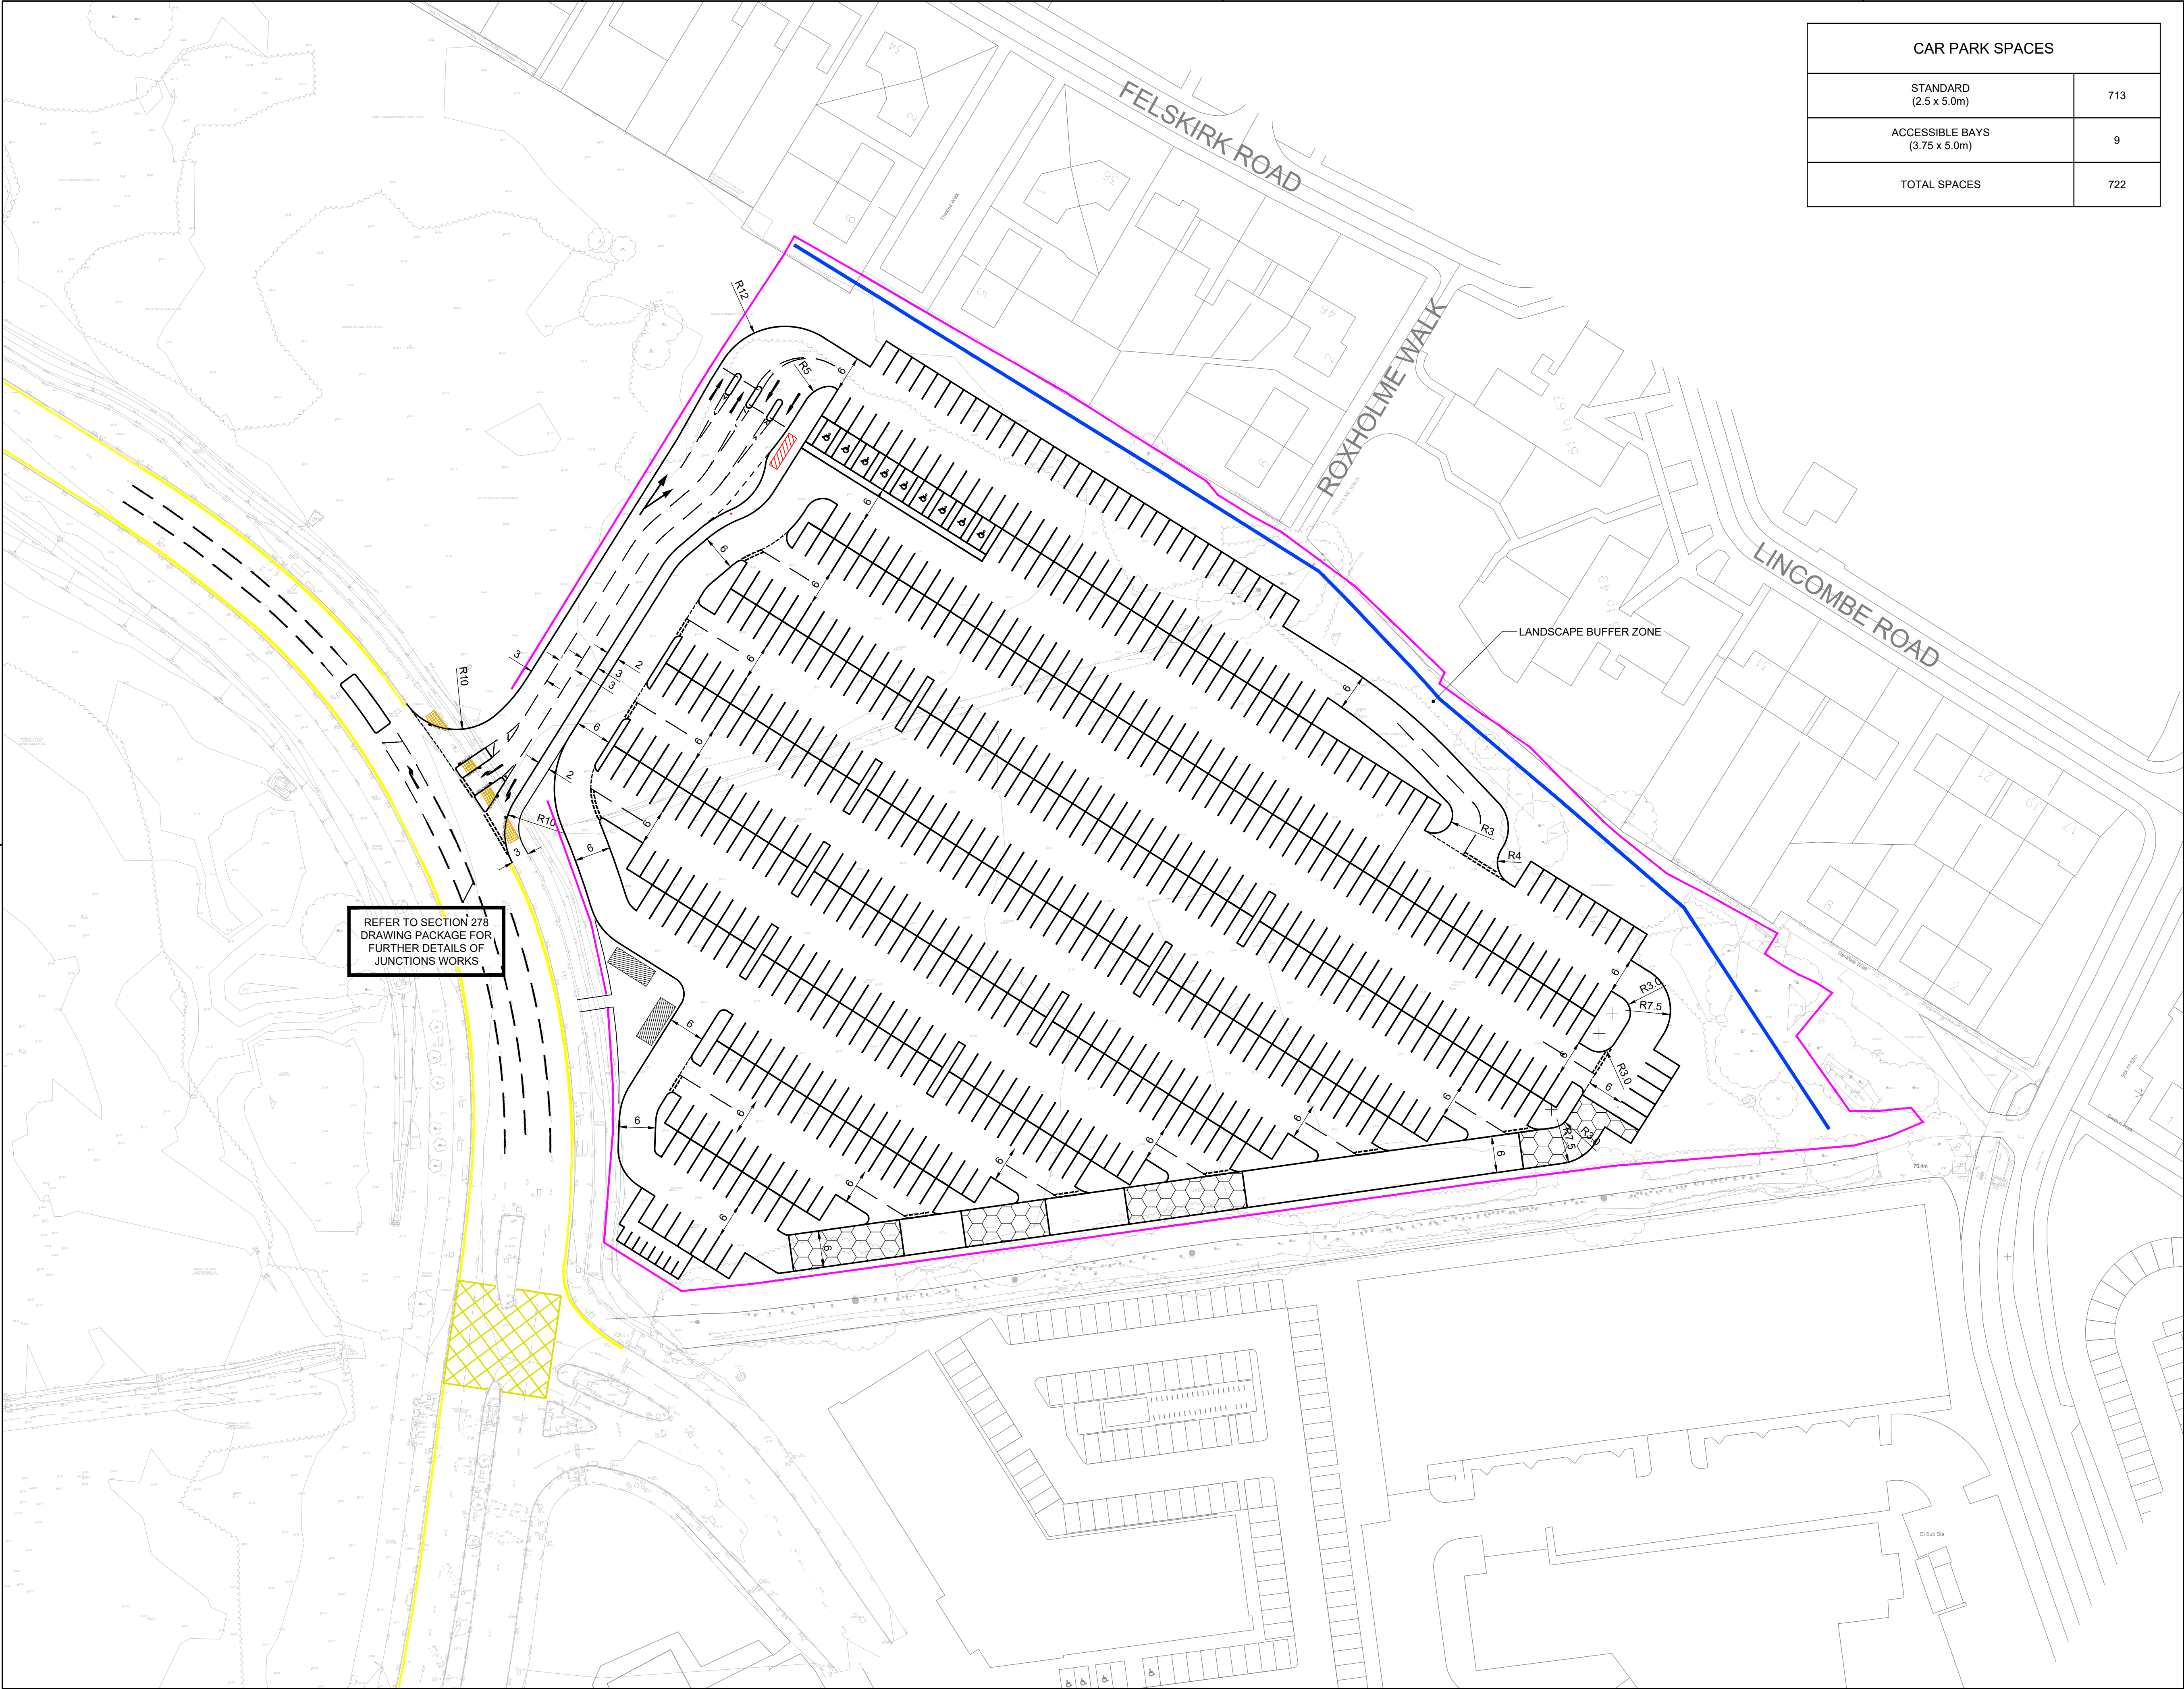

REFER TO SECTION 278
DRAWING PACKAGE FOR
FURTHER DETAILS OF
JUNCTIONS WORKS

CAR PARK SPACES	
STANDARD (2.5 x 5.0m)	713
ACCESSIBLE BAYS (3.75 x 5.0m)	9
TOTAL SPACES	722

- THIS DRAWING IS THE PROPERTY OF R&Cp. COPYRIGHT IS RESERVED BY THEM AND THE DRAWING IS ISSUED ON THE CONDITION THAT IT IS NOT COPIED, REPRODUCED, RETAINED OR DISCLOSED TO ANY UNAUTHORISED PERSON EITHER WHOLLY OR IN PART WITHOUT THE WRITTEN CONSENT OF R&Cp
- NOTES
- ALL DIMENSIONS ARE IN METRES UNLESS STATED OTHERWISE.
 - THIS DRAWING SHALL BE READ IN CONJUNCTION WITH ALL OTHER RELEVANT ARCHITECTURAL AND ENGINEERING DETAILS, DRAWINGS AND SPECIFICATIONS.
 - ANY DISCREPANCIES SHOULD BE REPORTED TO THE ENGINEER IMMEDIATELY SO THAT CLARIFICATION CAN BE SOUGHT PRIOR TO THE COMMENCEMENT OF WORK.
 - UNDERGROUND SERVICES MAY BE PRESENT IN THE AREA. THE CONTRACTOR SHALL ESTABLISH THE PRECISE LINE AND DEPTH OF ALL SERVICES PRIOR TO COMMENCING ANY EXCAVATION WORKS

KEY

THIS DRAWING REPRESENTS THE FINAL CONSTRUCTION VERSION ISSUED TO THE CONTRACTOR INCORPORATING AMENDMENTS MADE DURING CONSTRUCTION. IT IS BASED ON PERIODIC SITE INSPECTIONS AND CONTRACTOR RECORDS INCLUDING THEIR AS BUILT DRAWINGS

3	02.02.2024	FINAL ISSUE 2	SJB	PAW
2	22.12.2020	FINAL ISSUE	RM	PAW
1	23.07.2020	DESIGN UPDATED TO SUIT BOUNDARY ISSUES: CABIN REMOVED	RM	PAW
T3	08/11/2019	LAYOUT UPDATED	PAW	PAW
T2	03/09/2019	SITE BOUNDARY REVISED	RM	PW
T1	21/08/2019	TENDER ISSUE	RM	PW
P10	19/08/2019	PLANNING SUBMISSION	RM	PW
P9	12/08/2019	BACKGROUND & BOUNDARY UPDATED	PAW	PW
P8	02/08/2019	BACKGROUND UPDATED	PAW	PW
P7	23/07/2019	DISABLED BAYS ADJUSTED	TS	PW
P6	19/07/2019	PARKING SPACE TABLE AMENDED	TS	PW
P5	18/07/2019	DISABLED BAYS RELOCATED FOOTWAY ARRANGEMENT AND MOTORCYCLE BAYS AMENDED	PW	PW
P4	10/07/2019	UPDATED FOLLOWING CLIENT COMMENTS	PW	PW
P3	01/07/2019	UPDATED FOLLOWING CLIENT COMMENTS	TS	PW
P2	25/06/2019	UPDATED FOLLOWING PM COMMENTS	TS	PW
P1	25/06/2019	FIRST ISSUE	TS	PW
REV.	DATE	DETAILS	DRN.	CHK.

DRAWING STATUS

RECORD DRAWING

Commercial Wharf
6 Commercial Street
Manchester M15 4PZ
T 0161 214 5390
W roccoconsulting.com

DRAWN TS	DATE 25/06/19	SCALES 1:500
CHECKED PW	DATE 25/06/19	THE ABOVE SCALES APPLY WHEN PLOTTED AT A1 SIZE --DO NOT SCALE--
APPRVD. PW	DATE 25/06/19	EMAIL FOR DRAWINGS info@roccoconsulting.com

CLIENT

MANCHESTER AIRPORT GROUP

PROJECT TITLE

PLOT X
CAR PARK

DRAWING TITLE

PROPOSED CAR PARK
AND ACCESS LAYOUT

PROJECT No.	DRAWING No.	REV.
3989	CP/001	3

© R&Cp Ltd.