

Rev	Date	Revision	By	Chk
P01	230609	Issued for Planning	KC	JA
P02	240426	Planning Addendum Draft	TR	JA
P03	240501	Planning Addendum Issue	SG	JA

Notes

For Health & Safety related information please refer to the Rolling Designers Risk Register. Where relevant, elements identified on this register are highlighted within the model and on the drawings with the following logo.

DO NOT SCALE FROM DRAWING:

- Drawing to be printed in colour;
- All information contained in this drawing (including digital data) should be checked and verified prior to any fabrication or construction. Any inconsistencies or omissions should be reported to Bennetts Associates;
- Unless otherwise stated, all grids or co-ordinates are based on the Ordnance Survey National Grid via GPS Observations;
- Unless otherwise stated, all spot heights and levels are expressed as AOD *foabove ordnance datum* based on the Ordnance Survey ODN (Ordnance Datum Newlyn).

Bennetts Associates Architects make no warranties, express or implied, with respect to the reuse of the data provided herewith, regardless of its format or the means of its transmission.

All existing survey data is based on, or reference from, 3rd Party information. Unless otherwise stated, all structural, mechanical, electrical information is based on, or reference from, 3rd Party data.

© Crown Copyright 2021. All Rights Reserved.
Ordnance Survey License 123456

- Retained Construction
- Original Construction
- Original construction - Proposed Demolition
- Non-original Construction
- Non-original Construction - Proposed Demolition

BENNETTS ASSOCIATES

Second Floor, 31 Booth Street, Manchester, M2 4AF
T +44 (0)161 674 0135 • www.bennettsassociates.com
E manchester@bennettsassociates.com
For Bennetts Associates' electronic information issue disclaimer - www.bennettsassociates.com/informationdisclaimer/


Project Project No. 2211
room2 Homotel Manchester
Piccadilly
Northside (Manchester Ltd)

Drawing Title
Planning
Demolition Ground Floor Plan

Drawing Number Revision/Suitability
HMP-BA-12-L00-DP-A-0 P03 S2

Scale @ A3 Scale @ A1 Revision Date
1:200 1 : 100 240501

YY MM DD

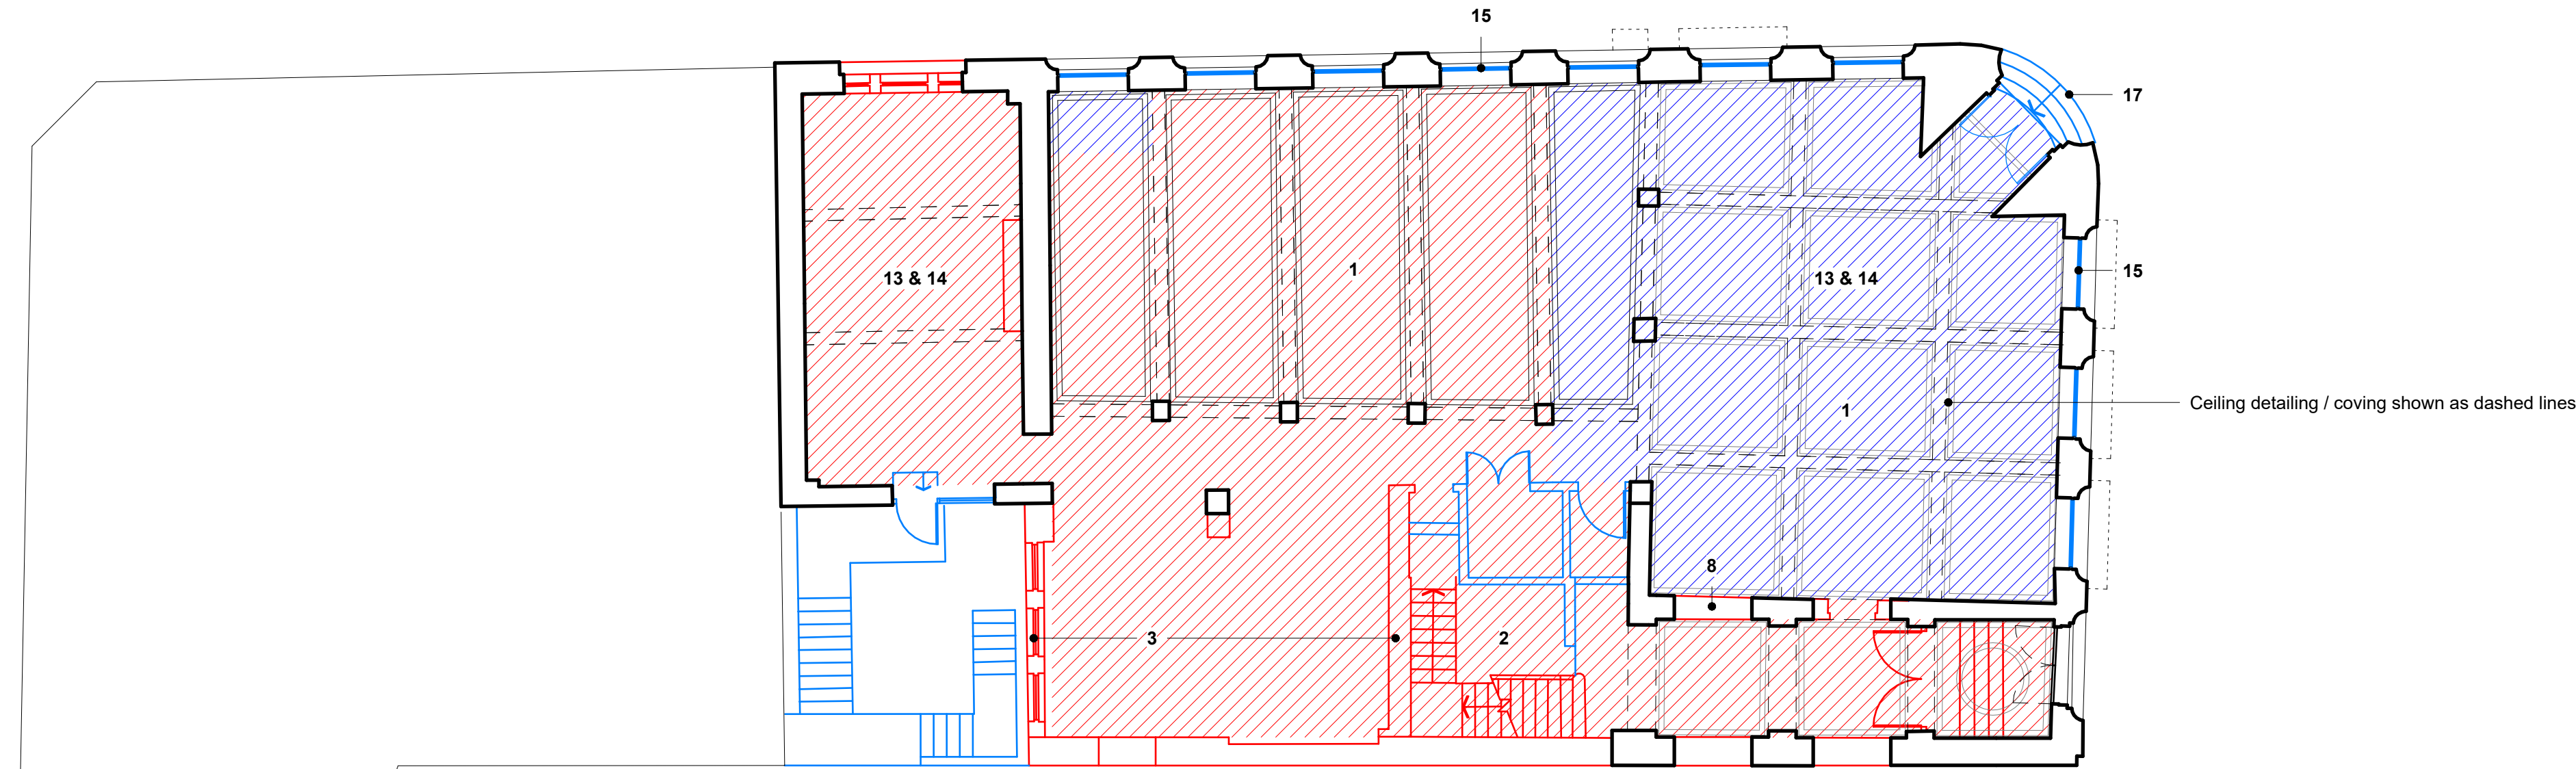

- Lowering of the ground floor slab** - The current ground floor slab level is non-original, it was later raised higher than the original banking hall that aligned with street level. The proposal will improve accessibility between the new and existing floor levels.
- Removal of the central staircase** - Staircase is utilitarian in design with low architectural significance. Removal enables the new and existing building to more successfully connect, improving accessibility, functionality and means of fire escape.
- Removal of rear part of south wall, toilet and staircase blocks** - lower significance rear elements, removal will enable the new and existing building to more successfully connect
- Infilling of rear lightwell** - Infilling of the rear lightwell allows for insertion of the new core and generates space in centre of plan for accommodation and fire escape from 12 Piccadilly
- Removal of stained glass windows to lightwell** - The design intent is to reclaim and repair these windows to be used as a design feature on the building interior
- Strategic removal basement walls** – to facilitate space for heavy plant equipment and distribution. This intervention reduces the need for plant on other floor levels, prioritised available space for amenity and front of house functions
- Insertion of new mezzanine level** - Lowering of the ground floor slab provides additional height and the insertion of a mezzanine floor generates additional space to support scheme viability
- Removal of internal walls at ground floor** - removal of these elements will form new structural openings to enable the new and existing building to more successfully connect, improving accessibility and functionality in these key front of house spaces. Marble panels to be salvaged with care and reinstated to the new openings.
- Levels 1-4 structural openings in masonry walls** - Limited / isolated structural opening formed in walls to allow connection between and into hotel rooms
- Infilling of doors and high-level internal windows** - Where existing doorway openings are present; these have been prioritised to retain to provide access into hotel rooms. Where this isn't feasible due to layout constraints, it is proposed to infill these openings
- Removal of level 2 escape stair** - Stair is non-original feature and is redundant following the removal of the external fire escape stair.
- Structural openings in floor slabs** - Openings required to enable risers and gravity water drainage system distribution from individual hotel room ensembles to basement level.
- Repair of ceilings and covings** - To restore internal heritage ceiling features, celebrating the qualities of the original building.
- General refurbishment and upgrade** - The current condition of the interiors is degraded after years of neglect and alterations. The proposal will look to refurbish the in line with modern standards and performance requirements.
- Removal of non-original windows to ground floor and levels 3-4** -Current windows to these levels are non-original, they are to be replaced with new multi pane sash windows to match the original condition.
- Sash windows refurbished** - Existing panelled sash windows to be refurbished, restored and painted
- Removal of ground floor corner stair** - This staircase is a non-original feature of the building that was installed when the banking hall was later raised higher than street level.