



VISUAL SCALE 1:100 @ A3

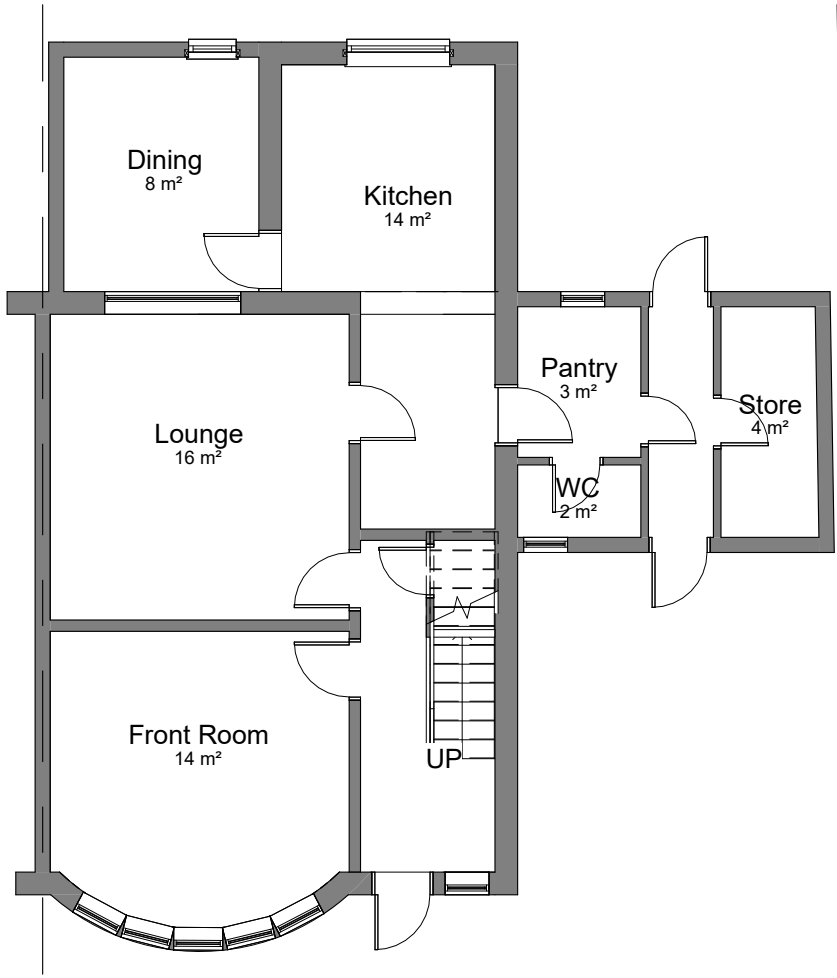

00-E-Ground Floor
1 : 100

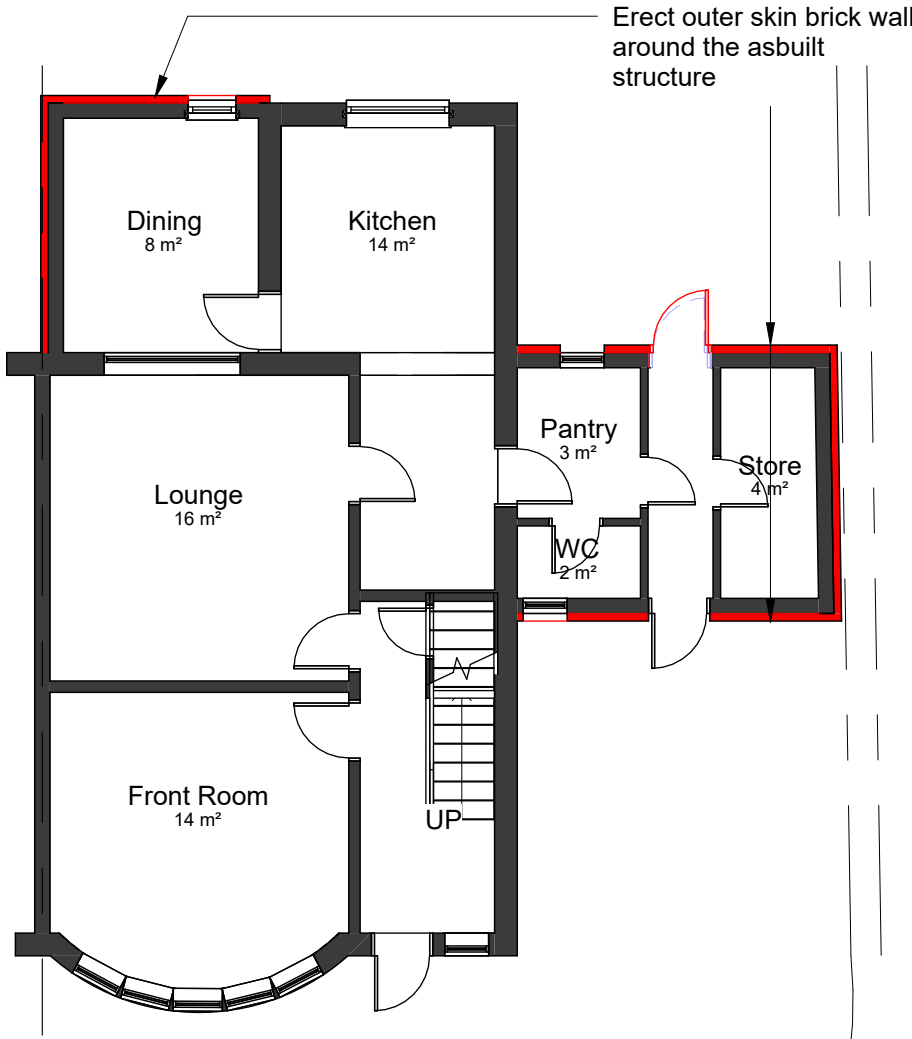

00-P-Ground Floor
1 : 100

COPYRIGHT © ALL RIGHTS RESERVED BY VIKAS ALYAS LTD. DO NOT SCALE FROM DRAWING. DRAWING INDICATES DESIGN INTENT ONLY. REPORT ANY DISCREPANCIES TO CLIENT / VA LTD. NOT TO BE USED FOR CONSTRUCTION UNLESS STATED SO. TO BE READ IN CONJUNCTION WITH OTHER DRAWINGS OR SPECIFICATION WHERE PROVIDED.



0161 511 8479

vikas@architek.uk
916 Stockport Road, Levenshulme, Manchester, M19 3AB

No.	Description	Date
P1	Issue to Planning	25.06.2024

PROJECT		ADDRESS		CLIENT	
Retrospective single storey extension to side and rear elevations		1232_94 Parrs Wood Rd, Manchester M20 4RP		Mr Ismail Altaf	
		SHEET		Date 25.06.2024	Project number 1232
Manchester City Council		Asbuilt and Retrospective Floor Plans		Scale (@ A3) 1 : 100	
PURPOSE OF ISSUE		DRAWING NUMBER		Drawn by VA	REV
Planning		A102		Checked by VA	P1