




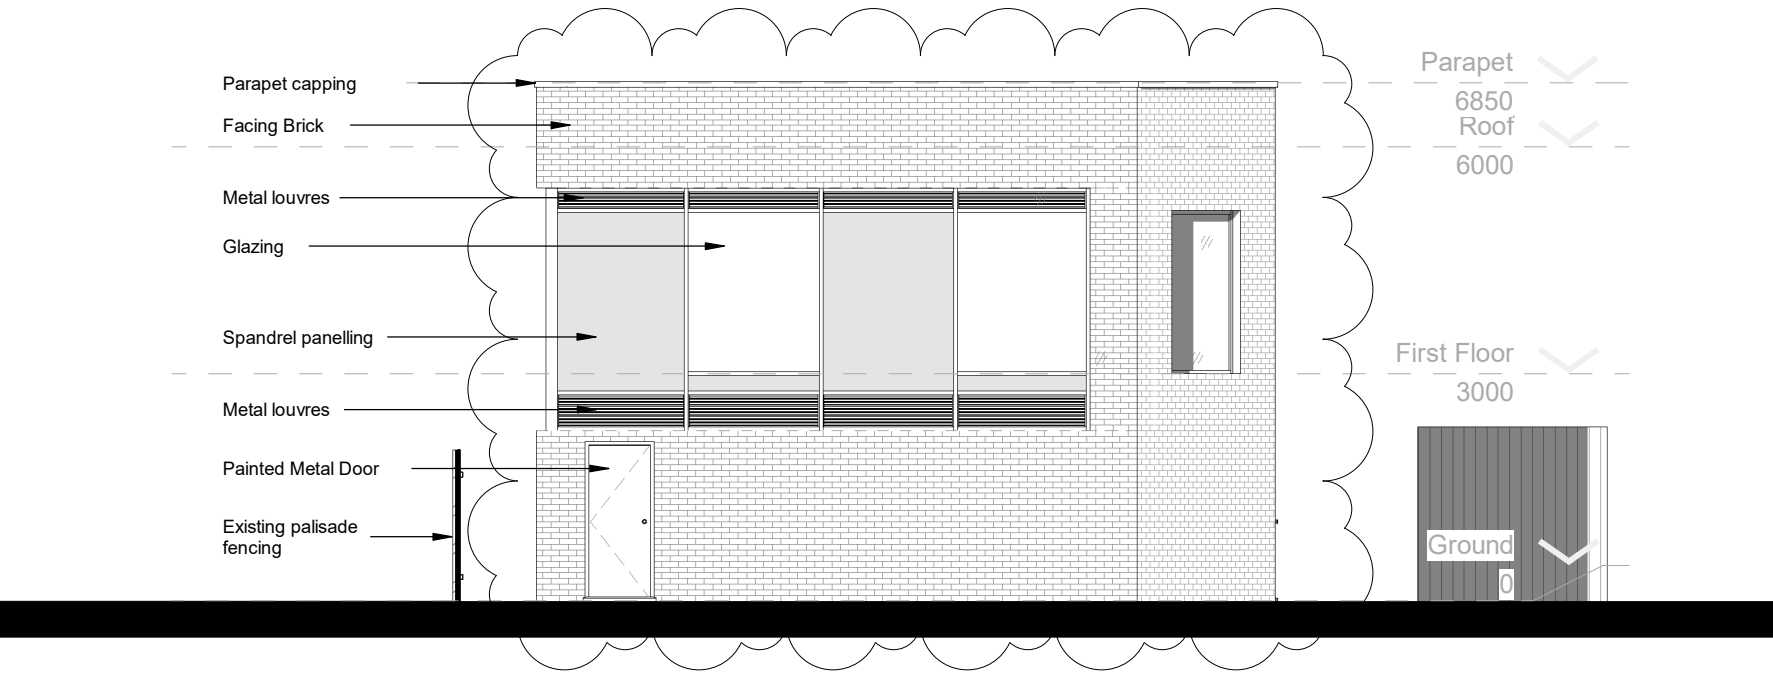

Proposed North Elevation
1 : 100

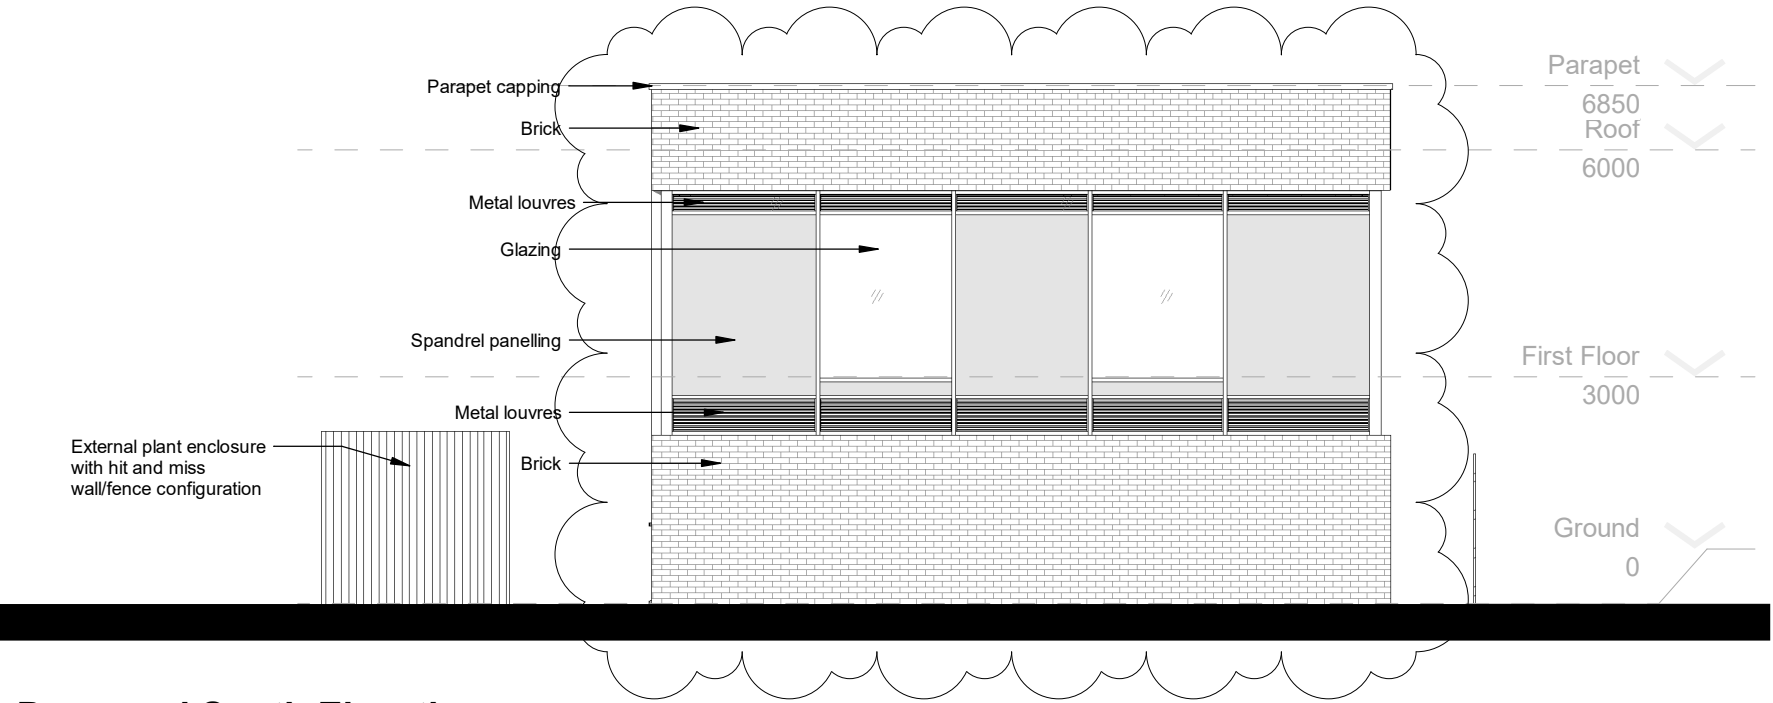

Proposed South Elevation
1 : 100

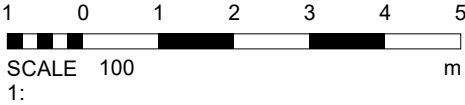

- DISCLAIMER NOTES:
- THIS DOCUMENT IS COPYRIGHT OF THE ORIGINATOR AND MUST BE TREATED AS CONFIDENTIAL. THIS DOCUMENT MUST NOT BE ALTERED, REPRODUCED OR DISTRIBUTED WITHOUT PRIOR WRITTEN CONSENT OF THE ORIGINATOR
 - THIS DOCUMENT MUST NOT BE ALTERED - THE ORIGINATOR ACCEPTS NO RESPONSIBILITY FOR ANY DISCREPANCIES ARISING AS A RESULT OF THE ORIGINATOR'S INFORMATION BEING ALTERED BY OTHERS
 - ANY DISCREPANCY MUST BE REPORTED TO THE ORIGINATOR
 - DO NOT SCALE THIS DOCUMENT - USE FIGURED DIMENSIONS ONLY
 - ALL DIMENSIONS MUST BE CHECKED ON SITE PRIOR TO COMMENCEMENT OF ANY RELATED WORKS
 - THIS DOCUMENT MUST BE READ IN CONJUNCTION WITH ALL SUPPORTING DOCUMENTS PRODUCED BY THE ORIGINATOR AND OTHER PROJECT DISCIPLINES
 - THE ORIGINATOR ACCEPTS NO RESPONSIBILITY FOR THE ACCURACY OF BACKGROUND INFORMATION PRODUCED BY THIRD PARTIES - THIS MUST BE TREATED AS INDICATIVE ONLY
 - USERS OF THIS DOCUMENT ARE RESPONSIBLE FOR CHECKING WHICH REVISION IS CURRENT
 - THE DOCUMENT STATUS "INFORMATION" OR "PRELIMINARY", INDICATES THAT THIS DRAWING IS FOR REFERENCE PURPOSES ONLY - THE ORIGINATOR WILL ACCEPT NO RESPONSIBILITY FOR THE COMPLETENESS OF INFORMATION UNDER THIS STATUS
 - THE DOCUMENT STATUS "RECORD" OR "AS BUILT" HAS BEEN PREPARED, IN PART, BASED UPON INFORMATION FURNISHED BY OTHERS. WHILE THIS INFORMATION IS BELIEVED TO BE RELIABLE, THE ORIGINATOR ASSUMES NO RESPONSIBILITY FOR THE ACCURACY OF THIS "RECORD" OR "AS BUILT" DOCUMENT OR FOR ANY ERRORS OR OMISSIONS THAT MAY HAVE BEEN INCORPORATED INTO IT AS A RESULT OF INCORRECT INFORMATION PROVIDED TO THE ORIGINATOR. THOSE RELYING ON THE "RECORD" OR "AS BUILT" DOCUMENT ARE ADVISED TO OBTAIN INDEPENDENT VERIFICATION OF ITS ACCURACY

- DRAWING NOTES:
- CDM REGULATIONS 2015
SIGNIFICANT OR NON-OBVIOUS RISKS AND RISKS WHICH ARE DIFFICULT TO MANAGE ARE IDENTIFIED ON THIS DRAWING USING THE FOLLOWING SYMBOL IDENTIFIED TO THE RIGHT WITH BRIEF ACCOMPANYING TEXT. FOR FURTHER DETAILS OF THE RISKS IDENTIFIED BY DESIGNERS, REFERENCE SHOULD BE MADE TO CDM HAZARD REGISTER.



P3	North West corner wall amended, low level retaining wall added, Revised internal layout to NR requirement, building footprint adjusted to suit, shrubbery to East boundary omitted	07/03/2024	SI	PW
P2	Building footprint revised to suit site conditions	15/03/2024	SI	NR
P1	Client issue for review and comment	17/10/2023	IGS	PW
REV	DESCRIPTION	DATE	BY	CHKD

ORIGINATOR:



RIDGE PROJECT No: 5023028



IN ASSOCIATION WITH:

PROJECT:
NHD - Newton Heath Depot

TITLE:
Proposed North and South Elevations

DRAWN BY:	MZ	CHECKED BY:	IGS	APPROVED BY:	PW
SCALE:	1:100 @ A3	DATE:	10/10/23		
STATUS:	S0	DESCRIPTION:	PLANNING		
DRAWING No:	NHD - RDG - XX - XX - D - A - 010009				
PROJECT:	ORIGINATOR:	FUNCTION:	SPATIAL:	FORM:	DISCIPLINE:
NHD	RDG	XX	XX	D	A
					NUMBER:
					010009
					REV:
					P3