





PROJECT			
Manchester Ice Rink 2023-24			
VENUE			
Todd Street, Manchester, M4 3BG			
DRAWING TITLE			
Ice Rink Site Plan Overview Google Map			
DRAWING NUMBER			
180356 - OGM			
JOB N	ZONE	N.	CONTENT
180356-MC-01-MANCHESTER			
ICE-ASB			
DATE	SCALE	DRAWN BY	
06.07.23	1:500 @ A3	LWood	
REV	COMMENTS	DATE	DRAWN
ASB	As Built Plan	10.01.24	LP/LWood

THE DESIGNS, CONCEPTS, AND MATERIALS (COLLECTIVELY REFERRED TO AS "DESIGNS") SUBMITTED HERewith ARE THE EXCLUSIVE AND PROPRIETARY PROPERTY OF ARENA GROUP ("PROPRIETOR"). THE DESIGNS ARE PROVIDED FOR THE SOLE PURPOSE OF EVALUATING AND CONSIDERING POTENTIAL COLLABORATION BETWEEN THE PROPRIETOR AND RECIPIENT OF THE DESIGNS AND MAY NOT BE REPLICATED, DISTRIBUTED OR OTHERWISE DISCLOSED TO ANY THIRD PARTY WITHOUT THE EXPRESS WRITTEN CONSENT OF THE PROPRIETOR. IN THE EVENT THAT THIS DESIGN FORMS PART OF A SUBMITTED PROPOSAL, THEN PLEASE NOTE THAT IT MAY BE SUBJECT TO FURTHER DESIGN DEVELOPMENT, COST ANALYSIS AND MATERIAL AVAILABILITY.

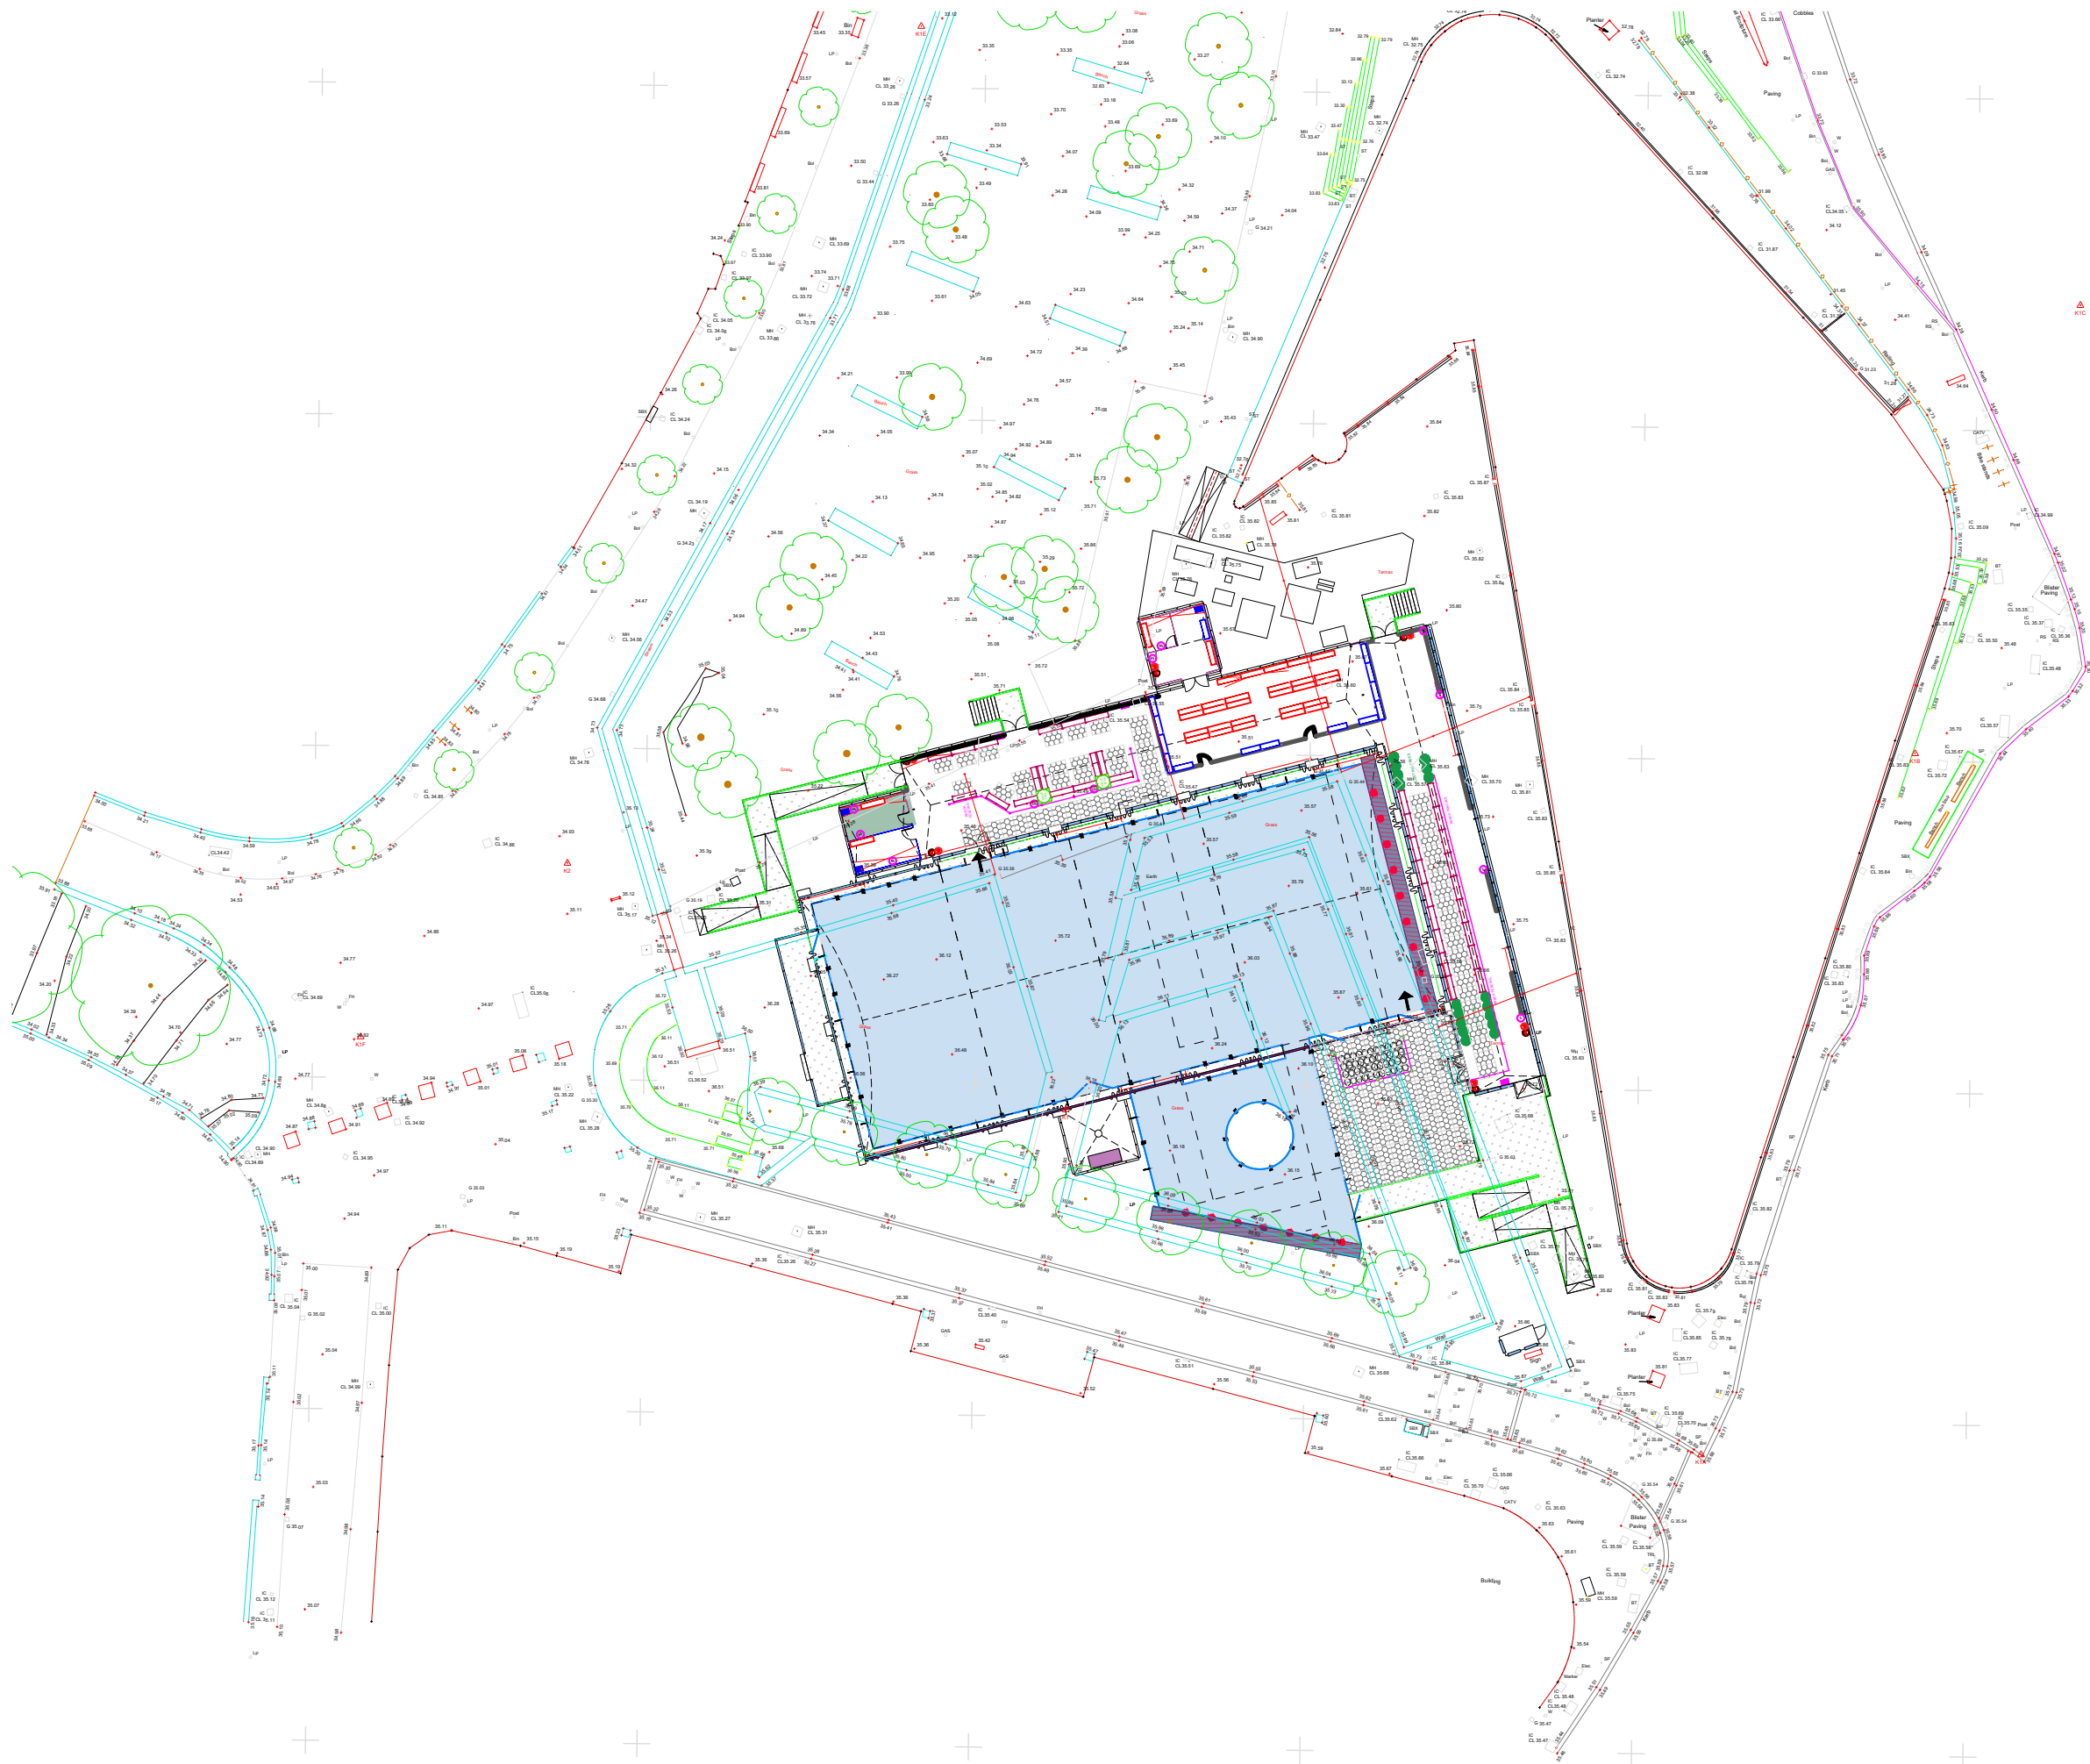


PROJECT			
Manchester Ice Rink 2023-24			
VENUE			
Todd Street, Manchester, M4 3BG			
DRAWING TITLE			
Ice Rink Site Plan Overview Survey Plan			
DRAWING NUMBER			
180356 - OSU			
JOB N	ZONE	N.	CONTENT
180356-MC-01-MANCHESTER ICE-ASB			
DATE	SCALE	DRAWN BY	
06.07.23	##### @ A3	LWood	
REV	COMMENTS	DATE	DRAWN
ASB	As Built Plan	10.01.24	LP/LWood
THE DESIGNS, CONCEPTS, AND MATERIALS (COLLECTIVELY REFERRED TO AS 'DESIGNS') SUBMITTED HERewith ARE THE EXCLUSIVE AND PROPRIETARY PROPERTY OF ARENA GROUP ('PROPRIETOR'). THE DESIGNS ARE PROVIDED FOR THE SOLE PURPOSE OF EVALUATING AND CONSIDERING POTENTIAL COLLABORATION BETWEEN THE PROPRIETOR AND RECIPIENT OF THE DESIGNS AND MAY NOT BE REPLICATED, DISTRIBUTED OR OTHERWISE DISCLOSED TO ANY THIRD PARTY WITHOUT THE EXPRESS WRITTEN CONSENT OF THE PROPRIETOR. IN THE EVENT THAT THIS DESIGN FORMS PART OF A SUBMITTED PROPOSAL, THEN PLEASE NOTE THAT IT MAY BE SUBJECT TO FURTHER DESIGN DEVELOPMENT, COST ANALYSIS AND MATERIAL AVAILABILITY.			

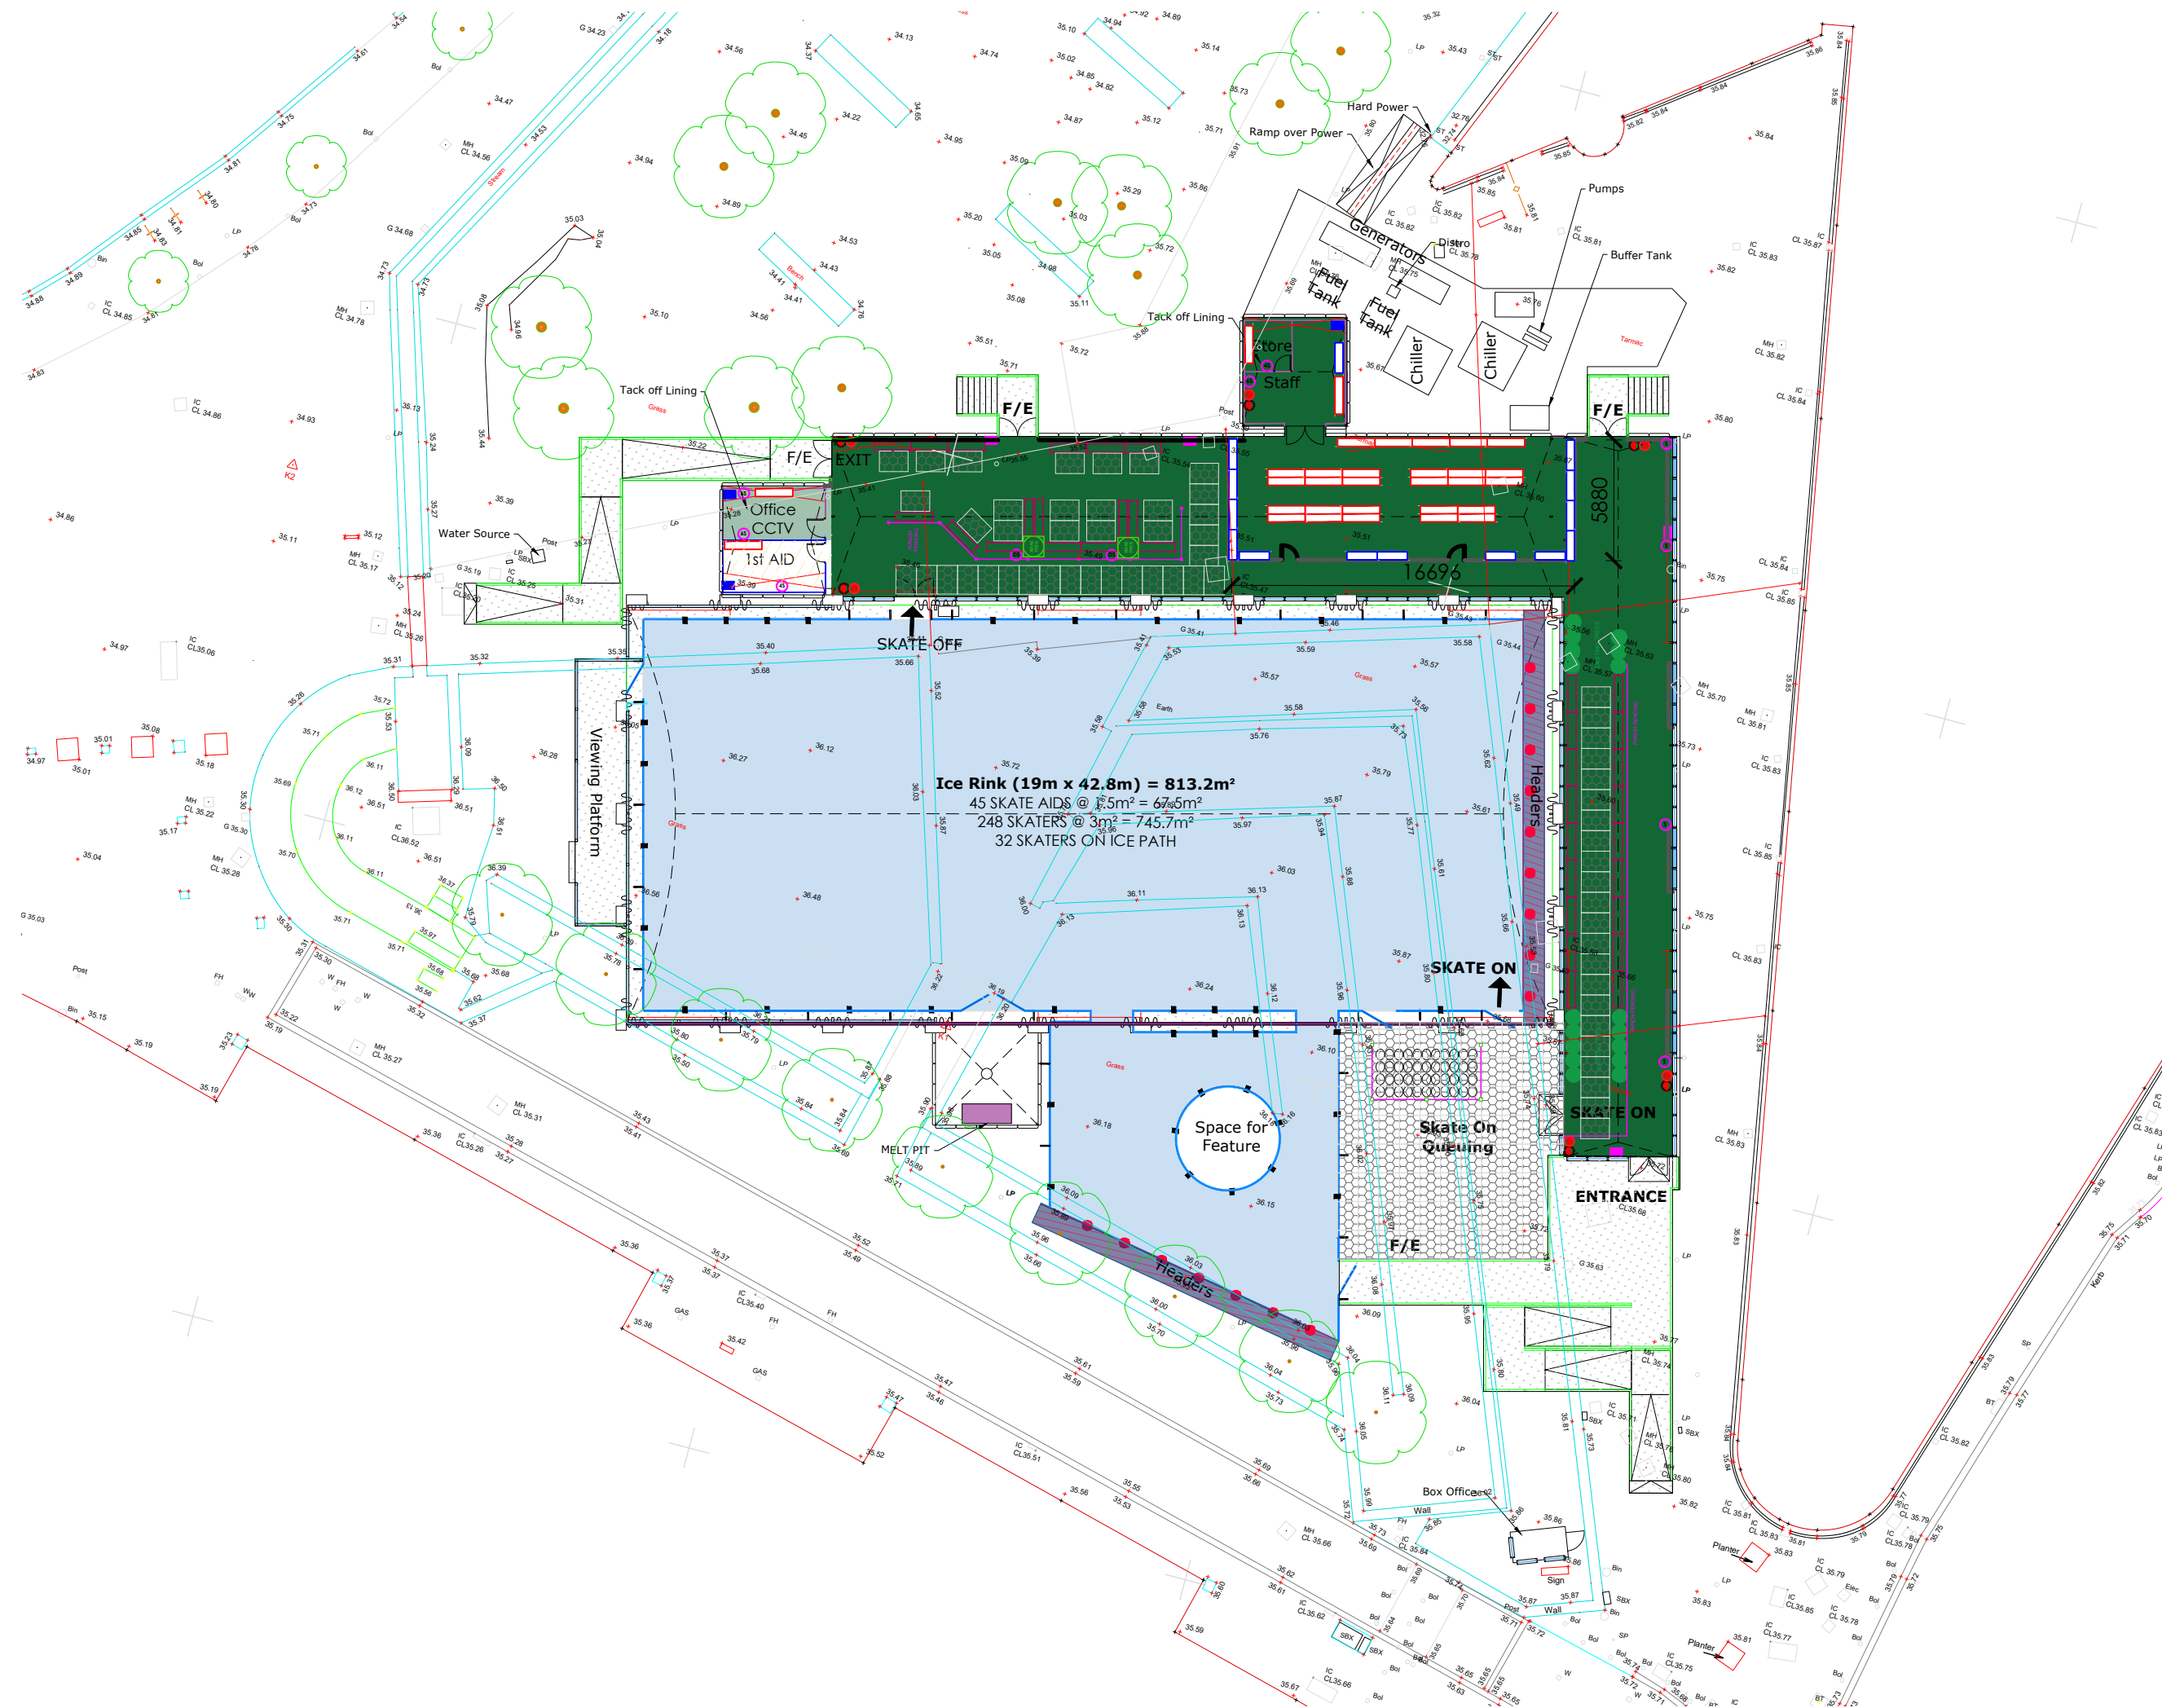

PROJECT			
<p style="text-align: center;">Manchester Ice Ring 2023-24</p>			
VENUE			
<p style="text-align: center;">Todd Street, Manchester, M4 3BG</p>			
DRAWING TITLE			
<p style="text-align: center;">Ice Ring Floor Plan</p>			
DRAWING NUMBER			
180356 - 1FP			
JOB N	ZONE	N.	REV
CONTENT			
180356-MC-01-MANCHESTER ICE-ASB			
DATE	SCALE	DRAWN BY	
06.07.23	##### @ A3	LWood	
REV	COMMENTS	DATE	DRAWN
ASB	As Built Plan	10.01.24	LP/LWood
<p>THE DESIGNS, CONCEPTS, AND MATERIALS (COLLECTIVELY REFERRED TO AS "DESIGNS") SUBMITTED HERewith ARE THE EXCLUSIVE AND PROPRIETARY PROPERTY OF ARENA GROUP ("PROPRIETOR"). THE DESIGNS ARE PROVIDED FOR THE SOLE PURPOSE OF EVALUATING AND CONSIDERING POTENTIAL COLLABORATION BETWEEN THE PROPRIETOR AND RECIPIENT OF THE DESIGNS AND MAY NOT BE REPLICATED, DISTRIBUTED OR OTHERWISE DISCLOSED TO ANY THIRD PARTY WITHOUT THE EXPRESS WRITTEN CONSENT OF THE PROPRIETOR.</p> <p>IN THE EVENT THAT THIS DESIGN FORMS PART OF A SUBMITTED PROPOSAL, THEN PLEASE NOTE THAT IT MAY BE SUBJECT TO FURTHER DESIGN DEVELOPMENT, COST ANALYSIS AND MATERIAL AVAILABILITY.</p>			


KEY:

- Glazed Panel
- Frosted Glazed Panel
- Solid uPVC Panel
- Open with Night Sheets
- Wire bracing
- Portal Beam
- 2m Door
- 1m Door
- Ramp
- Skate Rack
- Counter
- Ranch Fencing
- Scaffold Handrail By others
- Glass Handrail
- Ranch Fencing
- Smartboard
- MDF Walling
- Melamine Walling
- Gutter
- Ballast

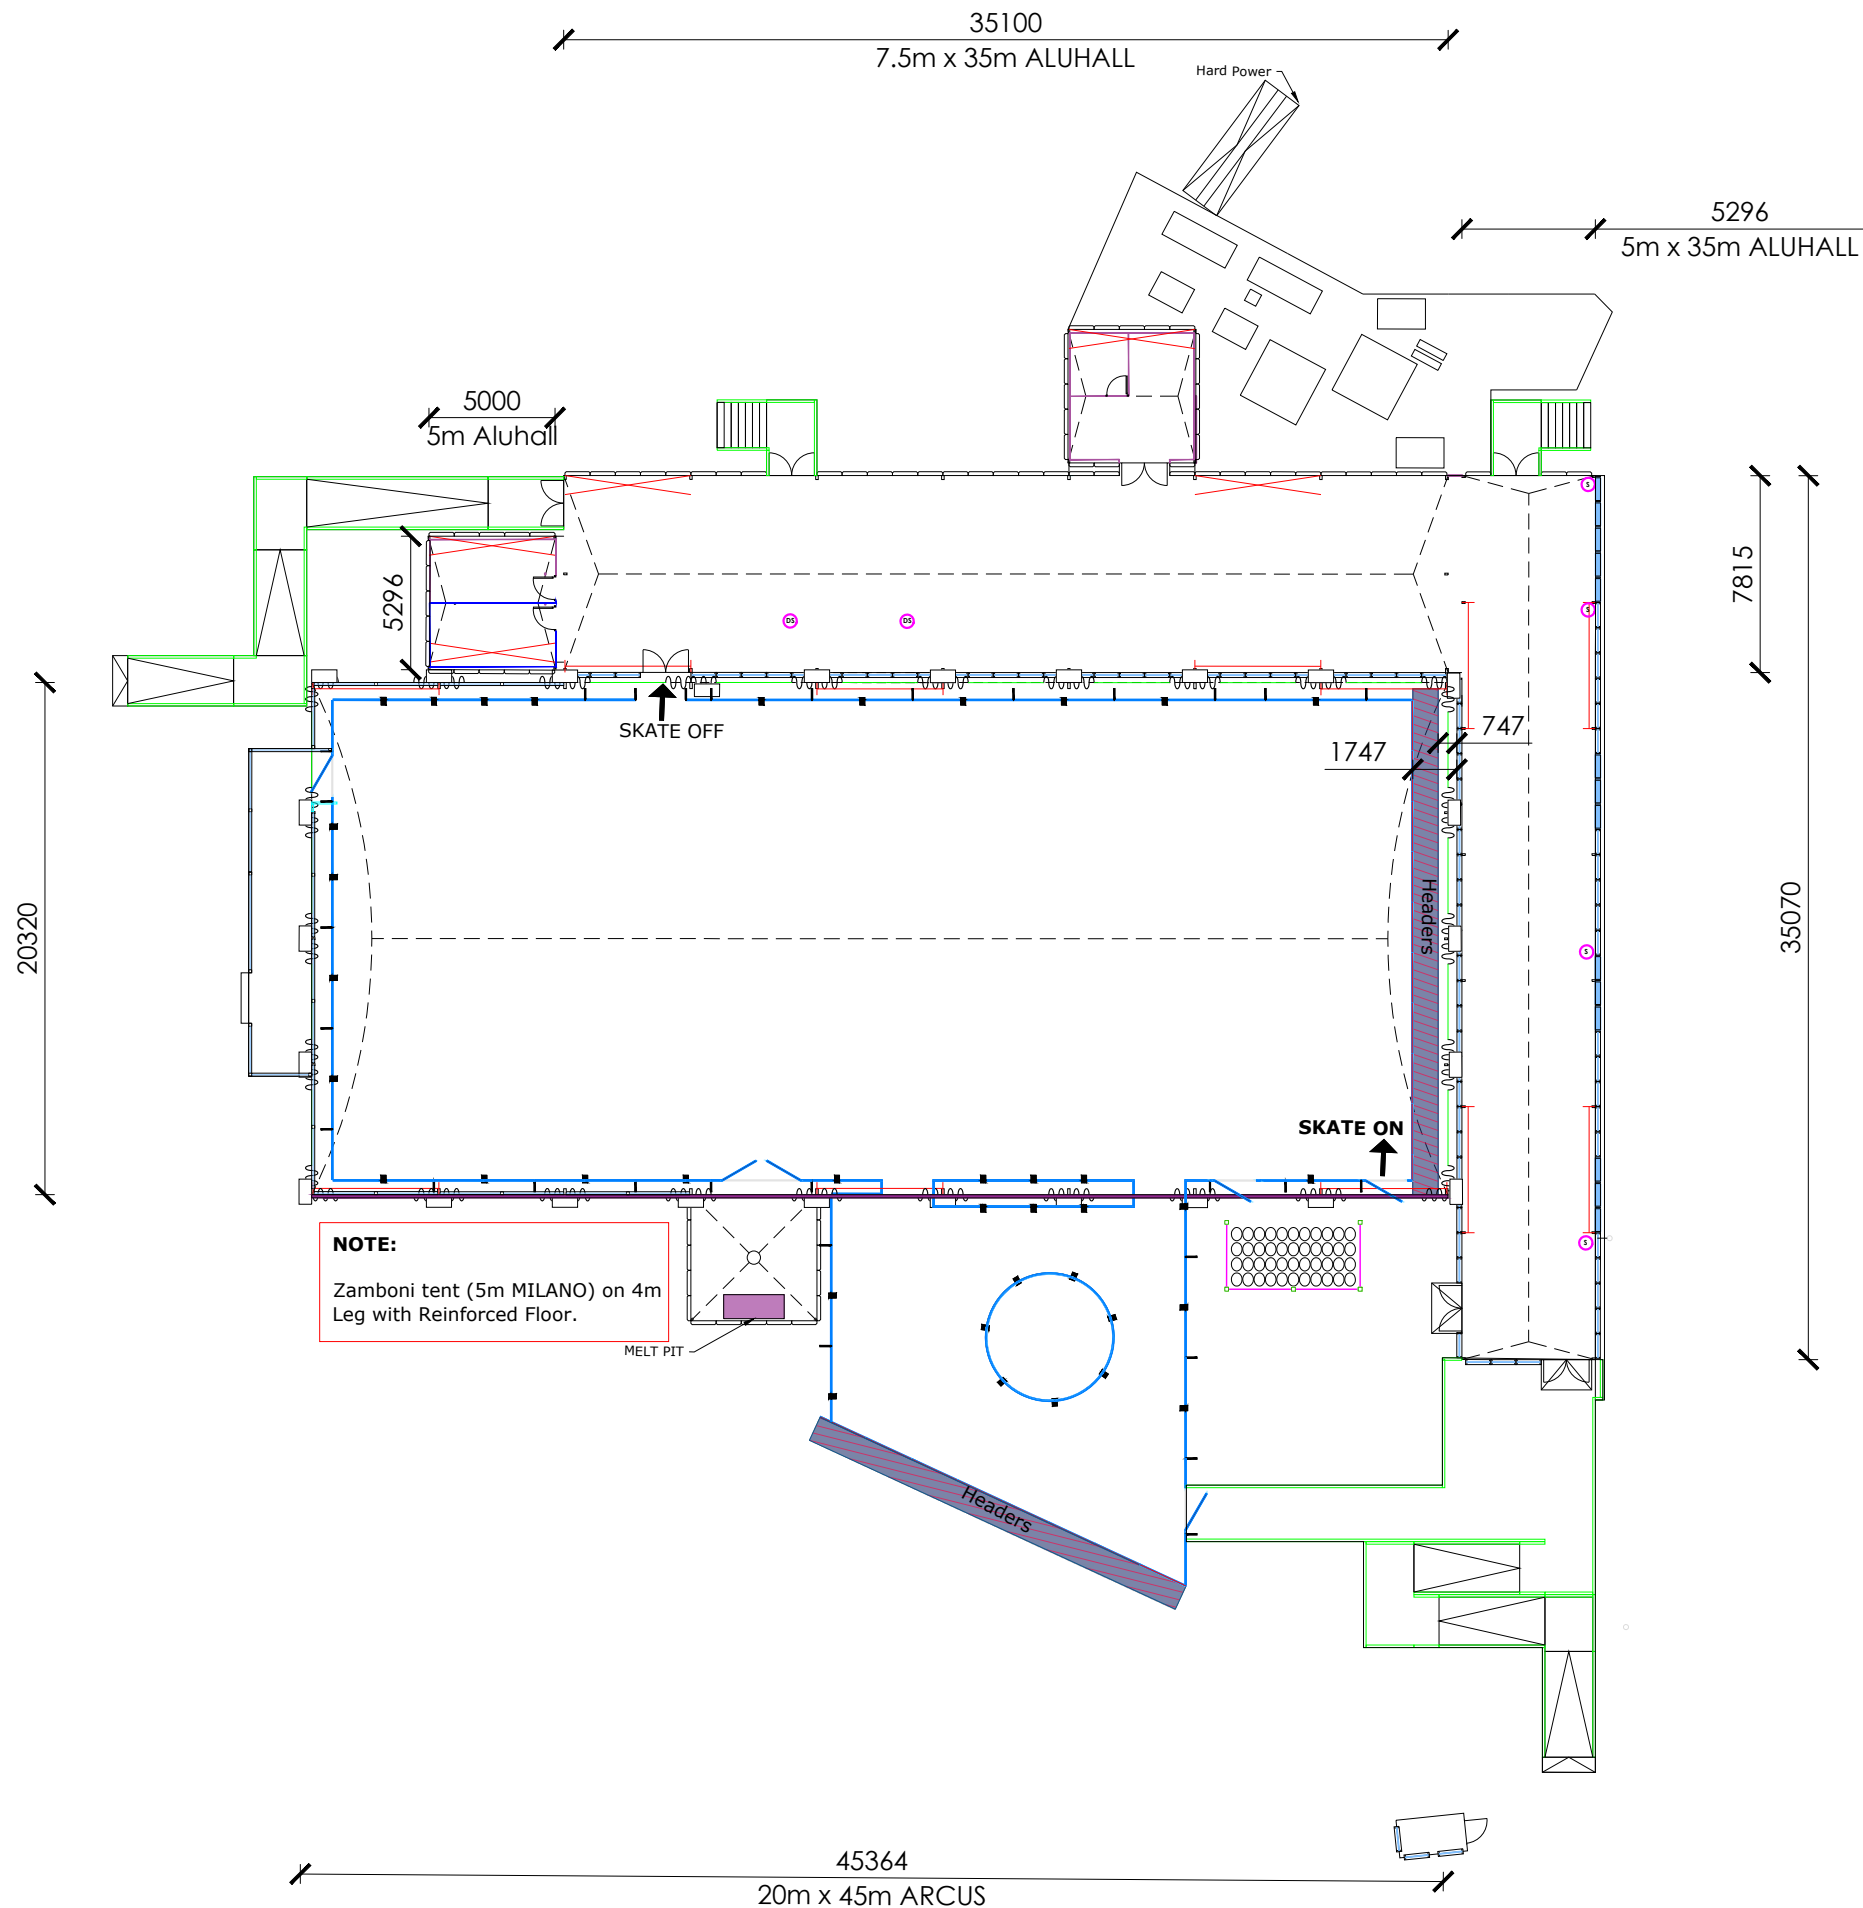

PROJECT			
Manchester Ice Rink 2023-24			
VENUE			
Todd Street, Manchester, M4 3BG			
DRAWING TITLE			
Ice Rink Structure Plan			
DRAWING NUMBER			
180356 - 2ST			
JOB N	ZONE	N.	CONTENT
180356-MC-01-MANCHESTER			ICE-ASB
DATE	SCALE	DRAWN BY	
06.07.23	##### @ A3	LWood	
REV	COMMENTS	DATE	DRAWN
ASB	As Built Plan	10.01.24	LP/LWood

THE DESIGNS, CONCEPTS, AND MATERIALS (COLLECTIVELY REFERRED TO AS 'DESIGNS') SUBMITTED HERewith ARE THE EXCLUSIVE AND PROPRIETARY PROPERTY OF ARENA GROUP ('PROPRIETOR'). THE DESIGNS ARE PROVIDED FOR THE SOLE PURPOSE OF EVALUATING AND CONSIDERING POTENTIAL COLLABORATION BETWEEN THE PROPRIETOR AND RECIPIENT OF THE DESIGNS AND MAY NOT BE REPLICATED, DISTRIBUTED OR OTHERWISE DISCLOSED TO ANY THIRD PARTY WITHOUT THE EXPRESS WRITTEN CONSENT OF THE PROPRIETOR. IN THE EVENT THAT THIS DESIGN FORMS PART OF A SUBMITTED PROPOSAL, THEN PLEASE NOTE THAT IT MAY BE SUBJECT TO FURTHER DESIGN DEVELOPMENT, COST ANALYSIS AND MATERIAL AVAILABILITY.

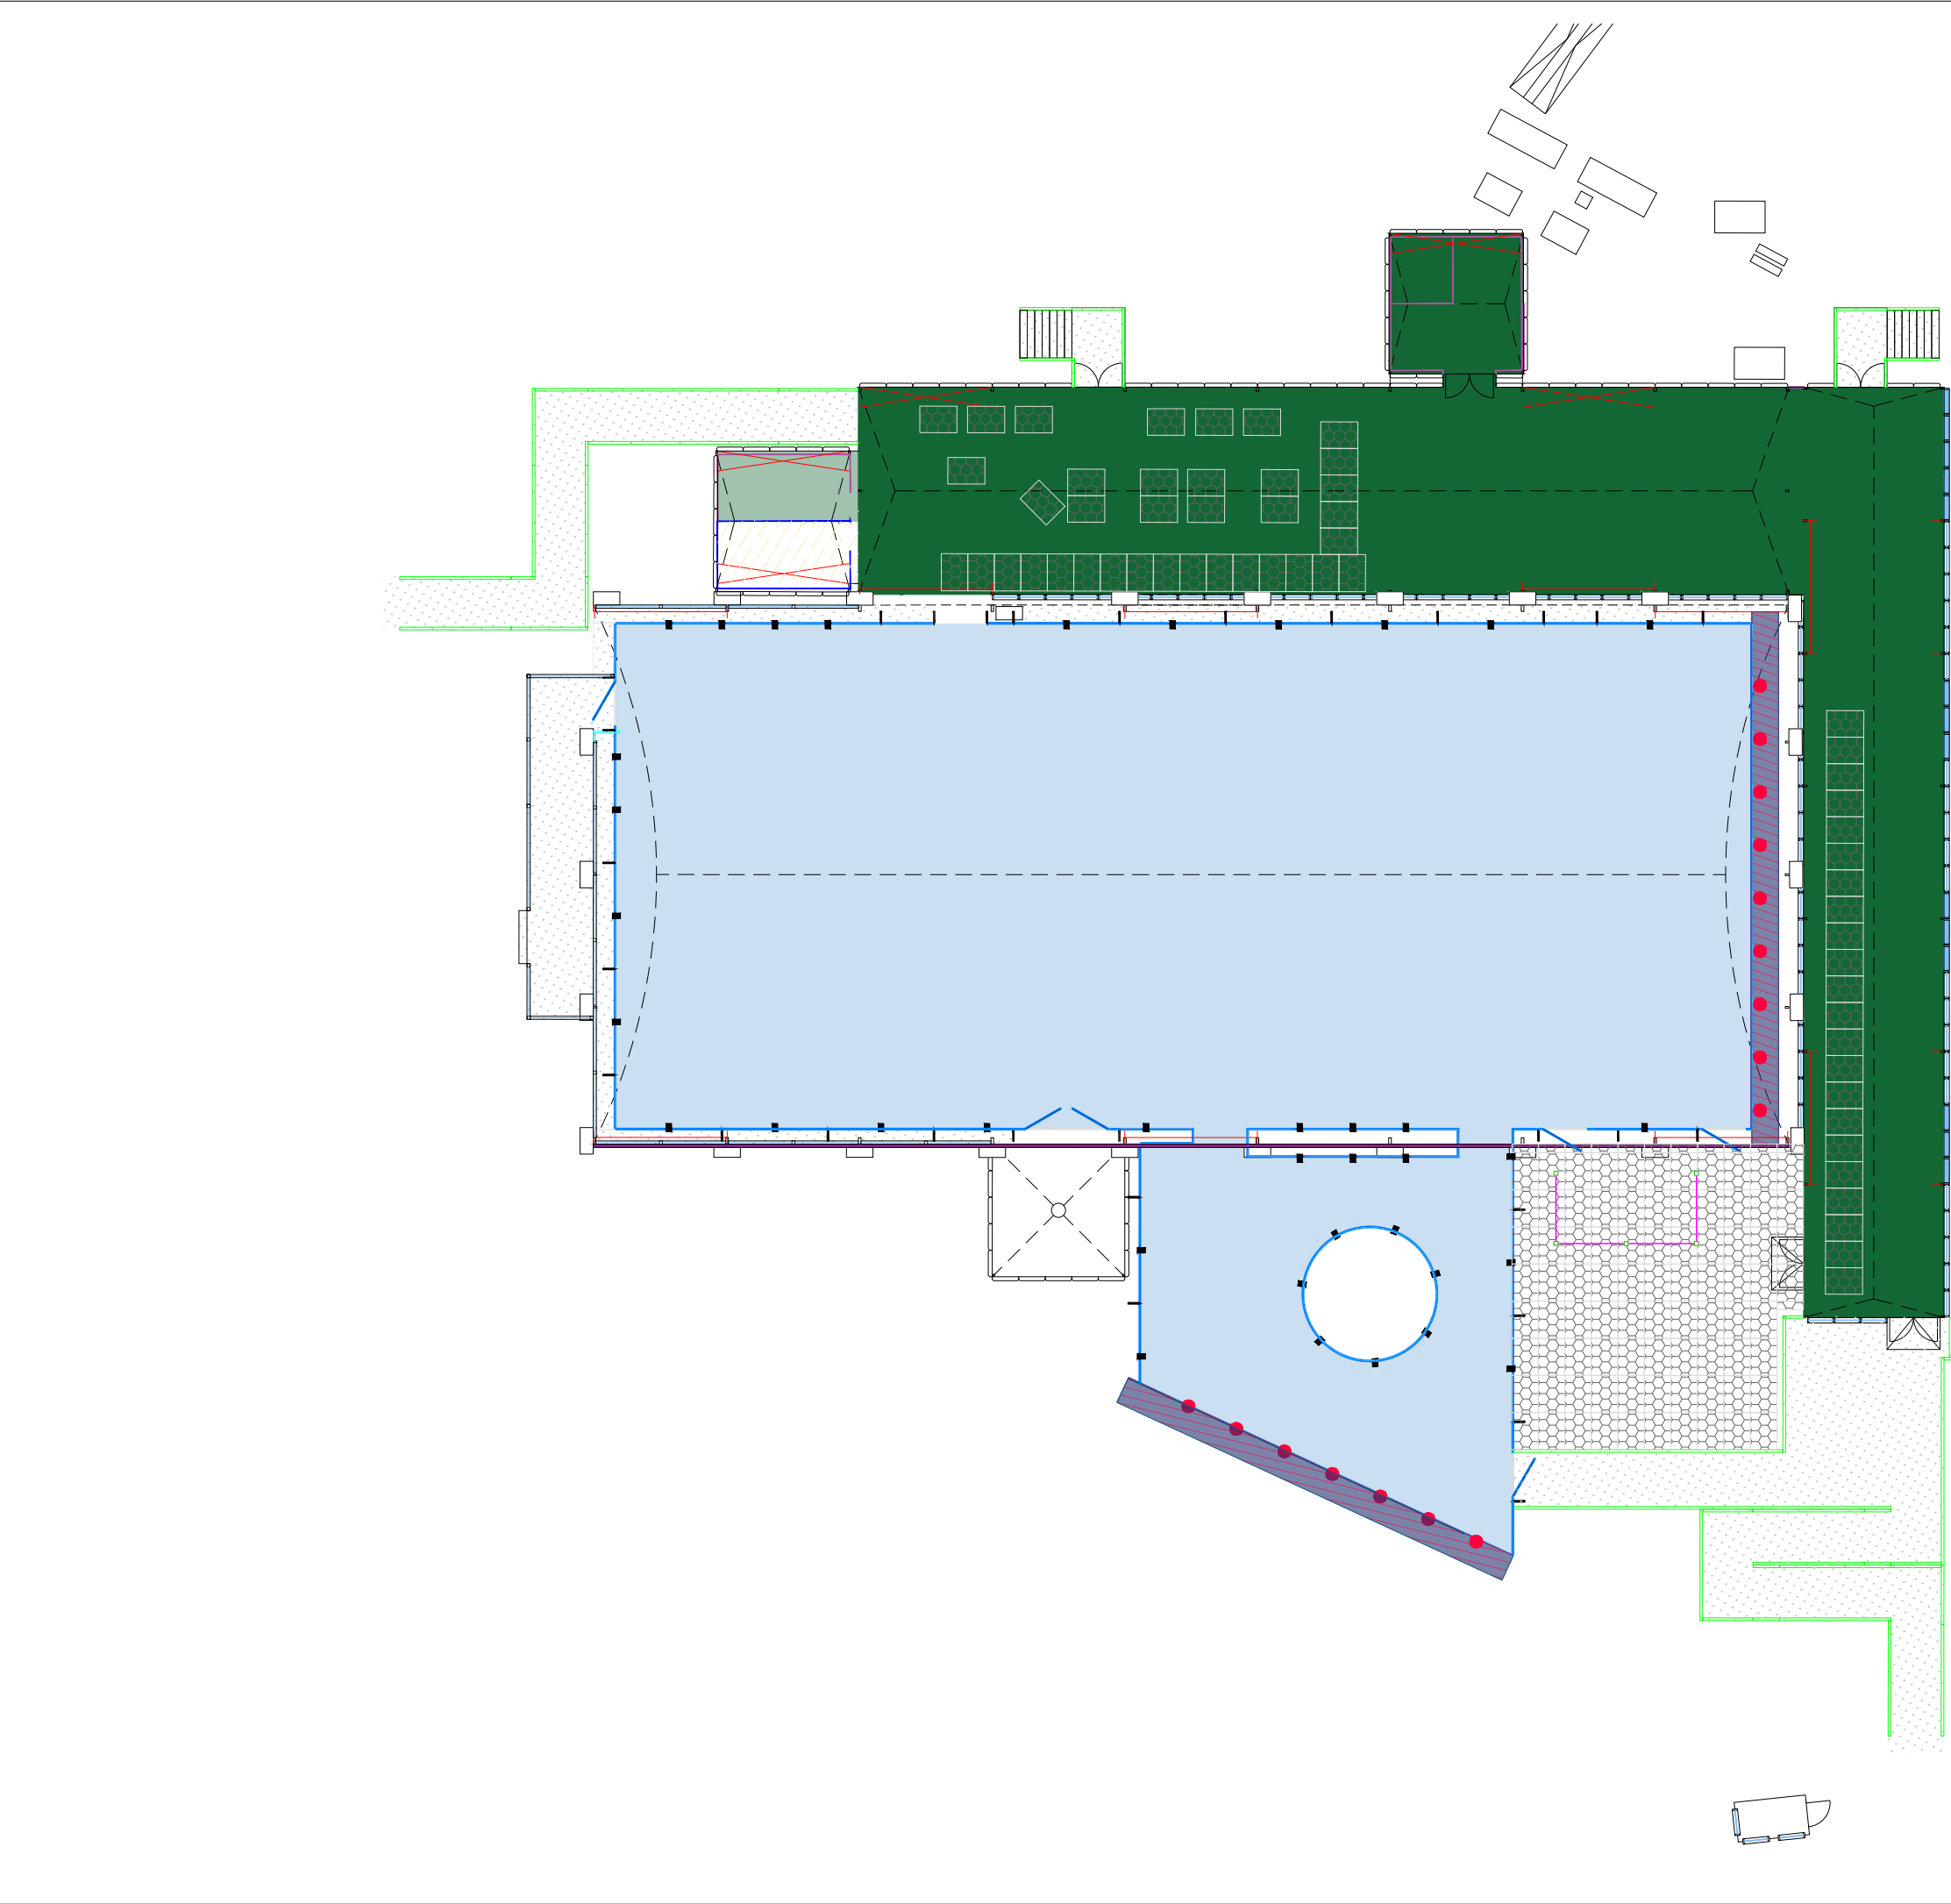

Arena


Needlingworth Industrial Estate
Needlingworth Road, St. Ives
Cambridgeshire PE27 4NB
Tel : 01480 468858
Fax : 01480 462888

KEY:

- Ice
- Marine Cord Carpet
- Grey Astro
- Vinyl
- Rubber Matting

PROJECT			
Manchester Ice Rink 2023-24			
VENUE			
Todd Street, Manchester, M4 3BG			
DRAWING TITLE			
Ice Rink Floor Covering Plan			
DRAWING NUMBER			
180356 - 3FC			
JOB N	ZONE	N.	CONTENT
180356-MC-01-MANCHESTER			
ICE-ASB			
DATE	SCALE	DRAWN BY	
06.07.23	##### @ A3	LWood	
REV	COMMENTS	DATE	DRAWN
ASB	As Built Plan	10.01.24	LP/LWood

THE DESIGNS, CONCEPTS, AND MATERIALS (COLLECTIVELY REFERRED TO AS "DESIGNS") SUBMITTED HERewith ARE THE EXCLUSIVE AND PROPRIETARY PROPERTY OF ARENA GROUP ("PROPRIETOR"). THE DESIGNS ARE PROVIDED FOR THE SOLE PURPOSE OF EVALUATING AND CONSIDERING POTENTIAL COLLABORATION BETWEEN THE PROPRIETOR AND RECIPIENT OF THE DESIGNS AND MAY NOT BE REPLICATED, DISTRIBUTED OR OTHERWISE DISCLOSED TO ANY THIRD PARTY WITHOUT THE EXPRESS WRITTEN CONSENT OF THE PROPRIETOR. IN THE EVENT THAT THIS DESIGN FORMS PART OF A SUBMITTED PROPOSAL, THEN PLEASE NOTE THAT IT MAY BE SUBJECT TO FURTHER DESIGN DEVELOPMENT, COST ANALYSIS AND MATERIAL AVAILABILITY.

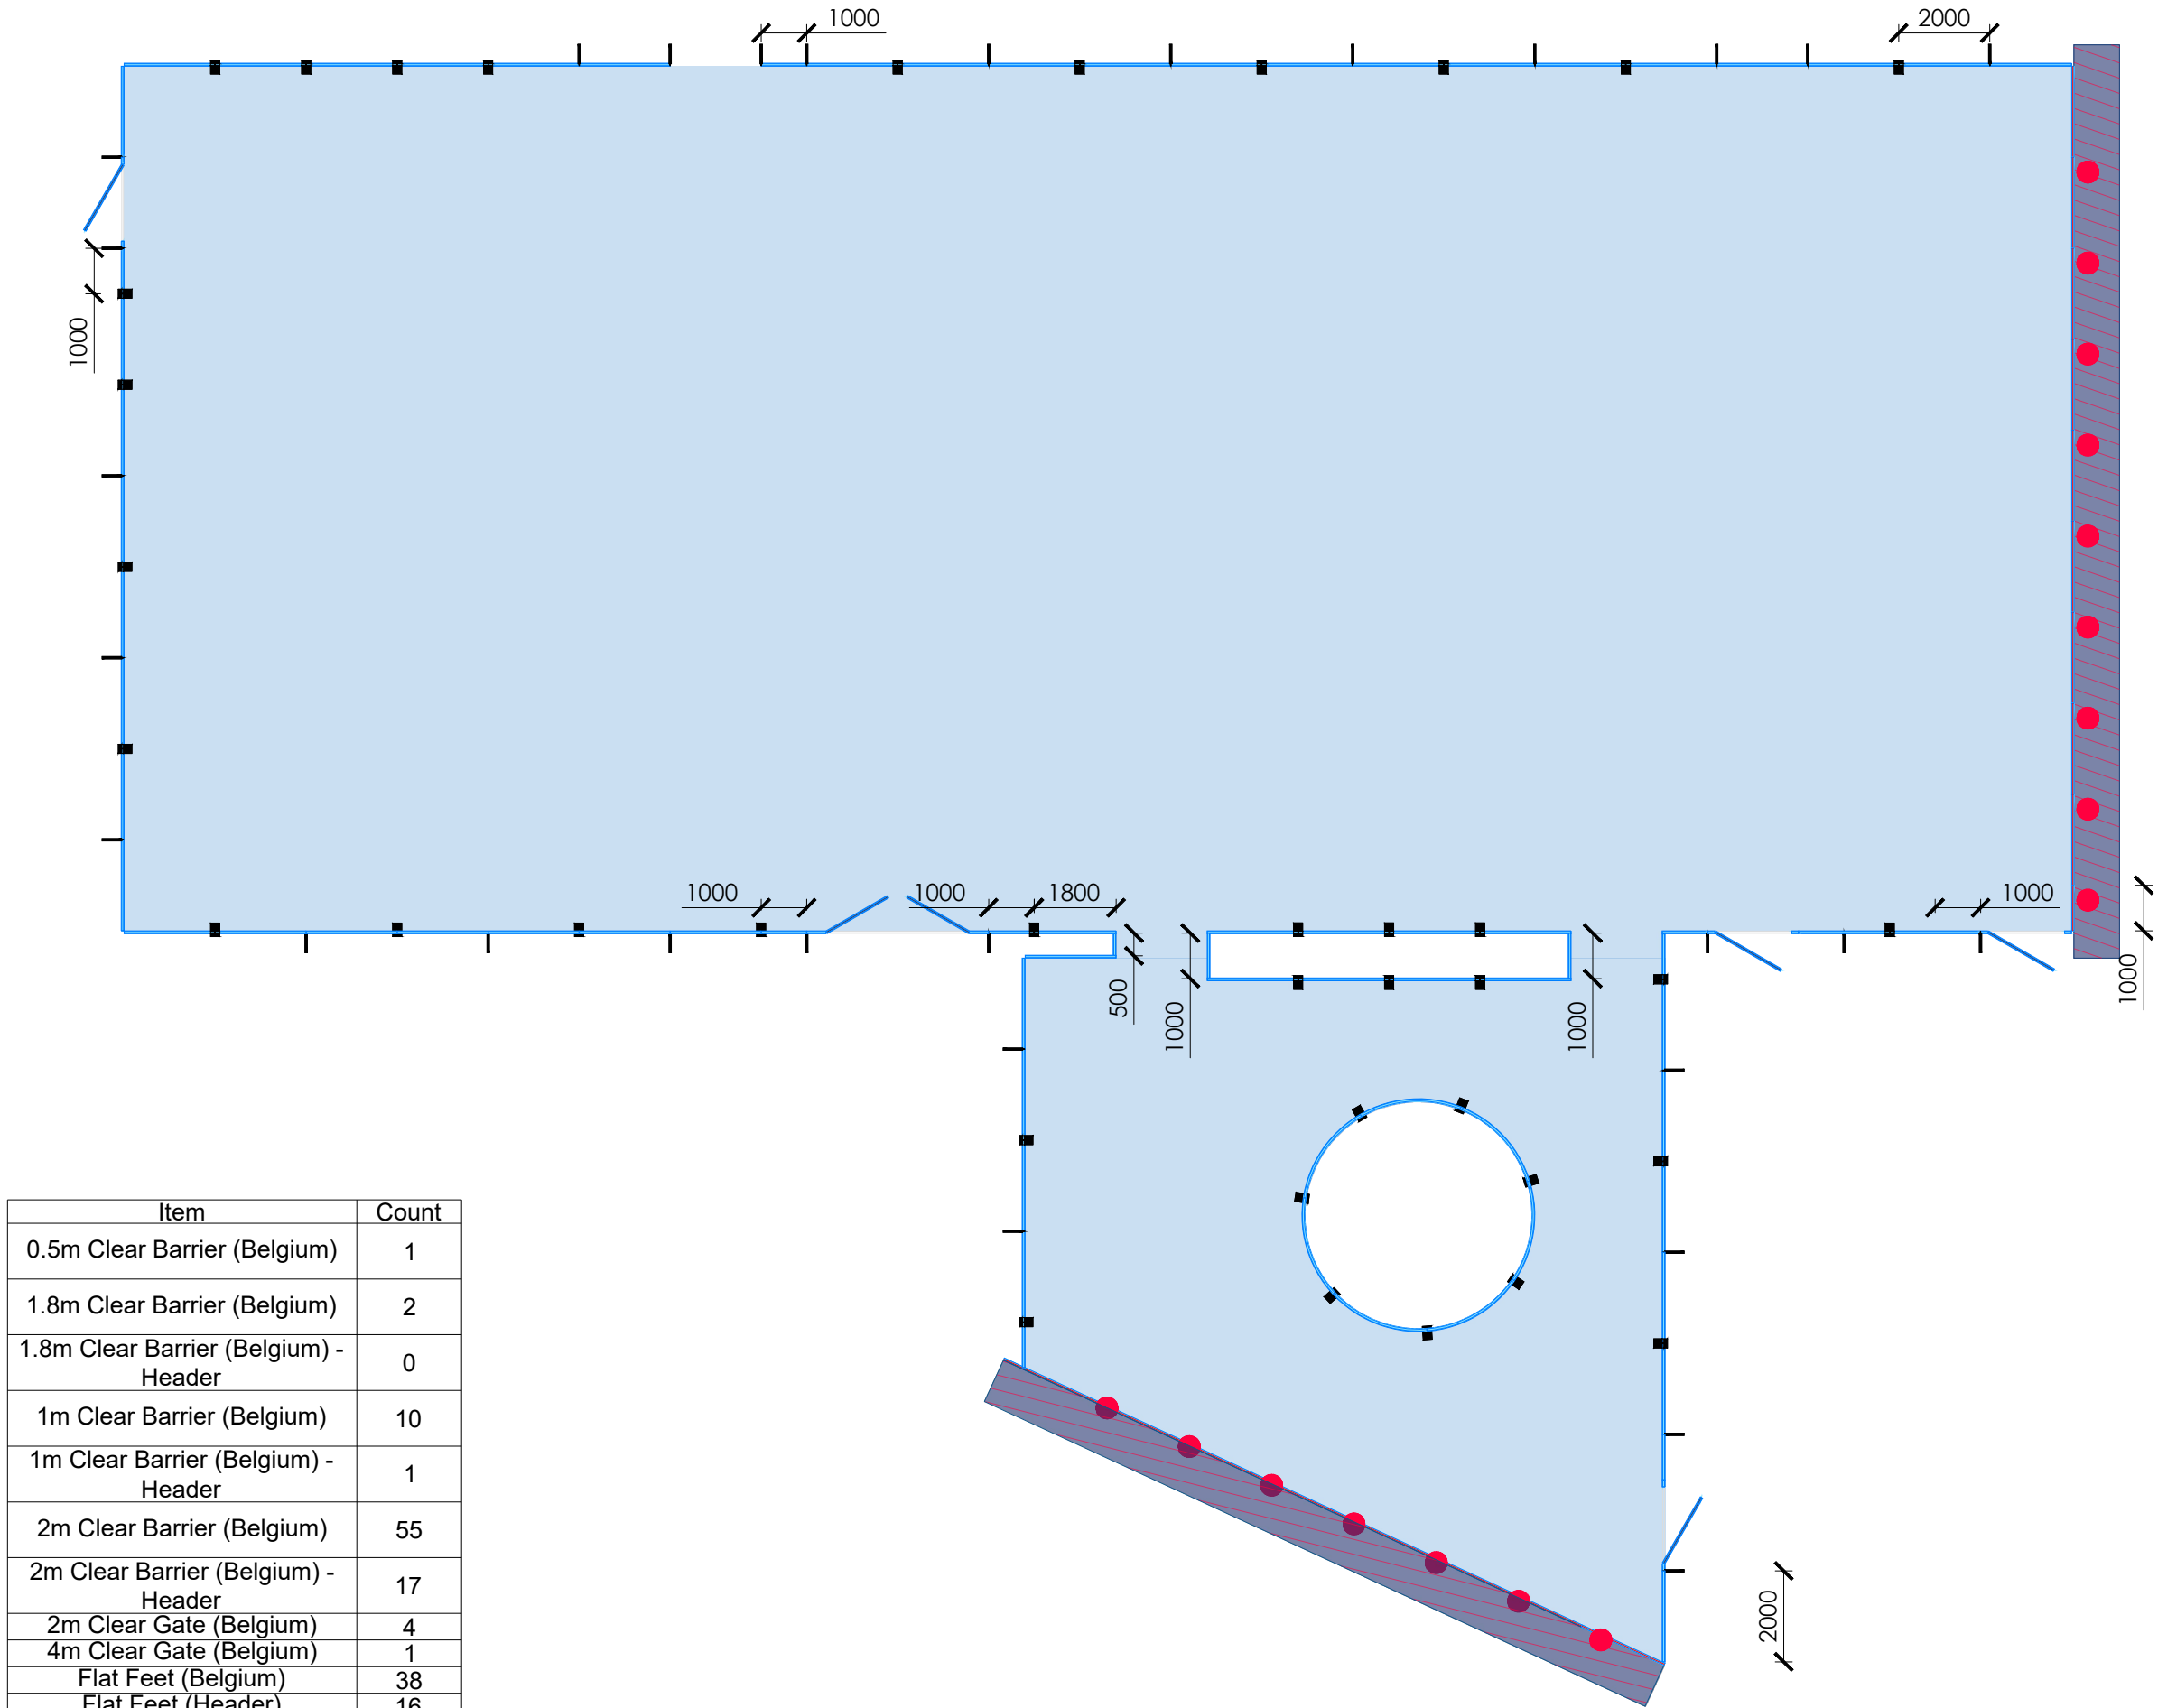

Item	Count
0.5m Clear Barrier (Belgium)	1
1.8m Clear Barrier (Belgium)	2
1.8m Clear Barrier (Belgium) - Header	0
1m Clear Barrier (Belgium)	10
1m Clear Barrier (Belgium) - Header	1
2m Clear Barrier (Belgium)	55
2m Clear Barrier (Belgium) - Header	17
2m Clear Gate (Belgium)	4
4m Clear Gate (Belgium)	1
Flat Feet (Belgium)	38
Flat Feet (Header)	16
Kickback	30

Arena

Needlingworth Industrial Estate
Needlingworth Road, St. Ives
Cambridgeshire PE27 4NB
Tel : 01480 468858
Fax : 01480 462888

KEY:


- Barrier - Clear (Belgium)
- Barrier - Clear (Belgium) - Header
- Flat Feet (Belgium)
- Kickback
- Flat Feet (Belgium) - Header
- Flat Feet (Frozen)
- 2m Clear Gate (Belgium)
- 4m Clear Gate (Belgium)
- 2m Open Frame (Belgium)


PROJECT			
Manchester Ice Rink 2023-24			
VENUE			
Todd Street, Manchester, M4 3BG			
DRAWING TITLE			
Ice Rink Barrier Layout			
DRAWING NUMBER			
180356 - 4aBA			
JOB N	ZONE	N.	CONTENT
180356-MC-01-MANCHESTER			
ICE-ASB			
DATE	SCALE	DRAWN BY	
06.07.23	##### @ A3	LWood	
REV	COMMENTS	DATE	DRAWN
ASB	As Built Plan	10.01.24	LP/LWood
THE DESIGNS, CONCEPTS, AND MATERIALS (COLLECTIVELY REFERRED TO AS 'DESIGNS') SUBMITTED HERewith ARE THE EXCLUSIVE AND PROPRIETARY PROPERTY OF ARENA GROUP ('PROPRIETOR'). THE DESIGNS ARE PROVIDED FOR THE SOLE PURPOSE OF EVALUATING AND CONSIDERING POTENTIAL COLLABORATION BETWEEN THE PROPRIETOR AND RECIPIENT OF THE DESIGNS AND MAY NOT BE REPLICATED, DISTRIBUTED OR OTHERWISE DISCLOSED TO ANY THIRD PARTY WITHOUT THE EXPRESS WRITTEN CONSENT OF THE PROPRIETOR. IN THE EVENT THAT THIS DESIGN FORMS PART OF A SUBMITTED PROPOSAL, THEN PLEASE NOTE THAT IT MAY BE SUBJECT TO FURTHER DESIGN DEVELOPMENT, COST ANALYSIS AND MATERIAL AVAILABILITY.			

KEY:

- Barrier - Clear (Belgium)
- Barrier - Clear (Belgium) - Header
- Flat Feet (Belgium)
- Kickback
- Flat Feet (Belgium) - Header
- Flat Feet (Frozen)
- 2m Clear Gate (Belgium)
- 4m Clear Gate (Belgium)
- 2m Open Frame (Belgium)

PROJECT			
Manchester Ice Rink 2023-24			
VENUE			
Todd Street, Manchester, M4 3BG			
DRAWING TITLE			
Ice Rink Pipes Layout			
DRAWING NUMBER			
180356 - 4bBA			
JOB N	ZONE	N.	CONTENT
180356-MC-01-MANCHESTER			
ICE-ASB			
DATE	SCALE	DRAWN BY	
06.07.23	##### @ A3	LWood	
REV	COMMENTS	DATE	DRAWN
ASB	As Built Plan	10.01.24	LP/LWood
THE DESIGNS, CONCEPTS, AND MATERIALS (COLLECTIVELY REFERRED TO AS 'DESIGNS') SUBMITTED HERewith ARE THE EXCLUSIVE AND PROPRIETARY PROPERTY OF ARENA GROUP ('PROPRIETOR'). THE DESIGNS ARE PROVIDED FOR THE SOLE PURPOSE OF EVALUATING AND CONSIDERING POTENTIAL COLLABORATION BETWEEN THE PROPRIETOR AND RECIPIENT OF THE DESIGNS AND MAY NOT BE REPLICATED, DISTRIBUTED OR OTHERWISE DISCLOSED TO ANY THIRD PARTY WITHOUT THE EXPRESS WRITTEN CONSENT OF THE PROPRIETOR. IN THE EVENT THAT THIS DESIGN FORMS PART OF A SUBMITTED PROPOSAL, THEN PLEASE NOTE THAT IT MAY BE SUBJECT TO FURTHER DESIGN DEVELOPMENT, COST ANALYSIS AND MATERIAL AVAILABILITY.			

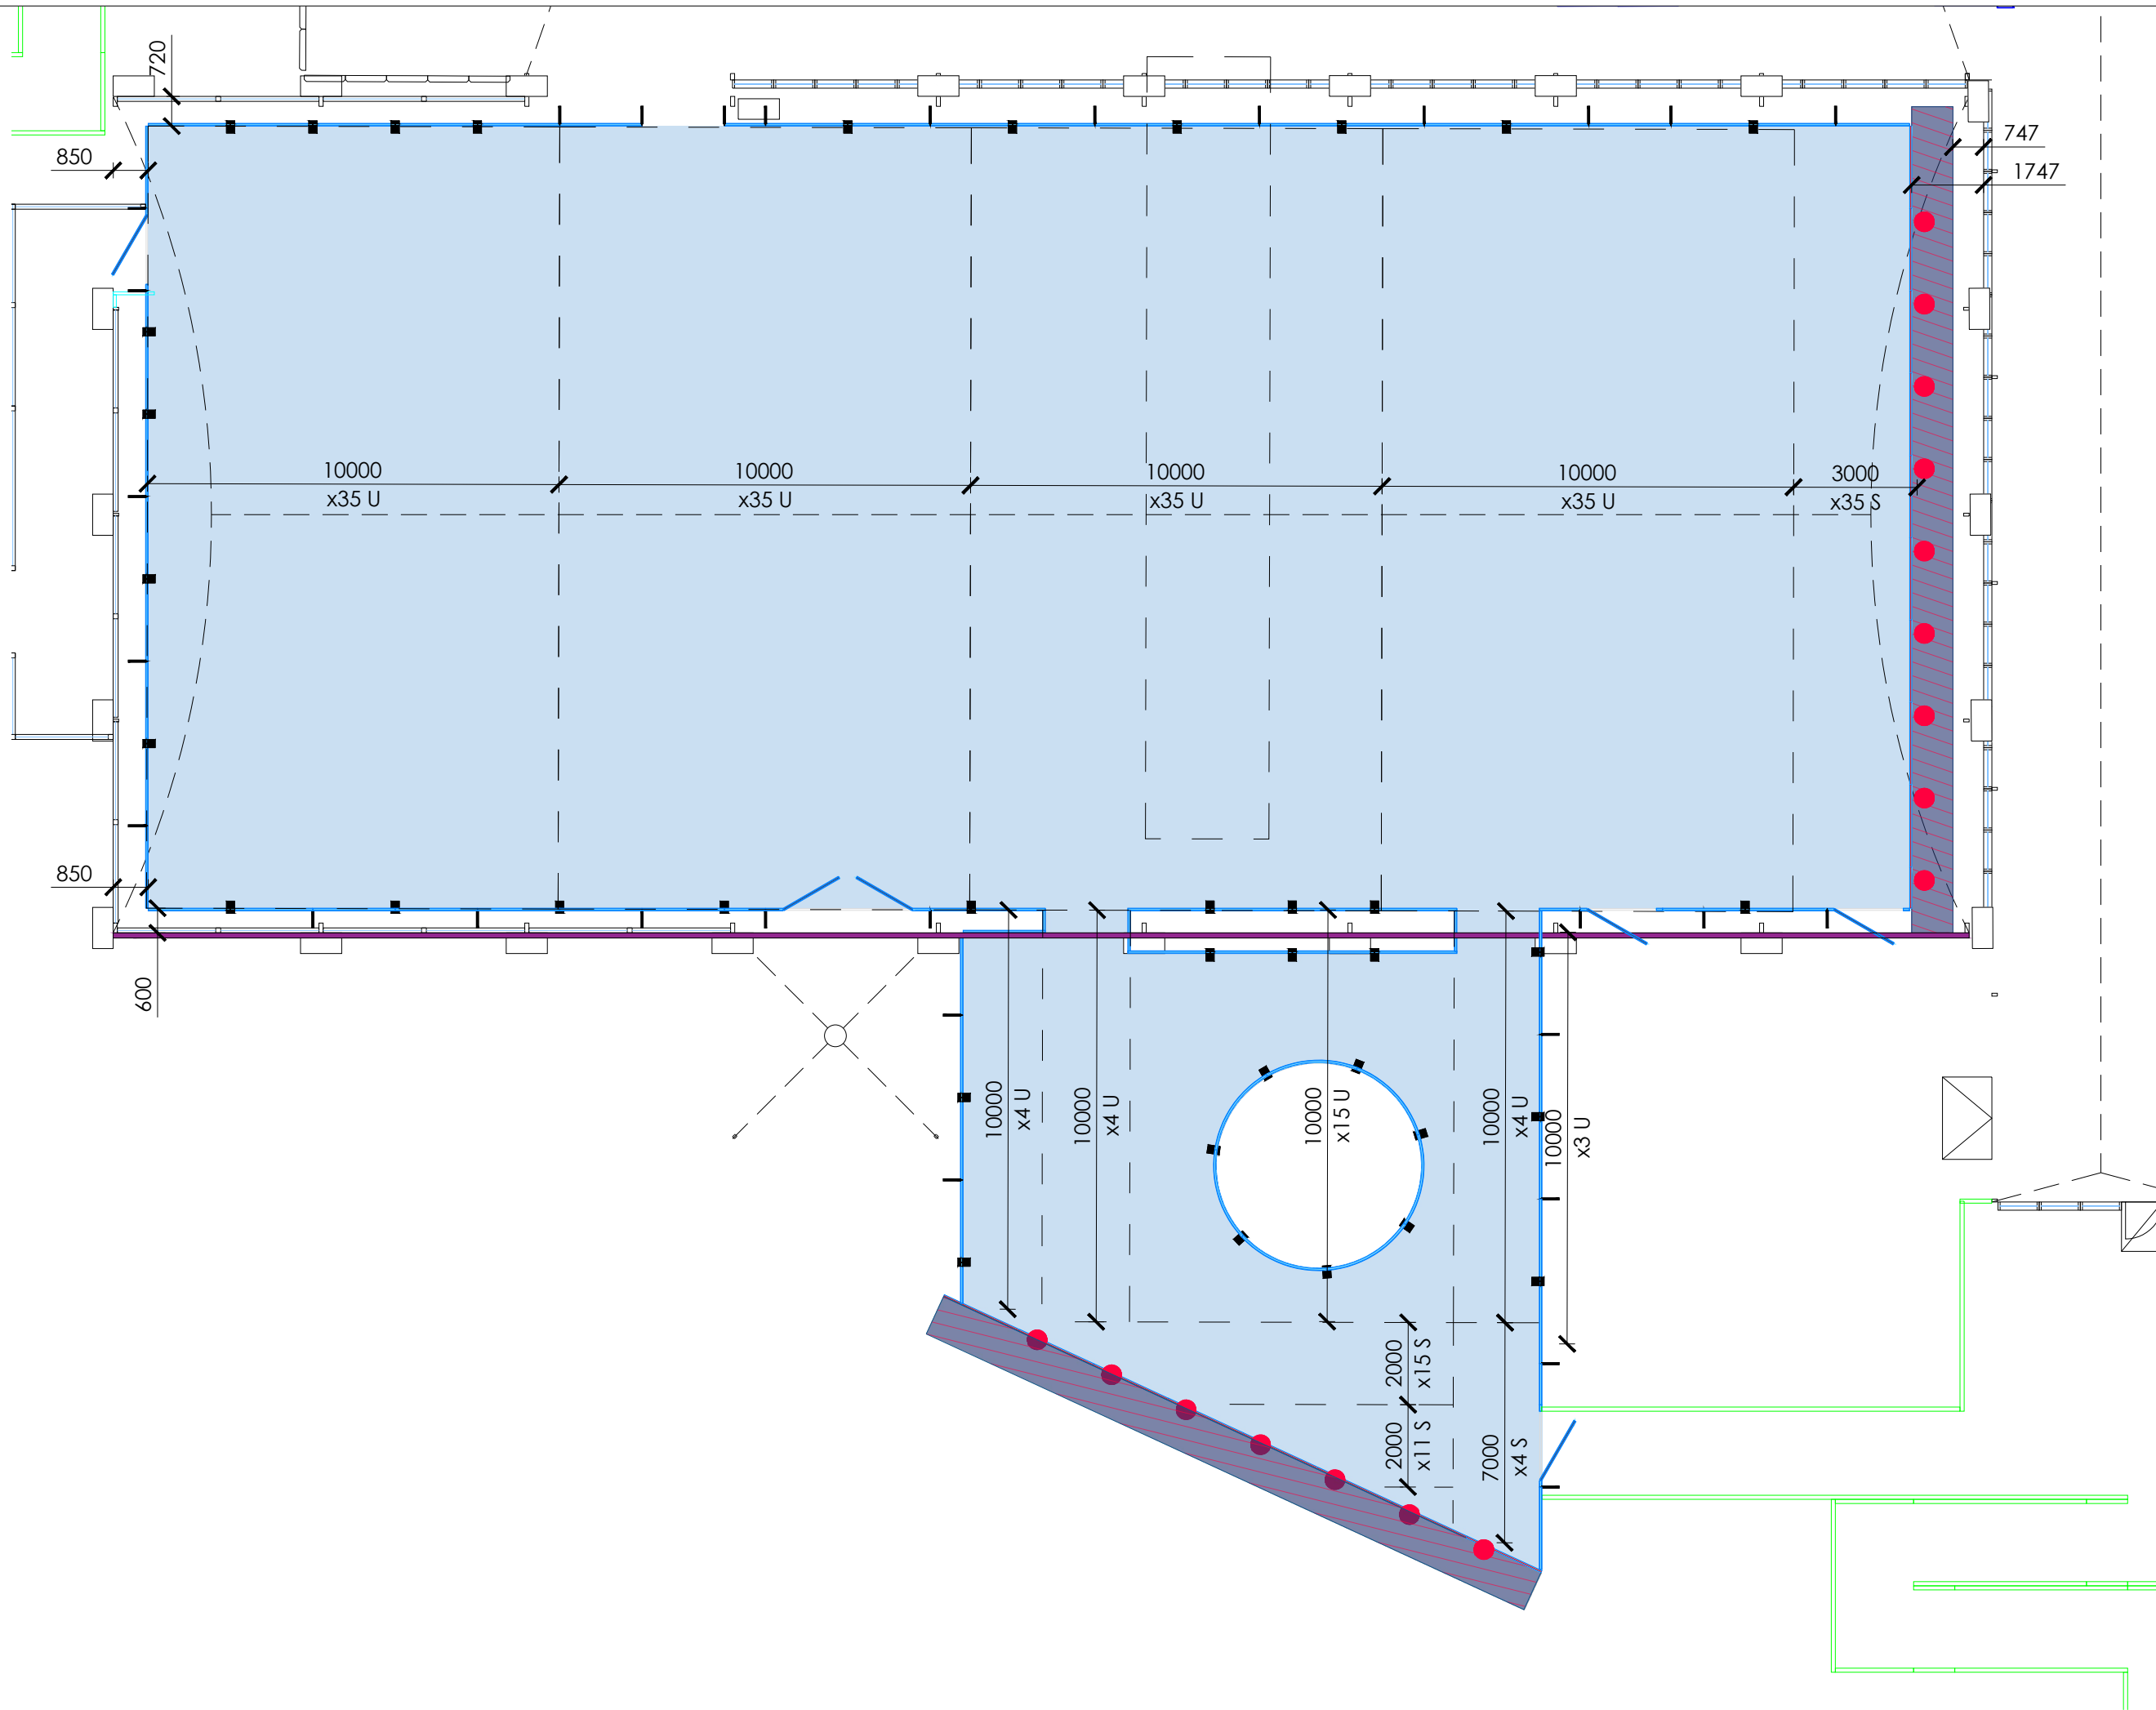

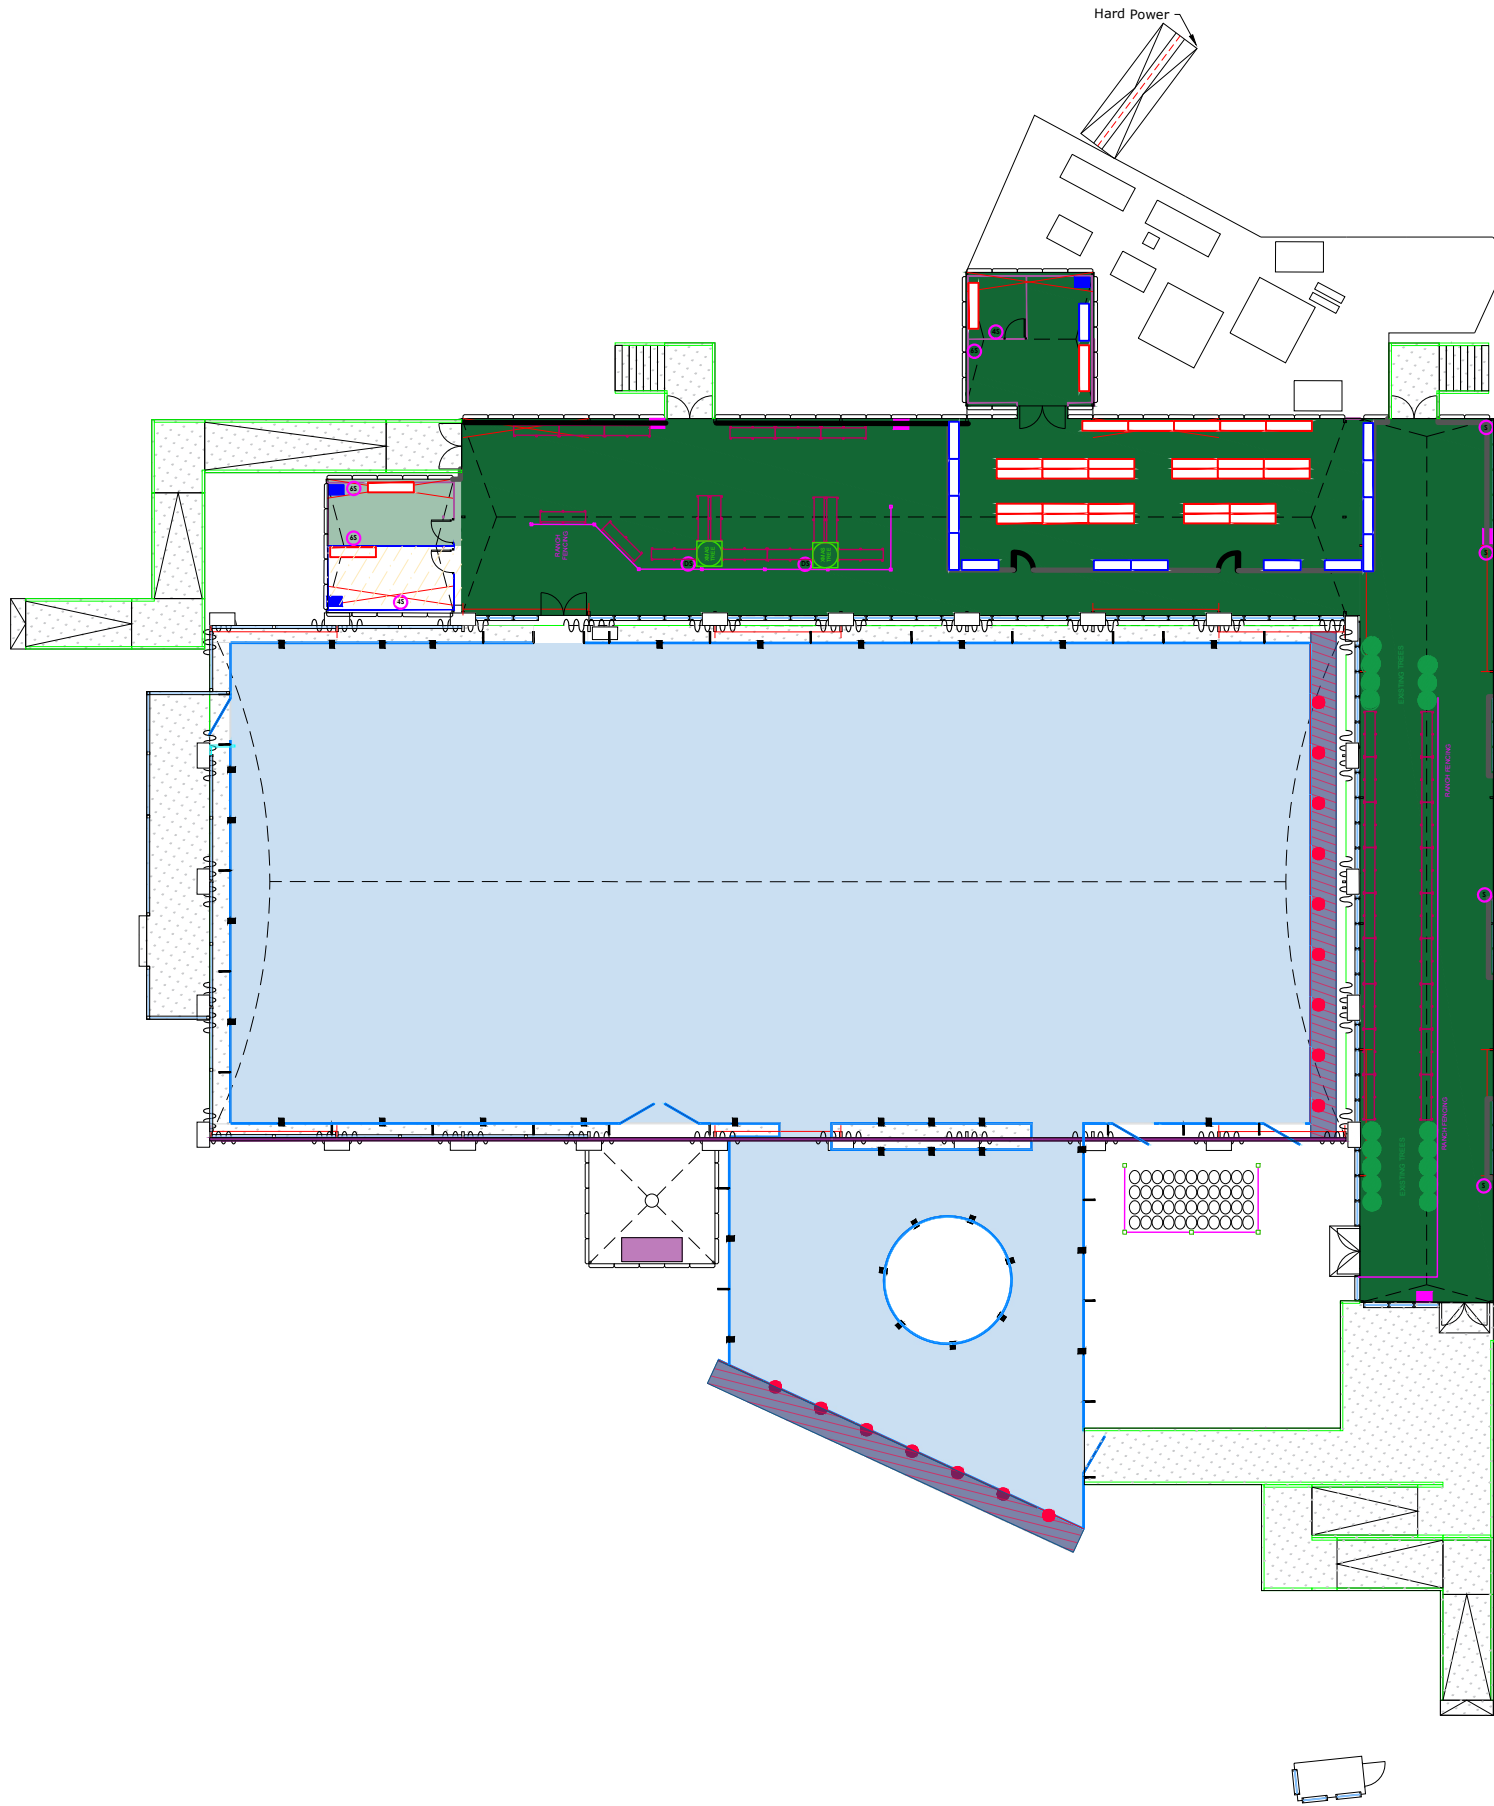

Arena

Needingworth Industrial Estate
Needingworth Road, St. Ives
Cambridgeshire PE27 4NB
Tel : 01480 468858
Fax : 01480 462888

- KEY:
- Small Heater
 - Large Heater
 - TS Electrical Socket for Tree
 - #S No. Of Single Electrical Sockets
 - DS Double Socket


PROJECT			
Manchester Ice Rink 2023-24			
VENUE			
Todd Street, Manchester, M4 3BG			
DRAWING TITLE			
Ice Rink Electrical Plan			
DRAWING NUMBER			
180356 - 5EL			
JOB N	ZONE	N.	CONTENT
180356-MC-01-MANCHESTER			ICE-ASB
DATE	SCALE	DRAWN BY	
06.07.23	##### @ A3	LWood	
REV	COMMENTS		DATE
ASB	As Built Plan		10.01.24
			DRAWN
			LP/LWood

THE DESIGNS, CONCEPTS, AND MATERIALS (COLLECTIVELY REFERRED TO AS 'DESIGNS') SUBMITTED HERewith ARE THE EXCLUSIVE AND PROPRIETARY PROPERTY OF ARENA GROUP ('PROPRIETOR'). THE DESIGNS ARE PROVIDED FOR THE SOLE PURPOSE OF EVALUATING AND CONSIDERING POTENTIAL COLLABORATION BETWEEN THE PROPRIETOR AND RECIPIENT OF THE DESIGNS AND MAY NOT BE REPLICATED, DISTRIBUTED OR OTHERWISE DISCLOSED TO ANY THIRD PARTY WITHOUT THE EXPRESS WRITTEN CONSENT OF THE PROPRIETOR. IN THE EVENT THAT THIS DESIGN FORMS PART OF A SUBMITTED PROPOSAL, THEN PLEASE NOTE THAT IT MAY BE SUBJECT TO FURTHER DESIGN DEVELOPMENT, COST ANALYSIS AND MATERIAL AVAILABILITY.



 Water

 CO₂

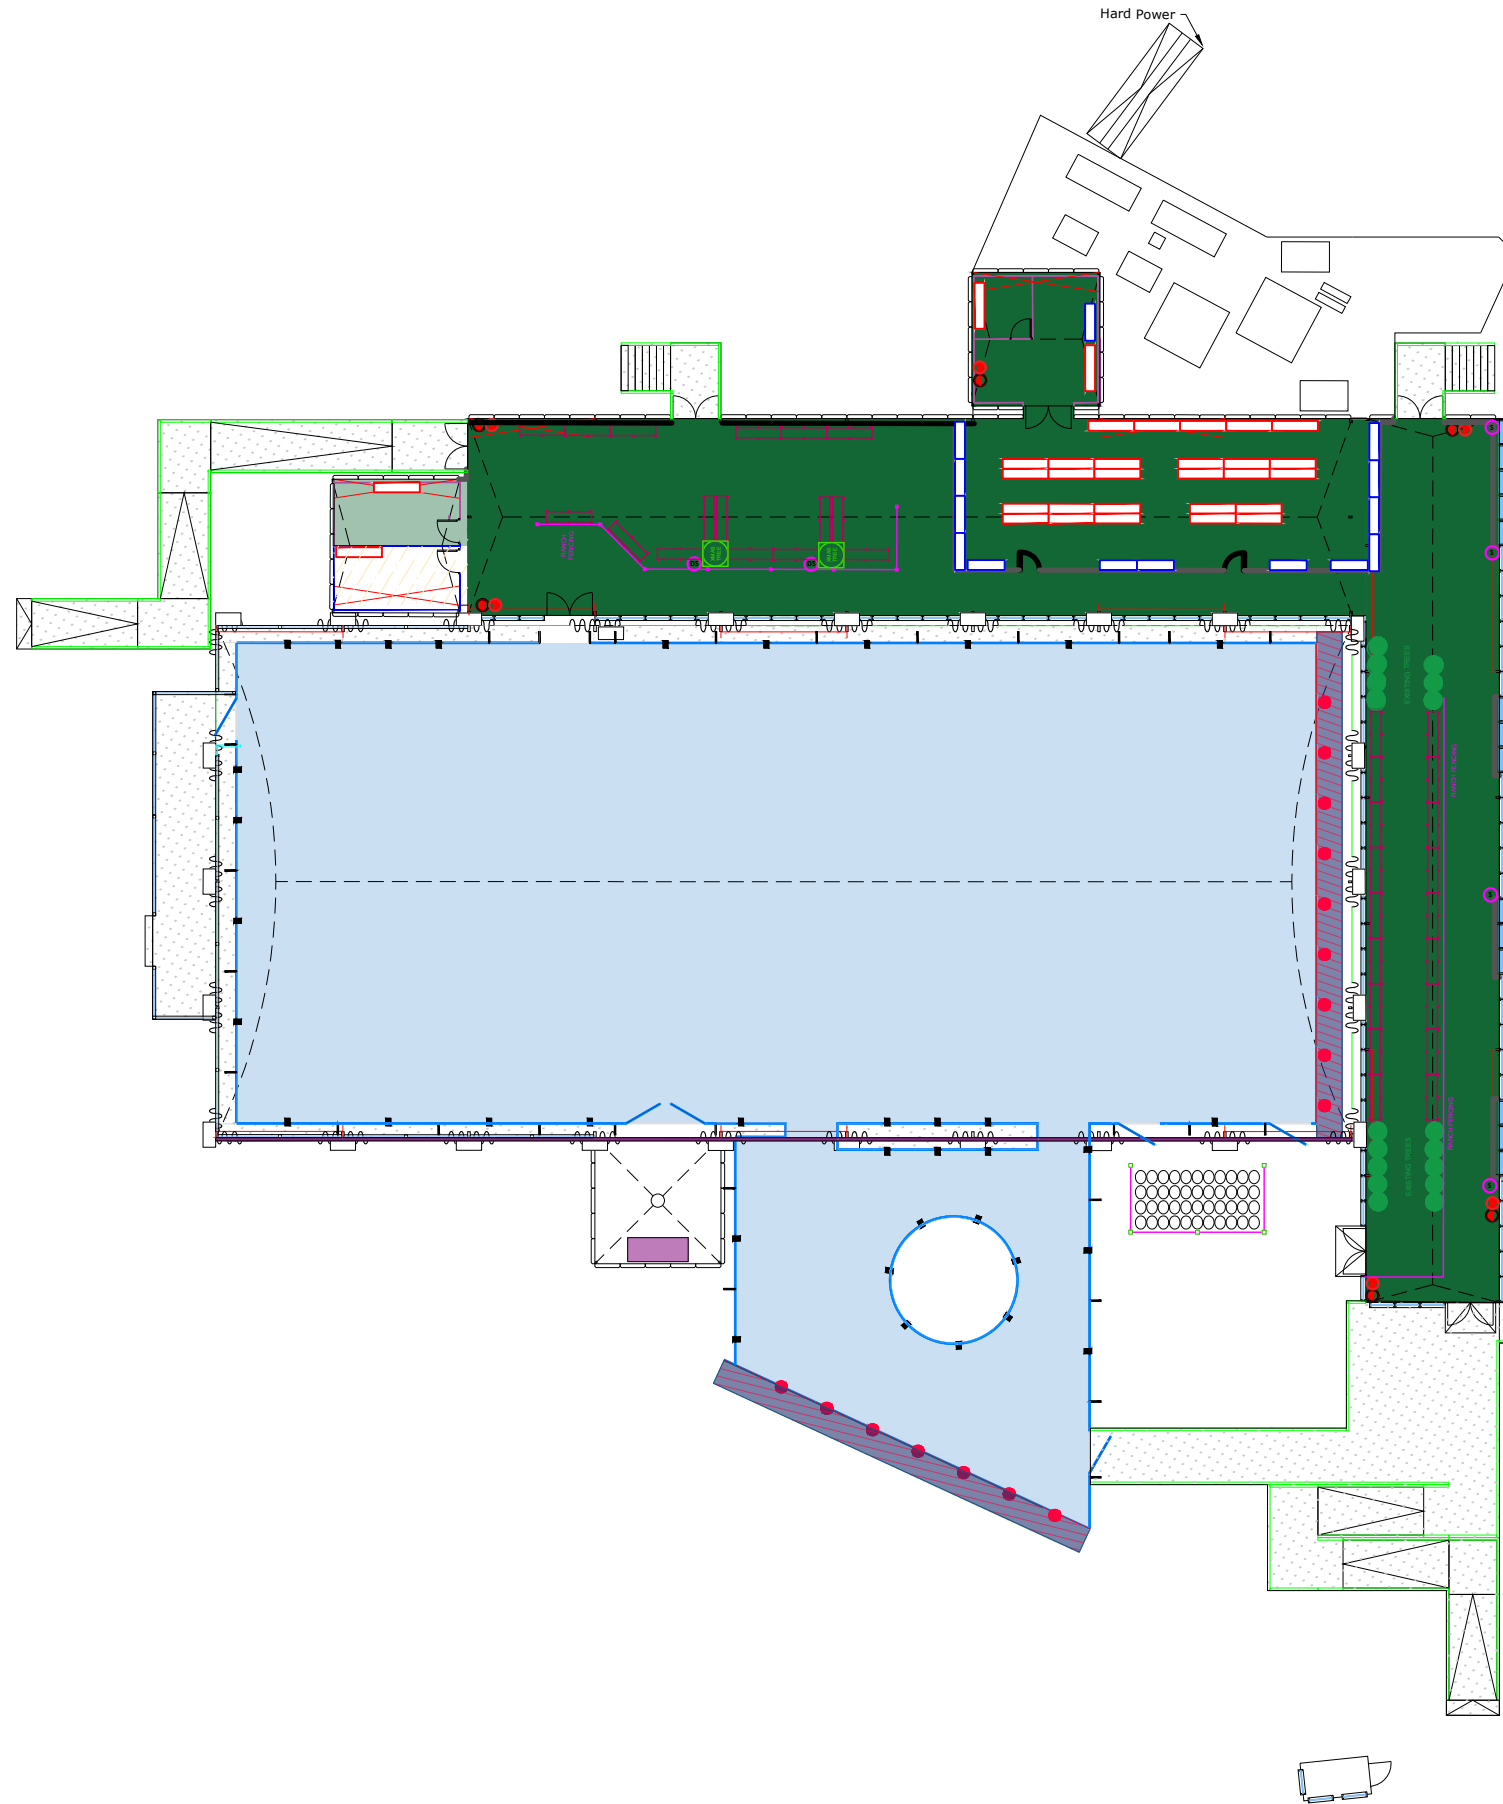

PROJECT Manchester Ice Rink 2023-24

VENUE
Todd Street,
Manchester, M4
3BG

DRAWING TITLE

Ice Rink
Health & Safety Plan

DRAWING NUMBER
180356 - 6HS

JOB N	ZONE	N.	CONTENT	REV
-------	------	----	---------	-----


180356-MC-01-MANCHESTER
ICE-ASB

DATE 06.07.23	SCALE ##### @ A3	DRAWN BY LWood
------------------	---------------------	-------------------


REV	COMMENTS	DATE	DRAWN
ASB	As Built Plan	10.01.24	LP/LWood

THE DESIGNS, CONCEPTS, AND MATERIALS (COLLECTIVELY REFERRED TO AS "DESIGNS") SUBMITTED HEREWITH ARE THE EXCLUSIVE AND PROPRIETARY PROPERTY OF ARENA GROUP ("PROPRIETOR"). THE DESIGNS ARE PROVIDED FOR THE SOLE PURPOSE OF EVALUATING AND CONSIDERING POTENTIAL COLLABORATION BETWEEN THE PROPRIETOR AND RECIPIENT OF THE DESIGNS AND MAY NOT BE REPLICATED, DISTRIBUTED OR OTHERWISE DISCLOSED TO ANY THIRD PARTY WITHOUT THE EXPRESS WRITTEN CONSENT OF THE PROPRIETOR.


IN THE EVENT THAT THIS DESIGN FORMS PART OF A SUBMITTED PROPOSAL, THEN PLEASE NOTE THAT IT MAY BE SUBJECT TO FURTHER DESIGN DEVELOPMENT, COST ANALYSIS AND MATERIAL AVAILABILITY.

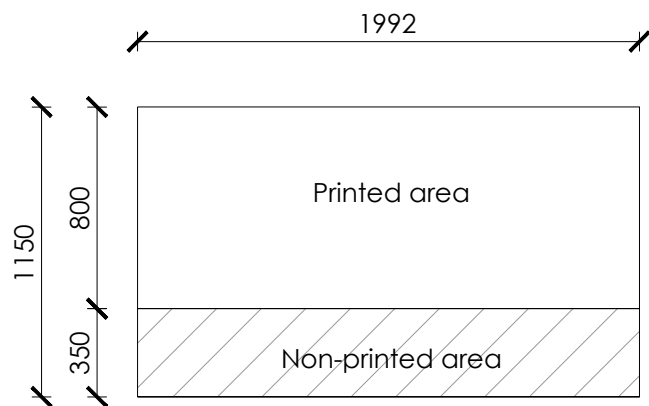


2m Barrier

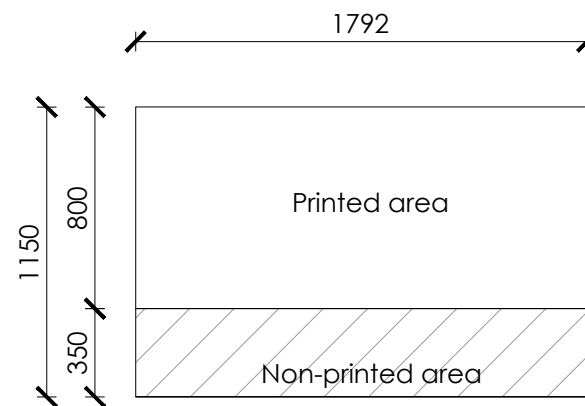


1.8m Barrier

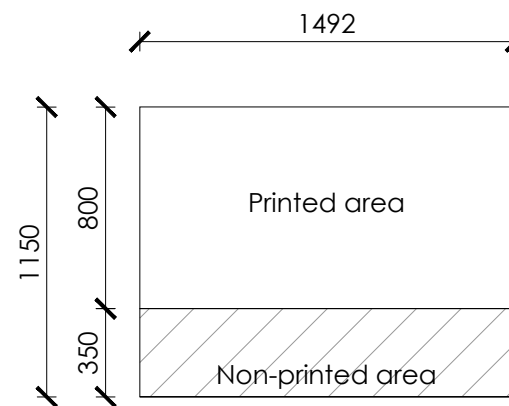


1.5m Barrier

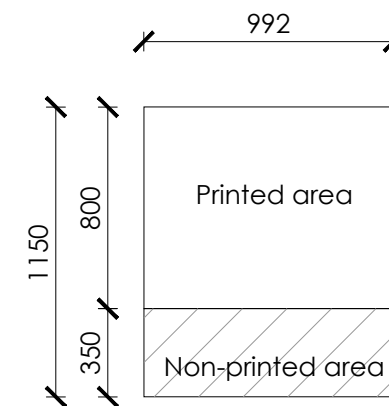


1m Barrier

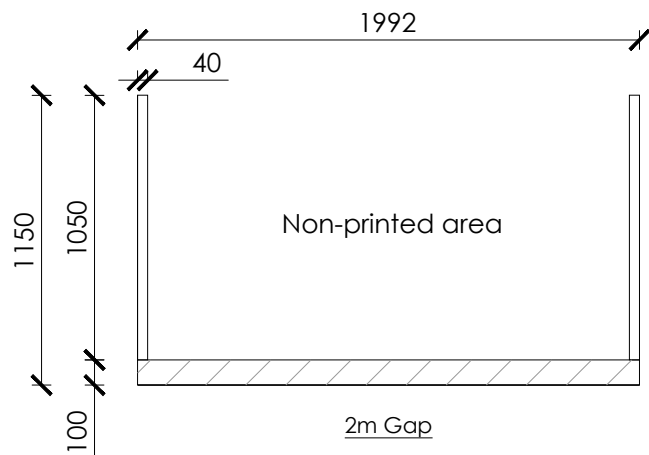


2m Gap

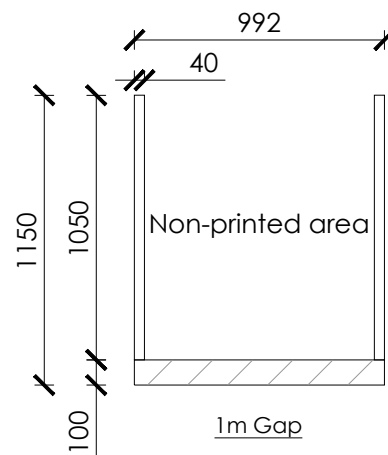


1m Gap

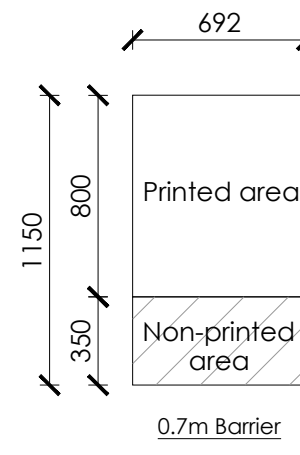


0.7m Barrier

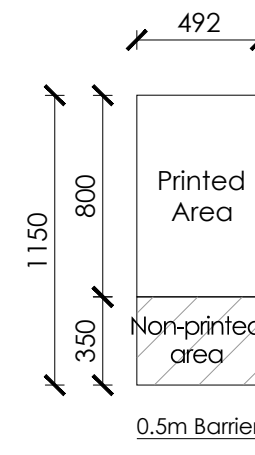


0.5m Barrier

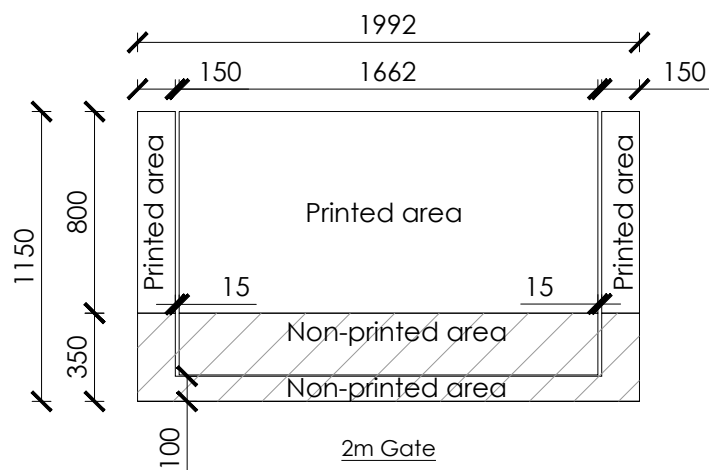

2m Gate

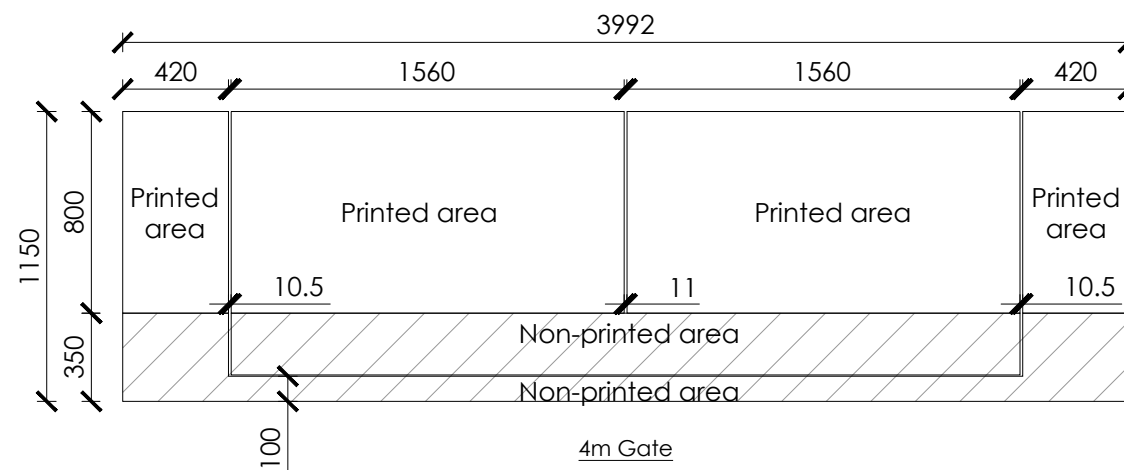

4m Gate

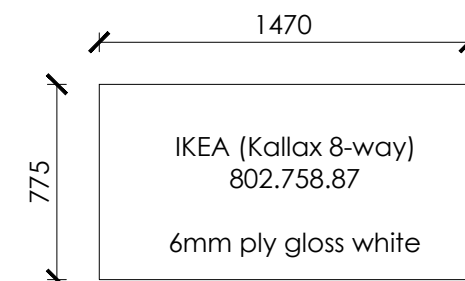

SKATE HIRE COUNTER FASCIA

NOTES:

- Header barriers are 1120mm O/A; Printed areas are the same dimensions as barriers shown above.
- Low-tack adhesive must be used for clear barriers. High-tack adhesive is required for opaque barriers.
- The client is responsible for the removal of any stickers/graphics applied to boarding plates. Any stickers/graphics not removed will be charged at £30.00 + VAT per plate (2m x 1m) and per side.

PROJECT			
Manchester Ice Rink 2023-24			
VENUE			
Todd Street, Manchester, M4 3BG			
DRAWING TITLE			
Ice Rink Barrier Detail			
DRAWING NUMBER			
180356 - 9PR			
JOB N	ZONE	N. CONTENT	REV
180356-MC-01-MANCHESTER ICE-ASB			
DATE	SCALE	DRAWN BY	
06.07.23	##### @ A3	LWood	
REV	COMMENTS	DATE	DRAWN
ASB	As Built Plan	10.01.24	LP/LWood
THE DESIGNS, CONCEPTS, AND MATERIALS (COLLECTIVELY REFERRED TO AS "DESIGNS") SUBMITTED HERewith ARE THE EXCLUSIVE AND PROPRIETARY PROPERTY OF ARENA GROUP ("PROPRIETOR"). THE DESIGNS ARE PROVIDED FOR THE SOLE PURPOSE OF EVALUATING AND CONSIDERING POTENTIAL COLLABORATION BETWEEN THE PROPRIETOR AND RECIPIENT OF THE DESIGNS AND MAY NOT BE REPLICATED, DISTRIBUTED OR OTHERWISE DISCLOSED TO ANY THIRD PARTY WITHOUT THE EXPRESS WRITTEN CONSENT OF THE PROPRIETOR. IN THE EVENT THAT THIS DESIGN FORMS PART OF A SUBMITTED PROPOSAL, THEN PLEASE NOTE THAT IT MAY BE SUBJECT TO FURTHER DESIGN DEVELOPMENT, COST ANALYSIS AND MATERIAL AVAILABILITY.			