




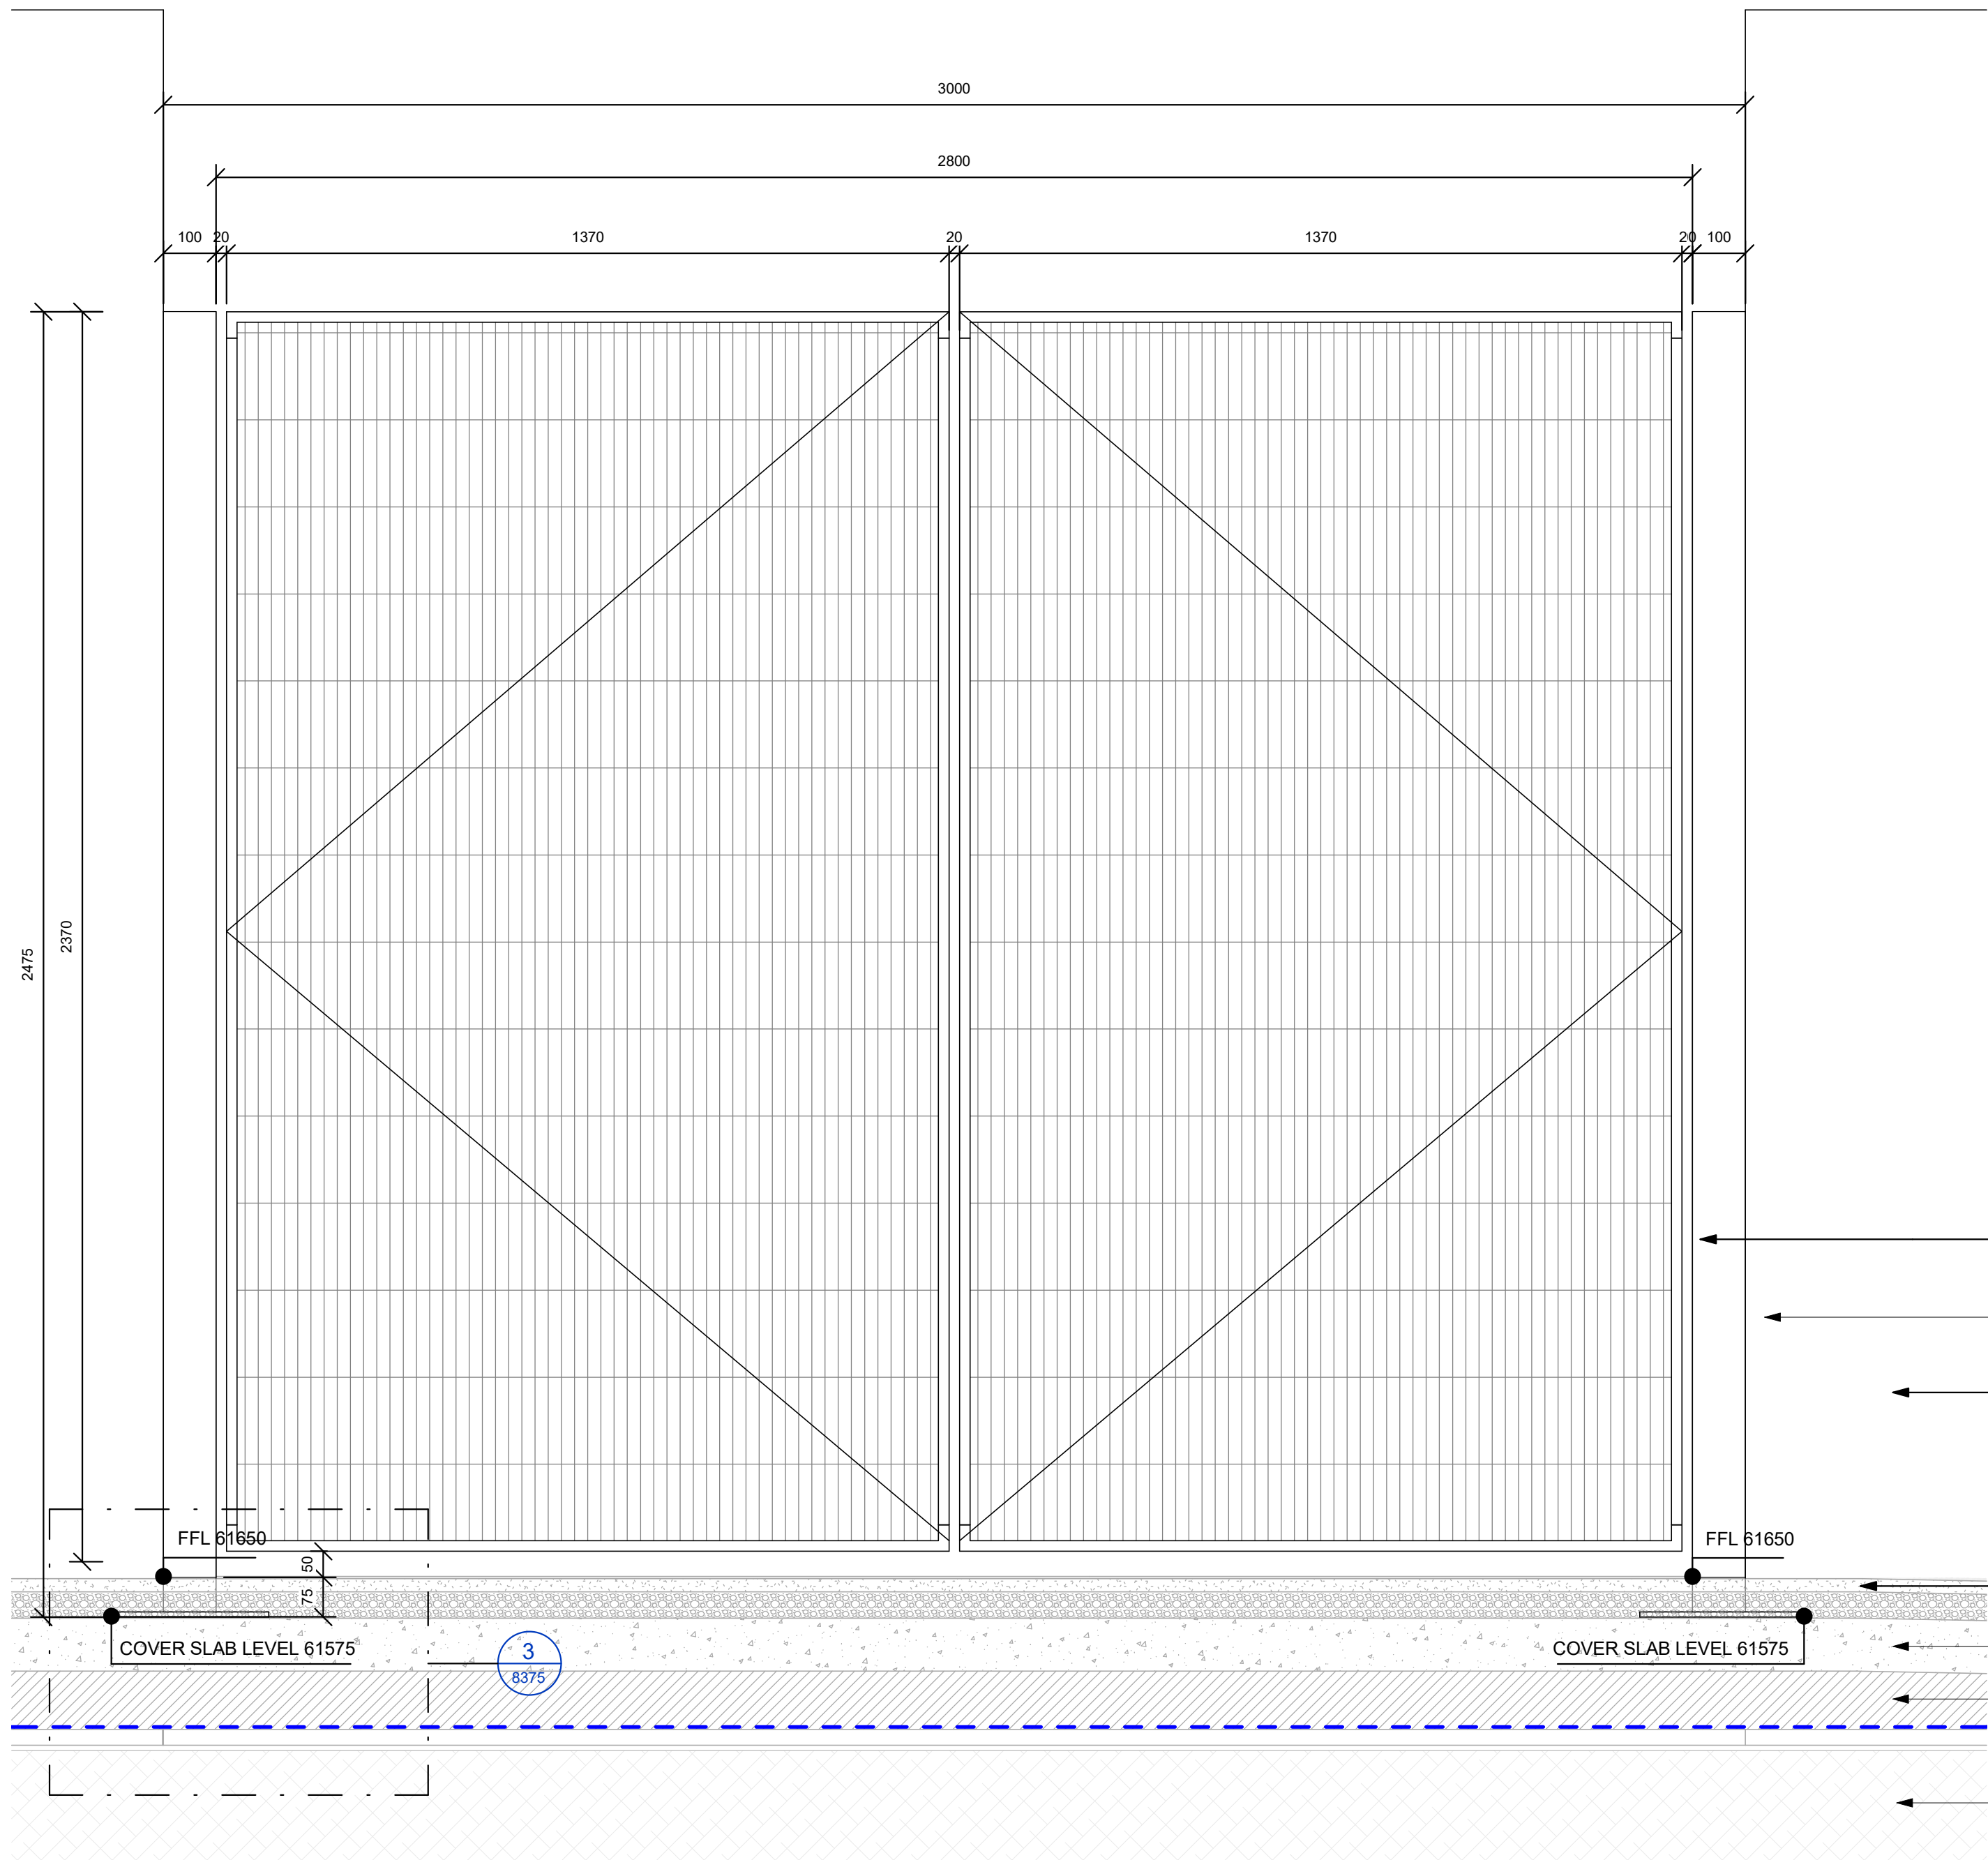


1 EXT-407 STEEL GATES - TYPE 3 (COMPOUND AREA) - ELEVATION

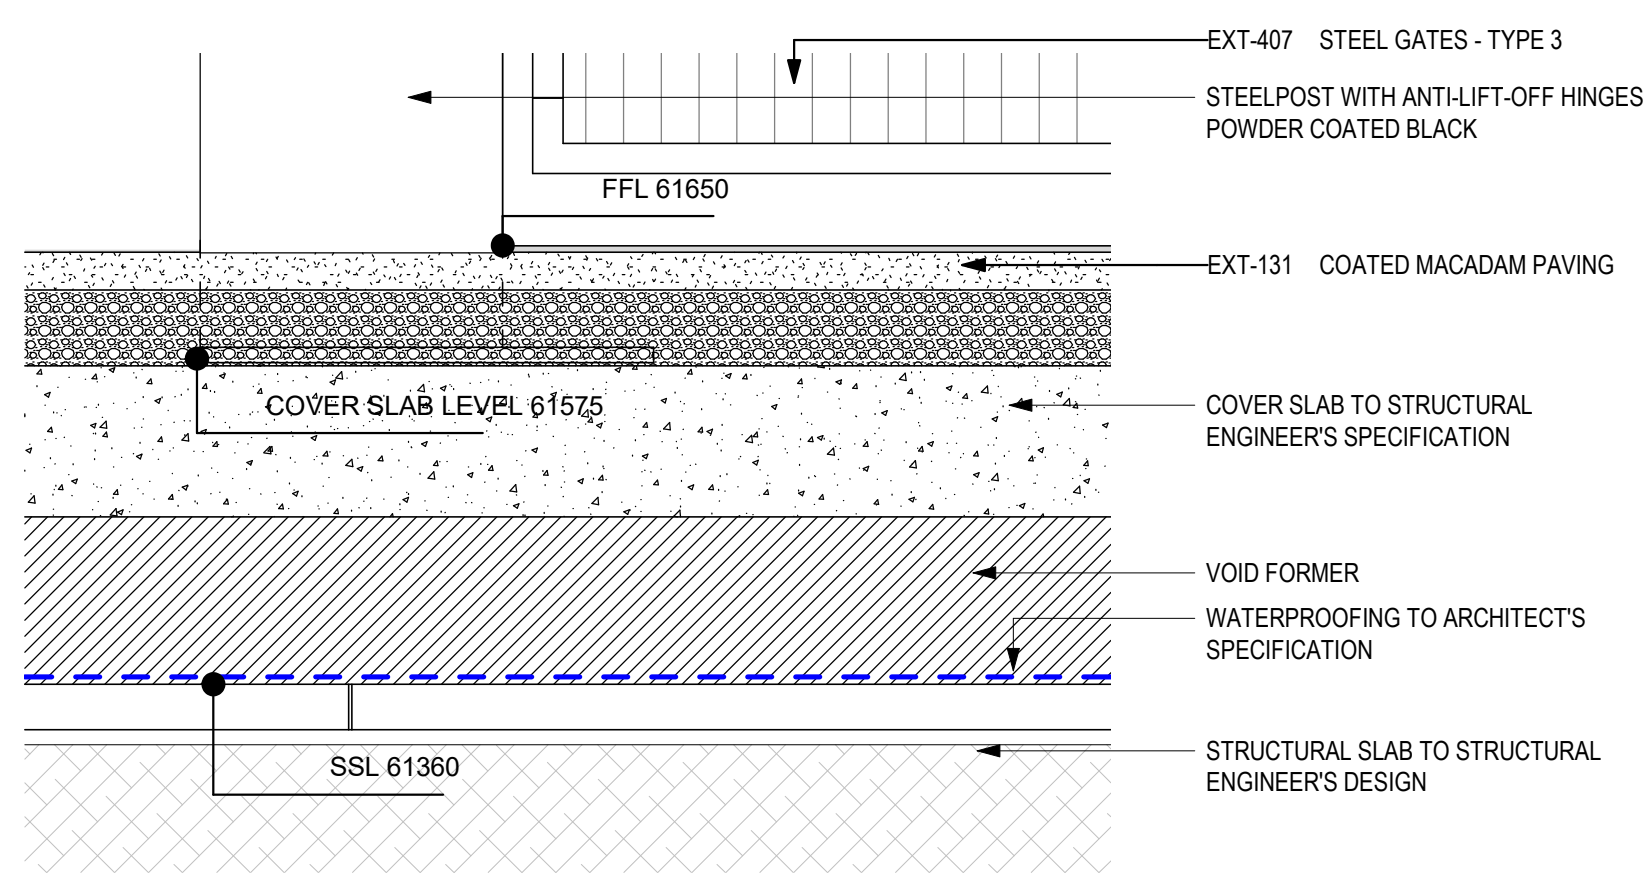

3 EXT-407 STEEL GATES - TYPE 3 (COMPOUND AREA) - DETAIL

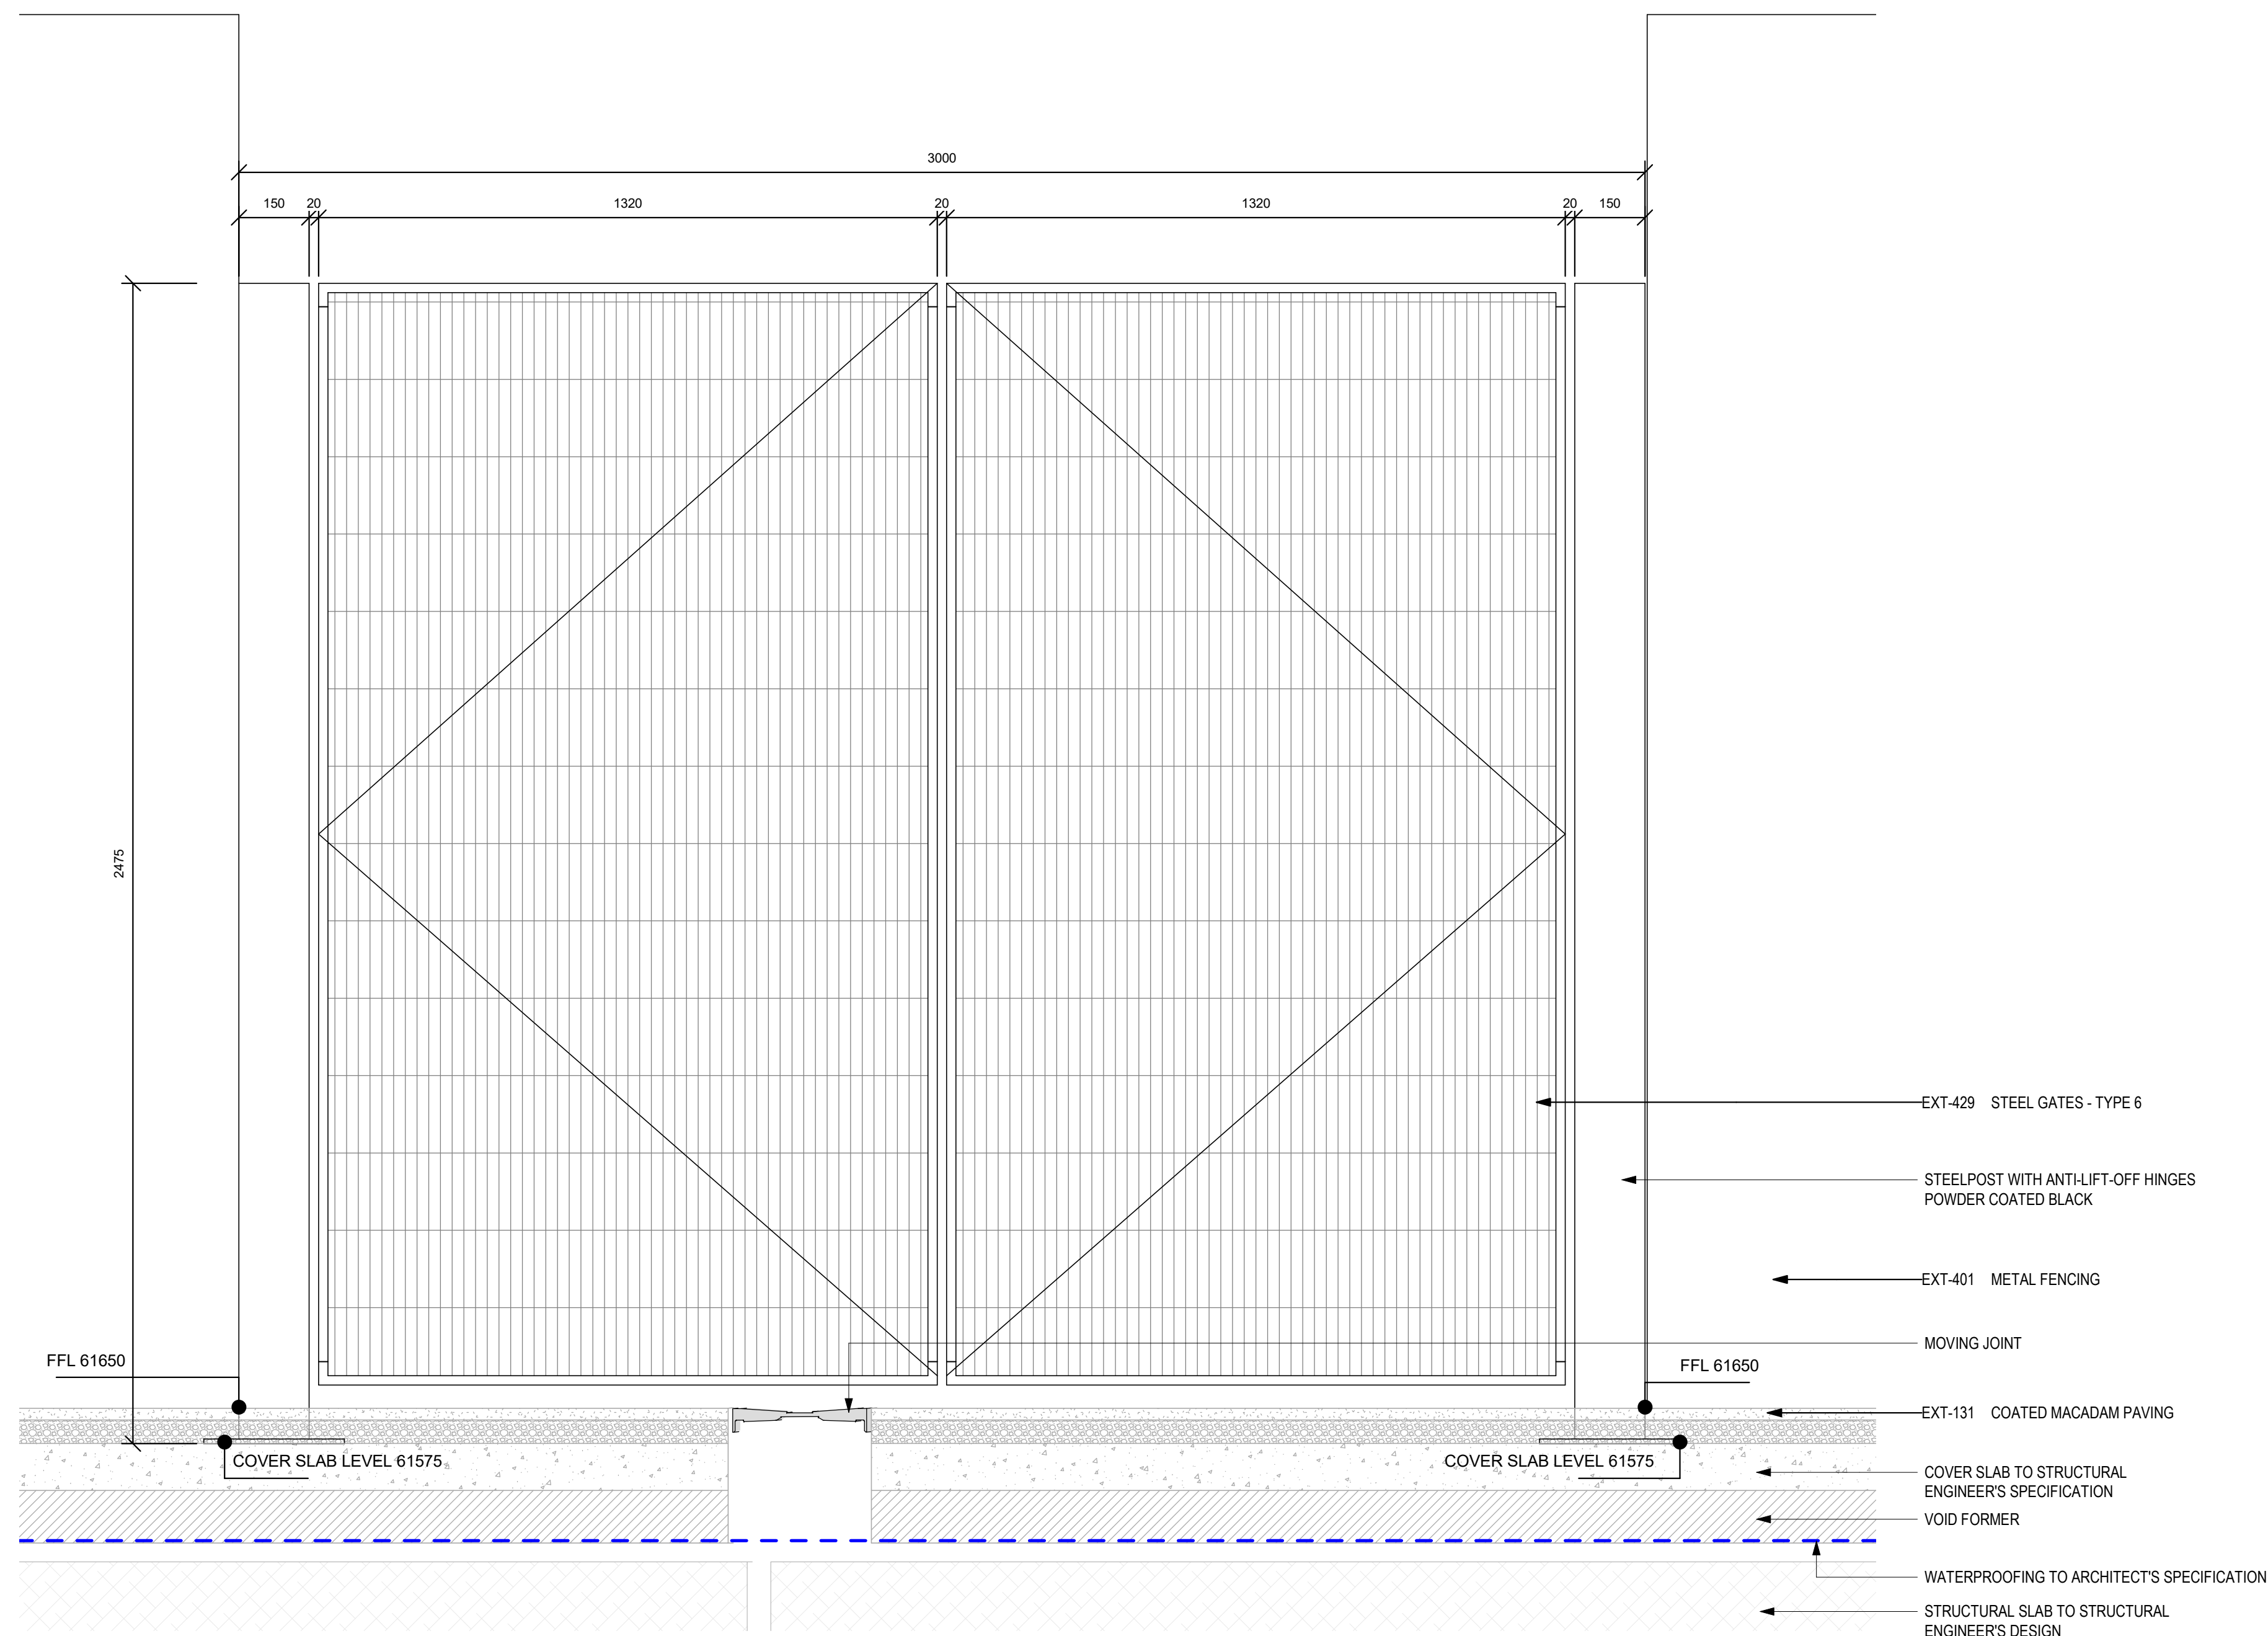

4 EXT-429 STEEL GATES - TYPE 6 (COMPOUND AREA) - ELEVATION

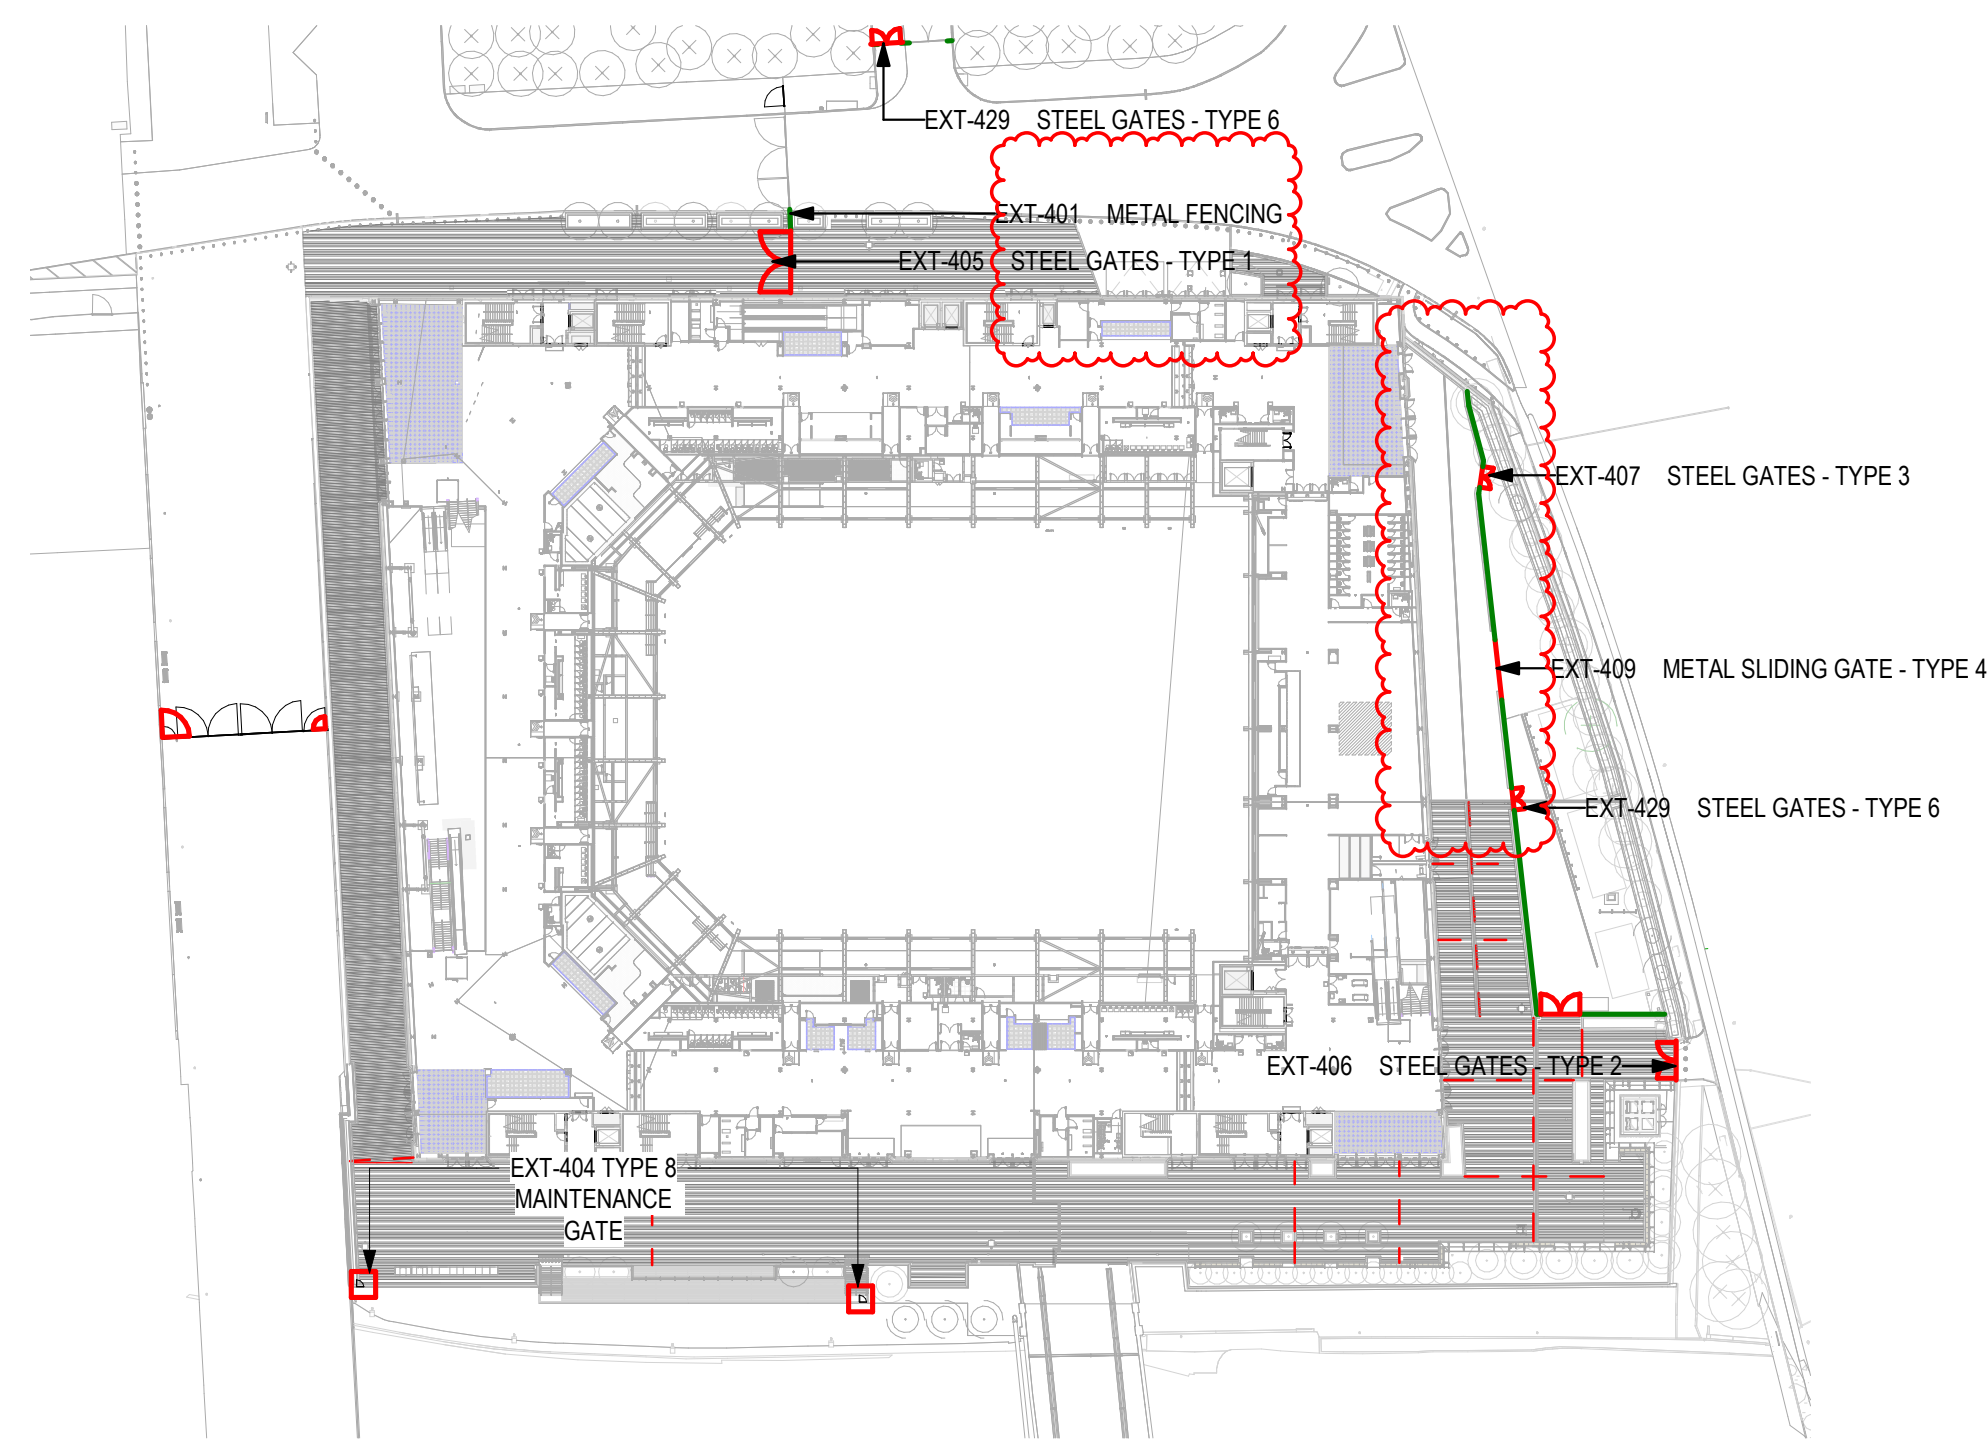

2 LOCATION PLAN

Suitability Code (as defined in ISO 19650-2:2018)

Work in Progress (WIP)

S0 - Under Review

Shared (Non-Contractual)

S1 - Suitable for co-ordination

S2 - Suitable for information

S3 - Suitable for review & comment

S4 - Suitable for review & comment

S5 - Withdrawn

S6 - Suitable for BIM authorisation

S7 - Suitable for BIM authorisation

Published (Contractual)

A1, A2, A3, Etc - Authorised and accepted

B1, B2, B3, Etc - Partial sign-off (with comments)

Published (AIM Acceptance)

CR - As constructed record document

KEY PLAN

KEY

GATE TYPES DESCRIPTION

EXT-406 TYPE 1 MILD STEEL VERTICAL OPEN RAIL SECURITY GATES TO MATCH EXISTING GATE DESIGN ON SPORTSCITY WAY

EXT-406 TYPE 2 MILD STEEL OPEN MESH PANEL SECURITY GATES

EXT-407 TYPE 3 MILD STEEL DOUBLE SWING OPEN MESH PANEL HIGH SECURITY GATES

EXT-409 TYPE 4 METAL OPEN MESH PANEL HIGH SECURITY GATE

EXT-428 TYPE 5 MILD STEEL OPEN MESH PANEL SECURITY GATES

EXT-429 TYPE 6 MILD STEEL OPEN MESH PANEL SECURITY GATES

EXT-431 TYPE 7 MILD STEEL SINGLE SWING SECURITY GATES TO MATCH EXISTING GATE DESIGN ON JOE MERCER WAY

EXT-404 TYPE 8 MAINTENANCE GATE

FENCE LOCATION DESCRIPTION

EWS-401 MILD STEEL OPEN MESH PANEL HIGH SECURITY FENCING

NOTES

1. GATES, SUPPORTS, FIXINGS AND UPSTANDS TO FOLLOW LOADING AND SECURITY REQUIREMENTS

2. FOR PAVING DETAILS REFER TO BRA-POP-ZZ-DR-L-8300

3. FOR TYPICAL GATE FIXING DETAILS REFER TO BRA-POP-ZZ-DR-L-8380 / 8381

4. ALL STRUCTURAL MEMBERS ARE SHOWN INDICATIVELY ONLY - REFER TO S.E.S. DET A.L.S. FOR SIZING

5. FOR TYPICAL FENCE FIXING REFER TO BRA-POP-ZZ-DR-L-8382

THIS DRAWING IS ONLY TO SCALE IF IT IS REPRODUCED AT THE CORRECT PAPER SIZE

1:10@A0

0 0.1 0.2 0.3 0.4 0.5 0.6 0.7 0.8 0.9 1.0

ALL INTERNAL LAYOUTS AND USES ARE SHOWN FOR ILLUSTRATIVE PURPOSES ONLY AND ARE NOT FOR DETERMINATION

Safety, Health and Environmental Information

In addition to the hazards / risks normally associated with the types of work detailed on this drawing, note the following risks and information:

Construction See risk register

No abnormal risks identified with this package of work.

For information relating to Use, Opening and Maintenance see the Health and Safety File. It is assumed that all works will be carried out by a competent contractor working, where appropriate, to an approved method statement.

04/2022

POPULOUS®

14 BLADES COURT | DEODAR ROAD | LONDON | SW16 2NU | UNITED KINGDOM

TELEPHONE +44 (0)20 8874 7666 FACSIMILE +44 (0)20 8874 7470

ALL PRODUCTION & INTELLECTUAL PROPERTY RIGHTS RESERVED © POPULOUS 2020

REVISIONS

REV DATE DESCRIPTION

001 27.08.2021 FENCES AND GATES ISSUED FOR CONSTRUCTION

002 07.09.2021 ADDITIONAL INFORMATION INCLUDED

003 02.06.2023 ADDITIONAL INFORMATION INCLUDED

004 05.09.2023 ADDITIONAL INFORMATION INCLUDED

005 14.05.2023 ADDITIONAL INFORMATION INCLUDED

006 20.06.2023 ADDITIONAL INFORMATION INCLUDED

007 16.03.2024 PAVING UPDATE

project name Co-op Live

the TYPICAL GATE DETAIL

COMPOUND AREA

GROUND LEVEL

scale 1:10, 1:100@A0

drawn FP

Project no. 4933

date 26/03/21

checked TJ

Suitability S4

project code originator version level type role number

reference BRA-POP-ZZ-ZZ-DR-L-8375

rev. C07