


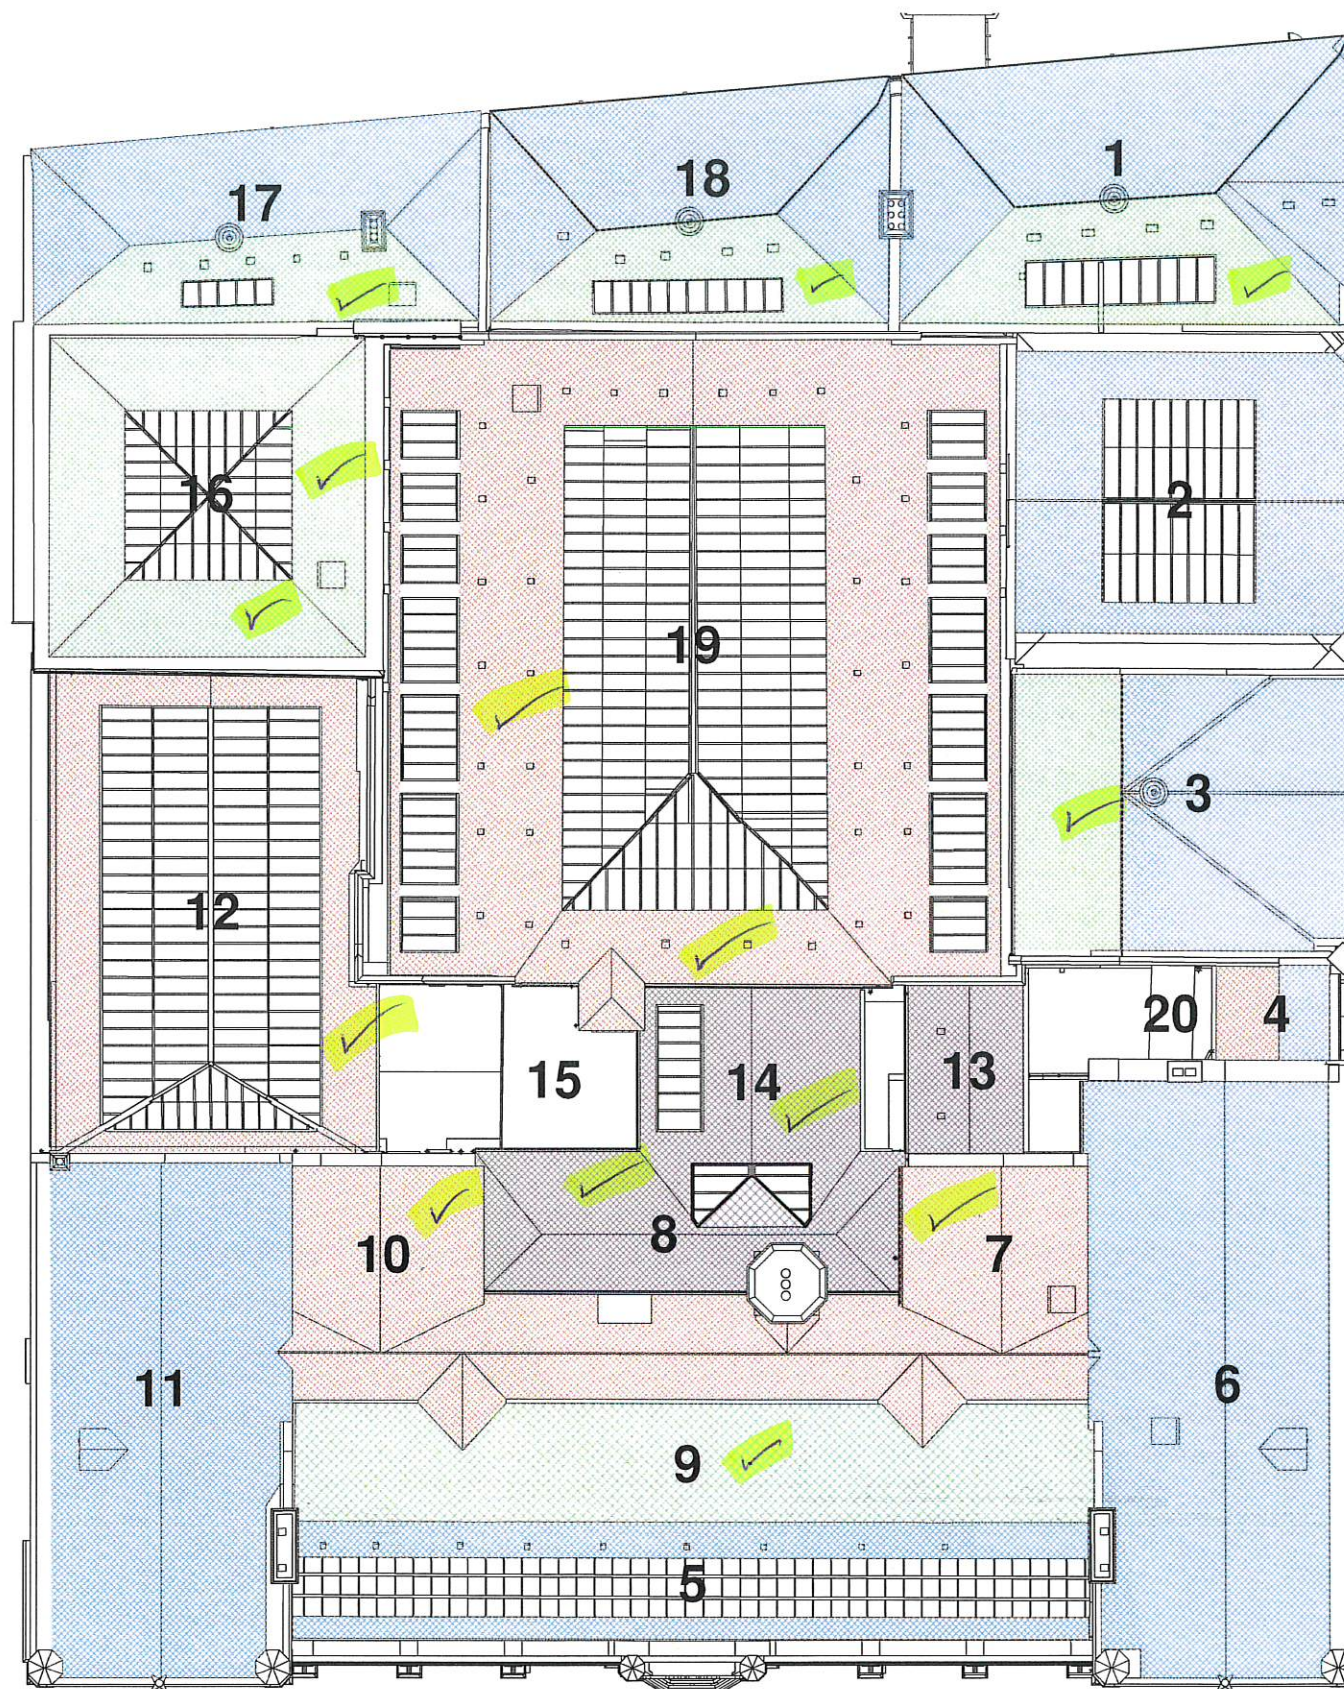

0m1m2m3m4m

Drawing Scale 1:50 @ A3

This drawing is subject to copyright and is not to be reproduced in part or whole without approval. Do not scale this drawing - check all dimensions on site .

LEGEND.	
	DENOTES EXISTING SLATES RE-USED ON THE PROMINENT ELEVATIONS. THE CURRENT ESTIMATE (24.11.2022.) IS THAT APPROXIMATELY 40% OF THE EXISTING SLATES ARE ABLE TO BE RE-USED.
	DENOTES EXISTING SLATES RE-USED, DESIRED 01, IF POSSIBLE, OR, NEW TO SITE RECLAIMED SLATES IF NOT POSSIBLE. AS ABOVE, THE CURRENT ESTIMATE (24.11.2022.) IS THAT APPROXIMATELY 40% OF THE EXISTING SLATES ARE ABLE TO BE RE-USED. HOWEVER, AS WORK PROCEEDS, IF IT IS FOUND TO BE THE CASE THAT MORE THAN 53% OF SLATES CAN BE RE-USED THEN THESE ROOFS ARE TO BE PRIORITISED.
	DENOTES EXISTING SLATES RE-USED DESIRED 01 + 02, IF POSSIBLE, OR, NEW TO SITE RECLAIMED SLATES IF NOT POSSIBLE. AS ABOVE, THE CURRENT ESTIMATE (24.11.2022.) IS THAT APPROXIMATELY 40% OF THE EXISTING SLATES ARE ABLE TO BE RE-USED. HOWEVER, AS WORK PROCEEDS, IF IT IS FOUND TO BE THE CASE THAT MORE THAN 79% OF SLATES CAN BE RE-USED THEN THESE ROOFS ARE TO BE PRIORITISED.
	DENOTES (NEW TO SITE) RECLAIMED SLATES

Item	Roof Area (Approximately)	Percentage (Approximately)
Overall Slate Roof Area	1655m ²	----
Blue Hatching	769m ²	46%
Blue + Green Hatching	879m ²	53%
Blue + Green + Red Hatching	1318m ²	79%

✓ DENOTES AREAS INSTALLED AS PER THE DETAILS IN THIS LEGEND. *[Signature]* 07/03/2024

Cassidy+Ashton

www.cassidyashton.co.uk

Architecture + Building Surveying + Town Planning

7 East Cliff, Preston, Lancashire, PR1 3JE
10 Hunters Walk, Canal Street, Chester, CH1 4EB
St Andrews Business Centre, Mold, Flintshire, CH7 1XB

T: 01772 258 356
T: 01244 402 900
T: 01352 706 246

C+A

Client

Manchester Metropolitan University

Project

Grosvenor Lifecycle Refurbishment Project

C01	FIRST ISSUE	NA	24.11.2022
Rev	Description	By	Date
Drawing Title SLATE RENEWAL STRATEGY Areas Showing Where Existing Slates Are To Be Re-used And Where (new to site) Reclaimed Slates Are To Be Used.			
Drawn by	NA	Checked by	SB Date 25.11.2022
Suitability	A Scale @ A3 Not To Scale		
10034	1002B-CAA-XX-ZZ-DR-A-017115	C01	
C+A JOB NO.	PROJECT - ORIGINATOR - VOL. - LEVEL - TYPE - ROLE - NUMBER	REV.	