


STADIUM EGRESS | PHASE 1 (DRAFT)

Scenario	Width	Spectators	Peak Flow Rate (ppmm)
Modelled	14.0	11,320	41
As Built	13.4	11,320	43

Scenario	Width	Spectators	Peak Flow Rate (ppmm)
Modelled	12.4	9,150	37
As Built	11.95	9,150	39

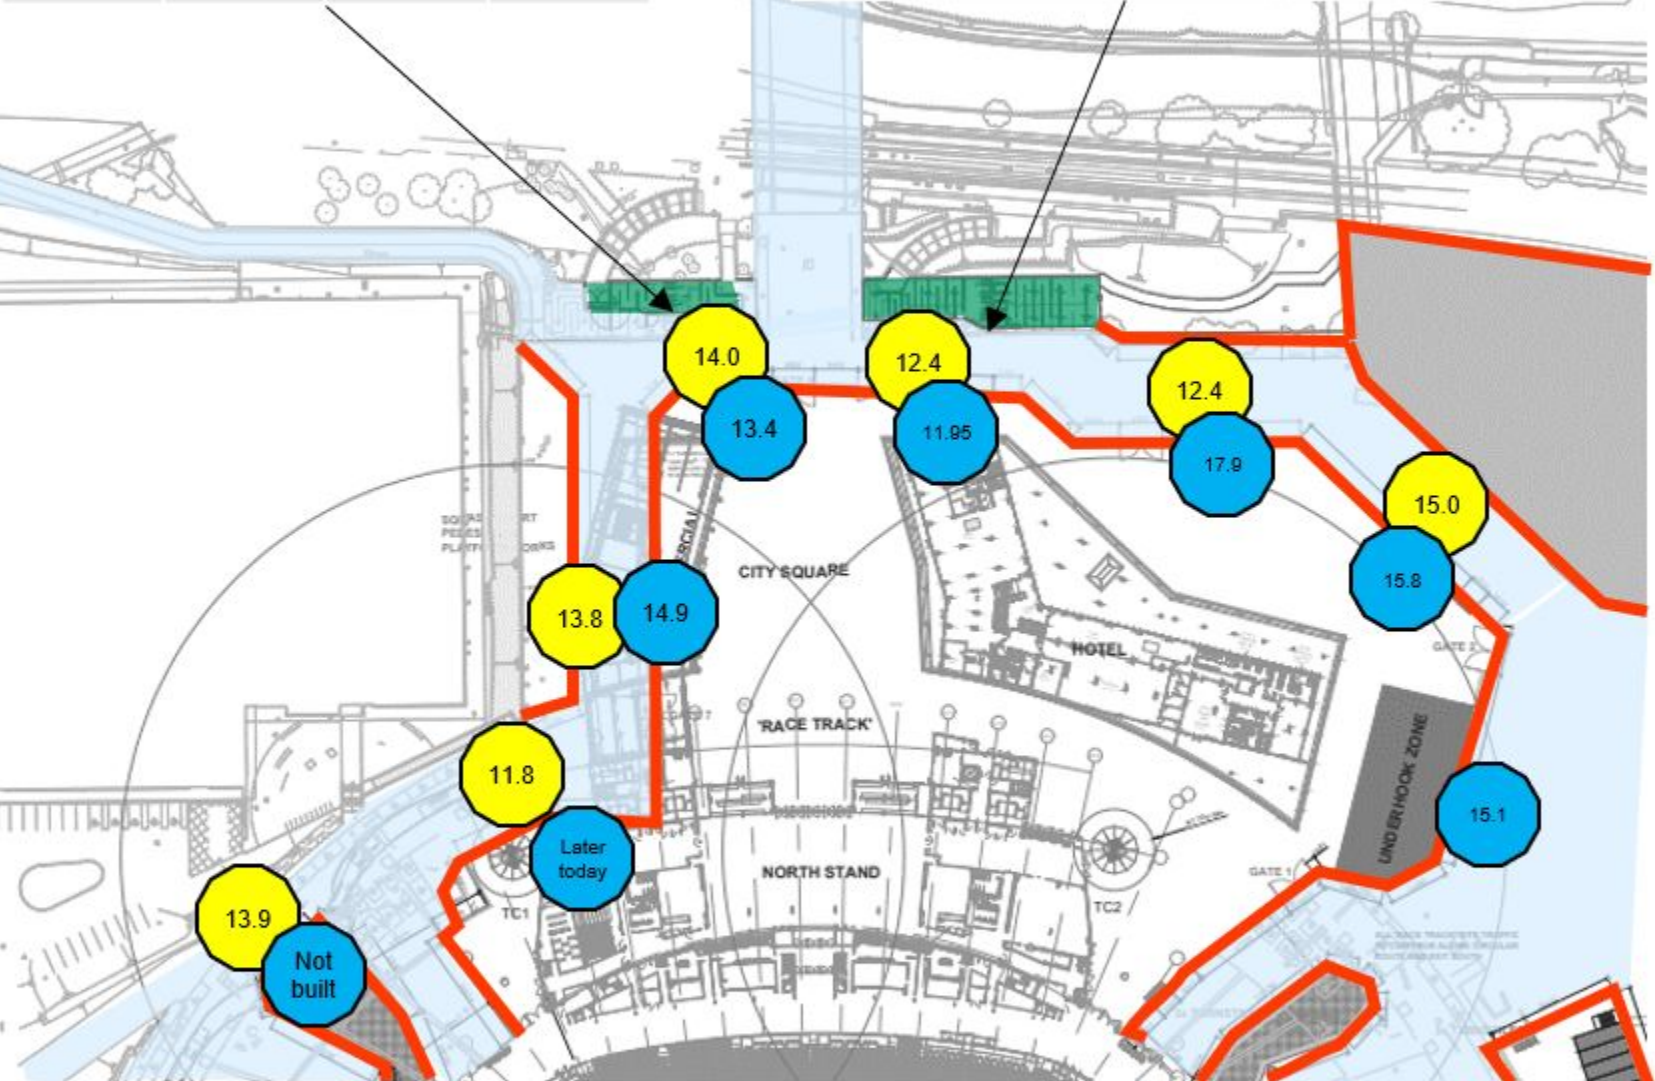

Phase 1 construction hoarding layout (Source: Sisk)

-  Pedestrian circulation space
-  Metrolink queue
-  Hoarding line

-  Minimum pedestrian circulation widths (metres) considered in the original construction hoarding modelling (12588700-230412 MCFC Construction Hoarding Impact Assessment Stage 3 Part 2 Crowd Modelling_DRAFT.pdf)
-  MCFC site visit measurements (metres) on Wednesday 16 August 2023