

**DRAINAGE INSTALLATION
VERIFICATION REPORT**
for a development at
GLENDENE, WYTHENSHAW
Undertaken on behalf of
THE CASEY GROUP LTD

Report Title:	Drainage Installation Verification Report
Report Reference:	9003-WML-ZZ-XX-RP-C-1000
Client:	The Casey Group Ltd
Issue Date:	January 2024
Drafted By:	Daniel Baker
Authorised By:	Natalie Brock

This document has been prepared for the titled project (or named part thereof) and should not be relied upon or used for any other project without an independent check being carried out as to its suitability and prior written authorization being obtained from WML Consulting. WML accepts no responsibility or liability for the consequences of the use of this document, wholly or in part, for any other purpose than that for which it was commissioned. Any persons so using or relying upon this document for such other purpose do so at their own risk.

This report was prepared for the sole use of the Client and shall not be relied upon or transferred to any other party without the express written authorisation of WML. It May contain material subject to copyright or obtained subject to license; unauthorised copying of this report will be in breach of copyright/license.

The findings and opinions provided in this document are given in good faith and are subject to the limitations imposed by employing site assessment methods and techniques, appropriate to the time of investigation and within the limitations and constraints defined within this document. The findings and opinions are relevant to the dates when the assessment was undertaken, but should not necessarily be relied upon to represent conditions at a substantially later date.

The findings and opinions conveyed in this report are based on information obtained from a variety of sources as detailed and which WML assumes to be reliable, but has not been independently confirmed. Therefore, WML cannot and does not guarantee the authenticity or reliability of third party information it has relied upon.

Where opinions expressed in this report are based on current available guidelines and legislation, no liability can be accepted by WML for the effects of any future changes to such guidelines and legislation.

The limitations of liability of WML for the contents of this document have been agreed with the Client, as set out in the terms and conditions of offer and related contract documentation.

WML Consulting Ltd
No. 8 Oak Green,
Earl Road,
Stanley Green Business Park,
Cheadle Hulme,
Cheshire
SK8 6QL

Tel: 0161 482 0600
Email: info@wmlconsulting.com
www.wmlconsulting.com

DRAINAGE INSTALLATION VERIFICATION REPORT

- 1.0 WML Consulting have been commissioned by The Casey Group Ltd (TCGL) to provide a response to planning condition 15 of planning consent ref. 129195 / FO / 2021.
- 1.1 The proposed development relates to the construction of a new residential development, comprising 56no low rise residential houses and associated parking / landscaping following the demolition of the former children's care home.
- 1.2 Condition 15 of this consent is as below in blue font.

No development hereby permitted shall be occupied until details of the implementation, maintenance and management of the sustainable drainage scheme have been submitted to and approved by the local planning authority. The scheme shall be implemented and thereafter managed and maintained in accordance with the approved details. Those details shall include:

- Verification report providing photographic evidence of construction as per design drawings;
- As built construction drawings if different from design construction drawings;
- Management and maintenance plan for the lifetime of the development which shall include the arrangements for adoption by any public body or statutory undertaker, or any other arrangements to secure the operation of the sustainable drainage scheme throughout its lifetime.

Reason: To manage flooding and pollution and to ensure that a managing body is in place for the sustainable drainage system and there is funding and maintenance mechanism for the lifetime of the development.

- 1.3 In response to the above WML have produced this document which contains a series of appendices as listed below

- **Appendix A** – drawings indicating the as installed below ground drainage infrastructure.

Note that TCGL have confirmed that the below ground drainage proposals were installed in line with WML's construction status drawings and calculations.

- **Appendix B** – Surface water drainage calculations for the systems indicated on drawing 1001.
- **Appendix C** – Photographs of the installation of the drainage infrastructure.

Maintenance of the below ground drainage system

- 1.5 It is understood that a portion of the proposed site drainage system, primarily constrained within the new extent of adoptable highway has been adopted by United Utilities (UU). The extent of adopted drainage has been indicated on WML Drawings 9003-WML-ZZ-XX-DR-C-1001 – 1005.
- 1.6 The inspection, maintenance and repair of this drainage falls under the responsibility of United Utilities and therefore any issues with said drainage should be raised with them directly using the following contact information;
- UU Customer Services: +44 (0)345 6723 723
 - <https://www.unitedutilities.com/help-and-support/contact-us/>

- 1.7 It should also be noted that the road gullies and associated lateral connections located within the extent of adoptable highway fall under the ownership of the local highway's authority and therefore any issues with said drainage should be raised with them directly using the following contact information;
- Manchester City Council Switchboard: +44 (0)161 234 5000
- 1.8 The remaining drainage is understood to be the shared responsibility of the residents or site owners' management team / company. Though it may be necessary to involve a specialist drainage maintenance company also as and when needed.
- 1.9 The below ground foul and surface water drainage proposals indicated are relatively traditional in nature, and should provide years of relatively low maintenance operation in relation to the anticipated lifespan of the proposed development.
- 1.10 In line with current good practice: -
- **Gullies and linear drainage channels.** These should be inspected and / or cleaned out at 6 monthly intervals or following heavy storms that may wash detritus into them. Any problems highlighted by these inspections will need to be investigated, possibly by CCTV survey, to confirm the nature of the problem and to allow it to be remedied in a timely manner.
 - **Inspection chambers, manholes, catchpits, etc.** These should be inspected at 6 monthly intervals or following heavy storms to ensure that the pipework associated with them is running freely. Any problems highlighted by these inspections will need to be investigated, possibly by CCTV survey, to confirm the nature of the problem and to allow it to be remedied in a timely manner.
 - **Hydrobrake flow controls.** It has been necessary to incorporate 3No. Hydrobrake flow control devices as part of the proposed surface water design. These should be inspected at 6 monthly intervals or following heavy storms to ensure that the pipework associated with them is running freely. Any problems highlighted by these inspections will need to be investigated, possibly by CCTV survey, to confirm the nature of the problem and to allow it to be remedied in a timely manner.


Two of the proposed Hydrobrake flow control units are located within the extent of adoptable drainage and therefore any maintenance requirement will be under the ownership and responsibility of United Utilities, however the third is located within the private drainage system.

The flow control manufacturer, Hydro International, provides a cleaning, maintenance and repair services for the hydrobrake that includes; scheduled cleaning, emergency breakdown assistance, on-site repairs, equipment strip-down, planned maintenance & planned spares replacements. Should this be of interest to the occupier, the contact information for Hydro International can be found below;

Hydro International
Unit 2 Rivermead Court,
Kenn Business Park,
Clevedon,
BS21 6FT
+44 (0)1275 878371
enquiries@hydro-int.com

- 1.11 It is anticipated that the majority of the maintenance of the below ground drainage system will be carried out by the site owner's management team / company. Though it may be necessary to involve a specialist drainage maintenance company also as and when needed.
- 1.12 TCGL will be responsible for the maintenance of the below ground drainage systems for twelve months following handover of the development, currently forecast to happen 11th Feb 2022.
- 1.13 Wythenshawe Community Housing Group will be responsible for the maintenance of the below ground drainage systems after 26th Jan 2024.
- 1.14 It is considered that this document with its various appendices adequately responds to the information requested via planning condition 15, and hence it can be discharged.

APPENDIX A
Record Drawings

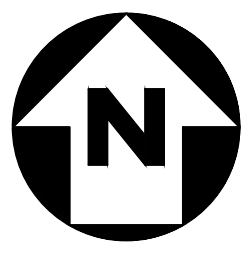

SHEET 1

SHEET 3

LEGEND

- PROPOSED PRIVATE SURFACE WATER SEWER
- PROPOSED PROPOSED FOUL WATER SEWER
- PROPOSED ADOPTED SURFACE WATER SEWER
- PROPOSED ADOPTED FOUL WATER SEWER
- PROPOSED ADOPTED COMBINED WATER SEWER
- PROPOSED CONCRETE ENCASEMENT TO SEWER
- EXISTING ADOPTED COMBINED WATER SEWER
- DENOTES EXISTING UNITED UTILITIES EASEMENT
- DENOTES SITE BOUNDARY

SUBJECT TO APPROVAL FROM
UNITED UTILITIES

DESIGN ASSUMPTIONS

THE PROPOSED DRAINAGE DESIGN ON THIS DRAWING IS BASED ON THE FOLLOWING ASSUMPTIONS:

ALL DRAINAGE COVER LEVELS SHOWN ARE INDICATIVE AND ARE SUBJECT TO FINAL LEVEL DESIGN BY THE ARCHITECT.

R/WPS AND SLAB PENETRATIONS ARE SHOWN INDICATIVE ONLY. FOR FINAL SETTING OUT REFER TO ARCHITECT DRAWINGS.

THE DRAINAGE DESIGN / INFORMATION SHOWN ON THIS DRAWING IS INDICATIVE ONLY AND IS SUBJECT TO CONFIRMATION OF THE EXISTING UNITED UTILITIES PUBLIC SEWER DEPTHS.

RAIN WATER PIPES AND SLAB PENETRATIONS ARE SHOWN INDICATIVE ONLY. ARCHITECT IS TO CONFIRM FINAL POSITIONS PRIOR TO DETAILED DESIGN.

PROPOSED FLOW RATES ARE AS OUTLINED IN THE DRAINAGE STRATEGY ASSUME THAT THE LOCAL PLANNING AUTHORITY & UNITED UTILITIES DO NOT IMPOSE FURTHER RESTRICTIONS TO DISCHARGE RATES.

GENERAL NOTES

DO NOT SCALE FROM THIS DRAWING WORK TO FIGURED DIMENSIONS ONLY.

NO DEVIATION FROM THE DETAILS SHOWN ON THIS DRAWING IS ALLOWED WITHOUT PRIOR PERMISSION IN WRITING.

ALL DRAWINGS ARE TO BE READ IN CONJUNCTION WITH ALL ARCHITECTS, ENGINEERS AND SPECIALISTS DRAWINGS AND THE SPECIFICATION.

THE CONTRACTOR SHALL INCORPORATE ALL THE REQUIREMENTS OF THE PRE-TENDER STAGE HEALTH AND SAFETY PLAN.

THIS DRAWING IS TO BE READ IN CONJUNCTION WITH WML DRAINAGE DETAIL DRAWINGS FOR DETAILS OF MATERIALS AND WORKMANSHIP REFER TO THE SPECIFICATION.

THE CONTRACTOR IS RESPONSIBLE FOR CHECKING INVERT LEVELS AND POSITIONS OF ALL EXISTING DRAINS, SEWERS, INSPECTION CHAMBERS AND MANHOLES SHOWN ON THIS DRAWING IMMEDIATELY ON SITE ESTABLISHMENT. ANY DISCREPANCIES MUST BE REPORTED TO WML CONSULTING IMMEDIATELY.

WHERE THE NEW SITE DRAINAGE CONNECTS IN TO EXISTING MANHOLES IN CARRIAGEWAYS AND/OR EXISTING ADOPTED SEWERS, THE CONTRACTOR IS RESPONSIBLE FOR ALL LIAISON WITH THE RELEVANT STATUTORY UNDERTAKER AND LOCAL AUTHORITY WITH REGARD TO ROAD CLOSURES, TRAFFIC MANAGEMENT, PERMITS TO WORK, SUBMISSION OF CONTRACTORS METHOD STATEMENTS AND RISK ASSESSMENTS AND OTHER DOCUMENTATION AND CORRESPONDENCE ASSOCIATED WITH THE SITE STAGE (PART 2) ELEMENT OF THE WORKS.

ROCKER PIPES TO BE PROVIDED AT ALL CONCRETE CASED INTERFACES.

PROVIDE ADEQUATE PROTECTION TO MAINTAIN MINIMUM COVER TO DRAINS DURING THE CONSTRUCTION PERIOD.

COVER LEVELS ON THIS DRAWING ARE APPROXIMATE AND INDICATIVE ONLY ARCHITECT TO CONFIRM COVER LEVELS TO ALL MANHOLES AND GULLIES PRIOR TO CONSTRUCTION.

THE LAYOUT OF DRAINAGE ON THIS DRAWING IS INDICATIVE ONLY ARCHITECT TO CONFIRM EXACT LOCATION OF MANHOLES AND GULLIES.

U.N.Q. ALL DRAINAGE GOODS & FITTINGS TO BE:-

UPTO 3000 (AND INCLUDING) TO BE SUPERSLEVE VITRIFIED CLAY PIPES OR SIMILAR.

ABOVE 3000 TO BE CONCRETE BY STANTON BONNA OR SIMILAR.

ALL COVERS AND RODDING ACCESS POINTS TO BE SEALED AND SECURED TIGHT.

ALL INTERNAL MANHOLE COVERS TO BE DOUBLE SEALED, LOCKABLE AND RECESSED TO ACCEPT FLOOR FINISHES WHERE APPLICABLE.

SETTING OUT OF ALL INTERNAL GULLY/PLUMBING CONNECTIONS TO BE CO-ORDINATED BETWEEN THE SERVICE ENGINEERS AND THE ARCHITECT.

ALL INTERNAL GULLIES, PLUMBING CONNECTIONS, SOIL STACKS, SIPS AND ALL OTHER CONNECTIONS OF FOUL AND SURFACE WATER DRAINS TO BELOW GROUND TO BE FITTED WITH ACCESSIBLE RODDING POINTS ABOVE SLAB LEVEL.

ALL SURFACE WATER CONNECTIONS TO BE 150mm DIAMETER AT MINIMUM FALLS OF 1:80 UNLESS NOTED OTHERWISE.

ALL FOUL WATER CONNECTIONS TO BE 150mm DIAMETER AT MINIMUM FALLS OF 1:150 UNLESS NOTED OTHERWISE.

ALL CONNECTIONS TO BE MADE IN ACCORDANCE WITH STANDARD DETAIL DRAWINGS.

ALL PIPEWORK TO BE INSTALLED WITH SOFFITS LEVEL (E.G. AT CHANGES IN PIPE SIZE) U.N.Q.

FOR DETAILS OF GREASE TRAP/MACERATOR REQUIREMENTS ASSOCIATED WITH KITCHENS REFER TO SERVICE ENGINEER.

ON COMPLETION OF DRAINAGE WORKS, THE NEW DRAINAGE SYSTEM IS TO BE THOROUGHLY CLEANED AND A CCTV SURVEY CARRIED OUT TO CONFIRM NO CONSTRUCTION DEBRIS OR BLOCKAGES REMAIN.

CONNECTIONS TO CARRIER DRAINS ARE TO BE "Y" JUNCTIONS.

ALL PRIVATE DRAINAGE IS TO COMPLY WITH BS EN 752 AND BUILDING REGS. PART H.

PIPE GRADIENTS ARE INDICATIVE MINIMUMS.

SURFACE CHANNEL DRAINS TO BE ACO MULTIDRAIN OR SIMILAR.

MANHOLES:

ALL PROPOSED NEW MANHOLES TO BE PRECAST RING MANHOLES TYPE B UNLESS NOTED OTHERWISE. INTERNAL DIAMETERS OF MANHOLES TO BE 1000mm WHERE DEPTH TO PIPE SOFFIT IS LESS THAN 1.5m AND 1200mm 9 ELSEWHERE UNLESS NOTED OTHERWISE. 10. DENOTES POLYPROPYLENE INSPECTION CHAMBER BY HEPWORTH OR SIMILAR APPROVED INSTALLED IN ACCORDANCE WITH THE MANUFACTURERS RECOMMENDATIONS.

MANHOLE COVERS:

CARRIAGEWAYS GENERAL - EN124 CLASS D403

CARRIAGEWAYS WITHIN 0.5m OF KERB - EN124 CLASS C250

SLOW MOVING HGV [38]- EN 124 CLASS B125 SLOW MOVING

GLV [10]- EN 124 CLASS B125 SLOW MOVING PRIVATE CARS - EN124 CLASS B125.

INTERNAL - JONES OF OSWESTRY - SUPRASTEEL DOUBLE SEALED WITH NEOPRENE GASKET AND COVER GREASE OR SIMILAR APPROVED.

REFER TO ARCHITECTS DRAWINGS FOR DETAILS OF ANY MANHOLE COVERS WHICH REQUIRE INSET PANELS.

FINAL CONSTRUCTION

WML DRAWINGS ARE FINAL CONSTRUCTION RECORD DRAWINGS INCORPORATING ANY AS-BUILT INFORMATION SUPPLIED BY THE CONTRACTOR

Rev.	Amendment	Date	By	Chkd
R01	FINAL CONSTRUCTION ISSUE	11/01/24	DB	LoG
Project: GLENDENE, WYTHENSHAW				
Client: BTP ARCHITECTS				
Title: PROPOSED DRAINAGE LAYOUT OVERVIEW				

Drawn	Checked	Date	Scale
DB	LoG	SEPT 21	1:200 @ A0


WML CONSULTING
Chartered Civil and Structural Engineers


No 3 Oak Green
East Road
Stanley Green Business Park
Cheshire Oaks
Cheshire M20 2QJ
Tel: 0161 442 0000
Fax: 0161 446 9210
e-mail: info@wmlconsulting.com
www.wmlconsulting.com

Project	Originator	Volume	Level	Type	Role	Number	Rev
9003	-	WML	-	ZZ	-	DR	-
				C	-	1001	R01

SHEET 2

SHEET 4

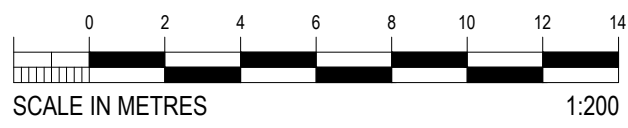

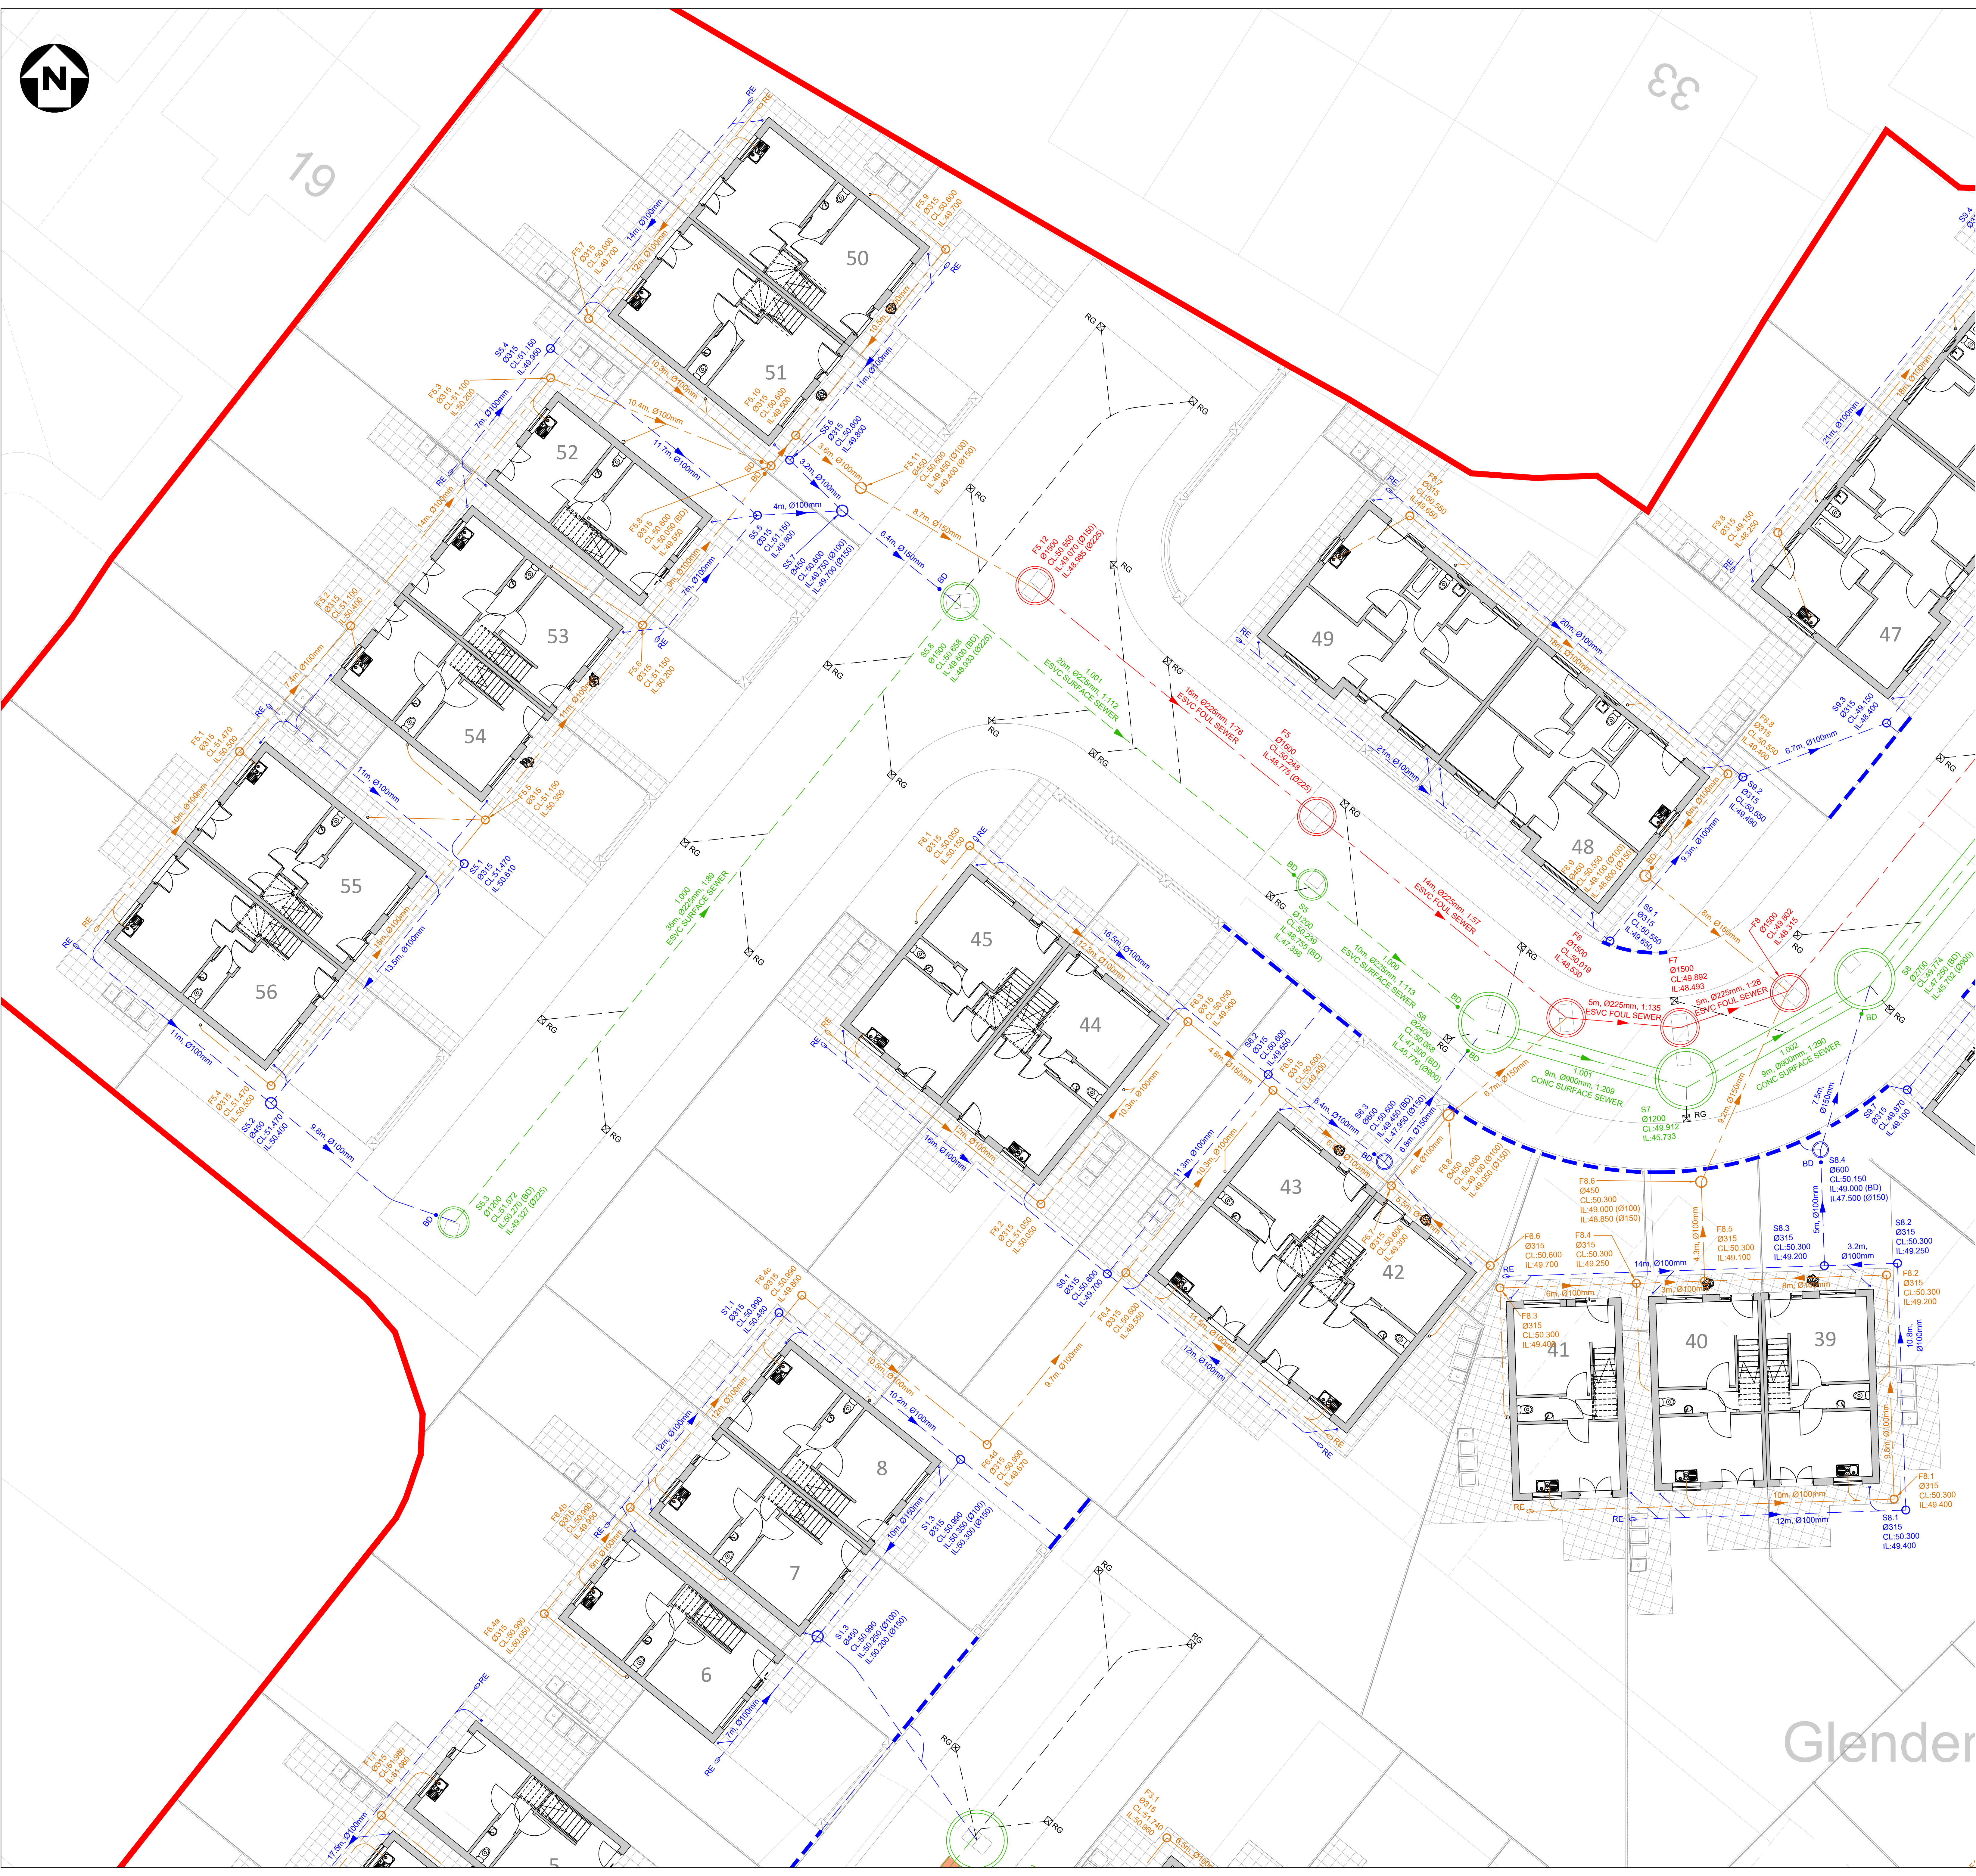

LEGEND

- PROPOSED PRIVATE SURFACE WATER SEWER
- PROPOSED PROPOSED FOUL WATER SEWER
- PROPOSED ADOPTED SURFACE WATER SEWER
- PROPOSED ADOPTED FOUL WATER SEWER
- PROPOSED ADOPTED COMBINED WATER SEWER
- PROPOSED CONCRETE ENCASEMENT TO SEWER
- EXISTING ADOPTED COMBINED WATER SEWER
- DENOTES EXISTING UNITED UTILITIES EASEMENT
- DENOTES SITE BOUNDARY

SUBJECT TO APPROVAL FROM UNITED UTILITIES

DESIGN ASSUMPTIONS

THE PROPOSED DRAINAGE DESIGN ON THIS DRAWING IS BASED ON THE FOLLOWING ASSUMPTIONS:

ALL DRAINAGE COVER LEVELS SHOWN ARE INDICATIVE AND ARE SUBJECT TO FINAL LEVEL DESIGN BY THE ARCHITECT.

R/WPS AND SLAB PENETRATIONS ARE SHOWN INDICATIVE ONLY. FOR FINAL SETTING OUT REFER TO ARCHITECT DRAWINGS.

THE DRAINAGE DESIGN / INFORMATION SHOWN ON THIS DRAWING IS INDICATIVE ONLY AND IS SUBJECT TO CONFIRMATION OF THE EXISTING UNITED UTILITIES PUBLIC SEWER DEPTHS.

RAIN WATER PIPES AND SLAB PENETRATIONS ARE SHOWN INDICATIVE ONLY. ARCHITECT IS TO CONFIRM FINAL POSITIONS PRIOR TO DETAILED DESIGN.

PROPOSED FLOW RATES ARE AS OUTLINED IN THE DRAINAGE STRATEGY ASSUME THAT THE LOCAL PLANNING AUTHORITY & UNITED UTILITIES DO NOT IMPOSE FURTHER RESTRICTIONS TO DISCHARGE RATES.

GENERAL NOTES

DO NOT SCALE FROM THIS DRAWING WORK TO FIGURED DIMENSIONS ONLY.

NO DEVIATION FROM THE DETAILS SHOWN ON THIS DRAWING IS ALLOWED WITHOUT PRIOR PERMISSION IN WRITING.

ALL DRAWINGS ARE TO BE READ IN CONJUNCTION WITH ALL ARCHITECTS, ENGINEERS AND SPECIALISTS DRAWINGS AND THE SPECIFICATION.

THE CONTRACTOR SHALL INCORPORATE ALL THE REQUIREMENTS OF THE PRE-TENDER STAGE HEALTH AND SAFETY PLAN.

THIS DRAWING IS TO BE READ IN CONJUNCTION WITH WML DRAINAGE DETAIL DRAWINGS FOR DETAILS OF MATERIALS AND WORKMANSHIP REFER TO THE SPECIFICATION.

THE CONTRACTOR IS RESPONSIBLE FOR CHECKING INVERT LEVELS AND POSITIONS OF ALL EXISTING DRAINS, SEWERS, INSPECTION CHAMBERS AND MANHOLES SHOWN ON THIS DRAWING IMMEDIATELY ON SITE ESTABLISHMENT. ANY DISCREPANCIES MUST BE REPORTED TO WML CONSULTING IMMEDIATELY.

WHERE THE NEW SITE DRAINAGE CONNECTS IN TO EXISTING MANHOLES IN CARRIAGEWAYS AND/OR EXISTING ADOPTED SEWERS, THE CONTRACTOR IS RESPONSIBLE FOR ALL LIAISON WITH THE RELEVANT STATUTORY UNDERTAKER AND LOCAL AUTHORITY WITH REGARD TO ROAD CLOSURES, TRAFFIC MANAGEMENT, PERMITS TO WORK, SUBMISSION OF CONTRACTORS METHOD STATEMENTS AND RISK ASSESSMENTS AND OTHER DOCUMENTATION AND CORRESPONDENCE ASSOCIATED WITH THE SITE STAGE (PART 2) ELEMENT OF THE WORKS.

ROCKER PIPES TO BE PROVIDED AT ALL CONCRETE CASSED INTERFACES.

PROVIDE ADEQUATE PROTECTION TO MAINTAIN MINIMUM COVER TO DRAINS DURING THE CONSTRUCTION PERIOD.

COVER LEVELS ON THIS DRAWING ARE APPROXIMATE AND INDICATIVE ONLY ARCHITECT TO CONFIRM COVER LEVELS TO ALL MANHOLES AND GULLIES PRIOR TO CONSTRUCTION.

THE LAYOUT OF DRAINAGE ON THIS DRAWING IS INDICATIVE ONLY ARCHITECT TO CONFIRM EXACT LOCATION OF MANHOLES AND GULLIES.

U.N.Q. ALL DRAINAGE GOODS & FITTINGS TO BE:-

UPTO 3000 (AND INCLUDING) TO BE SUPERSLEVE VITRIFIED CLAY PIPES OR SIMILAR.

ABOVE 3000 TO BE CONCRETE BY STANTON BONNA OR SIMILAR.

ALL COVERS AND RODDING ACCESS POINTS TO BE SEALED AND LOCKED AND RECESSED TO ACCEPT FLOOR FINISHES WHERE APPLICABLE.

ALL INTERNAL MANHOLE COVERS TO BE DOUBLE SEALED, SECURE AND RECESSED TO ACCEPT FLOOR FINISHES WHERE APPLICABLE.

SETTING OUT OF ALL INTERNAL GULLY/PLUMBING CONNECTIONS TO BE CO-ORDINATED BETWEEN THE SERVICE ENGINEERS AND THE ARCHITECT.

ALL INTERNAL GULLIES, PLUMBING CONNECTIONS, SOIL STACKS, SIPS AND ALL OTHER CONNECTIONS OF FOUL AND SURFACE WATER DRAINS TO BELOW GROUND TO BE FITTED WITH ACCESSIBLE RODDING POINTS ABOVE SLAB LEVEL.

ALL SURFACE WATER CONNECTIONS TO BE 150mm DIAMETER AT MINIMUM FALLS OF 1:80 UNLESS NOTED OTHERWISE.

ALL FOUL WATER CONNECTIONS TO BE 150mm DIAMETER AT MINIMUM FALLS OF 1:150 UNLESS NOTED OTHERWISE.

ALL CONNECTIONS TO BE MADE IN ACCORDANCE WITH STANDARD DETAIL DRAWINGS.

ALL PIPEWORK TO BE INSTALLED WITH SOFFITS LEVEL (E.G. AT CHANGES IN PIPE SIZE) U.N.Q.

FOR DETAILS OF GREASE TRAP/MACERATOR REQUIREMENTS ASSOCIATED WITH KITCHENS REFER TO SERVICE ENGINEER.

ON COMPLETION OF DRAINAGE WORKS, THE NEW DRAINAGE SYSTEM IS TO BE THOROUGHLY CLEANED AND A CCTV SURVEY CARRIED OUT TO CONFIRM NO CONSTRUCTION DEBRIS OR BLOCKAGES REMAIN.

CONNECTIONS TO CARRIER DRAINS ARE TO BE "Y" JUNCTIONS.

ALL PRIVATE DRAINAGE IS TO COMPLY WITH BS EN 752 AND BUILDING REGS. PART H.

PIPE GRADIENTS ARE INDICATIVE MINIMUMS.

SURFACE CHANNEL DRAINS TO BE ACO MULTIDRAIN OR SIMILAR.

MANHOLES:

ALL PROPOSED NEW MANHOLES TO BE PRECAST RING MANHOLES TYPE B UNLESS NOTED OTHERWISE. INTERNAL DIAMETERS OF MANHOLES TO BE 1020mm WHERE DEPTH TO PIPE SOFFIT IS LESS THAN 1.5m, AND 1200mm @ 1:50 WHERE UNLESS NOTED OTHERWISE. 1C DENOTES POLYPROPYLENE INSPECTION CHAMBER BY HEPWORTH OR SIMILAR APPROVED INSTALLED IN ACCORDANCE WITH THE MANUFACTURERS RECOMMENDATIONS.

MANHOLE COVERS:

CARRIAGEWAYS GENERAL - EN124 CLASS D400
CARRIAGEWAYS WITHIN 0.5m OF KERB - EN124 CLASS C250
SLOW MOVING HGV [38]- EN 124 CLASS B125 SLOW MOVING
GLV [10]- EN 124 CLASS B125 SLOW MOVING PRIVATE CARS - EN124 CLASS B125.


INTERNAL - JONES OF OSWESTRY - SUPRASTEEL DOUBLE SEALED WITH NEOPRENE GASKET AND COVER GREASE OR SIMILAR APPROVED.

REFER TO ARCHITECTS DRAWINGS FOR DETAILS OF ANY MANHOLE COVERS WHICH REQUIRE INSET PANELS.

FINAL CONSTRUCTION

WML DRAWINGS ARE FINAL CONSTRUCTION RECORD DRAWINGS INCORPORATING ANY AS-BUILT INFORMATION SUPPLIED BY THE CONTRACTOR

R01 FINAL CONSTRUCTION ISSUE		11.01.24		DB	LoG
Rev.	Amendment	Date	By	Chkd	
Project GLENDENE, WYTHENSHAW					
CLIENT BTP ARCHITECTS					
Title PROPOSED DRAINAGE LAYOUT SHEET 1					
Drawn	DB	Checked LoG	Date SEPT 21	Scale 1:100 @ A0	
WMLCONSULTING Chartered Civil and Structural Engineers			No 5 Oak Green East Road Barnley Green Business Park Chesham 960 GL Chesham Bucks HP8 4JL Tel 0161 482 9200 Fax 0161 482 9210 e-mail info@wmlconsulting.com www.wmlconsulting.com		
Project	Originator	Volume	Level	Type	Role
9003	- WML - ZZ	- XX	- DR	- C	- Number
				1002	R01

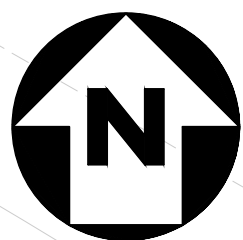

LEGEND

- PROPOSED PRIVATE SURFACE WATER SEWER
- PROPOSED PROPOSED FOUL WATER SEWER
- PROPOSED ADOPTED SURFACE WATER SEWER
- PROPOSED ADOPTED FOUL WATER SEWER
- PROPOSED ADOPTED COMBINED WATER SEWER
- PROPOSED CONCRETE ENCASEMENT TO SEWER
- EXISTING ADOPTED COMBINED WATER SEWER
- DENOTES EXISTING UNITED UTILITIES EASEMENT
- DENOTES SITE BOUNDARY

SUBJECT TO APPROVAL FROM UNITED UTILITIES

DESIGN ASSUMPTIONS

- THE PROPOSED DRAINAGE DESIGN ON THIS DRAWING IS BASED ON THE FOLLOWING ASSUMPTIONS:
- ALL DRAINAGE COVER LEVELS SHOWN ARE INDICATIVE AND ARE SUBJECT TO FINAL LEVEL DESIGN BY THE ARCHITECT.
- RWPS AND SLAB PENETRATIONS ARE SHOWN INDICATIVE ONLY. FOR FINAL SETTING OUT REFER TO ARCHITECT DRAWINGS.
- THE DRAINAGE DESIGN / INFORMATION SHOWN ON THIS DRAWING IS INDICATIVE ONLY AND IS SUBJECT TO CONFIRMATION OF THE EXISTING UNITED UTILITIES PUBLIC SEWER DEPTHS.
- RAIN WATER PIPES AND SLAB PENETRATIONS ARE SHOWN INDICATIVE ONLY. ARCHITECT IS TO CONFIRM FINAL POSITIONS PRIOR TO DETAILED DESIGN.
- PROPOSED FLOW RATES ARE AS OUTLINED IN THE DRAINAGE STRATEGY ASSUME THAT THE LOCAL PLANNING AUTHORITY & UNITED UTILITIES DO NOT IMPOSE FURTHER RESTRICTIONS TO DISCHARGE RATES.

GENERAL NOTES

- DO NOT SCALE FROM THIS DRAWING WORK TO FIGURED DIMENSIONS ONLY.
- NO DEVIATION FROM THE DETAILS SHOWN ON THIS DRAWING IS ALLOWED WITHOUT PRIOR PERMISSION IN WRITING.
- ALL DRAWINGS ARE TO BE READ IN CONJUNCTION WITH ALL ARCHITECTS, ENGINEERS AND SPECIALISTS DRAWINGS AND THE SPECIFICATION.
- THE CONTRACTOR SHALL INCORPORATE ALL THE REQUIREMENTS OF THE PRE-TENDER STAGE HEALTH AND SAFETY PLAN.
- THIS DRAWING IS TO BE READ IN CONJUNCTION WITH WML DRAINAGE DETAIL DRAWINGS FOR DETAILS OF MATERIALS AND WORKMANSHIP REFER TO THE SPECIFICATION.
- THE CONTRACTOR IS RESPONSIBLE FOR CHECKING INVERT LEVELS AND POSITIONS OF ALL EXISTING DRAINS, SEWERS, INSPECTION CHAMBERS AND MANHOLES SHOWN ON THIS DRAWING IMMEDIATELY ON SITE ESTABLISHMENT. ANY DISCREPANCIES MUST BE REPORTED TO WML CONSULTING IMMEDIATELY.
- WHERE THE NEW SITE DRAINAGE CONNECTS IN TO EXISTING MANHOLES IN CARRIAGEWAYS AND/OR EXISTING ADOPTED SEWERS, THE CONTRACTOR IS RESPONSIBLE FOR LIAISON WITH THE RELEVANT STATUTORY UNDERTAKER AND LOCAL AUTHORITY WITH REGARD TO ROAD CLOSURES, TRAFFIC MANAGEMENT, PERMITS TO WORK, SUBMISSION OF CONTRACTORS METHOD STATEMENTS AND RISK ASSESSMENTS AND OTHER DOCUMENTATION AND CORRESPONDENCE ASSOCIATED WITH THE SITE STAGE (PART 2) ELEMENT OF THE WORKS.
- ROCKER PIPES TO BE PROVIDED AT ALL CONCRETE CASSED INTERFACES.
- PROVIDE ADEQUATE PROTECTION TO MAINTAIN MINIMUM COVER TO DRAINS DURING THE CONSTRUCTION PERIOD.
- COVER LEVELS ON THIS DRAWING ARE APPROXIMATE AND INDICATIVE ONLY ARCHITECT TO CONFIRM COVER LEVELS TO ALL MANHOLES AND GULLIES PRIOR TO CONSTRUCTION.
- THE LAYOUT OF DRAINAGE ON THIS DRAWING IS INDICATIVE ONLY ARCHITECT TO CONFIRM EXACT LOCATION OF MANHOLES AND GULLIES.
- U.N.Q. ALL DRAINAGE GOODS & FITTINGS TO BE:-
- UPTO 3000 (AND INCLUDING) TO BE SUPERSLEEVE VITRIFIED CLAY PIPES OR SIMILAR.
- ABOVE 3000 TO BE CONCRETE BY STANTON BONNA OR SIMILAR.
- ALL COVERS AND RODDING ACCESS POINTS TO BE SEALED AND RECESSED TO ACCEPT FLOOR FINISHES WHERE APPLICABLE.
- ALL INTERNAL MANHOLE COVERS TO BE DOUBLE SEALED, LOCKABLE AND RECESSED TO ACCEPT FLOOR FINISHES WHERE APPLICABLE.
- SETTING OUT OF ALL INTERNAL GULLY/PLUMBING CONNECTIONS TO BE CO-ORDINATED BETWEEN THE SERVICE ENGINEERS AND THE ARCHITECT.
- ALL INTERNAL GULLIES, PLUMBING CONNECTIONS, SOIL STACKS, SIPPS AND ALL OTHER CONNECTIONS OF FOUL AND SURFACE WATER DRAINS TO BELOW GROUND TO BE FITTED WITH ACCESSIBLE RODDING POINTS ABOVE SLAB LEVEL.
- ALL SURFACE WATER CONNECTIONS TO BE 150mm DIAMETER AT MINIMUM FALLS OF 1:80 UNLESS NOTED OTHERWISE.
- ALL FOUL WATER CONNECTIONS TO BE 150mm DIAMETER AT MINIMUM FALLS OF 1:150 UNLESS NOTED OTHERWISE.
- ALL CONNECTIONS TO BE MADE IN ACCORDANCE WITH STANDARD DETAIL DRAWINGS.
- ALL PIPEWORK TO BE INSTALLED WITH SOFFITS LEVEL (E.G. AT CHANGES IN PIPE SIZE) U.N.Q.
- FOR DETAILS OF GREASE TRAP/MACERATOR REQUIREMENTS ASSOCIATED WITH KITCHENS REFER TO SERVICE ENGINEER.
- ON COMPLETION OF DRAINAGE WORKS, THE NEW DRAINAGE SYSTEM IS TO BE THOROUGHLY CLEANED AND A CCTV SURVEY CARRIED OUT TO CONFIRM NO CONSTRUCTION DEBRIS OR BLOCKAGES REMAIN.
- CONNECTIONS TO CARRIER DRAINS ARE TO BE "Y" JUNCTIONS.
- ALL PRIVATE DRAINAGE IS TO COMPLY WITH BS EN 752 AND BUILDING REGS. PART H.
- PIPE GRADIENTS ARE INDICATIVE MINIMUMS.
- SURFACE CHANNEL DRAINS TO BE ACO MULTIDRAIN OR SIMILAR.

MANHOLES:

- ALL PROPOSED NEW MANHOLES TO BE PRECAST RING MANHOLES TYPE B UNLESS NOTED OTHERWISE. INTERNAL DIAMETERS OF MANHOLES TO BE 1000mm WHERE DEPTH TO PIPE SOFFIT IS LESS THAN 1.5m, AND 1200mm @ 0.5m THERE UNLESS NOTED OTHERWISE. 1C DENOTES POLYPROPYLENE INSPECTION CHAMBER BY HEPWORTH OR SIMILAR APPROVED INSTALLED IN ACCORDANCE WITH THE MANUFACTURERS RECOMMENDATIONS.

MANHOLE COVERS:



- CARRIAGEWAYS GENERAL - EN124 CLASS D400
CARRIAGEWAYS WITHIN 0.5m OF KERB - EN124 CLASS C250
SLOW MOVING HGV (38t) - EN 124 CLASS B125 SLOW MOVING
GLV (10t) - EN 124 CLASS B125 SLOW MOVING PRIVATE CARS - EN124 CLASS B125.
- INTERNAL - JONES OF OSWESTRY - SUPRASTEEL DOUBLE SEALED WITH NEOPRENE GASKET AND COVER GREASE OR SIMILAR APPROVED.
- REFER TO ARCHITECTS DRAWINGS FOR DETAILS OF ANY MANHOLE COVERS WHICH REQUIRE INSET PANELS.

FINAL CONSTRUCTION

WML DRAWINGS ARE FINAL CONSTRUCTION RECORD DRAWINGS INCORPORATING ANY AS-BUILT INFORMATION SUPPLIED BY THE CONTRACTOR

Rev	FINAL CONSTRUCTION ISSUE		11/01/24		DB	LoG
Rev.	Amendment		Date	By	Chkd	
Project	GLENDENE, WYTHENSHAW					
Client	BTP ARCHITECTS					
Title	PROPOSED DRAINAGE LAYOUT SHEET 3					
Drawn	DB	Checked	LoG	Date	Scale	
				SEPT 21	1:100 @ A0	
WML CONSULTING				No.8 Oak Green East Road Stanning Green Business Park Cheshire 9300 0A Cheshire 9300 0A Tel 0161 482 0000 Fax 0161 482 0010 e-mail info@wmlconsulting.com www.wmlconsulting.com		
Chartered Civil and Structural Engineers						
Project	Originator	Volume	Level	Type	Role	Number
9003	- WML - ZZ	- XX	- DR	- C	-	1004
Rev	Originator	Volume	Level	Type	Role	Number
R01	- WML - ZZ	- XX	- DR	- C	-	1004

SCALE IN METRES 1:100

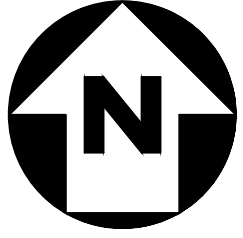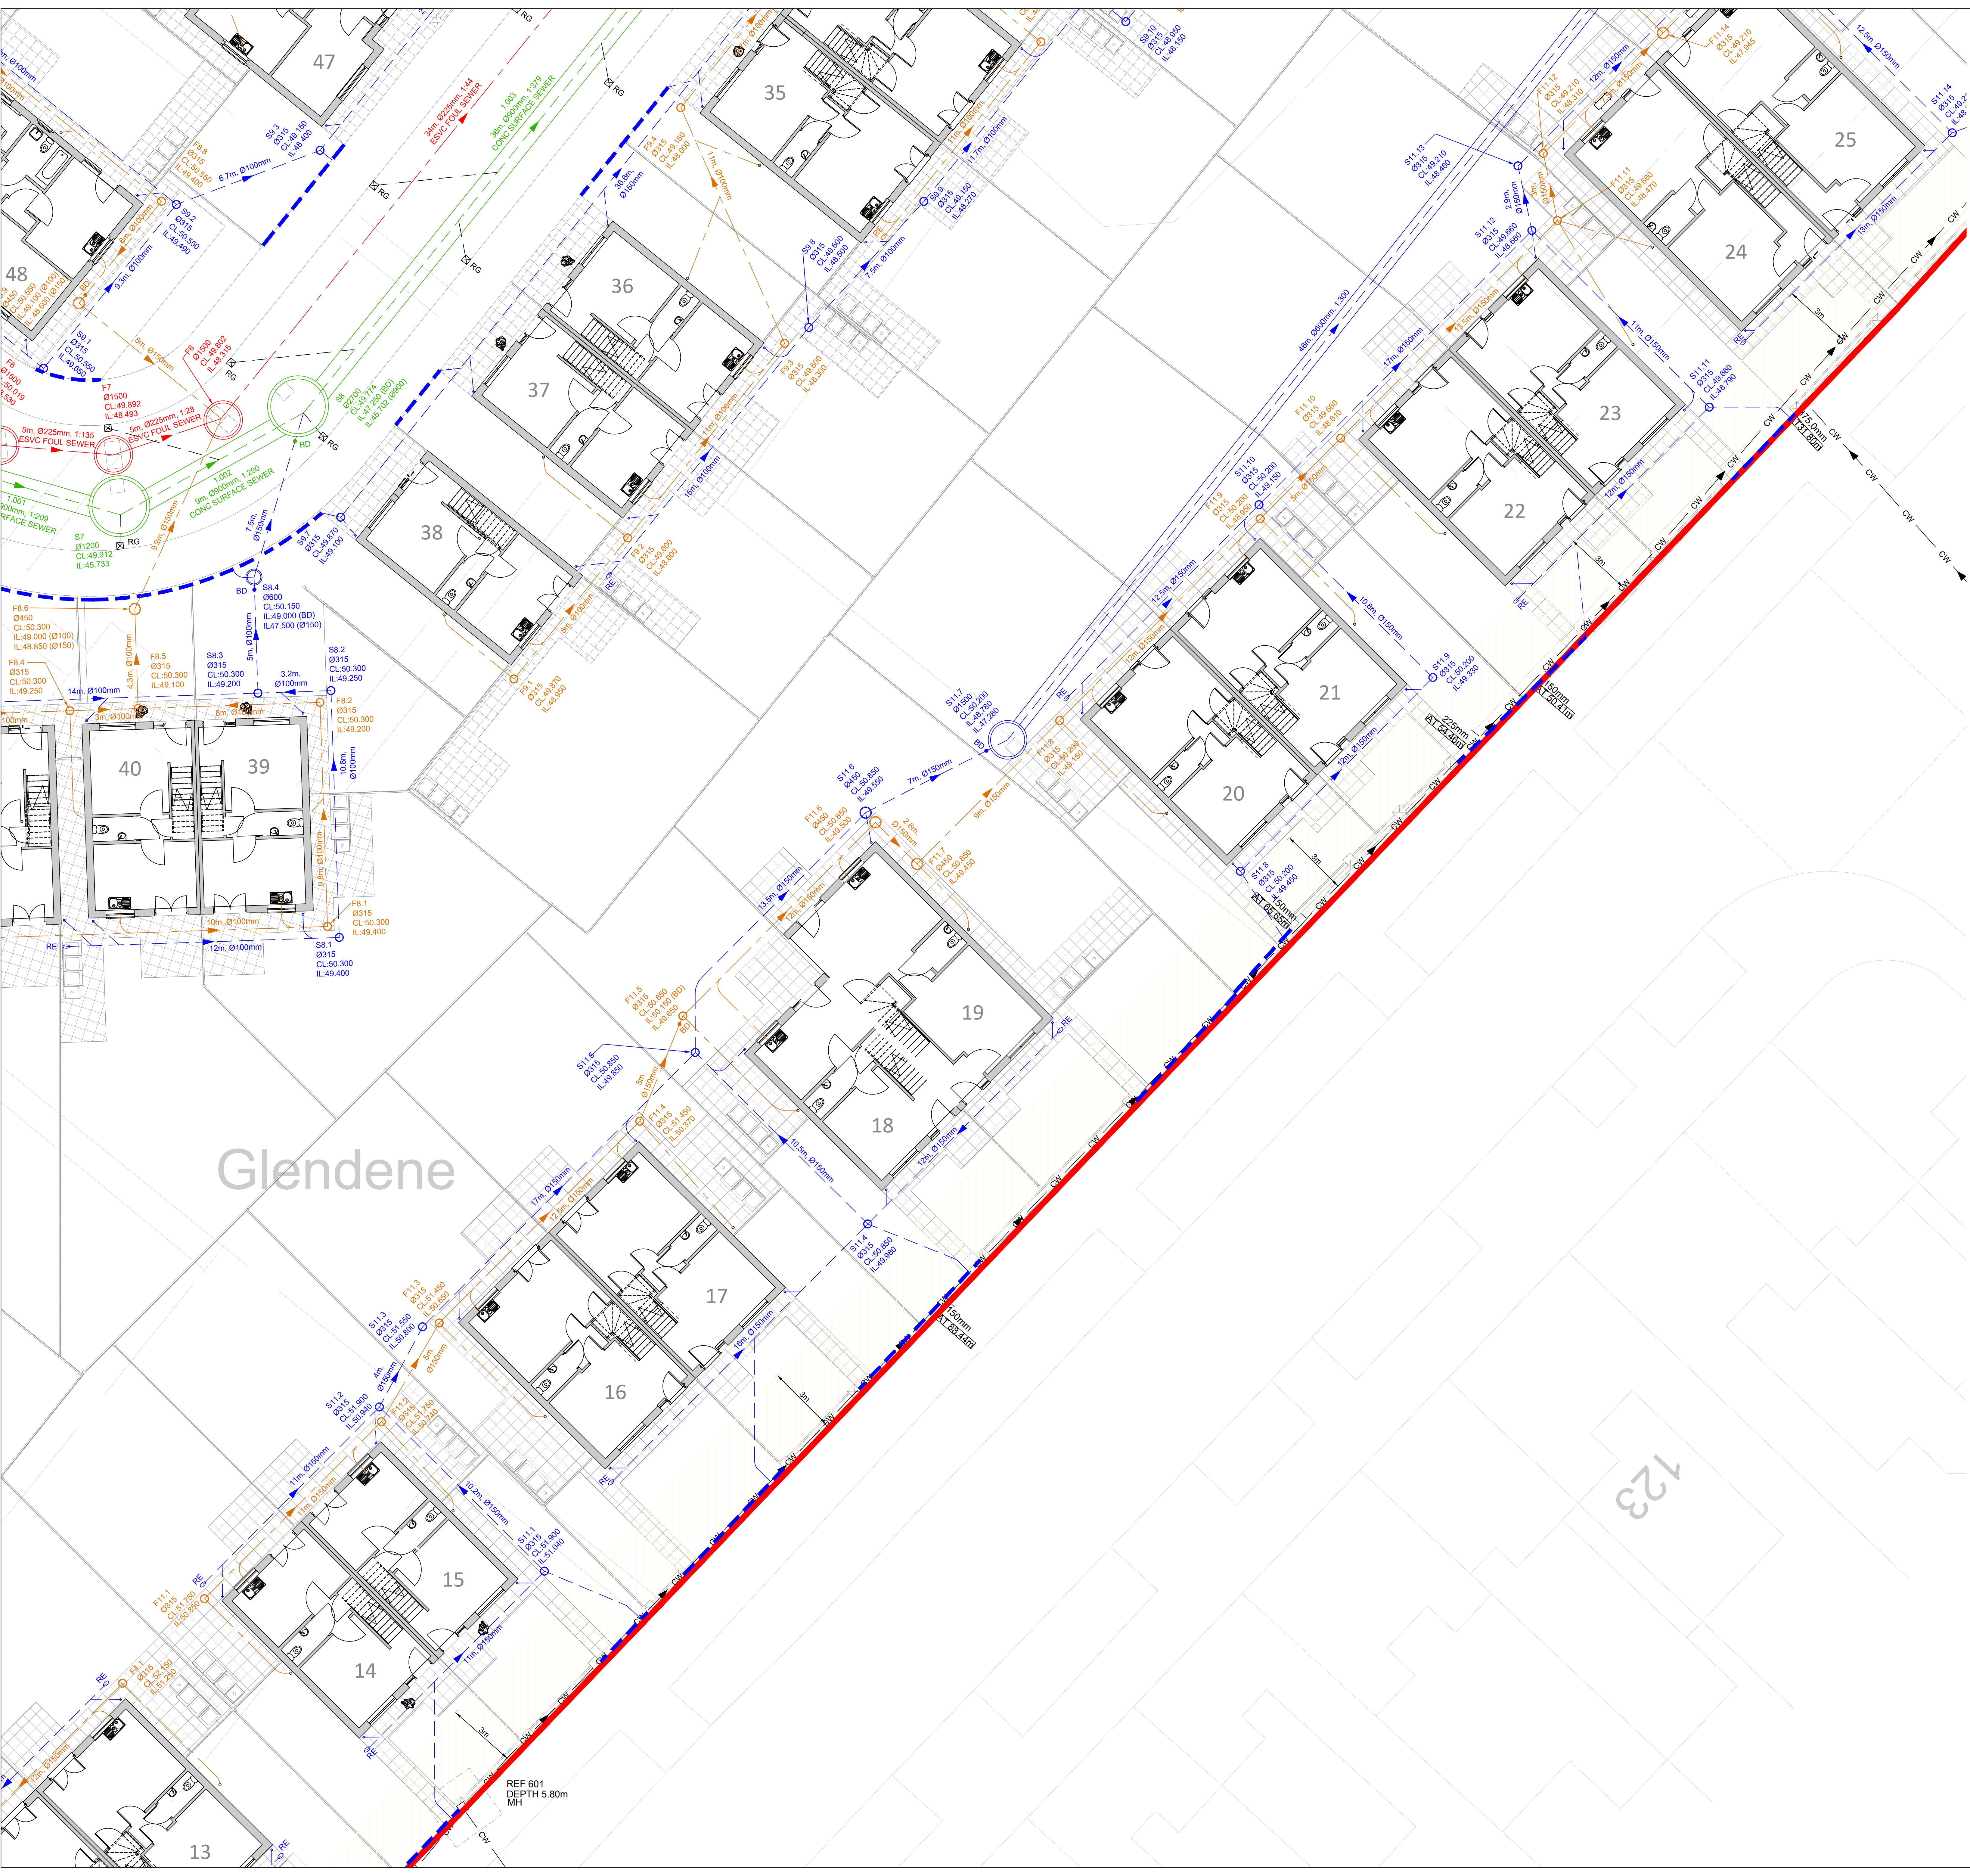

LEGEND

- PROPOSED PRIVATE SURFACE WATER SEWER
- PROPOSED PROPOSED FOUL WATER SEWER
- PROPOSED ADOPTED SURFACE WATER SEWER
- PROPOSED ADOPTED FOUL WATER SEWER
- PROPOSED ADOPTED COMBINED WATER SEWER
- PROPOSED CONCRETE ENCASMENT TO SEWER
- EXISTING ADOPTED COMBINED WATER SEWER
- DENOTES EXISTING UNITED UTILITIES EASEMENT
- DENOTES SITE BOUNDARY

SUBJECT TO APPROVAL FROM UNITED UTILITIES

DESIGN ASSUMPTIONS

THE PROPOSED DRAINAGE DESIGN ON THIS DRAWING IS BASED ON THE FOLLOWING ASSUMPTIONS:

ALL DRAINAGE COVER LEVELS SHOWN ARE INDICATIVE AND ARE SUBJECT TO FINAL LEVEL DESIGN BY THE ARCHITECT.

R/W'S AND SLAB PENETRATIONS ARE SHOWN INDICATIVE ONLY. FOR FINAL SETTING OUT REFER TO ARCHITECT DRAWINGS.

THE DRAINAGE DESIGN / INFORMATION SHOWN ON THIS DRAWING IS INDICATIVE ONLY AND IS SUBJECT TO CONFIRMATION OF THE EXISTING UNITED UTILITIES PUBLIC SEWER DEPTHS.

RAIN WATER PIPES AND SLAB PENETRATIONS ARE SHOWN INDICATIVE ONLY. ARCHITECT IS TO CONFIRM FINAL POSITIONS PRIOR TO DETAILED DESIGN.

PROPOSED FLOW RATES ARE AS OUTLINED IN THE DRAINAGE STRATEGY ASSUME THAT THE LOCAL PLANNING AUTHORITY & UNITED UTILITIES DO NOT IMPOSE FURTHER RESTRICTIONS TO DISCHARGE RATES.

GENERAL NOTES

DO NOT SCALE FROM THIS DRAWING WORK TO FIGURED DIMENSIONS ONLY.

NO DEVIATION FROM THE DETAILS SHOWN ON THIS DRAWING IS ALLOWED WITHOUT PRIOR PERMISSION IN WRITING.

ALL DRAWINGS ARE TO BE READ IN CONJUNCTION WITH ALL ARCHITECTS, ENGINEERS AND SPECIALISTS DRAWINGS AND THE SPECIFICATION.

THE CONTRACTOR SHALL INCORPORATE ALL THE REQUIREMENTS OF THE PRE-TENDER STAGE HEALTH AND SAFETY PLAN.

THIS DRAWING IS TO BE READ IN CONJUNCTION WITH WML DRAINAGE DETAIL DRAWINGS FOR DETAILS OF MATERIALS AND WORKMANSHIP REFER TO THE SPECIFICATION.

THE CONTRACTOR IS RESPONSIBLE FOR CHECKING INVERT LEVELS AND POSITIONS OF ALL EXISTING DRAINS, SEWERS, INSPECTION CHAMBERS AND MANHOLES SHOWN ON THIS DRAWING IMMEDIATELY ON SITE ESTABLISHMENT. ANY DISCREPANCIES MUST BE REPORTED TO WML CONSULTING IMMEDIATELY.

WHERE THE NEW SITE DRAINAGE CONNECTS IN TO EXISTING MANHOLES IN CARRIAGEWAYS AND/OR EXISTING ADOPTED SEWERS, THE CONTRACTOR IS RESPONSIBLE FOR ALL LIAISON WITH THE RELEVANT STATUTORY UNDERTAKER AND LOCAL AUTHORITY WITH REGARD TO ROAD CLOSURES, TRAFFIC MANAGEMENT, PERMITS TO WORK, SUBMISSION OF CONTRACTORS METHOD STATEMENTS AND RISK ASSESSMENTS AND OTHER DOCUMENTATION AND CORRESPONDENCE ASSOCIATED WITH THE SITE STAGE (PART 2) ELEMENT OF THE WORKS.

ROCKER PIPES TO BE PROVIDED AT ALL CONCRETE CASSED INTERFACES.

PROVIDE ADEQUATE PROTECTION TO MAINTAIN MINIMUM COVER TO DRAINS DURING THE CONSTRUCTION PERIOD.

COVER LEVELS ON THIS DRAWING ARE APPROXIMATE AND INDICATIVE ONLY ARCHITECT TO CONFIRM COVER LEVELS TO ALL MANHOLES AND GULLIES PRIOR TO CONSTRUCTION.

THE LAYOUT OF DRAINAGE ON THIS DRAWING IS INDICATIVE ONLY ARCHITECT TO CONFIRM EXACT LOCATION OF MANHOLES AND GULLIES.

U.N.Q. ALL DRAINAGE GOODS & FITTINGS TO BE:-

UPTO 3000 (AND INCLUDING) TO BE SUPERSLAVE VITRIFIED CLAY PIPES OR SIMILAR.

ABOVE 3000 TO BE CONCRETE BY STANTON BONNA OR SIMILAR.

ALL COVERS AND RODDING ACCESS POINTS TO BE SEALED AND RECESSED TO ACCEPT FLOOR FINISHES WHERE APPLICABLE.

ALL INTERNAL MANHOLE COVERS TO BE DOUBLE SEALED, LOCKABLE AND RECESSED TO ACCEPT FLOOR FINISHES WHERE APPLICABLE.

SETTING OUT OF ALL INTERNAL GULLY/PLUMBING CONNECTIONS TO BE CO-ORDINATED BETWEEN THE SERVICE ENGINEERS AND THE ARCHITECT.

ALL INTERNAL GULLIES, PLUMBING CONNECTIONS, SOIL STACKS, SYPS AND ALL OTHER CONNECTIONS OF FOUL AND SURFACE WATER DRAINS TO BELOW GROUND TO BE FITTED WITH ACCESSIBLE RODDING POINTS ABOVE SLAB LEVEL.

ALL SURFACE WATER CONNECTIONS TO BE 150mm DIAMETER AT MINIMUM FALLS OF 1:80 UNLESS NOTED OTHERWISE.

ALL FOUL WATER CONNECTIONS TO BE 150mm DIAMETER AT MINIMUM FALLS OF 1:150 UNLESS NOTED OTHERWISE.

ALL CONNECTIONS TO BE MADE IN ACCORDANCE WITH STANDARD DETAIL DRAWINGS.

ALL PIPEWORK TO BE INSTALLED WITH SOFFITS LEVEL (E.G. AT CHANGES IN PIPE SIZE) U.N.Q.

FOR DETAILS OF GREASE TRAP/MACRATOR REQUIREMENTS ASSOCIATED WITH KITCHENS REFER TO SERVICE ENGINEER.

ON COMPLETION OF DRAINAGE WORKS, THE NEW DRAINAGE SYSTEM IS TO BE THOROUGHLY CLEANED AND A CCTV SURVEY CARRIED OUT TO CONFIRM NO CONSTRUCTION DEBRIS OR BLOCKAGES REMAIN.

CONNECTIONS TO CARRIER DRAINS ARE TO BE "Y" JUNCTIONS.

ALL PRIVATE DRAINAGE IS TO COMPLY WITH BS EN 752 AND BUILDING REGS. PART H.

PIPE GRADIENTS ARE INDICATIVE MINIMUMS.

SURFACE CHANNEL DRAINS TO BE ACO MULTIDRAIN OR SIMILAR.

MANHOLES:

ALL PROPOSED NEW MANHOLES TO BE PRECAST RING MANHOLES TYPE B UNLESS NOTED OTHERWISE. INTERNAL DIAMETERS OF MANHOLES TO BE 1000mm WHERE DEPTH TO PIPE SOFFIT IS LESS THAN 1.5m, AND 1200mm 9 ELSEWHERE UNLESS NOTED OTHERWISE. 1C DENOTES POLYPROPYLENE INSPECTION CHAMBER BY HEPWORTH OR SIMILAR APPROVED INSTALLED IN ACCORDANCE WITH THE MANUFACTURERS RECOMMENDATIONS.

MANHOLE COVERS:

CARRIAGEWAYS GENERAL - EN124 CLASS D40

CARRIAGEWAYS WITHIN 0.5m OF KERB - EN124 CLASS C250

SLOW MOVING HGV [38] - EN 124 CLASS B125 SLOW MOVING

GLV [10] - EN 124 CLASS B125 SLOW MOVING PRIVATE CARS - EN124 CLASS B125.

INTERNAL - JONES OF OSWESTRY - SUPRASTEEL DOUBLE SEALED WITH NEOPRENE GASKET AND COVER GREASE OR SIMILAR APPROVED.

REFER TO ARCHITECTS DRAWINGS FOR DETAILS OF ANY MANHOLE COVERS WHICH REQUIRE INSET PANELS.

FINAL CONSTRUCTION

WML DRAWINGS ARE FINAL CONSTRUCTION RECORD DRAWINGS INCORPORATING ANY AS-BUILT INFORMATION SUPPLIED BY THE CONTRACTOR

Rev.	Amendment	Date	By	Chkd
R01	FINAL CONSTRUCTION ISSUE	11/01/24	DB	LoG

Project
GLENDENE, WYTHENSHAW

Client
BTP ARCHITECTS

Title
PROPOSED DRAINAGE LAYOUT SHEET 4

Drawn	Checked	Date	Scale
DB	LoG	SEPT 21	1:100 @ A0

WML CONSULTING
Chartered Civil and Structural Engineers

No 5 Oak Green
East Road
Barnley Green Business Park
Chesham Bucks HP8 4JL
Tel 01494 442 000
Fax 01494 442 010
e-mail info@wmlconsulting.com
www.wmlconsulting.com

Project	Originator	Volume	Level	Type	Role	Number	Rev
9003	-	WML	-	ZZ	-	XX	-
				DR	-	C	-
						1005	R01



Nursery

Medical Centre

Glendene

LEGEND

PROPOSED PRIVATE SURFACE WATER SEWER

PROPOSED PROPOSED FOUL WATER SEWER

PROPOSED ADOPTED SURFACE WATER SEWER

PROPOSED ADOPTED FOUL WATER SEWER

PROPOSED ADOPTED COMBINED WATER SEWER

PROPOSED CONCRETE ENCASEMENT TO SEWER

EXISTING ADOPTED COMBINED WATER SEWER

DENOTES EXISTING UNITED UTILITIES EASEMENT

DENOTES SITE BOUNDARY

SUBJECT TO APPROVAL FROM
UNITED UTILITIES

DESIGN ASSUMPTIONS

THE PROPOSED DRAINAGE DESIGN ON THIS DRAWING IS BASED ON THE FOLLOWING ASSUMPTIONS:

ALL DRAINAGE COVER LEVELS SHOWN ARE INDICATIVE AND ARE SUBJECT TO FINAL LEVEL DESIGN BY THE ARCHITECT.

R/WPs AND SLAB PENETRATIONS ARE SHOWN INDICATIVE ONLY. FOR FINAL SETTING OUT REFER TO ARCHITECT DRAWINGS.

THE DRAINAGE DESIGN / INFORMATION SHOWN ON THIS DRAWING IS INDICATIVE ONLY AND IS SUBJECT TO CONFIRMATION OF THE EXISTING UNITED UTILITIES PUBLIC SEWER DEPTHS.

RAIN WATER PIPES AND SLAB PENETRATIONS ARE SHOWN INDICATIVE ONLY. ARCHITECT IS TO CONFIRM FINAL POSITIONS PRIOR TO DETAILED DESIGN.

PROPOSED FLOW RATES ARE AS OUTLINED IN THE DRAINAGE STRATEGY ASSUME THAT THE LOCAL PLANNING AUTHORITY & UNITED UTILITIES DO NOT IMPOSE FURTHER RESTRICTIONS TO DISCHARGE RATES.

GENERAL NOTES

DO NOT SCALE FROM THIS DRAWING WORK TO FIGURED DIMENSIONS ONLY.

NO DEVIATION FROM THE DETAILS SHOWN ON THIS DRAWING IS ALLOWED WITHOUT PRIOR PERMISSION IN WRITING.

ALL DRAWINGS ARE TO BE READ IN CONJUNCTION WITH ALL ARCHITECTS, ENGINEERS AND SPECIALISTS DRAWINGS AND THE SPECIFICATION.

THE CONTRACTOR SHALL INCORPORATE ALL THE REQUIREMENTS OF THE PRE-TENDER STAGE HEALTH AND SAFETY PLAN.

THIS DRAWING IS TO BE READ IN CONJUNCTION WITH WML DRAINAGE DETAIL DRAWINGS FOR DETAILS OF MATERIALS AND WORKMANSHIP REFER TO THE SPECIFICATION.

THE CONTRACTOR IS RESPONSIBLE FOR CHECKING INVERT LEVELS AND POSITIONS OF ALL EXISTING DRAINS, SEWERS, INSPECTION CHAMBERS AND MANHOLES SHOWN ON THIS DRAWING IMMEDIATELY ON SITE ESTABLISHMENT. ANY DISCREPANCIES MUST BE REPORTED TO WML CONSULTING IMMEDIATELY.

WHERE THE NEW SITE DRAINAGE CONNECTS IN TO EXISTING MANHOLES IN CARRIAGEWAYS AND/OR EXISTING ADOPTED SEWERS, THE CONTRACTOR IS RESPONSIBLE FOR ALL LIAISON WITH THE RELEVANT STATUTORY UNDERTAKER AND LOCAL AUTHORITY WITH REGARD TO ROAD CLOSURES, TRAFFIC MANAGEMENT, PERMITS TO WORK, SUBMISSION OF CONTRACTORS METHOD STATEMENTS AND RISK ASSESSMENTS AND OTHER DOCUMENTATION AND CORRESPONDENCE ASSOCIATED WITH THE SITE STAGE (PART 2) ELEMENT OF THE WORKS.

ROCKER PIPES TO BE PROVIDED AT ALL CONCRETE CASED INTERFACES.

PROVIDE ADEQUATE PROTECTION TO MAINTAIN MINIMUM COVER TO DRAINS DURING THE CONSTRUCTION PERIOD.

COVER LEVELS ON THIS DRAWING ARE APPROXIMATE AND INDICATIVE ONLY ARCHITECT TO CONFIRM COVER LEVELS TO ALL MANHOLES AND GULLIES PRIOR TO CONSTRUCTION.

THE LAYOUT OF DRAINAGE ON THIS DRAWING IS INDICATIVE ONLY ARCHITECT TO CONFIRM EXACT LOCATION OF MANHOLES AND GULLIES.

U.N.Q. ALL DRAINAGE GOODS & FITTINGS TO BE:-

UPTO 3000 (AND INCLUDING) TO BE SUPERSLAVE VITRIFIED CLAY PIPES OR SIMILAR.

ABOVE 3000 TO BE CONCRETE BY STANTON BONNA OR SIMILAR.

ALL COVERS AND RODDING ACCESS POINTS TO BE SEALED AND LOCKED TIGHT.

ALL INTERNAL MANHOLE COVERS TO BE DOUBLE SEALED, SCHEDULED AND RECESSED TO ACCEPT FLOOR FINISHES WHERE APPLICABLE.

SETTING OUT OF ALL INTERNAL GULLY/PLUMBING CONNECTIONS TO BE CO-ORDINATED BETWEEN THE SERVICE ENGINEERS AND THE ARCHITECT.

ALL INTERNAL GULLIES, PLUMBING CONNECTIONS, SOIL STACKS, SIPS AND ALL OTHER CONNECTIONS OF FOUL AND SURFACE WATER DRAINS TO BELOW GROUND TO BE FITTED WITH ACCESSIBLE RODDING POINTS ABOVE SLAB LEVEL.

ALL SURFACE WATER CONNECTIONS TO BE 150mm DIAMETER AT MINIMUM FALLS OF 1:80 UNLESS NOTED OTHERWISE.

ALL FOUL WATER CONNECTIONS TO BE 150mm DIAMETER AT MINIMUM FALLS OF 1:150 UNLESS NOTED OTHERWISE.

ALL CONNECTIONS TO BE MADE IN ACCORDANCE WITH STANDARD DETAIL DRAWINGS.

ALL PIPEWORK TO BE INSTALLED WITH SOFFITS LEVEL (E.G. AT CHANGES IN PIPE SIZE) U.N.Q.

FOR DETAILS OF GREASE TRAP/MACERATOR REQUIREMENTS ASSOCIATED WITH KITCHENS REFER TO SERVICE ENGINEER.

ON COMPLETION OF DRAINAGE WORKS, THE NEW DRAINAGE SYSTEM IS TO BE THOROUGHLY CLEANED AND A CCTV SURVEY CARRIED OUT TO CONFIRM NO CONSTRUCTION DEBRIS OR BLOCKAGES REMAIN.

CONNECTIONS TO CARRIER DRAINS ARE TO BE "Y" JUNCTIONS.

ALL PRIVATE DRAINAGE IS TO COMPLY WITH BS EN 752 AND BUILDING REGS. PART H.

PIPE GRADIENTS ARE INDICATIVE MINIMUMS.

SURFACE CHANNEL DRAINS TO BE ACO MULTIDRAIN OR SIMILAR.

MANHOLES:

ALL PROPOSED NEW MANHOLES TO BE PRECAST RING MANHOLES TYPE B UNLESS NOTED OTHERWISE. INTERNAL DIAMETERS OF MANHOLES TO BE 1000mm WHERE DEPTH TO PIPE SOFFIT IS LESS THAN 1.5m, AND 1200mm @ ELSEWHERE UNLESS NOTED OTHERWISE. 1C DENOTES POLYPROPYLENE INSPECTION CHAMBER BY HEPWORTH OR SIMILAR APPROVED INSTALLED IN ACCORDANCE WITH THE MANUFACTURERS RECOMMENDATIONS.

MANHOLE COVERS:

CARRIAGEWAYS GENERAL - EN124 CLASS D403

CARRIAGEWAYS WITHIN 0.5m OF KERB - EN124 CLASS C250

SLOW MOVING HGV (38t) - EN 124 CLASS B125 SLOW MOVING

GLV (10t) - EN 124 CLASS B125 SLOW MOVING PRIVATE CARS - EN124 CLASS B125.

INTERNAL - JONES OF OSWESTRY - SUPRASTEEL DOUBLE SEALED WITH NEOPRENE GASKET AND COVER GREASE OR SIMILAR APPROVED.

REFER TO ARCHITECTS DRAWINGS FOR DETAILS OF ANY MANHOLE COVERS WHICH REQUIRE INSET PANELS.

FINAL CONSTRUCTION

WML DRAWINGS ARE FINAL CONSTRUCTION RECORD DRAWINGS INCORPORATING ANY AS-BUILT INFORMATION SUPPLIED BY THE CONTRACTOR

FINAL CONSTRUCTION ISSUE		11/01/24	DB	LoG
Amendment		Date	By	Chkd
GLENDENE, WYTHENSHAW				
BTP ARCHITECTS				
SECTION 104 - PROPOSED DRAINAGE LAYOUT OVERVIEW				
DB	Checked	LoG	Date	SEPT 21
Scale			1:200 @ A0	
WML CONSULTING			No. 8 Oak Green East Road Barnley Green Business Park Chesham Bucks Chesham HP8 3LQ Tel 01494 462 000 Fax 01494 462 010 e-mail info@wmlconsulting.com www.wmlconsulting.com	
Chartered Civil and Structural Engineers				
Project	Originator	Volume	Level	Type
9003	- WML	- ZZ	- XX	- DR
Role	Number	Rev		
- C	- 101	R01		




SURFACE CHANNEL DRAINS TO BE ACO MULTIDRAIN OR SIMILAR.

REFER TO ARCHITECTS DRAWINGS FOR DETAILS OF ANY MANHOLE
COVERS WHICH REQUIRE INSET PANELS.

Project	Originator	Volume	Level	Type	Role	Number	Rev
9003	- WML	- ZZ	- XX	- DR	- C	- 1013	R0

0 1 2 3 4 5 6 7

SCALE IN METRES 1:100

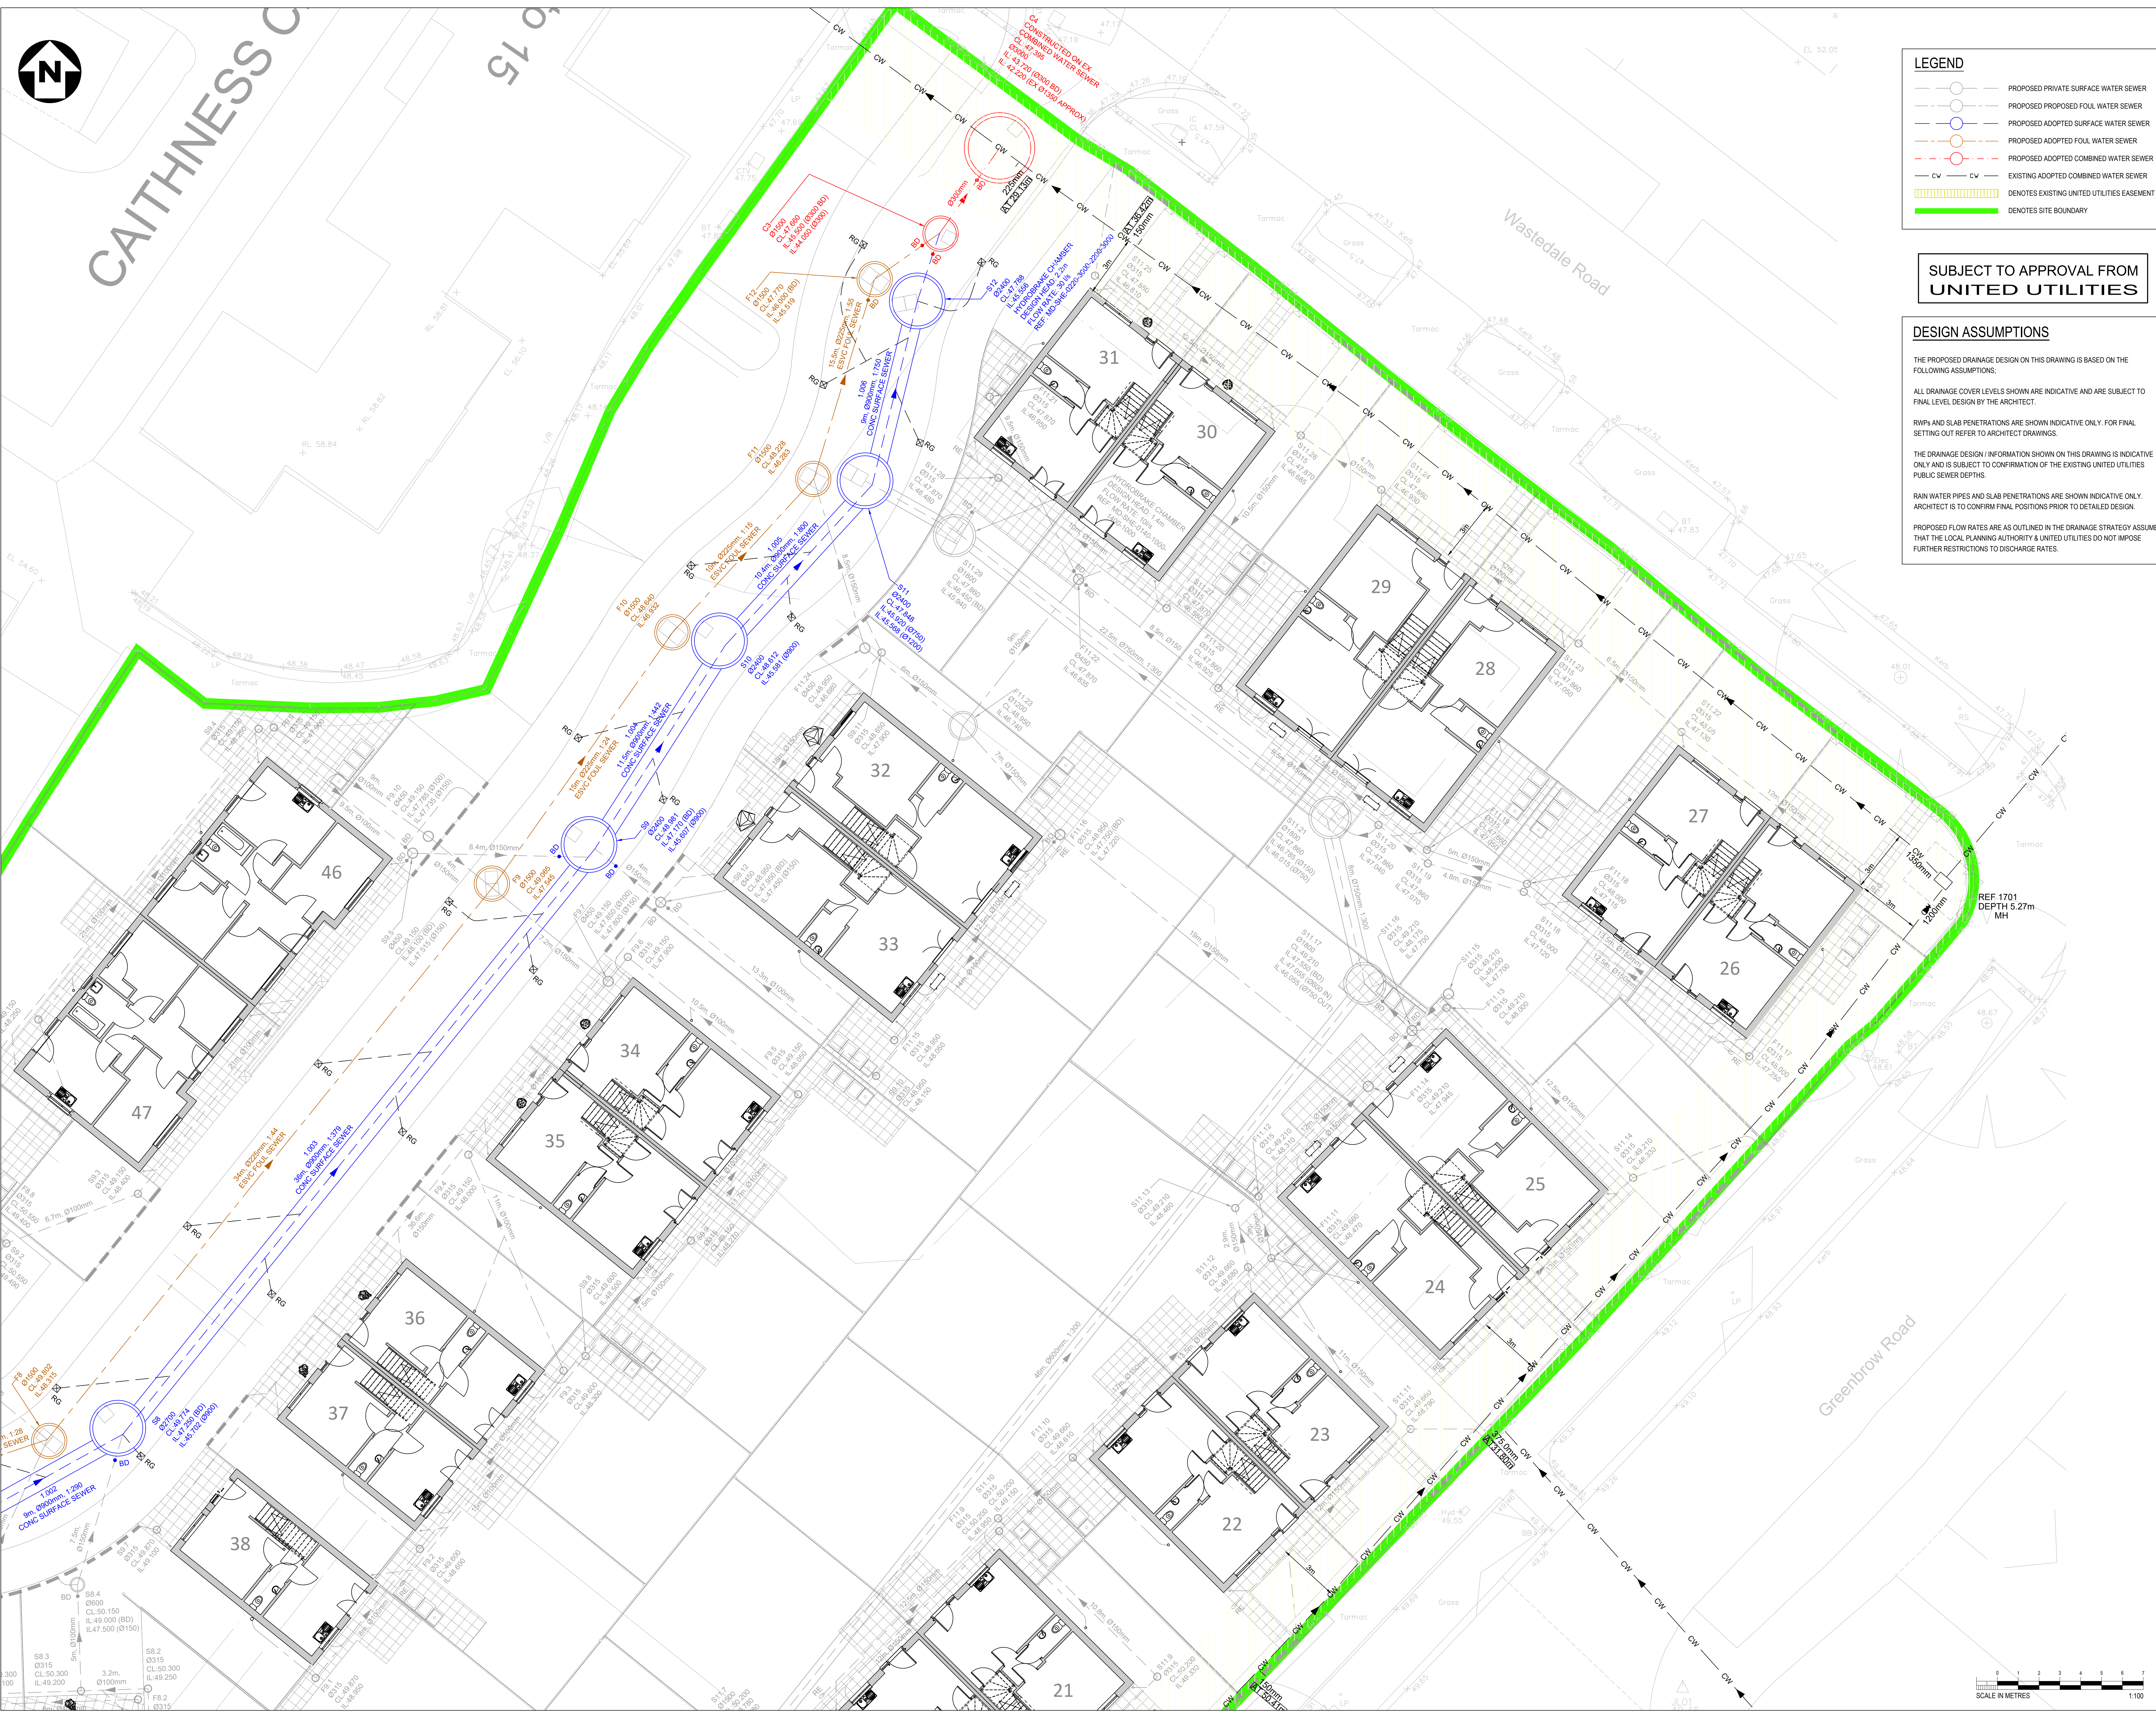

LEGEND

- PROPOSED PRIVATE SURFACE WATER SEWER
- PROPOSED PROPOSED FOUL WATER SEWER
- PROPOSED ADOPTED SURFACE WATER SEWER
- PROPOSED ADOPTED FOUL WATER SEWER
- PROPOSED ADOPTED COMBINED WATER SEWER
- CW CW EXISTING ADOPTED COMBINED WATER SEWER
- EXISTING EXISTING UNITED UTILITIES EASEMENT
- DENOTES SITE BOUNDARY

SUBJECT TO APPROVAL FROM UNITED UTILITIES

DESIGN ASSUMPTIONS

THE PROPOSED DRAINAGE DESIGN ON THIS DRAWING IS BASED ON THE FOLLOWING ASSUMPTIONS:

ALL DRAINAGE COVER LEVELS SHOWN ARE INDICATIVE AND ARE SUBJECT TO FINAL LEVEL DESIGN BY THE ARCHITECT.

RWPs AND SLAB PENETRATIONS ARE SHOWN INDICATIVE ONLY. FOR FINAL SETTING OUT REFER TO ARCHITECT DRAWINGS.

THE DRAINAGE DESIGN / INFORMATION SHOWN ON THIS DRAWING IS INDICATIVE ONLY AND IS SUBJECT TO CONFIRMATION OF THE EXISTING UNITED UTILITIES PUBLIC SEWER DEPTHS.

RAIN WATER PIPES AND SLAB PENETRATIONS ARE SHOWN INDICATIVE ONLY. ARCHITECT IS TO CONFIRM FINAL POSITIONS PRIOR TO DETAILED DESIGN.

PROPOSED FLOW RATES ARE AS OUTLINED IN THE DRAINAGE STRATEGY ASSUME THAT THE LOCAL PLANNING AUTHORITY & UNITED UTILITIES DO NOT IMPOSE FURTHER RESTRICTIONS TO DISCHARGE RATES.

GENERAL NOTES

DO NOT SCALE FROM THIS DRAWING WORK TO FIGURED DIMENSIONS ONLY.

NO DEVIATION FROM THE DETAILS SHOWN ON THIS DRAWING IS ALLOWED WITHOUT PRIOR PERMISSION IN WRITING.

ALL DRAWINGS ARE TO BE READ IN CONJUNCTION WITH ALL ARCHITECTS, ENGINEERS AND SPECIALISTS DRAWINGS AND THE SPECIFICATION.

THE CONTRACTOR SHALL INCORPORATE ALL THE REQUIREMENTS OF THE PRE-TENDER STAGE HEALTH AND SAFETY PLAN.

THIS DRAWING IS TO BE READ IN CONJUNCTION WITH WML DRAINAGE DETAIL DRAWINGS FOR DETAILS OF MATERIALS AND WORKMANSHIP REFER TO THE SPECIFICATION.

THE CONTRACTOR IS RESPONSIBLE FOR CHECKING INVERT LEVELS AND POSITIONS OF ALL EXISTING DRAINS, SEWERS, INSPECTION CHAMBERS AND MANHOLES SHOWN ON THIS DRAWING IMMEDIATELY ON SITE ESTABLISHMENT. ANY DISCREPANCIES MUST BE REPORTED TO WML CONSULTING IMMEDIATELY.

WHERE THE NEW SITE DRAINAGE CONNECTS IN TO EXISTING MANHOLES IN CARRIAGEWAYS AND/OR EXISTING ADOPTED SEWERS, THE CONTRACTOR IS RESPONSIBLE FOR ALL LIAISON WITH THE RELEVANT STATUTORY UNDERTAKER AND LOCAL AUTHORITY WITH REGARD TO ROAD CLOSURES, TRAFFIC MANAGEMENT, PERMITS TO WORK, SUBMISSION OF CONTRACTORS METHOD STATEMENTS AND RISK ASSESSMENTS AND OTHER DOCUMENTATION AND CORRESPONDENCE ASSOCIATED WITH THE SITE STAGE (PART 2) ELEMENT OF THE WORKS.

ROCKER PIPES TO BE PROVIDED AT ALL CONCRETE CASED INTERFACES.

PROVIDE ADEQUATE PROTECTION TO MAINTAIN MINIMUM COVER TO DRAINS DURING THE CONSTRUCTION PERIOD.

COVER LEVELS ON THIS DRAWING ARE APPROXIMATE AND INDICATIVE ONLY ARCHITECT TO CONFIRM COVER LEVELS TO ALL MANHOLES AND GULLIES PRIOR TO CONSTRUCTION.

THE LAYOUT OF DRAINAGE ON THIS DRAWING IS INDICATIVE ONLY ARCHITECT TO CONFIRM EXACT LOCATION OF MANHOLES AND GULLIES.

U.N.Q. ALL DRAINAGE GOODS & FITTINGS TO BE:-

UPTO 3000 (AND INCLUDING) TO BE SUPERSLEEVE VITRIFIED CLAY PIPES OR SIMILAR.

ABOVE 3000 TO BE CONCRETE BY STANTON BONNA OR SIMILAR.

ALL COVERS AND RODDING ACCESS POINTS TO BE SEALED AND RECESSED TIGHT.

ALL INTERNAL MANHOLE COVERS TO BE DOUBLE SEALED, LOCKABLE AND RECESSED TO ACCEPT FLOOR FINISHES WHERE APPLICABLE.

SETTING OUT OF ALL INTERNAL GULLY/PLUMBING CONNECTIONS TO BE CO-ORDINATED BETWEEN THE SERVICE ENGINEERS AND THE ARCHITECT.

ALL INTERNAL GULLIES, PLUMBING CONNECTIONS, SOIL STACKS, SIPRS AND ALL OTHER CONNECTIONS OF FOUL AND SURFACE WATER DRAINS TO BELOW GROUND TO BE FITTED WITH ACCESSIBLE RODDING POINTS ABOVE SLAB LEVEL.

ALL SURFACE WATER CONNECTIONS TO BE 150mm DIAMETER AT MINIMUM FALLS OF 1:80 UNLESS NOTED OTHERWISE.

ALL FOUL WATER CONNECTIONS TO BE 150mm DIAMETER AT MINIMUM FALLS OF 1:150 UNLESS NOTED OTHERWISE.

ALL CONNECTIONS TO BE MADE IN ACCORDANCE WITH STANDARD DETAIL DRAWINGS.

ALL PIPEWORK TO BE INSTALLED WITH SOFFITS LEVEL (E.G. AT CHANGES IN PIPE SIZE) U.N.Q.

FOR DETAILS OF GREASE TRAP/MACERATOR REQUIREMENTS ASSOCIATED WITH KITCHENS REFER TO SERVICE ENGINEER.

ON COMPLETION OF DRAINAGE WORKS, THE NEW DRAINAGE SYSTEM IS TO BE THOROUGHLY CLEANED AND A CCTV SURVEY CARRIED OUT TO CONFIRM NO CONSTRUCTION DEBRIS OR BLOCKAGES REMAIN.

CONNECTIONS TO CARRIER DRAINS ARE TO BE "Y" JUNCTIONS.

ALL PRIVATE DRAINAGE IS TO COMPLY WITH BS EN 752 AND BUILDING REGS. PART H.

PIPE GRADIENTS ARE INDICATIVE MINIMUMS.

SURFACE CHANNEL DRAINS TO BE ACO MULTIDRAIN OR SIMILAR.

MANHOLES:

ALL PROPOSED NEW MANHOLES TO BE PRECAST RING MANHOLES TYPE B UNLESS NOTED OTHERWISE. INTERNAL DIAMETERS OF MANHOLES TO BE 1000mm WHERE DEPTH TO PIPE SOFFIT IS LESS THAN 1.5m, AND 1200mm @ ELSEWHERE UNLESS NOTED OTHERWISE. 1C DENOTES POLYPROPYLENE INSPECTION CHAMBER BY HEPWORTH OR SIMILAR APPROVED INSTALLED IN ACCORDANCE WITH THE MANUFACTURERS RECOMMENDATIONS.

MANHOLE COVERS:

CARRIAGEWAYS GENERAL - EN124 CLASS D400
CARRIAGEWAYS WITHIN 0.5m OF KERB - EN124 CLASS C250
SLOW MOVING HGV (B8) - EN 124 CLASS B125 SLOW MOVING
GLV (10) - EN 124 CLASS B125 SLOW MOVING PRIVATE CARS - EN124 CLASS B125.

INTERNAL - JONES OF OSWESTRY - SUPRASTEEL DOUBLE SEALED WITH NEOPRENE GASKET AND COVER GREASE OR SIMILAR APPROVED.

REFER TO ARCHITECTS DRAWINGS FOR DETAILS OF ANY MANHOLE COVERS WHICH REQUIRE INSET PANELS.

FINAL CONSTRUCTION

WML DRAWINGS ARE FINAL CONSTRUCTION RECORD DRAWINGS INCORPORATING ANY AS-BUILT INFORMATION SUPPLIED BY THE CONTRACTOR

R01	FINAL CONSTRUCTION ISSUE	11/01/24	DB	LoG
Rev.	Amendment	Date	By	Chkd

Project: **GLENDENE, WYTHENSHAW**

Client: **BTP ARCHITECTS**


Title: **SECTION 104 - PROPOSED DRAINAGE LAYOUT SHEET 3**

Drawn	DB	Checked	LoG	Date	SEPT 21	Scale	1:100 @ A0
-------	----	---------	-----	------	---------	-------	------------

WML CONSULTING
Chartered Civil and Structural Engineers

No.1 Oak Green
East Road
Barnley, South Yorkshire
YO10 2BB
Tel: 01454 482 000
Fax: 01454 482 010
e-mail: info@wmlconsulting.com
www.wmlconsulting.com

Project	Originator	Volume	Level	Type	Role	Number	Rev
9003	- WML - ZZ	- XX	- DR	- C	-	1014	R01

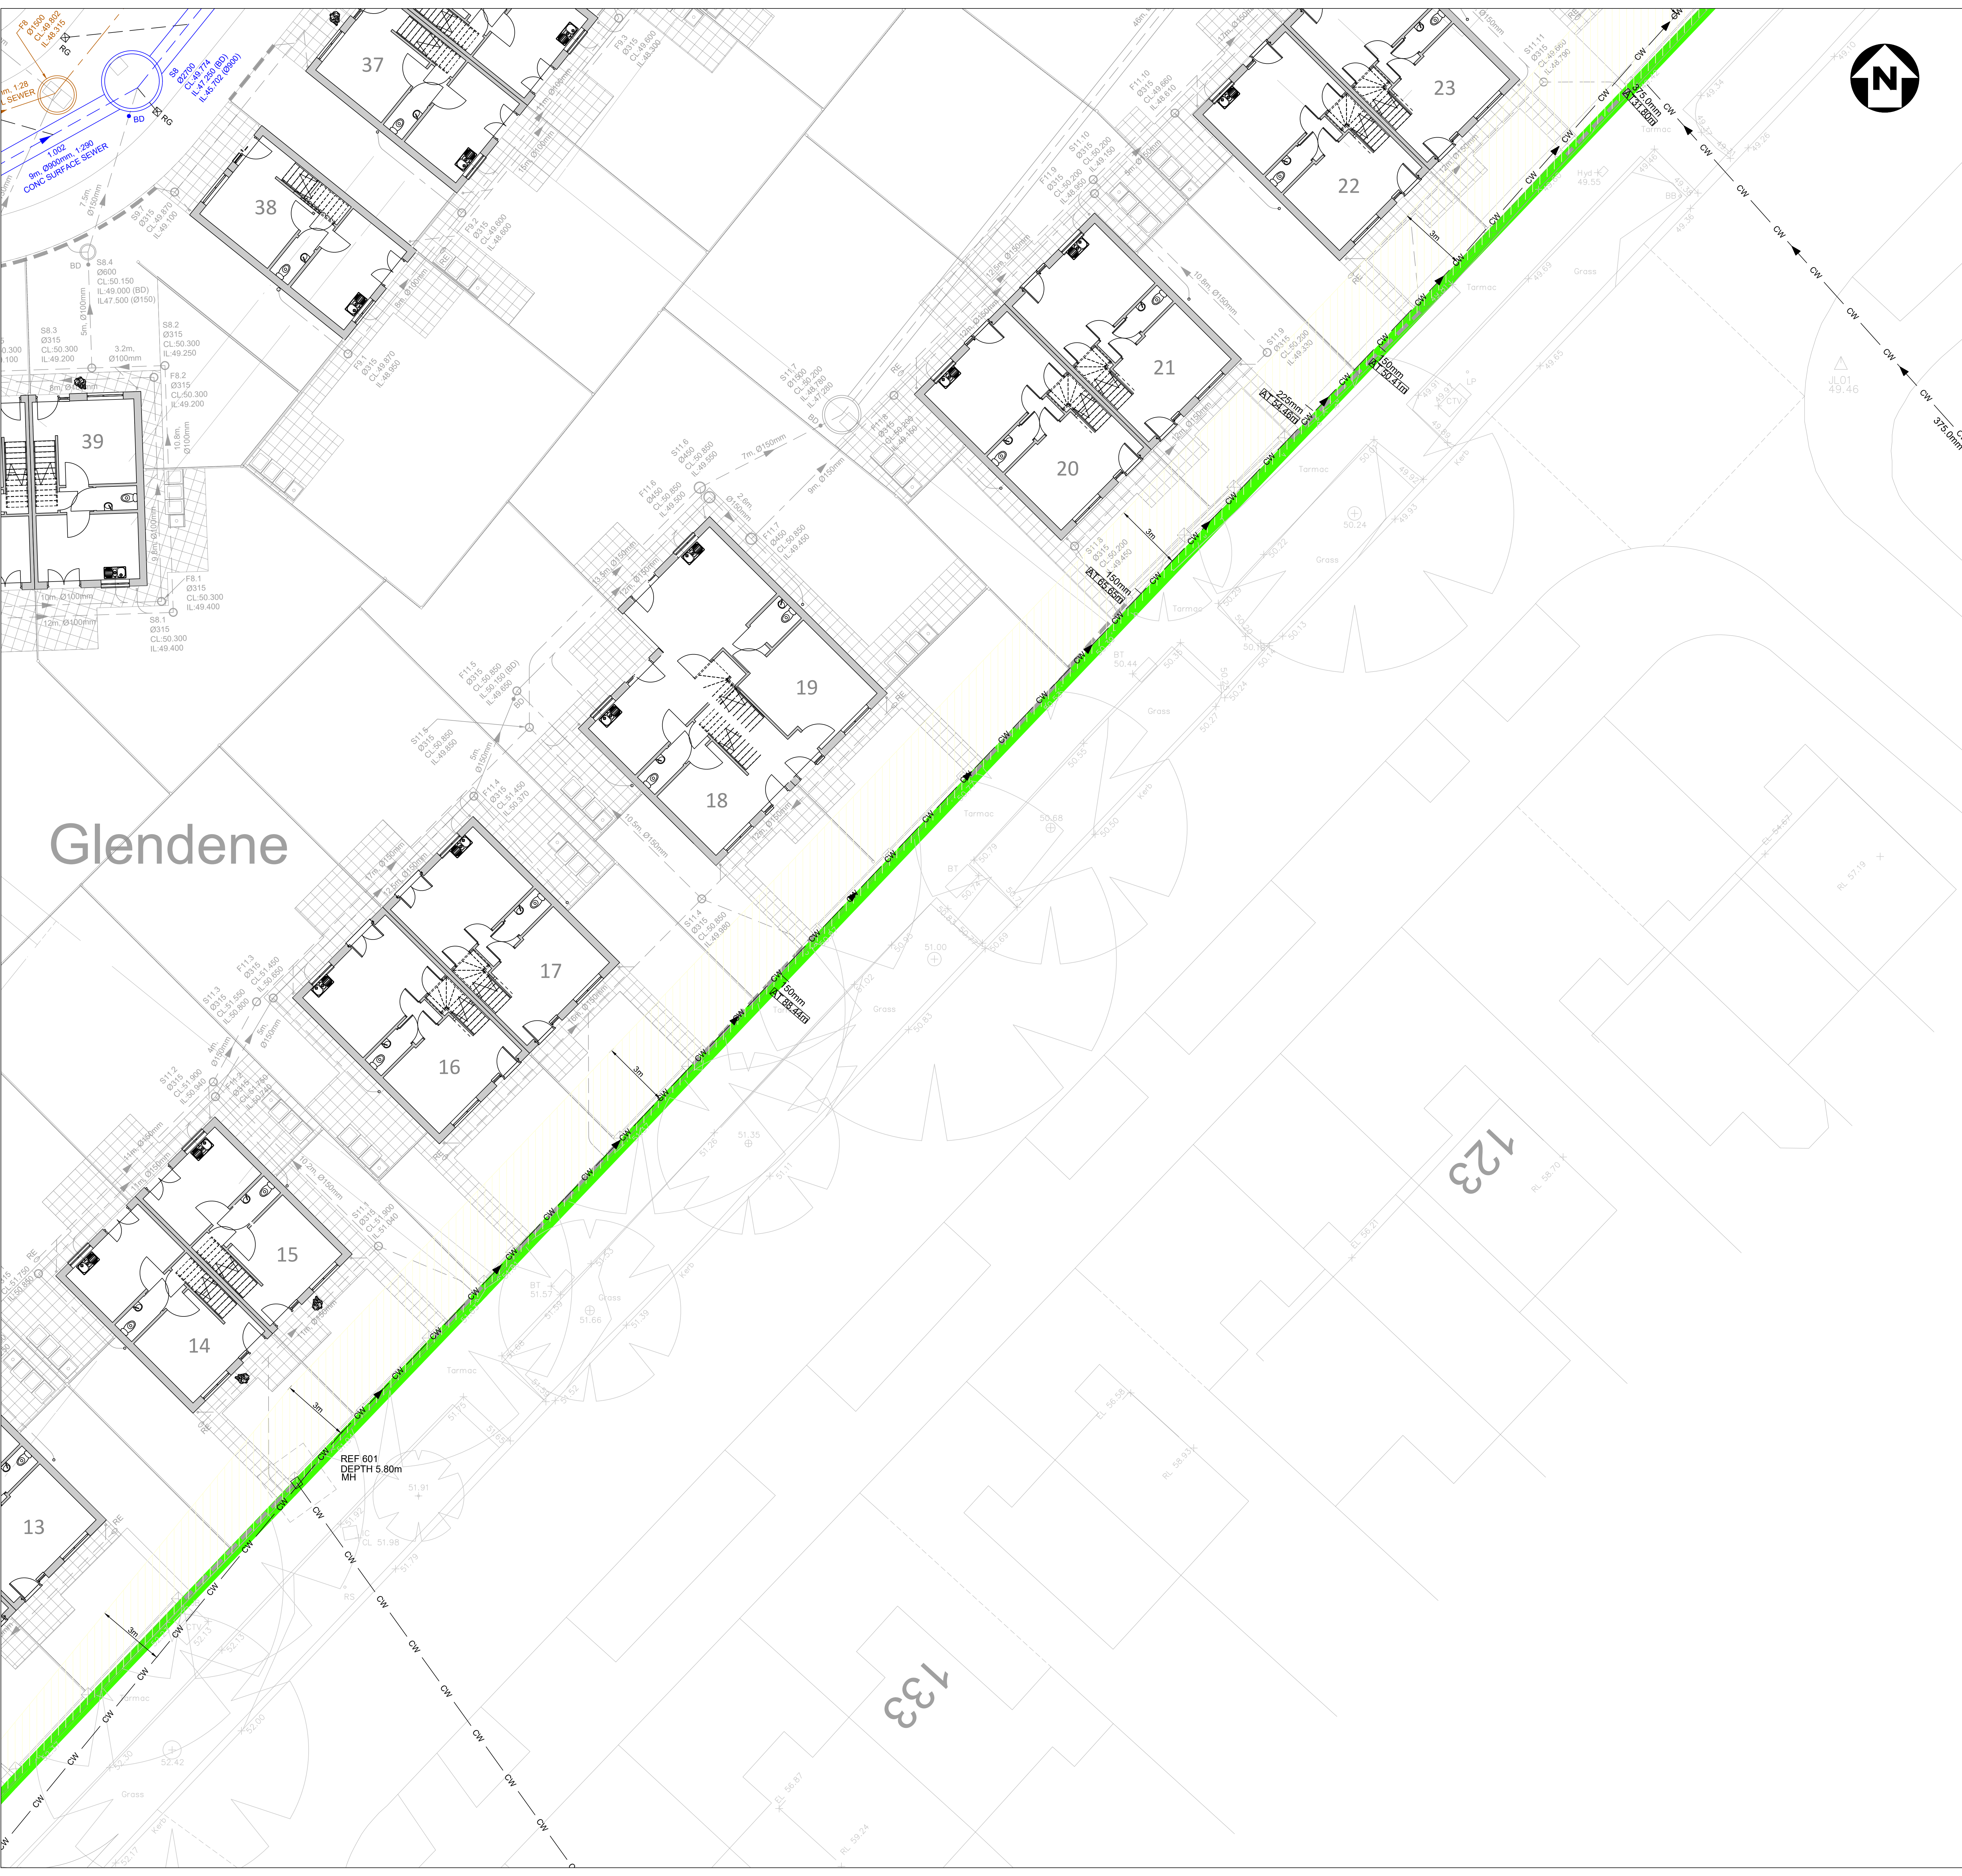

Glendene

123

133

LEGEND

- PROPOSED PRIVATE SURFACE WATER SEWER
- PROPOSED PROPOSED FOUL WATER SEWER
- PROPOSED ADOPTED SURFACE WATER SEWER
- PROPOSED ADOPTED FOUL WATER SEWER
- PROPOSED ADOPTED COMBINED WATER SEWER
- CW CW EXISTING ADOPTED COMBINED WATER SEWER
- EXISTING EXISTING UNITED UTILITIES EASEMENT
- DENOTES SITE BOUNDARY

SUBJECT TO APPROVAL FROM UNITED UTILITIES

DESIGN ASSUMPTIONS

THE PROPOSED DRAINAGE DESIGN ON THIS DRAWING IS BASED ON THE FOLLOWING ASSUMPTIONS:

ALL DRAINAGE COVER LEVELS SHOWN ARE INDICATIVE AND ARE SUBJECT TO FINAL LEVEL DESIGN BY THE ARCHITECT.

RWPs AND SLAB PENETRATIONS ARE SHOWN INDICATIVE ONLY. FOR FINAL SETTING OUT REFER TO ARCHITECT DRAWINGS.

THE DRAINAGE DESIGN / INFORMATION SHOWN ON THIS DRAWING IS INDICATIVE ONLY AND IS SUBJECT TO CONFIRMATION OF THE EXISTING UNITED UTILITIES PUBLIC SEWER DEPTHS.

RAIN WATER PIPES AND SLAB PENETRATIONS ARE SHOWN INDICATIVE ONLY. ARCHITECT IS TO CONFIRM FINAL POSITIONS PRIOR TO DETAILED DESIGN.

PROPOSED FLOW RATES ARE AS OUTLINED IN THE DRAINAGE STRATEGY ASSUME THAT THE LOCAL PLANNING AUTHORITY & UNITED UTILITIES DO NOT IMPOSE FURTHER RESTRICTIONS TO DISCHARGE RATES.

GENERAL NOTES

DO NOT SCALE FROM THIS DRAWING WORK TO FIGURED DIMENSIONS ONLY.

NO DEVIATION FROM THE DETAILS SHOWN ON THIS DRAWING IS ALLOWED WITHOUT PRIOR PERMISSION IN WRITING.

ALL DRAWINGS ARE TO BE READ IN CONJUNCTION WITH ALL ARCHITECTS, ENGINEERS AND SPECIALISTS DRAWINGS AND THE SPECIFICATION.

THE CONTRACTOR SHALL INCORPORATE ALL THE REQUIREMENTS OF THE PRE-TENDER STAGE HEALTH AND SAFETY PLAN.

THIS DRAWING IS TO BE READ IN CONJUNCTION WITH WML DRAINAGE DETAIL DRAWINGS FOR DETAILS OF MATERIALS AND WORKMANSHIP REFER TO THE SPECIFICATION.

THE CONTRACTOR IS RESPONSIBLE FOR CHECKING INVERT LEVELS AND POSITIONS OF ALL EXISTING DRAINS, SEWERS, INSPECTION CHAMBERS AND MANHOLES SHOWN ON THIS DRAWING IMMEDIATELY ON SITE ESTABLISHMENT. ANY DISCREPANCIES MUST BE REPORTED TO WML CONSULTING IMMEDIATELY.

WHERE THE NEW SITE DRAINAGE CONNECTS IN TO EXISTING MANHOLES IN CARRIAGEWAYS AND/OR EXISTING ADOPTED SEWERS, THE CONTRACTOR IS RESPONSIBLE FOR ALL LIAISON WITH THE RELEVANT STATUTORY UNDERTAKER AND LOCAL AUTHORITY WITH REGARD TO ROAD CLOSURES, TRAFFIC MANAGEMENT, PERMITS TO WORK, SUBMISSION OF CONTRACTORS METHOD STATEMENTS AND RISK ASSESSMENTS AND OTHER DOCUMENTATION AND CORRESPONDENCE ASSOCIATED WITH THE SITE STAGE (PART 2) ELEMENT OF THE WORKS.

ROCKER PIPES TO BE PROVIDED AT ALL CONCRETE CASSED INTERFACES.

PROVIDE ADEQUATE PROTECTION TO MAINTAIN MINIMUM COVER TO DRAINS DURING THE CONSTRUCTION PERIOD.

COVER LEVELS ON THIS DRAWING ARE APPROXIMATE AND INDICATIVE ONLY ARCHITECT TO CONFIRM COVER LEVELS TO ALL MANHOLES AND GULLIES PRIOR TO CONSTRUCTION.

THE LAYOUT OF DRAINAGE ON THIS DRAWING IS INDICATIVE ONLY ARCHITECT TO CONFIRM EXACT LOCATION OF MANHOLES AND GULLIES.

U.N.O. ALL DRAINAGE GOODS & FITTINGS TO BE:-

UPTO 3000 (AND INCLUDING) TO BE SUPERSLEVE VITRIFIED CLAY PIPES OR SIMILAR.

ABOVE 3000 TO BE CONCRETE BY STANTON BONNA OR SIMILAR.

ALL COVERS AND RODDING ACCESS POINTS TO BE SEALED AND SECURED TIGHT.

ALL INTERNAL MANHOLE COVERS TO BE DOUBLE SEALED, LOCKABLE AND RECESSED TO ACCEPT FLOOR FINISHES WHERE APPLICABLE.

SETTING OUT OF ALL INTERNAL GULLY/PLUMBING CONNECTIONS TO BE CO-ORDINATED BETWEEN THE SERVICE ENGINEERS AND THE ARCHITECT.

ALL INTERNAL GULLIES, PLUMBING CONNECTIONS, SOIL STACKS, SIPS AND ALL OTHER CONNECTIONS OF FOUL AND SURFACE WATER DRAINS TO BELOW GROUND TO BE FITTED WITH ACCESSIBLE RODDING POINTS ABOVE SLAB LEVEL.

ALL SURFACE WATER CONNECTIONS TO BE 150mm DIAMETER AT MINIMUM FALLS OF 1:80 UNLESS NOTED OTHERWISE.

ALL FOUL WATER CONNECTIONS TO BE 150mm DIAMETER AT MINIMUM FALLS OF 1:150 UNLESS NOTED OTHERWISE.

ALL CONNECTIONS TO BE MADE IN ACCORDANCE WITH STANDARD DETAIL DRAWINGS.

ALL PIPEWORK TO BE INSTALLED WITH SOFFITS LEVEL (E.G. AT CHANGES IN PIPE SIZE) U.N.O.

FOR DETAILS OF GREASE TRAP/MACERATOR REQUIREMENTS ASSOCIATED WITH KITCHENS REFER TO SERVICE ENGINEER.

ON COMPLETION OF DRAINAGE WORKS, THE NEW DRAINAGE SYSTEM IS TO BE THOROUGHLY CLEANED AND A CCTV SURVEY CARRIED OUT TO CONFIRM NO CONSTRUCTION DEBRIS OR BLOCKAGES REMAIN.

CONNECTIONS TO CARRIER DRAINS ARE TO BE "Y" JUNCTIONS.

ALL PRIVATE DRAINAGE IS TO COMPLY WITH BS EN 752 AND BUILDING REGS. PART H.

PIPE GRADIENTS ARE INDICATIVE MINIMUMS.

SURFACE CHANNEL DRAINS TO BE ACO MULTIDRAIN OR SIMILAR.

MANHOLES:

ALL PROPOSED NEW MANHOLES TO BE PRECAST RING MANHOLES TYPE B UNLESS NOTED OTHERWISE. INTERNAL DIAMETERS OF MANHOLES TO BE 1000mm WHERE DEPTH TO PIPE SOFFIT IS LESS THAN 1.5m, AND 1200mm @ 90° ELSEWHERE UNLESS NOTED OTHERWISE. 1C - DENOTES POLYPROPYLENE INSPECTION CHAMBER BY HEPWORTHY OR SIMILAR APPROVED INSTALLED IN ACCORDANCE WITH THE MANUFACTURERS RECOMMENDATIONS.

MANHOLE COVERS:

CARRIAGEWAYS GENERAL - EN124 CLASS D400

CARRIAGEWAYS WITHIN 0.5m OF KERB - EN124 CLASS C250

SLOW MOVING HGV [38] - EN 124 CLASS B125 SLOW MOVING

GLV [10] - EN 124 CLASS B125 SLOW MOVING PRIVATE CARS - EN124 CLASS B125.


INTERNAL - JONES OF OSWESTRY - SUPRASTEEL DOUBLE SEALED WITH NEOPRENE GASKET AND COVER GREASE OR SIMILAR APPROVED.

REFER TO ARCHITECTS DRAWINGS FOR DETAILS OF ANY MANHOLE COVERS WHICH REQUIRE INSET PANELS.

FINAL CONSTRUCTION

WML DRAWINGS ARE FINAL CONSTRUCTION RECORD DRAWINGS INCORPORATING ANY AS-BUILT INFORMATION SUPPLIED BY THE CONTRACTOR

R01	FINAL CONSTRUCTION ISSUE	11/01/24	DB	LoG			
Rev.	Amendment	Date	By	Chk			
Project GLENDENE, WYTHENSHAW							
Client BTP ARCHITECTS							
Title SECTION 104 - PROPOSED DRAINAGE LAYOUT SHEET 4							
Drawn DB	Checked LoG	Date SEPT 21	Scale 1:100 @ A0				
WML CONSULTING Chartered Civil and Structural Engineers No. 8 Oak Green East Road Barnley Green Business Park Cheshire M30 2QL Tel: 0161 482 0000 Fax: 0161 482 0010 e-mail: info@wmlconsulting.com www.wmlconsulting.com							
Project 9003	Originator - WML - ZZ -	Volume XX -	Level DR -	Type C -	Role 1015	Number R01	Rev

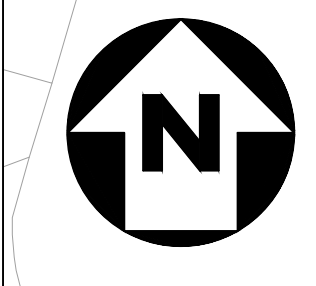

LEGEND

- PROPOSED PRIVATE SURFACE WATER SEWER
- PROPOSED FOULED WATER SEWER
- PROPOSED ADOPTED SURFACE WATER SEWER
- PROPOSED ADOPTED FOULED WATER SEWER
- PROPOSED ADOPTED COMBINED WATER SEWER
- CW CW EXISTING ADOPTED COMBINED WATER SEWER

**SUBJECT TO APPROVAL FROM
UNITED UTILITIES**

DESIGN ASSUMPTIONS

THE PROPOSED DRAINAGE DESIGN ON THIS DRAWING IS BASED ON THE FOLLOWING ASSUMPTIONS:

ALL DRAINAGE COVER LEVELS SHOWN ARE INDICATIVE AND ARE SUBJECT TO FINAL LEVEL DESIGN BY THE ARCHITECT.

RWPs AND SLAB PENETRATIONS ARE SHOWN INDICATIVE ONLY. FOR FINAL SETTING OUT REFER TO ARCHITECT DRAWINGS.

THE DRAINAGE DESIGN / INFORMATION SHOWN ON THIS DRAWING IS INDICATIVE ONLY AND IS SUBJECT TO CONFIRMATION OF THE EXISTING UNITED UTILITIES PUBLIC SEWER DEPTHS.

RAIN WATER PIPES AND SLAB PENETRATIONS ARE SHOWN INDICATIVE ONLY. ARCHITECT IS TO CONFIRM FINAL POSITIONS PRIOR TO DETAILED DESIGN.

PROPOSED FLOW RATES ARE AS OUTLINED IN THE DRAINAGE STRATEGY ASSUME THAT THE LOCAL PLANNING AUTHORITY & UNITED UTILITIES DO NOT IMPOSE FURTHER RESTRICTIONS TO DISCHARGE RATES.

GENERAL NOTES

DO NOT SCALE FROM THIS DRAWING WORK TO FIGURED DIMENSIONS ONLY.

NO DEVIATION FROM THE DETAILS SHOWN ON THIS DRAWING IS ALLOWED WITHOUT PRIOR PERMISSION IN WRITING.

ALL DRAWINGS ARE TO BE READ IN CONJUNCTION WITH ALL ARCHITECTS, ENGINEERS AND SPECIALISTS DRAWINGS AND THE SPECIFICATION.

THE CONTRACTOR SHALL INCORPORATE ALL THE REQUIREMENTS OF THE PRE-TENDER STAGE HEALTH AND SAFETY PLAN.

FINAL CONSTRUCTION


WML DRAWINGS ARE FINAL CONSTRUCTION RECORD DRAWINGS INCORPORATING ANY AS-BUILT INFORMATION SUPPLIED BY THE CONTRACTOR

FINAL CONSTRUCTION ISSUE		11.01.24	DB	LoG
Amendment		Date	By	Chkd
GLENDENE, WYTHENSHAWE				
T BTP ARCHITECTS				
SECTION 104 - PROPOSED DRAINAGE AREA PLAN				
DB	Checked LoG	Date SEPT 21	Scale 1:200 @ A0	
WML CONSULTING Chartered Civil and Structural Engineers		No. 1 Oak Green East Road Stanning Green Business Park Cheshire SK10 5QL Tel: 0161 482 0000 Fax: 0161 482 0010 e-mail: info@wmlconsulting.com www.wmlconsulting.com		
ect	Originator	Volume	Level	Type
03	- WML - ZZ	- XX	- DR	- C
	Number	Rev		
	1016			

DO NOT SCALE FROM THIS DRAWING WORK TO FIGURED DIMENSIONS ONLY.


ALL DRAWINGS ARE TO BE READ IN CONJUNCTION WITH ALL ARCHITECTS,
ENGINEERS AND SPECIALISTS DRAWINGS AND THE SPECIFICATION.

THIS DRAWING IS TO BE READ IN CONJUNCTION WITH WML DRAINAGE
DETAIL DRAWINGS FOR DETAILS OF MATERIALS AND WORKMANSHIP
REFER TO THE SPECIFICATION.

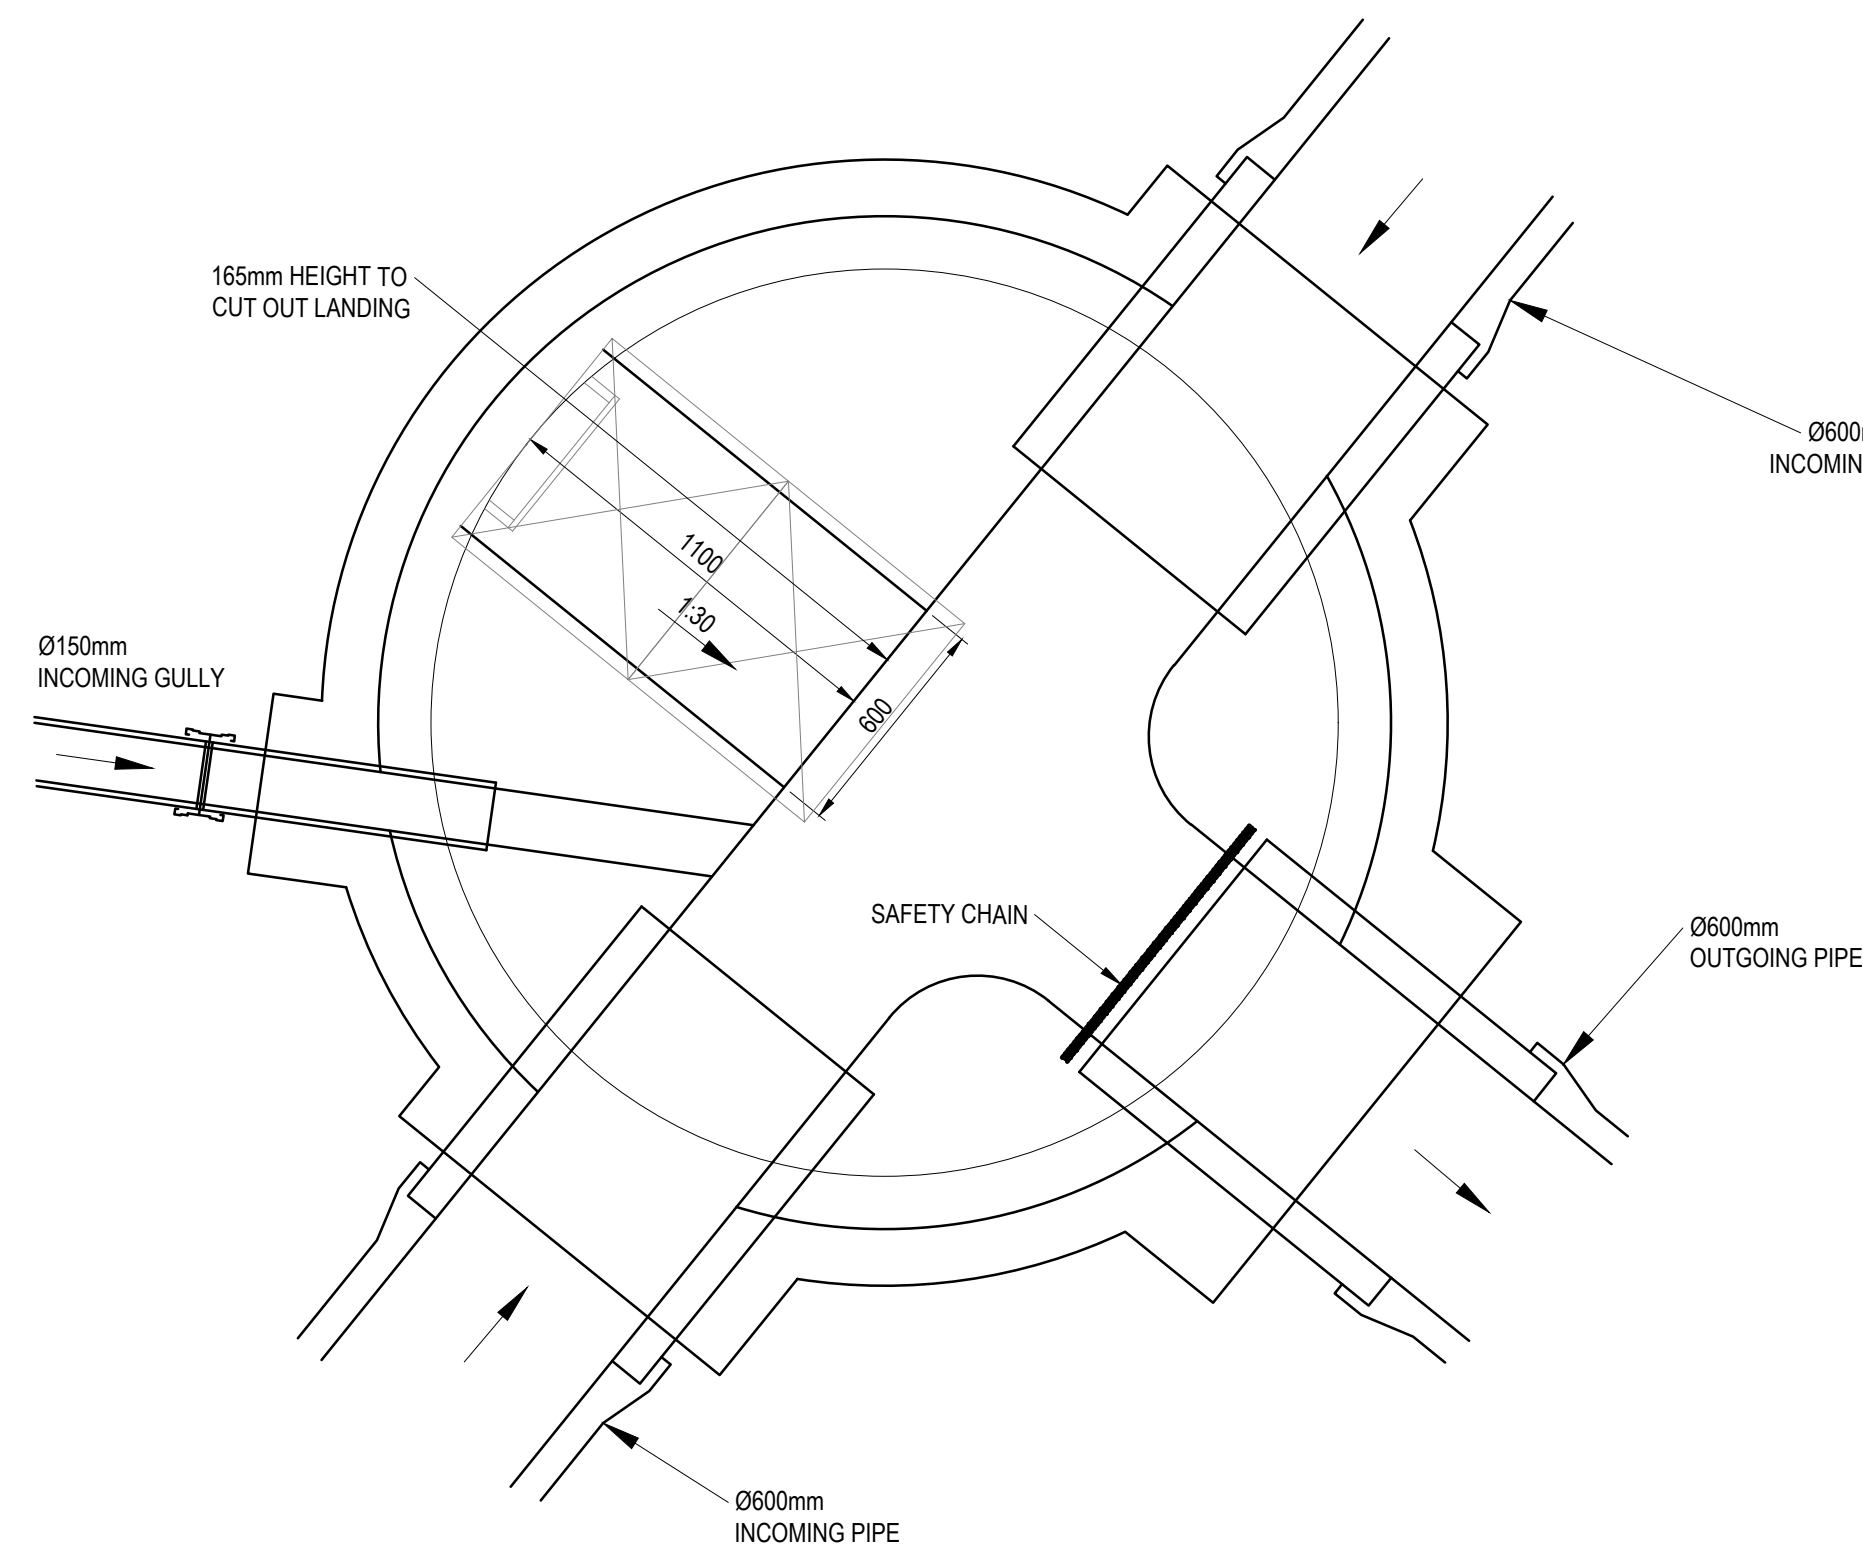

MANHOLE REF	SETTING OUT	COVER LEVEL	INVERT LEVEL	DEPTH TO SOFFIT	MANHOLE DIAMETER	MANHOLE COVER	MANHOLE TYPE	COVER SLAB OPENING
S2	E:381020.880 N:387625.605	51.680	49.633	1.447m	2.400m	1200x675 D400 150mm DEEP	PCC TYPE 4	1200x675


MANHOLE REF	SETTING OUT	COVER LEVEL	INVERT LEVEL	DEPTH TO SOFFIT	MANHOLE DIAMETER	MANHOLE COVER	MANHOLE TYPE	COVER SLAB OPENING
S4	E:381057.270 N:387604.915	52.216m	49.457m	2.159m	2.400m	600x600 D400 150mm DEEP	FLOW CONTROL MH	750x600

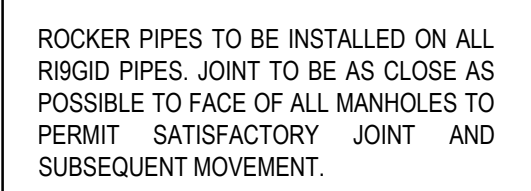

THE RECOMMENDED LENGTH OF THE NEXT PIPE (ROCKER PIPE) AWAY FROM THE MANHOLE FROM SEWERS FOR ADOPTION (6TH EDITION) SHOULD BE AS SHOWN IN THE TABLE BELOW:

WHERE LADDERS ARE USED, SEATING RINGS TO BE TURNED 180° TO ENSURE 600x600 ACCESS IS MAINTAINED WITH THE INCLUSION OF LADDERS.

ALL LATERAL CONNECTIONS TO BE MADE
AT SOFFIT LEVEL TO THE MAIN CHANNEL.

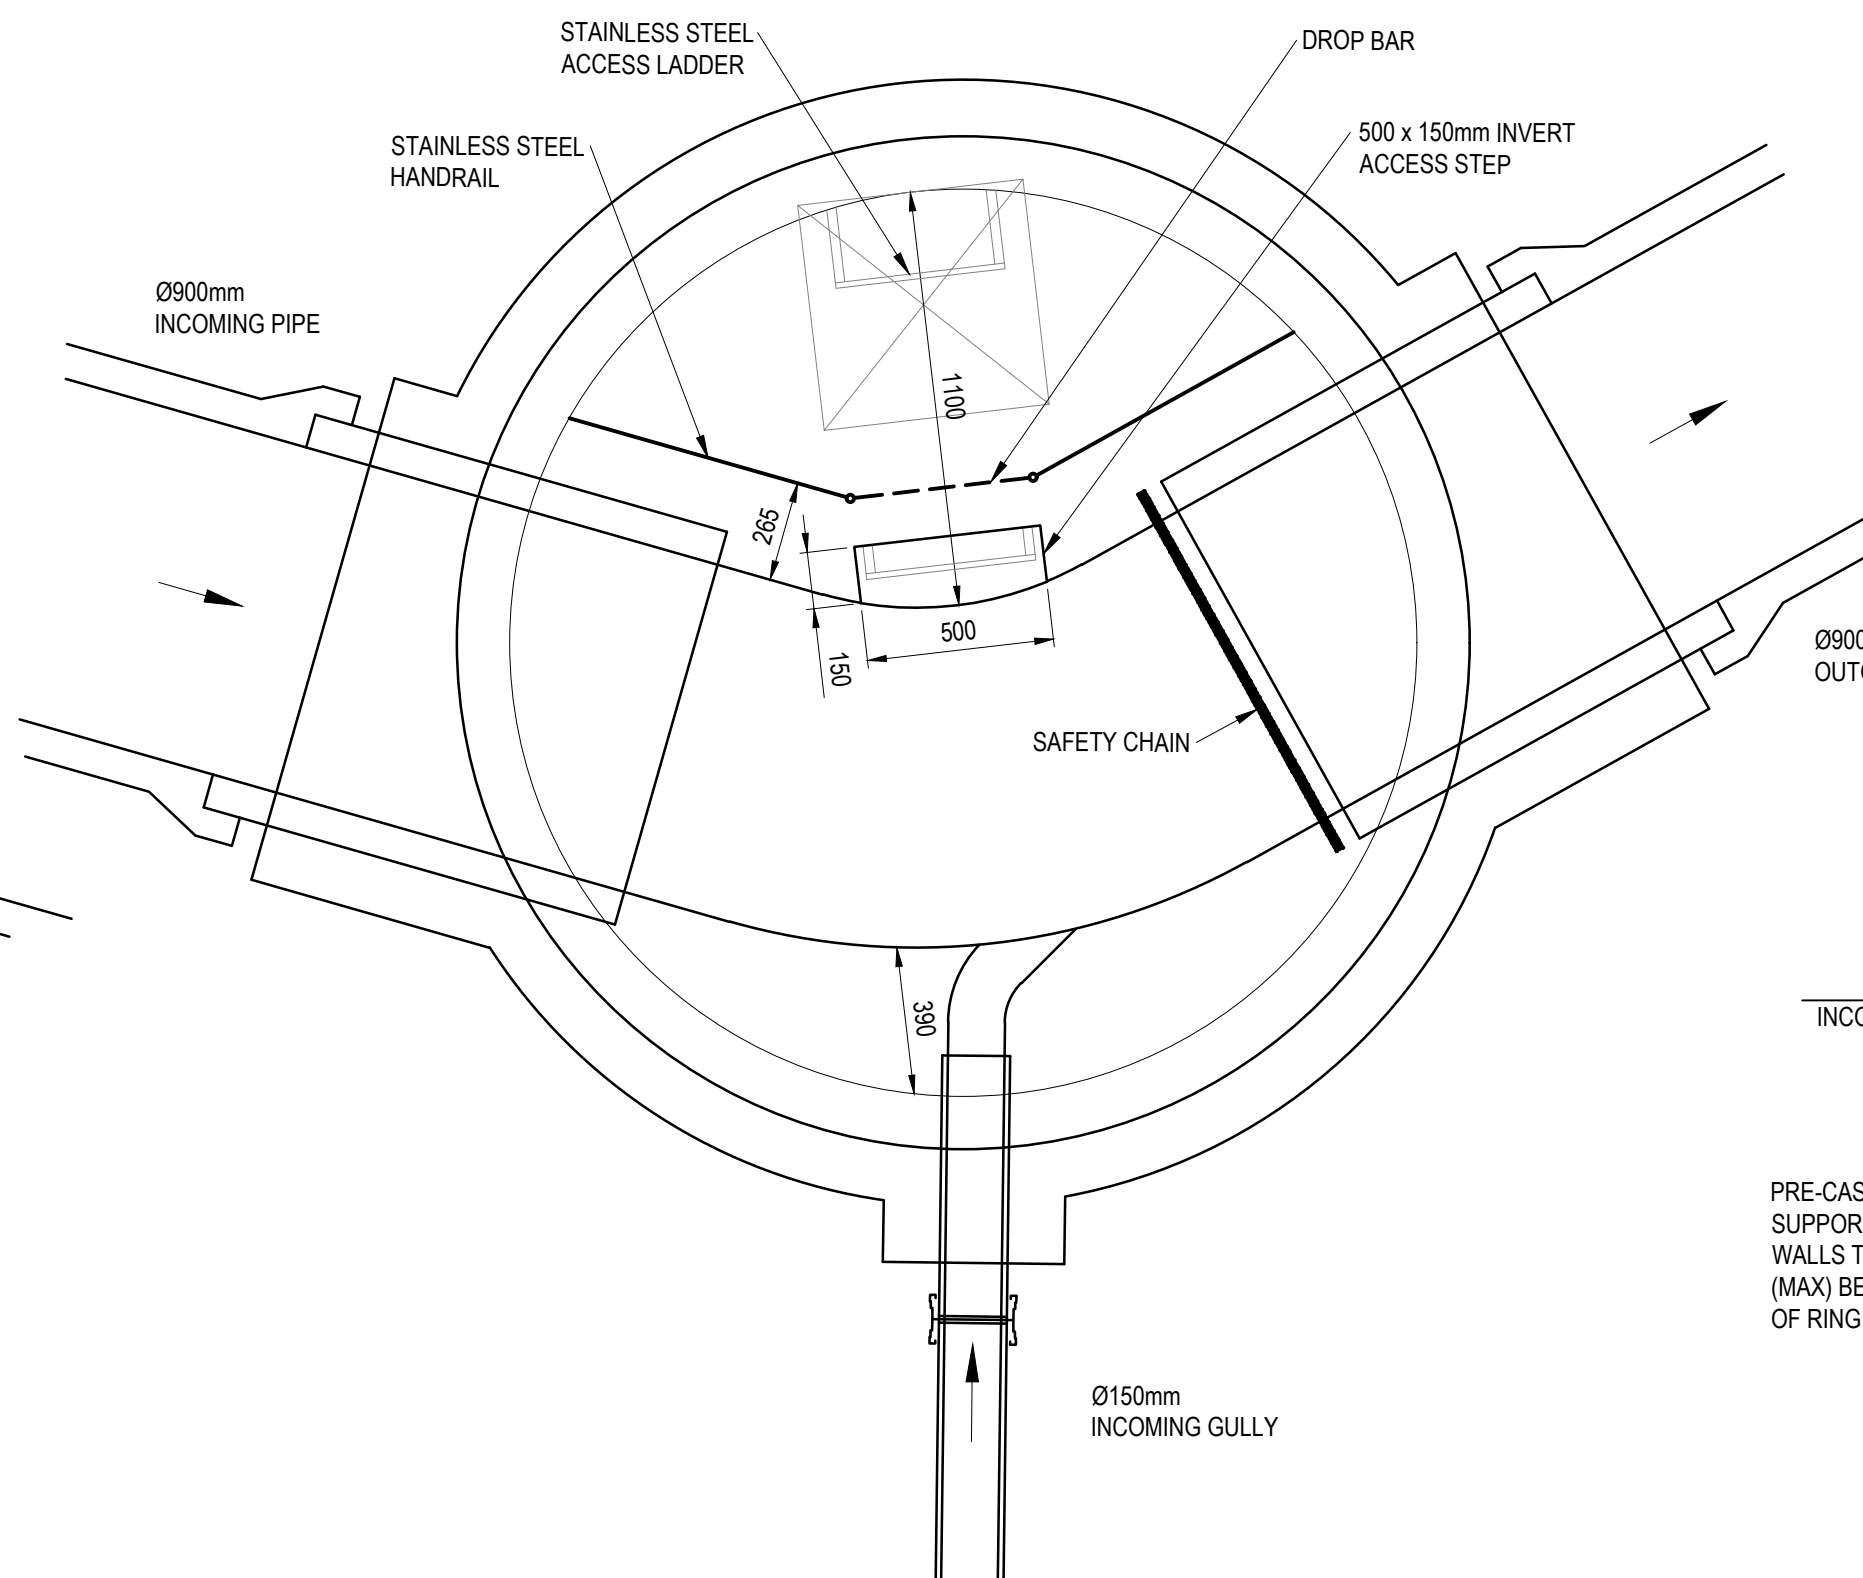

MANHOLE REF	SETTING OUT	COVER LEVEL	INVERT LEVEL	DEPTH TO SOFFIT	MANHOLE DIAMETER	MANHOLE COVER	MANHOLE TYPE	COVER SLAB OPENING
S6	E:981057.205 N:387678.650	50.068m	45.776m	3.392m	2.400m	600x600 D400 150mm DEEP	PCC TYPE 2	750x600

1200 x 675mm CLEAR OPENING

M.H. COVER AND FRAME.

ROPE TO OPERATE PIVOTING BY-PASS DOOR, AND TO HAVE A RISING SPINDLE

CL 52 216

PC COVER SLAB

PCC FRAME SEATING RINGS (1 min. 3 mmbENEATH COVER AND FRAME IN ACCORDANCE WITH UU DETAILS

PRE-CAST MANHOLE RINGS

Ø950mm OUTGOING PIPE

Ø950 INCOMING PIPE

Ø150mm INCOMING

HIGH STRENGTH CONCRETE TOPPING TO BE BROUGHT UP TO A DENSE SMOOTH FACE TO A DENSE SMOOTH FACE TO ALL BRANCH CONNECTIONS (MINIMUM THICKNESS 20mm)

MIN 150mm THK CONCRETE SURROUND

FLOW CONTROL BY SPECIALIST HYDRO-BRAN WITH A PIVOTING BY-PASS DOOR TO LIMIT FLOW.

OUTFLOW

IL 49.457

IL 48.457

PRE-CAST CONCRETE CHAMBER RINGS SUPPORTED ON MASS CONCRETE BASE AND WALLS TO LEVEL OF 100mm (MIN) AND 200mm (MAX) BETWEEN PIPE CROWN AND UNDERSIDE OF RING IN ACCORDANCE WITH UU DETAILS

HYDRO-BRAKE REF MD SHE 0137/1000-1600-1000 DESIGN FLOW = 10 l/sec DESIGN HEAD = 1.6m

425

60°

145

290

300mm THK REINFORCED CONCRETE BASE SLAB WITH 2 LAYERS A303 MESH IN TOP WITH 50mm COVER

MIN SUMP TO DEPTH OF 425mm BELOW OUTLET PIPE

Technical drawing of a double step access connection. The drawing shows a circular manhole with a 60-degree sector cut out. An incoming pipe with a diameter of 100mm and a length of 50.270m enters from the left. An outgoing pipe with a diameter of 25mm exits from the top right. The distance from the center of the manhole to the center of the outgoing pipe is 3.72m. A label "DOUBLE STEP ACCESS" points to the 60-degree sector cutout.

MANHOLE REF	SETTING OUT	COVER LEVEL	INVERT LEVEL	DEPTH TO SOFFIT	MANHOLE DIAMETER	MANHOLE COVER	MANHOLE TYPE	COVER SLAB OPENING
S5.3	E:381011.710 N:387669.875	51.572m	49.327m	2.020m	1.200m	600x600 D400 150mm DEEP	PCC TYPE 1	750x750

PE

DOUBLE STEP ACCESS

Ø150mm
INCOMING PRIVATE
BACKDROP CONNECTION
IL49 600

Ø150mm
INCOMING GULLY

Ø225mm
INCOMING PIPE

Ø225mm
OUTGOING PIPE

410

650

SUBJECT TO APPROVAL FROM
AND UNITED UTILITIES

WML DRAWINGS ARE FINAL CONSTRUCTION RECORD DRAWINGS INCORPORATING
ANY AS-BUILT INFORMATION SUPPLIED BY THE CONTRACTOR

Project	GLENDENE, WYTHENSHAW
---------	---------------------------------

Title SECTION 104 - MA

Drawn DB	Checked LoG	Date SEPT 21	Scale AS NOTED @ A0
-------------	----------------	-----------------	------------------------

No.8 Oak Green
Earl Road
Stanley Green Business Park
Cheadle Hulme
Cheshire SK8 6QL
Tel 0161 482 0000
Fax 0161 486 9210
e-mail info@wmlcoconsulting.com
www.wmlcoconsulting.com

Project	Originator	Volume	Level	Type	Role	Number	Rev
9003	- WML	- ZZ	- XX	- DR	- C	- 1021	R01

GENERAL NOTES

DO NOT SCALE FROM THIS DRAWING WORK TO FIGURED DIMENSIONS ONLY.


NO DEVIATION FROM THE DETAILS SHOWN ON THIS DRAWING IS ALLOWED WITHOUT PRIOR PERMISSION IN WRITING.

ALL DRAWINGS ARE TO BE READ IN CONJUNCTION WITH ALL ARCHITECTS, ENGINEERS AND SPECIALISTS DRAWINGS AND THE SPECIFICATION.


THE CONTRACTOR SHALL INCORPORATE ALL THE REQUIREMENTS OF THE PRE-TENDER STAGE HEALTH AND SAFETY PLAN.

THIS DRAWING IS TO BE READ IN CONJUNCTION WITH WML DRAINAGE DETAIL DRAWINGS FOR DETAILS OF MATERIALS AND WORKMANSHIP REFER TO THE SPECIFICATION.


THE CONTRACTOR IS RESPONSIBLE FOR CHECKING INVERT LEVELS AND POSITIONS OF ALL EXISTING DRAINS, SEWERS, INSPECTION CHAMBERS AND MANHOLES SHOWN ON THIS DRAWING IMMEDIATELY ON SITE ESTABLISHMENT. ANY DISCREPANCIES MUST BE REPORTED TO WML CONSULTING IMMEDIATELY.

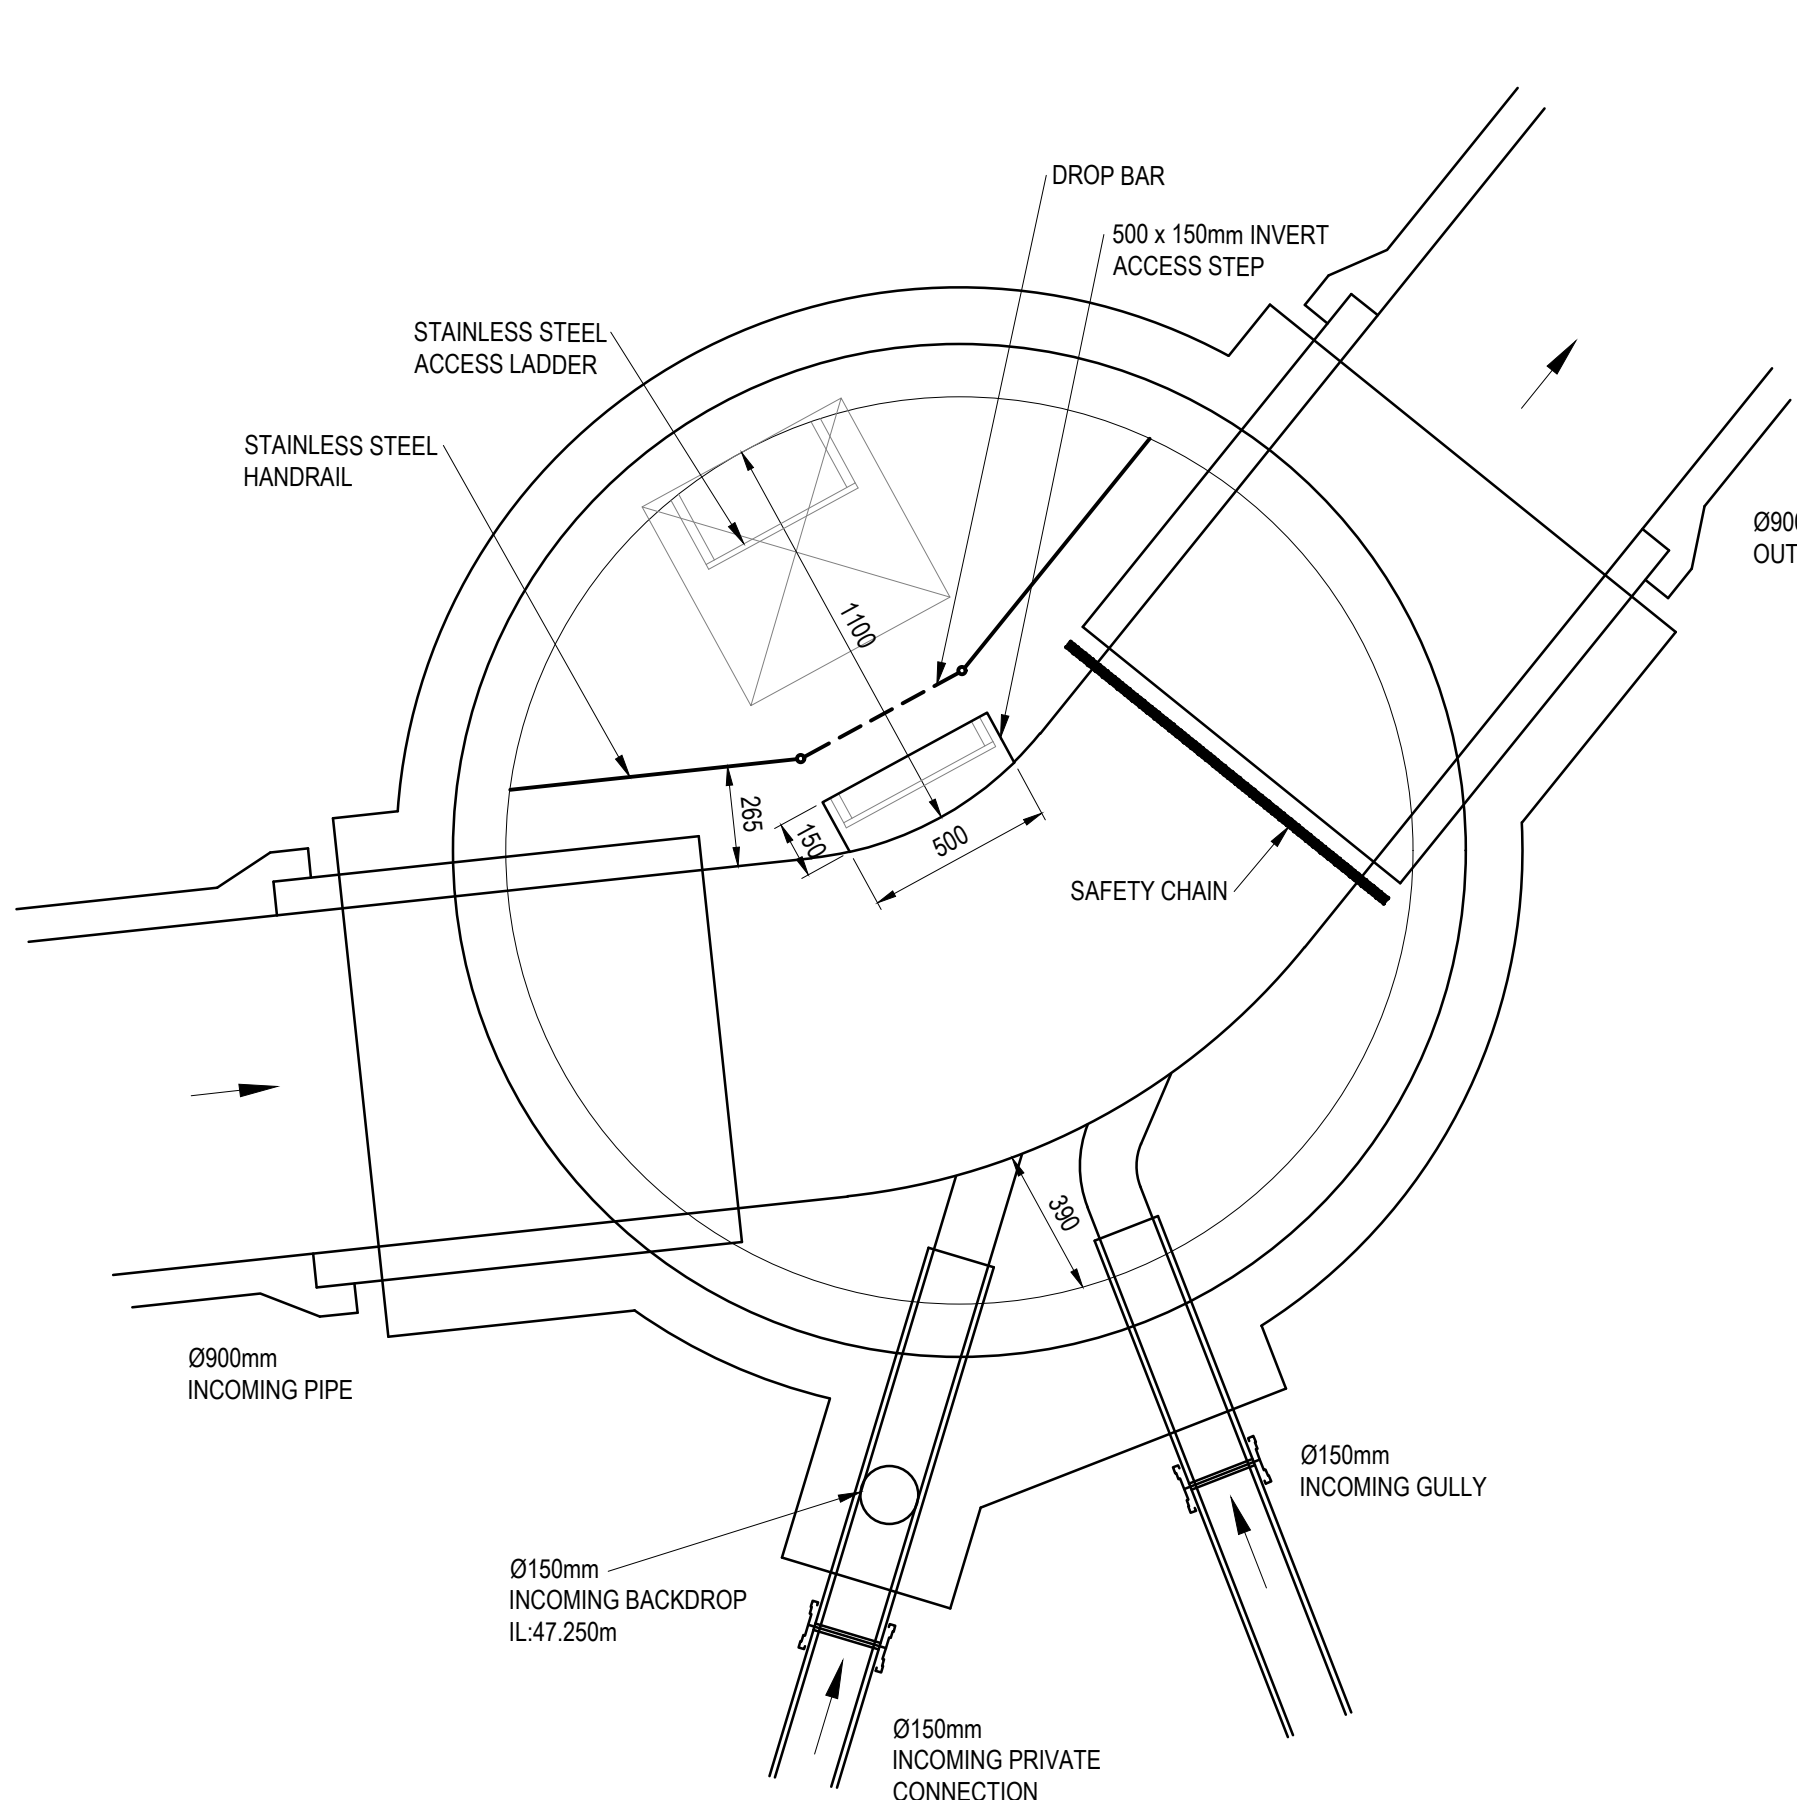


MANHOLE REF	SETTING OUT	COVER LEVEL	INVERT LEVEL	DEPTH TO SOFFIT	MANHOLE DIAMETER	MANHOLE COVER	MANHOLE TYPE	COVER SLAB OPENING
S8	E:381073.710 N:387680.575	48.774m	45.702m	3.172m	2,400m	600x600 D400 150mm DEEP	PCC TYPE 2	750x600

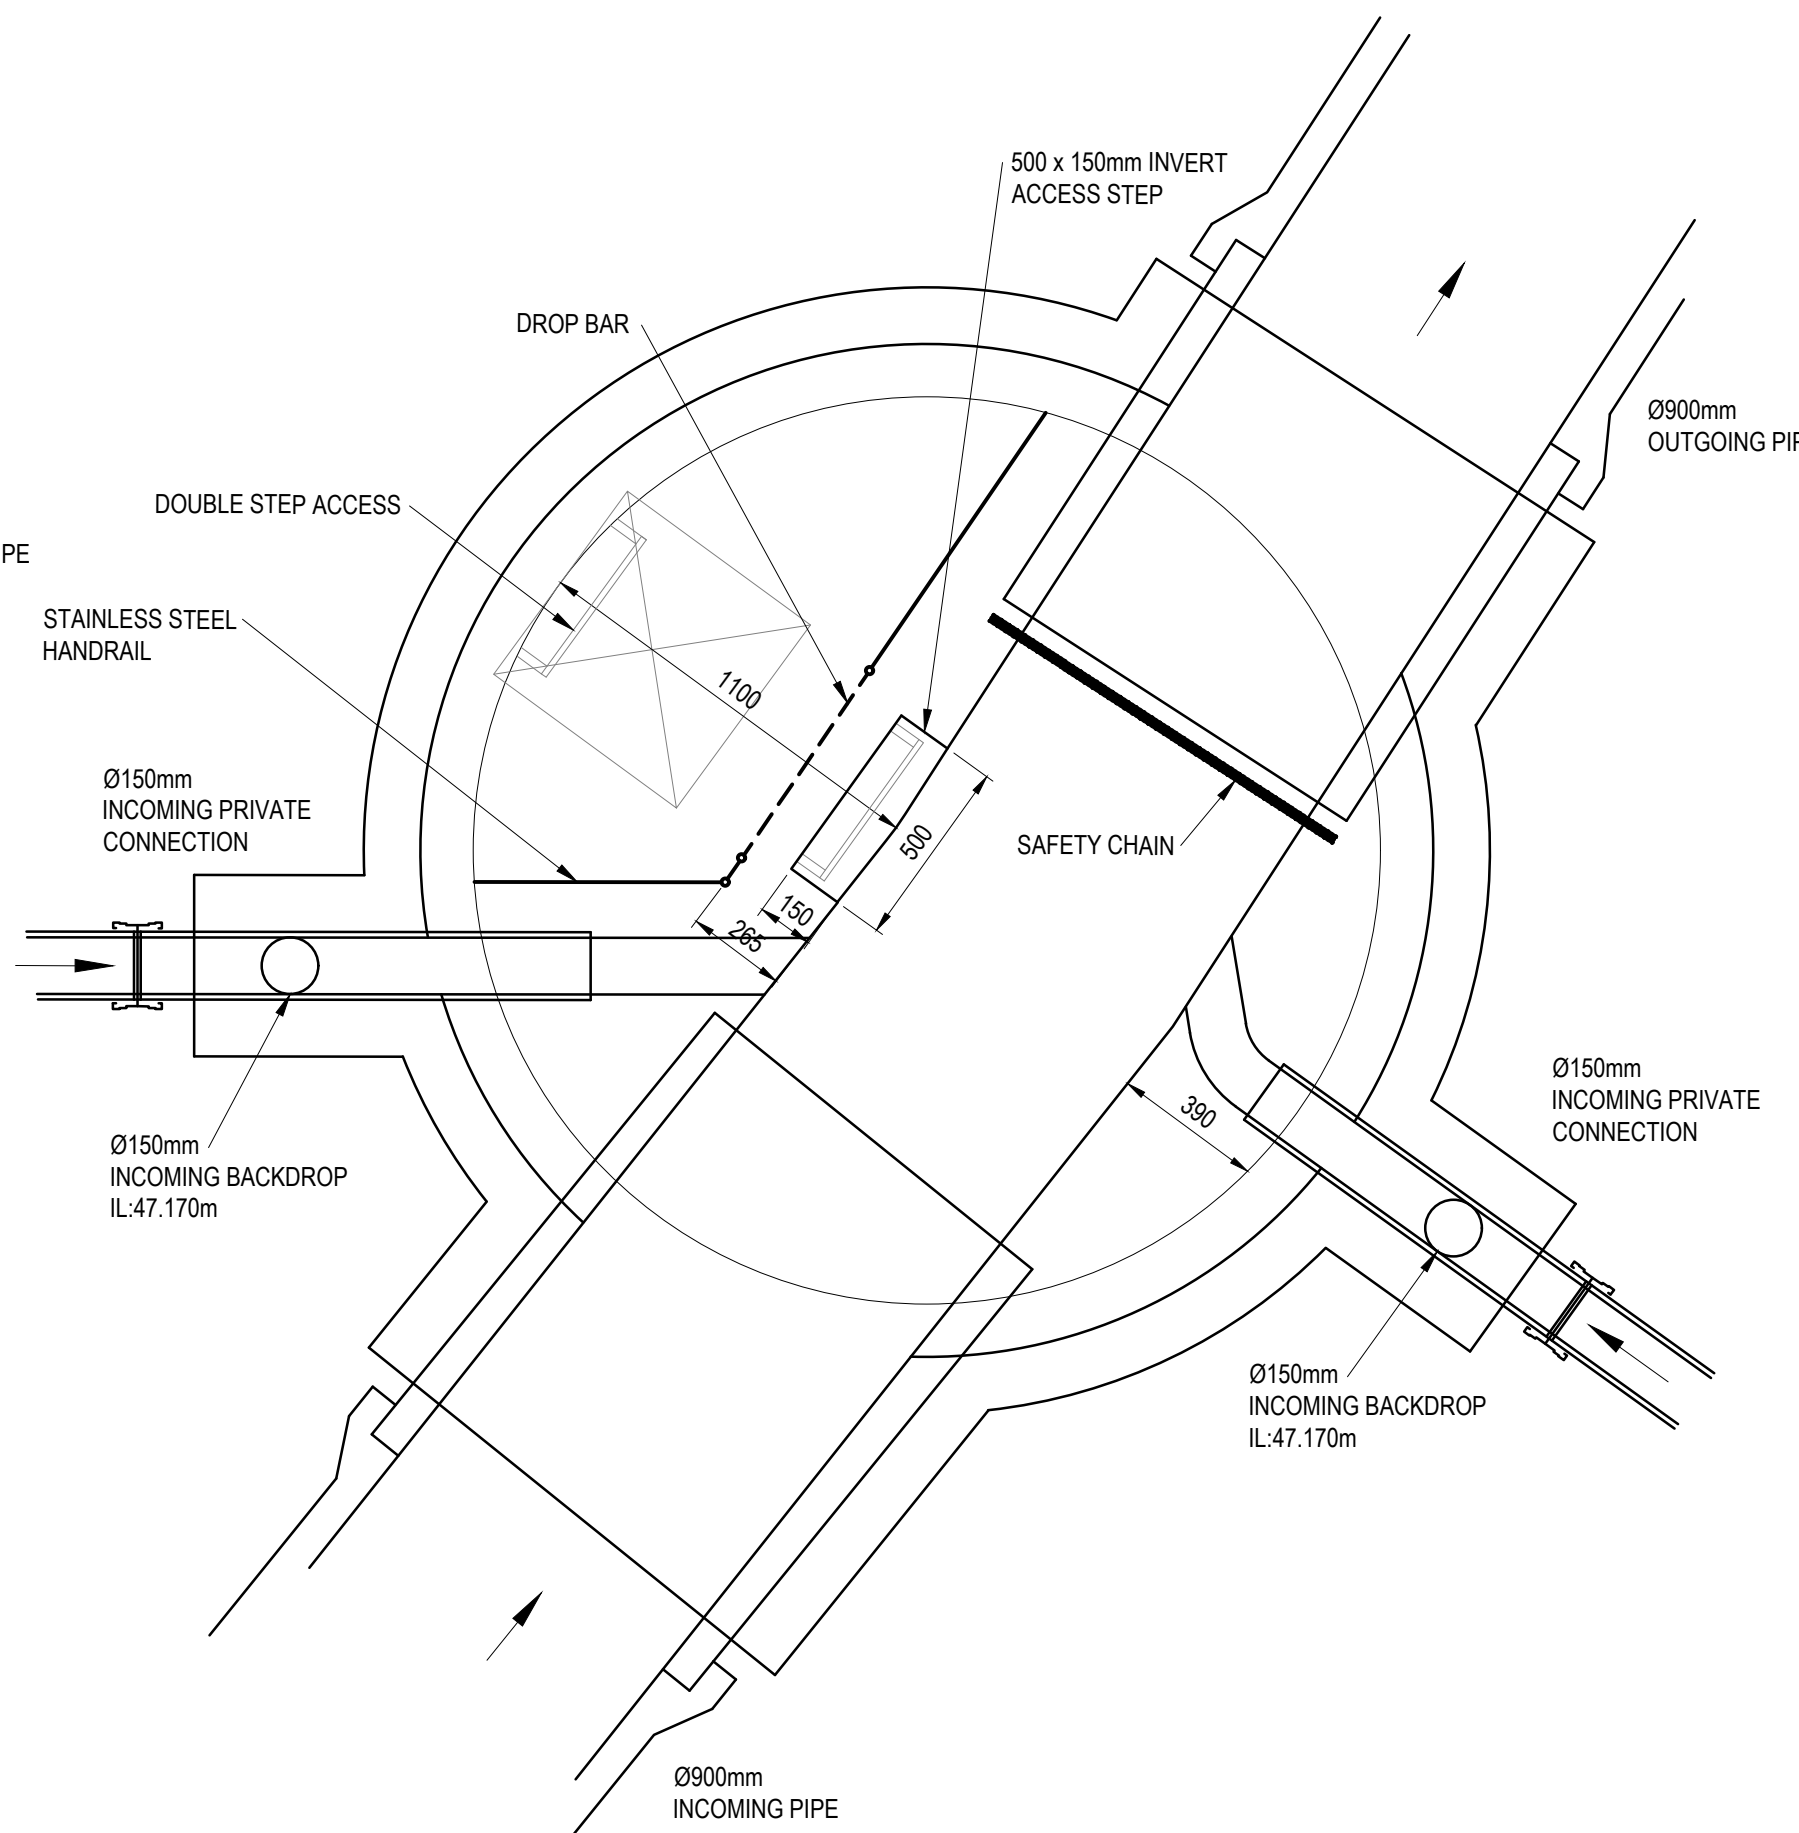


MANHOLE REF	SETTING OUT	COVER LEVEL	INVERT LEVEL	DEPTH TO SOFFIT	MANHOLE DIAMETER	MANHOLE COVER	MANHOLE TYPE	COVER SLAB OPENING
S9	E:381073.710 N:387680.575	48.981m	45.607m	2.474m	2,400m	600x600 D400 150mm DEEP	PCC TYPE 2	750x600

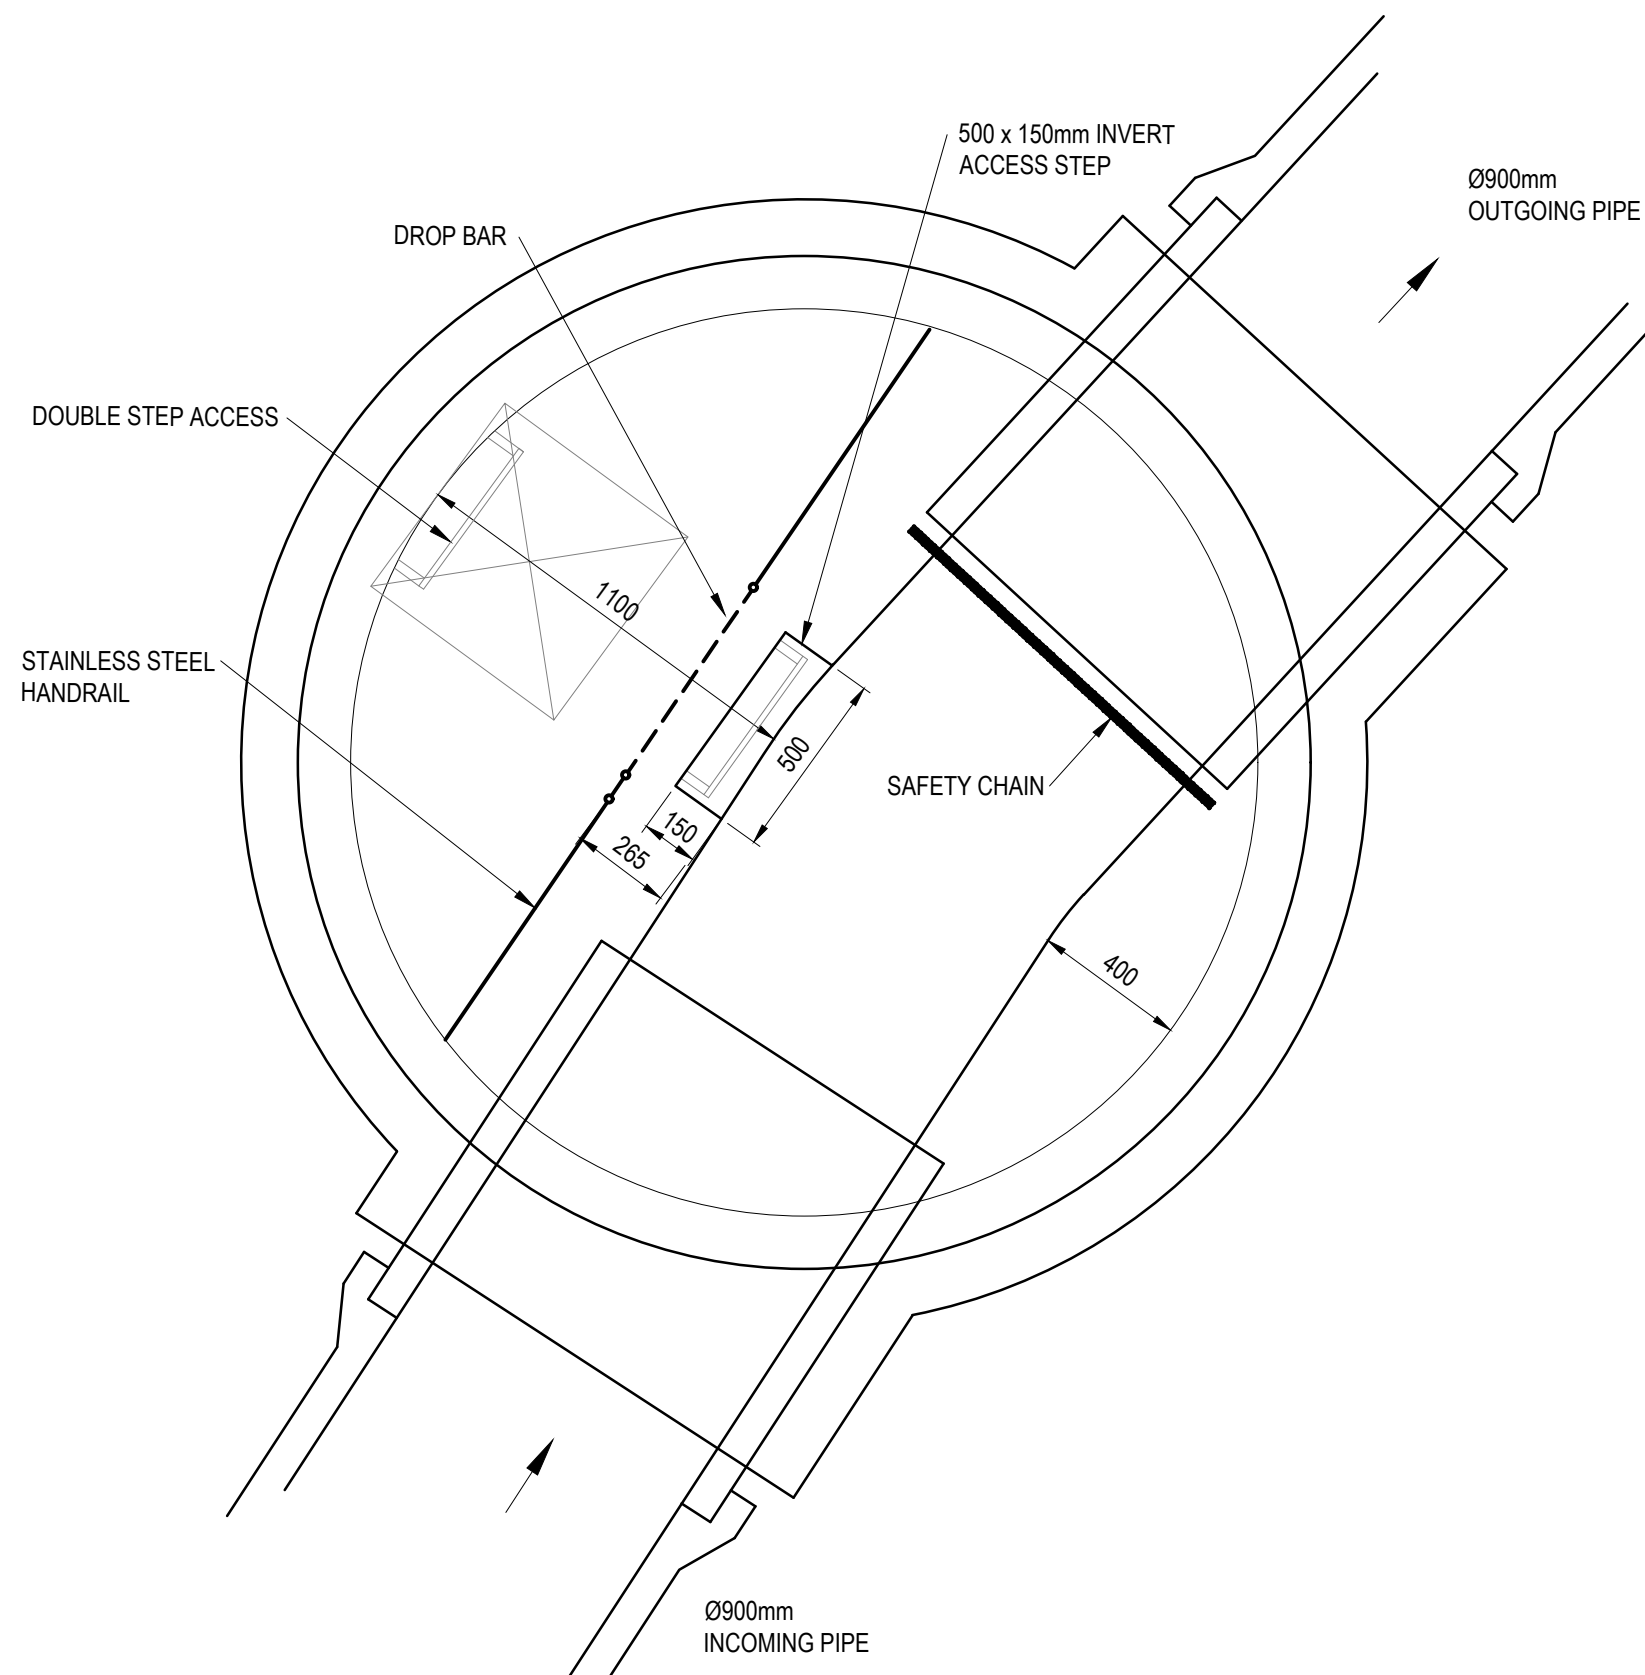


MANHOLE REF	SETTING OUT	COVER LEVEL	INVERT LEVEL	DEPTH TO SOFFIT	MANHOLE DIAMETER	MANHOLE COVER	MANHOLE TYPE	COVER SLAB OPENING
S10	E:381102.580 N:387718.350	48.612m	45.581m	2.131m	2,400m	600x600 D400 150mm DEEP	PCC TYPE 2	750x600

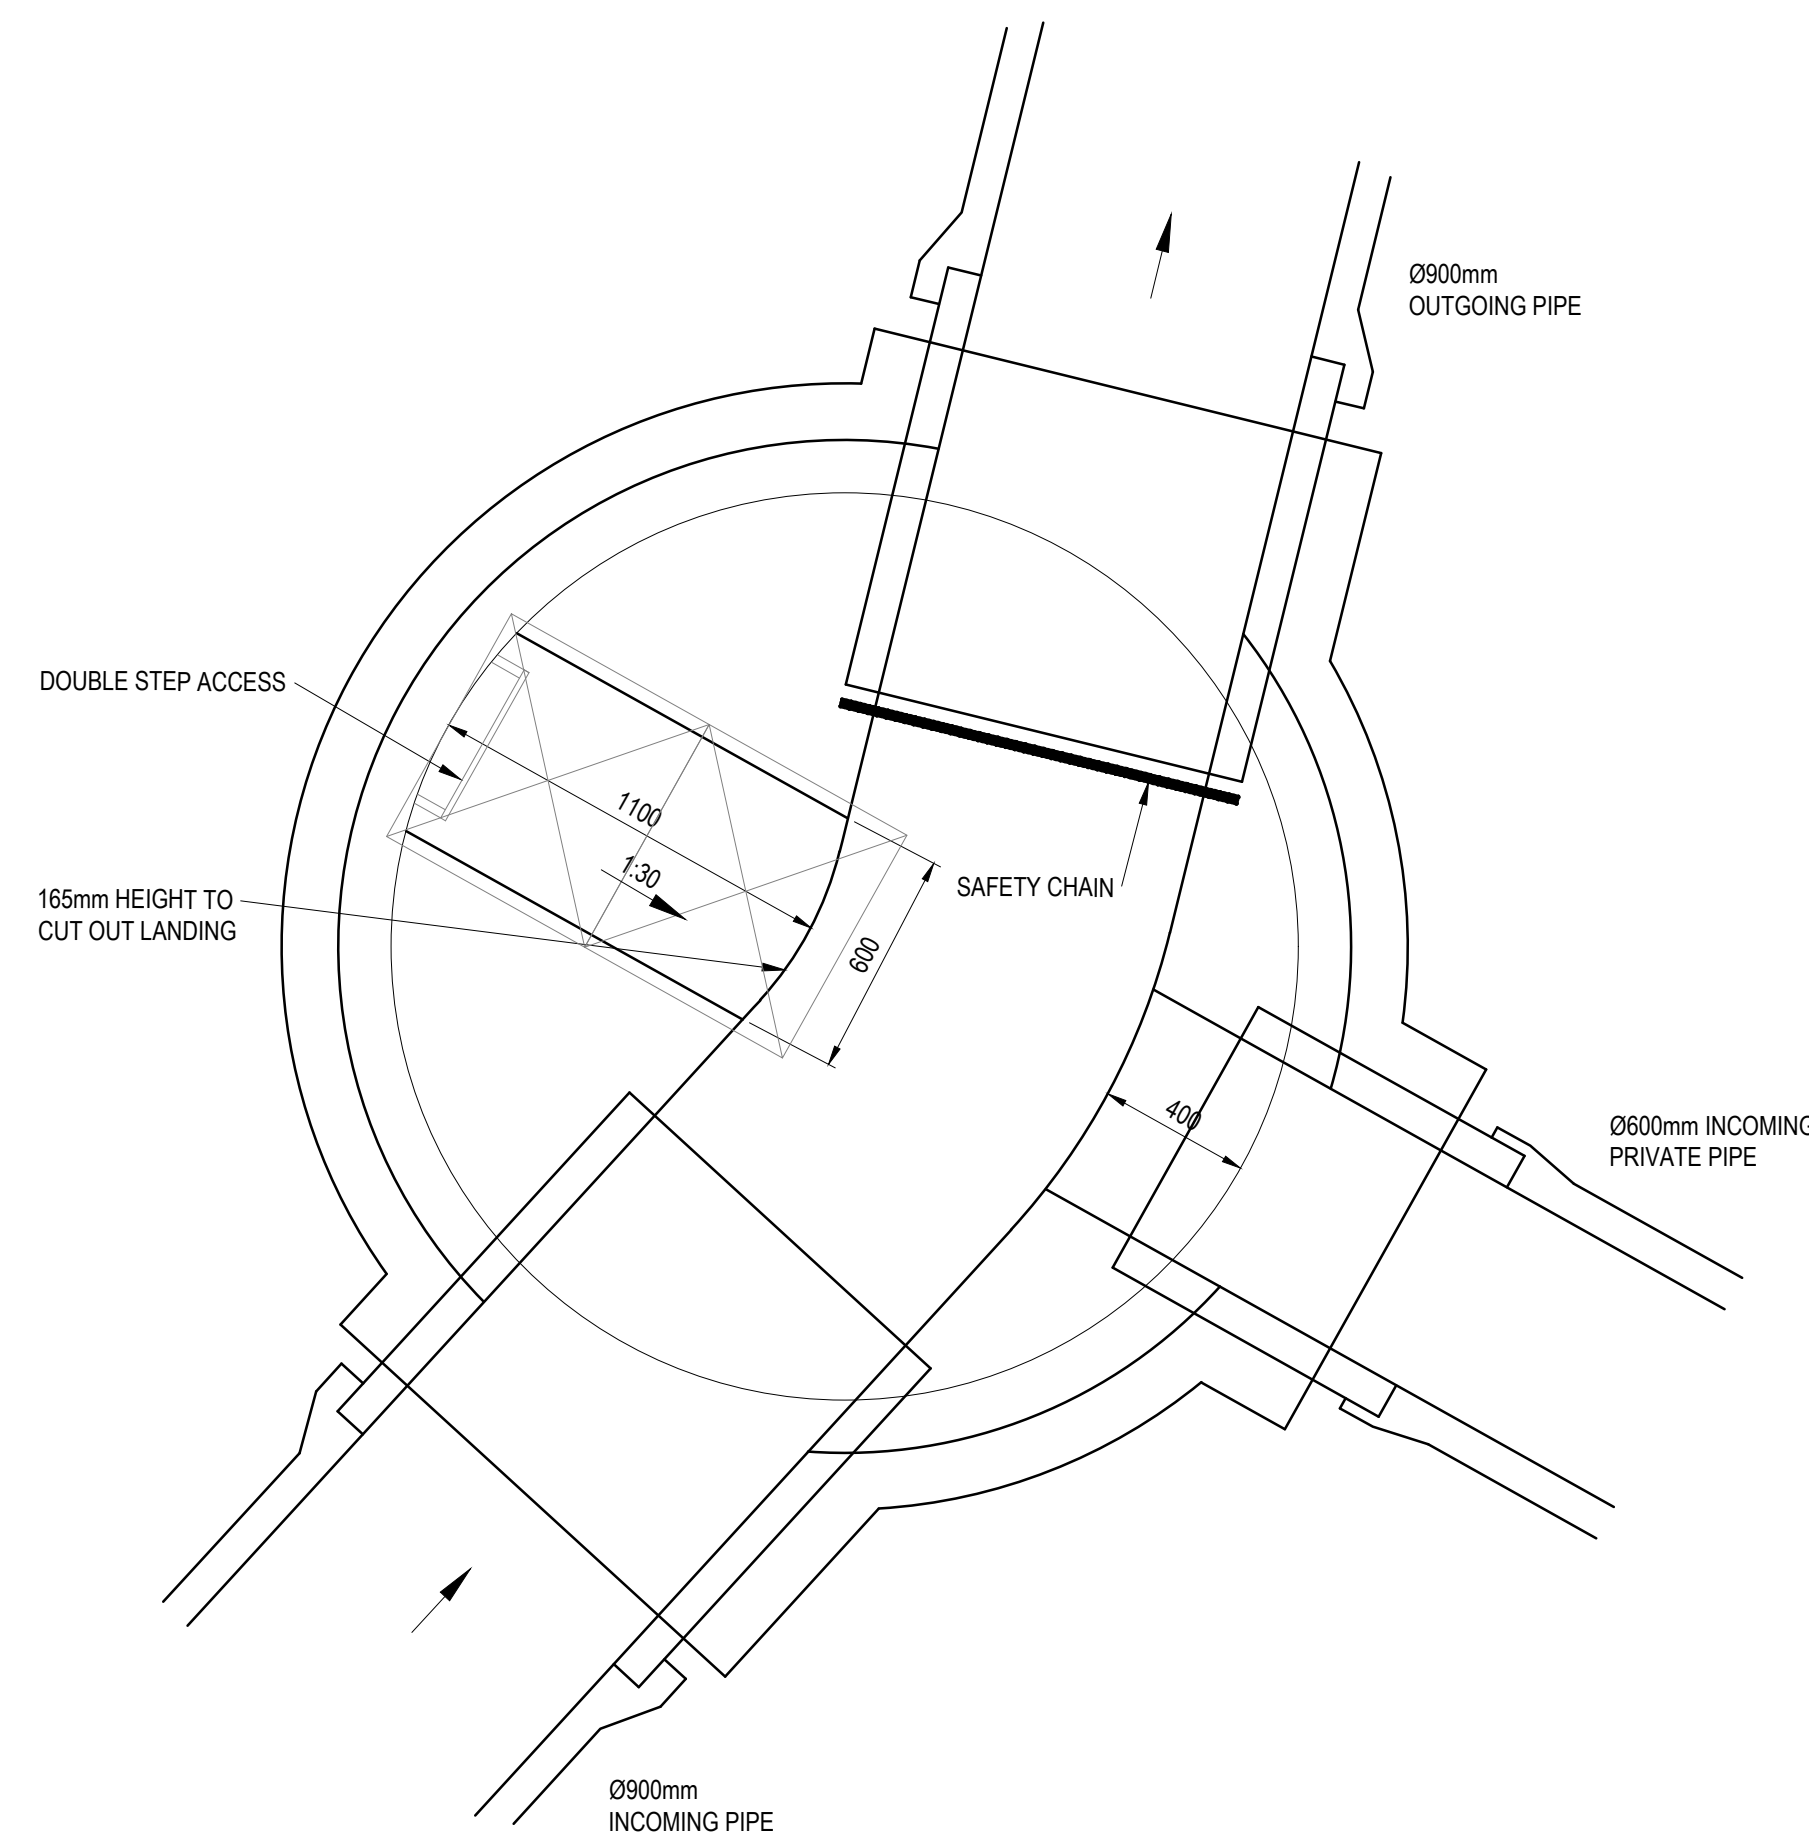

MANHOLE REF	SETTING OUT	COVER LEVEL	INVERT LEVEL	DEPTH TO SOFFIT	MANHOLE DIAMETER	MANHOLE COVER	MANHOLE TYPE	COVER SLAB OPENING
S11	E:381109.570 N:387726.035	47.848m	45.568m	1.380m	2,400m	1200x675 D400 150mm DEEP	PCC TYPE 4	1200x675

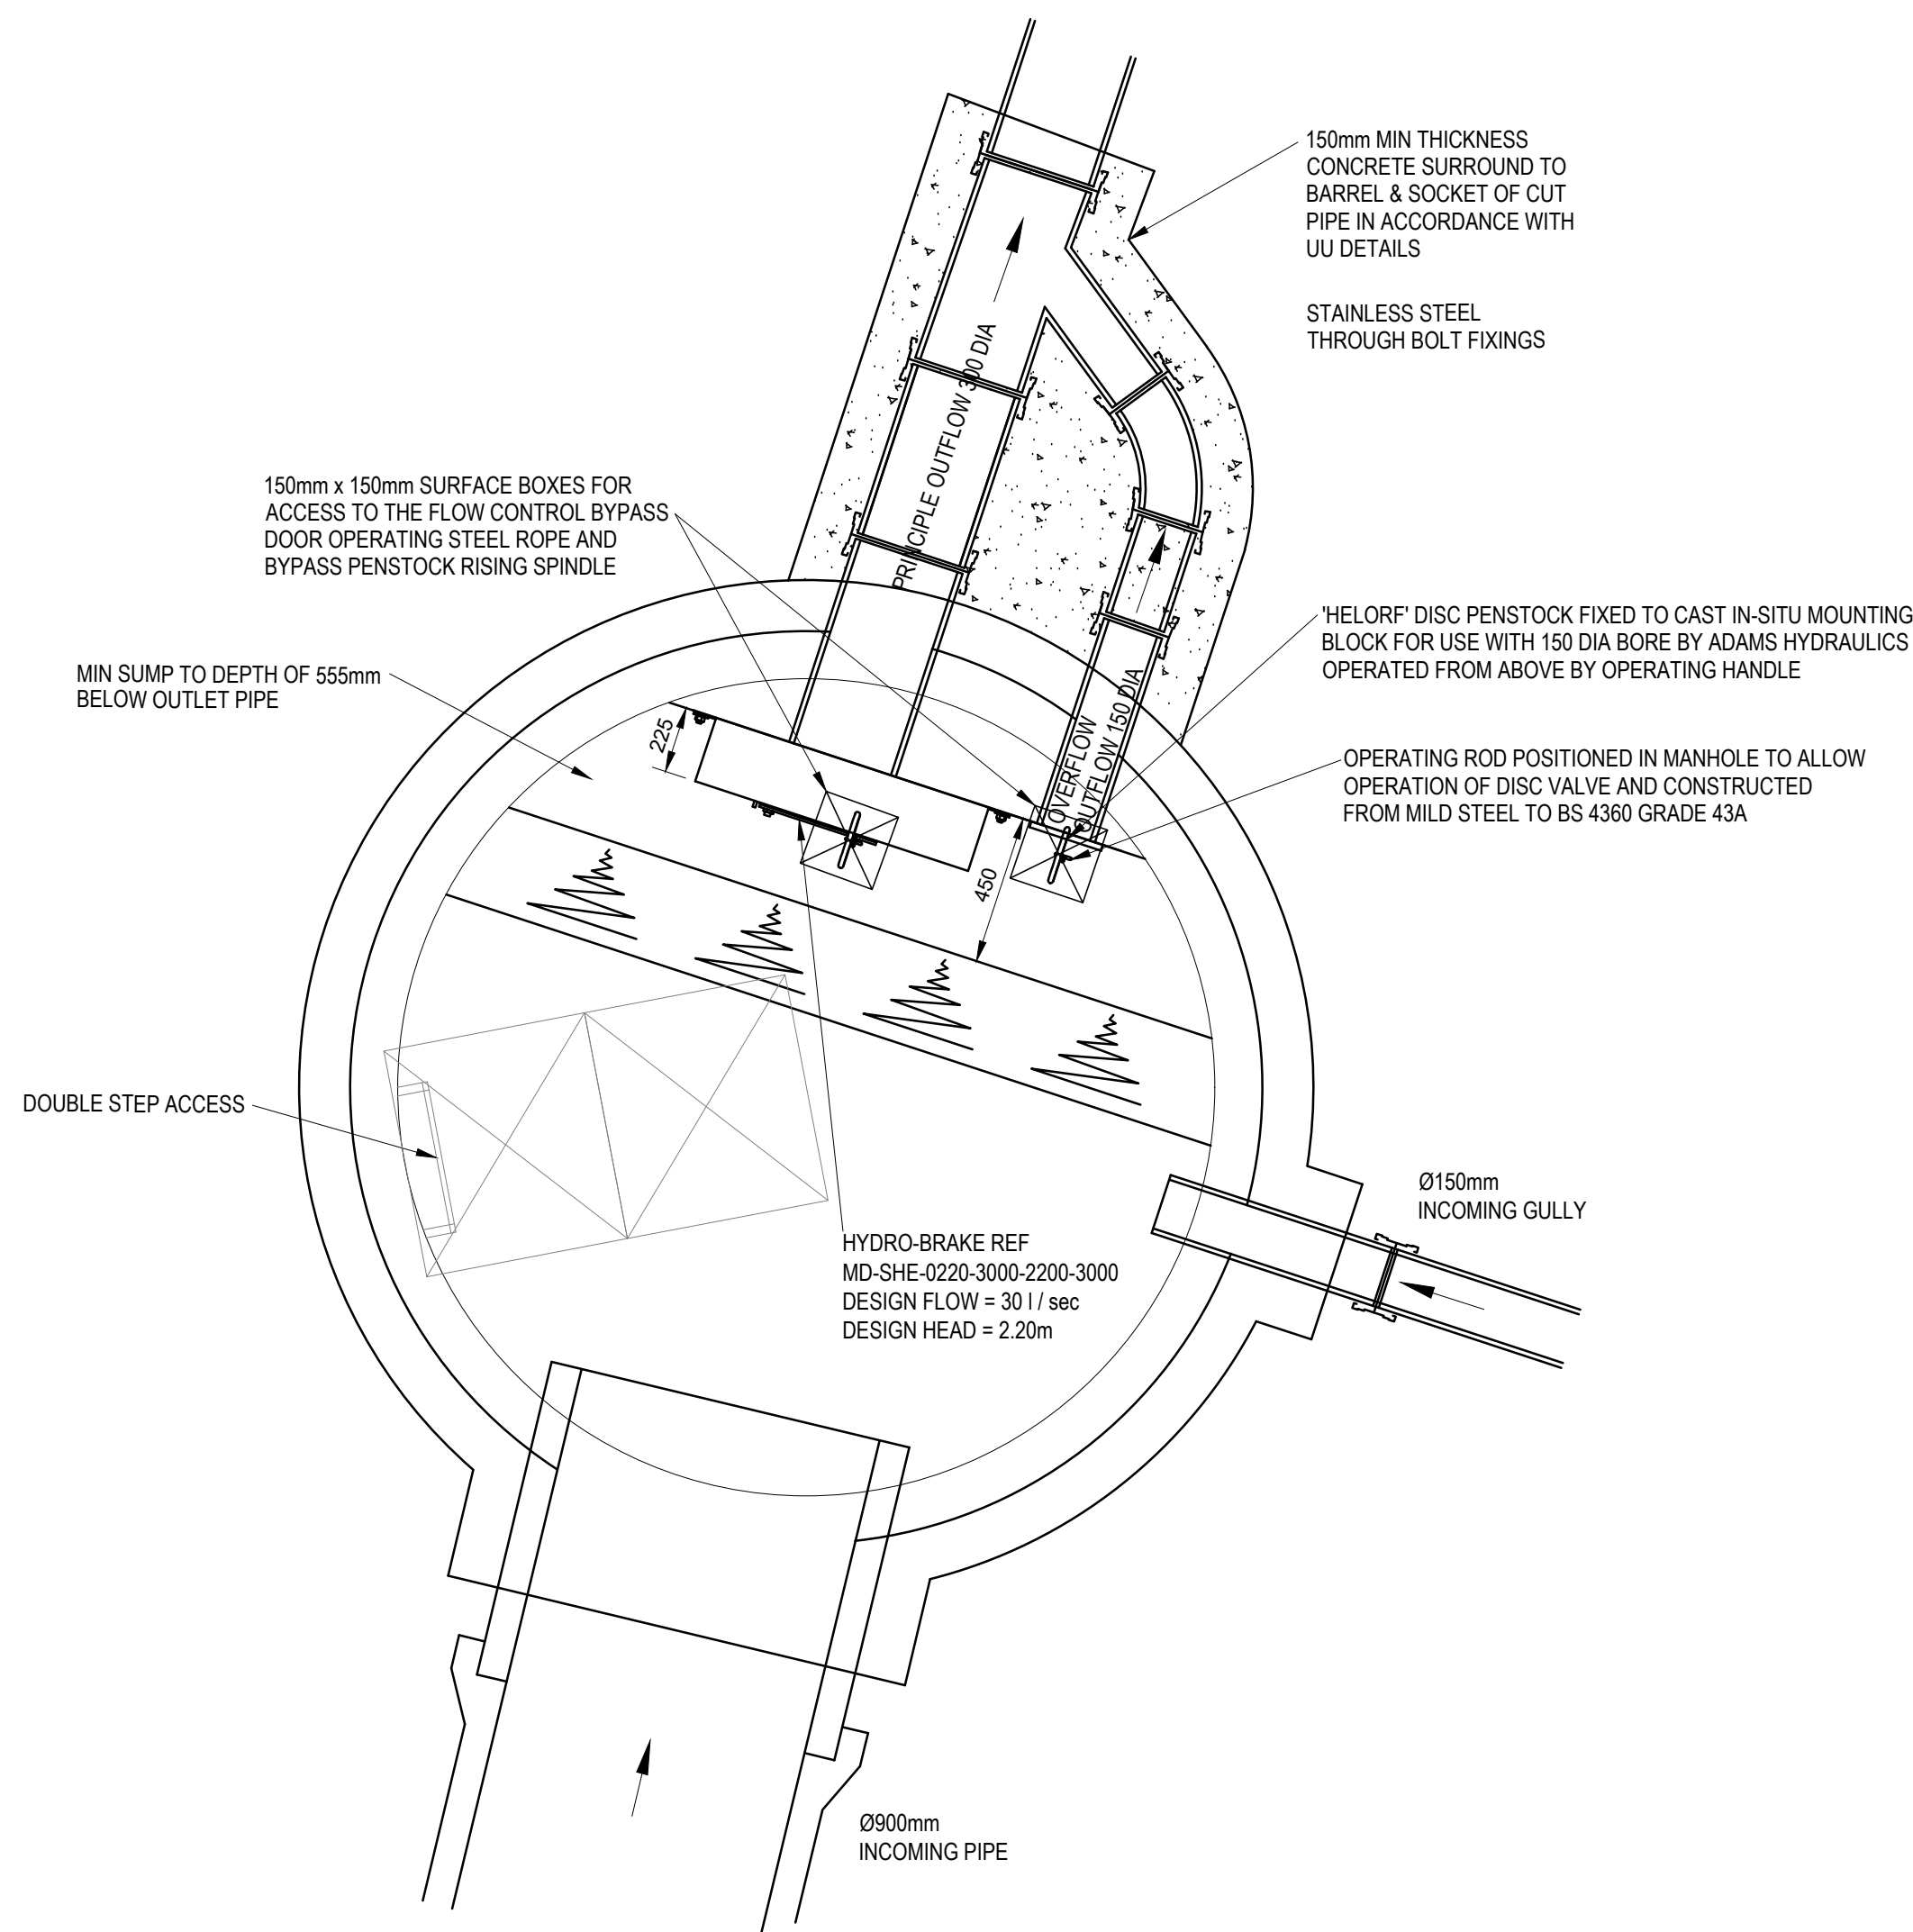

MANHOLE REF	SETTING OUT	COVER LEVEL	INVERT LEVEL	DEPTH TO SOFFIT	MANHOLE DIAMETER	MANHOLE COVER	MANHOLE TYPE	COVER SLAB OPENING
S12	E:381109.570 N:387726.035	47.788m	45.556m	1.332m	2,400m	1200x675 D400 150mm DEEP	FLOW CONTROL MH	1200x675

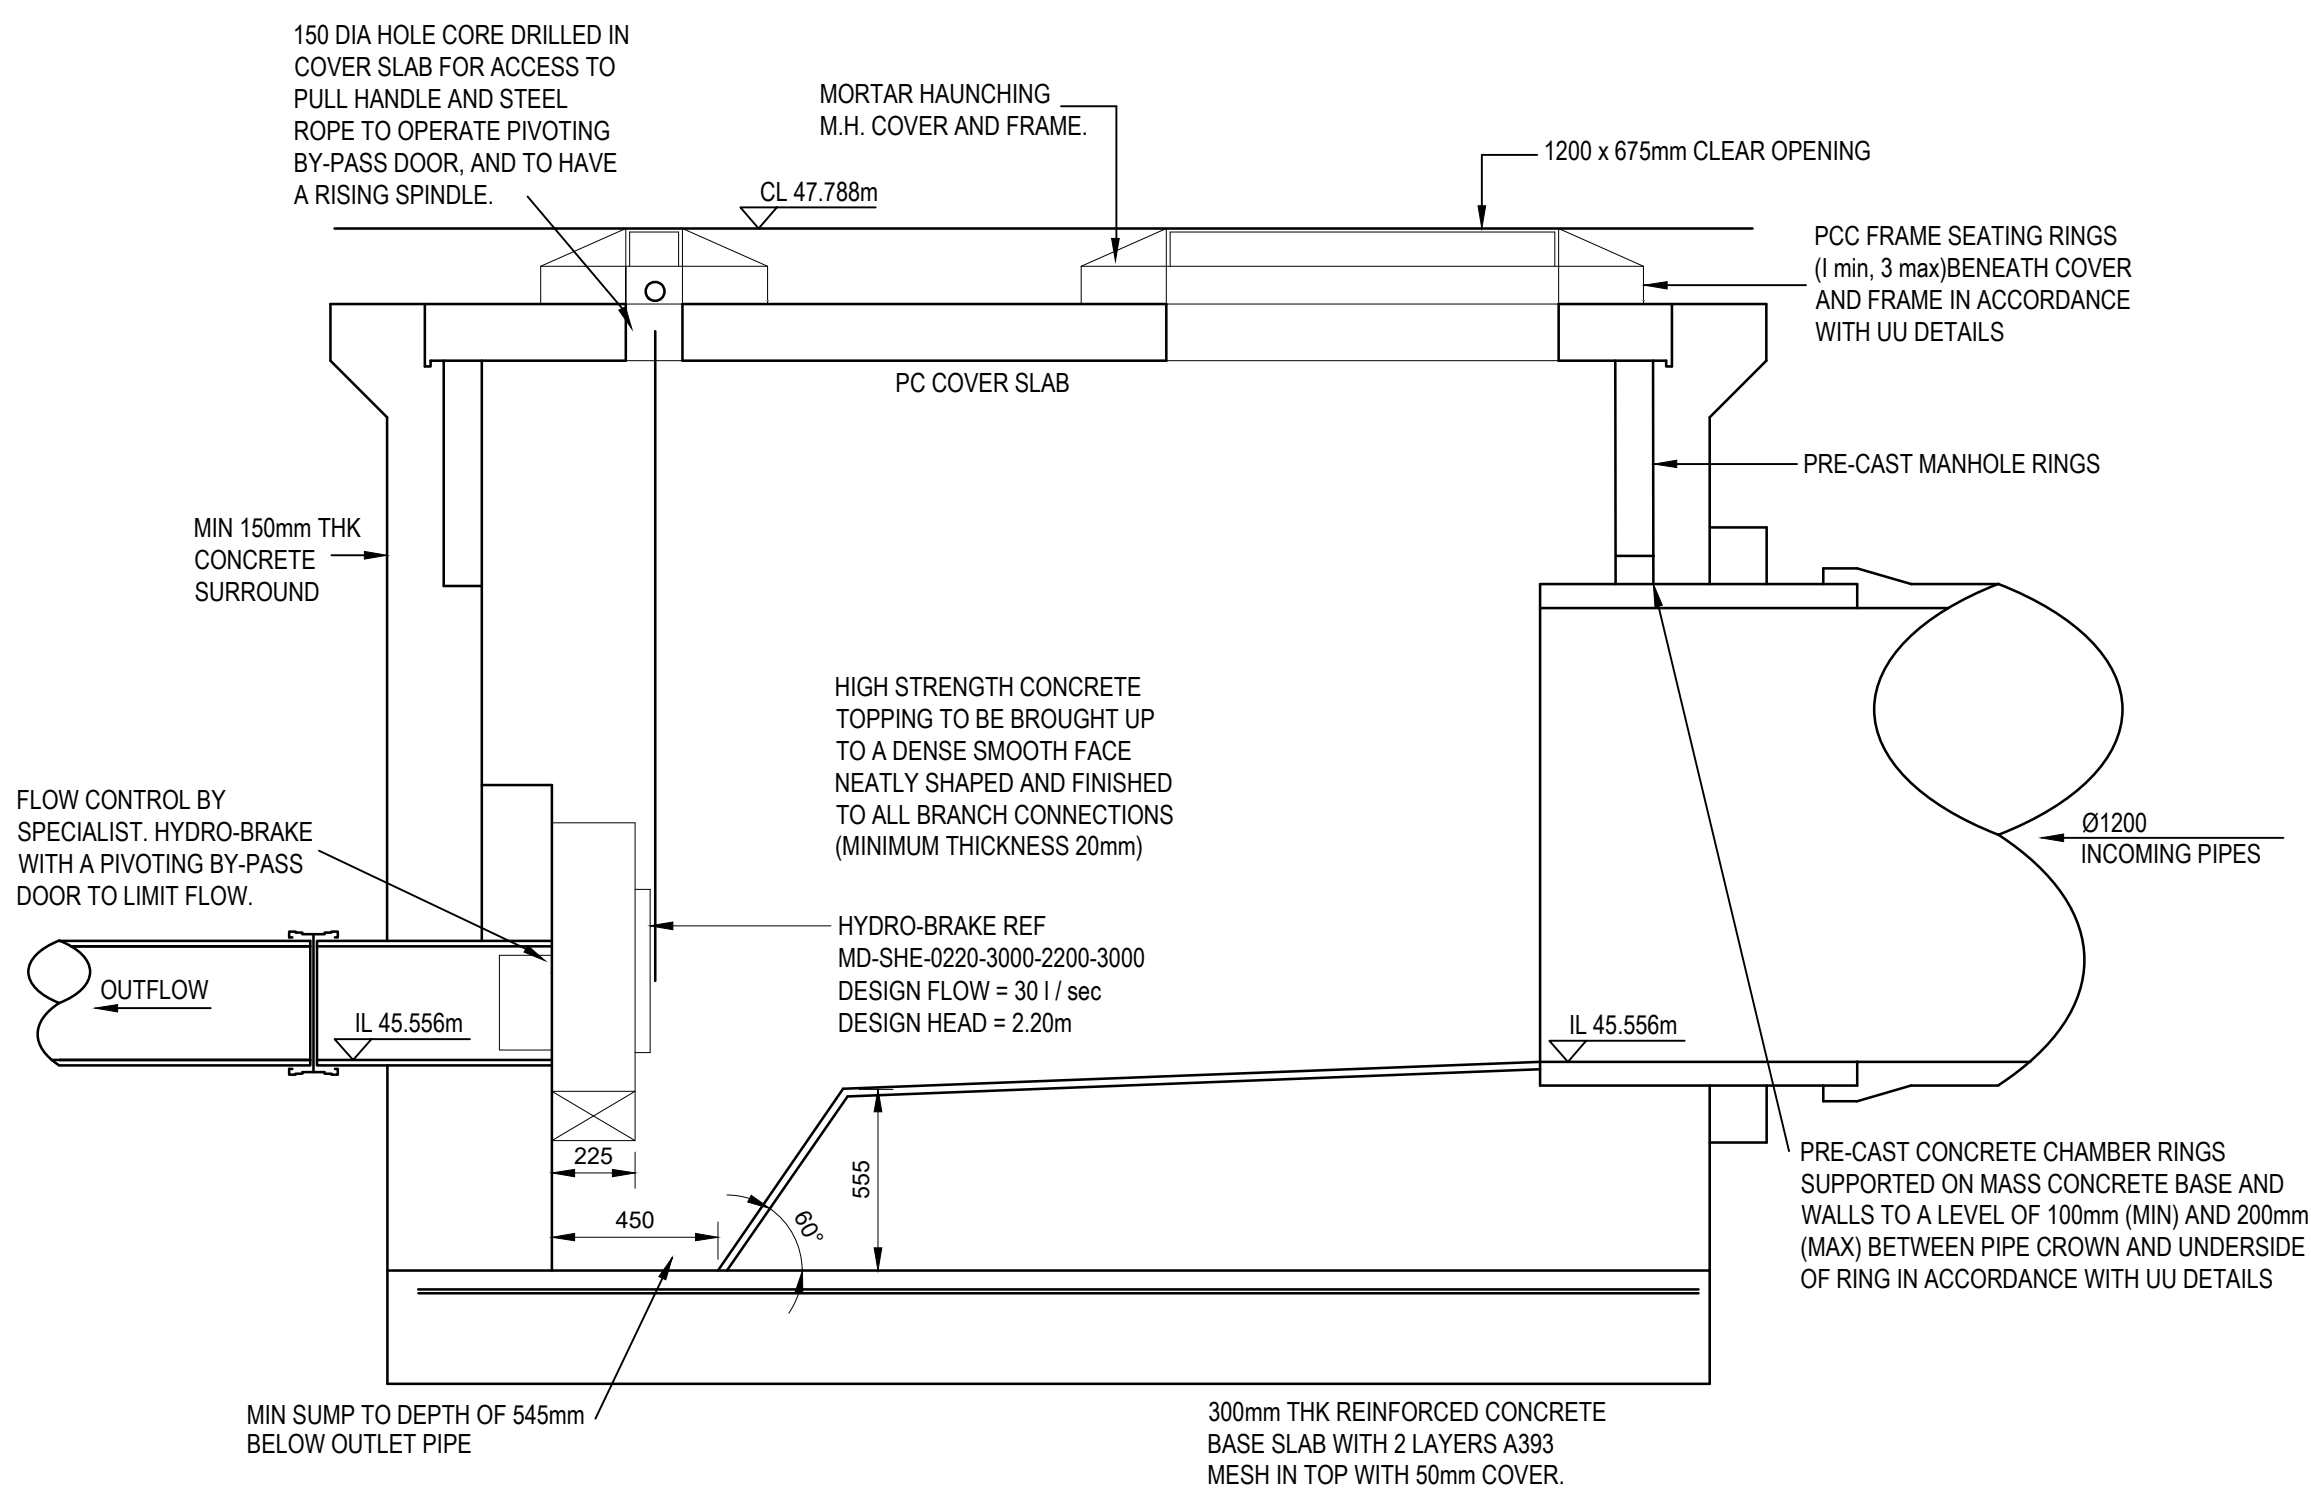

S12 - HYDRO-BRAKE SECTION

NOMINAL DIA. (mm)	EFFECTIVE LENGTH (m)
150 TO 600	0.6
675 TO 750	1.0
825 & OVER	1.25

WHERE LADDERS ARE USED, SEATING RINGS TO BE TURNED 180° TO ENSURE 600x900 ACCESS IS MAINTAINED WITH THE INCLUSION OF LADDERS.

ALL LATERAL CONNECTIONS TO BE MADE AT SOFFIT LEVEL TO THE MAIN CHANNEL.

FINAL CONSTRUCTION

WML DRAWINGS ARE FINAL CONSTRUCTION RECORD DRAWINGS INCORPORATING ANY AS-BUILT INFORMATION SUPPLIED BY THE CONTRACTOR

Rev	FINAL CONSTRUCTION ISSUE				Date	DB	LoG
R01	Amendment				11/01/24	DB	LoG
Project	GLENDENE, WYTHENSHAW						
Client	BTP ARCHITECTS						
Title	SECTION 104 - MANHOLE SCHEDULE SHEET 2 SURFACE WATER 2						
Drawn	DB	Checked	LoG	Date	SEPT 21	Scale	AS NOTED @ A0
WML CONSULTING Chartered Civil and Structural Engineers					No 8 Oak Green East Road Sutton Green Business Park Cheshire M66 9QJ Tel : 0161 482 0800 Fax : 0161 486 0210 e-mail info@wmlconsulting.com www.wmlconsulting.com		
Project	Originator	Volume	Level	Type	Role	Number	Rev
9003	- WML	- ZZ	- XX	DR	- C	- 1022	R01

SUBJECT TO APPROVAL FROM
AND UNITED UTILITIES