


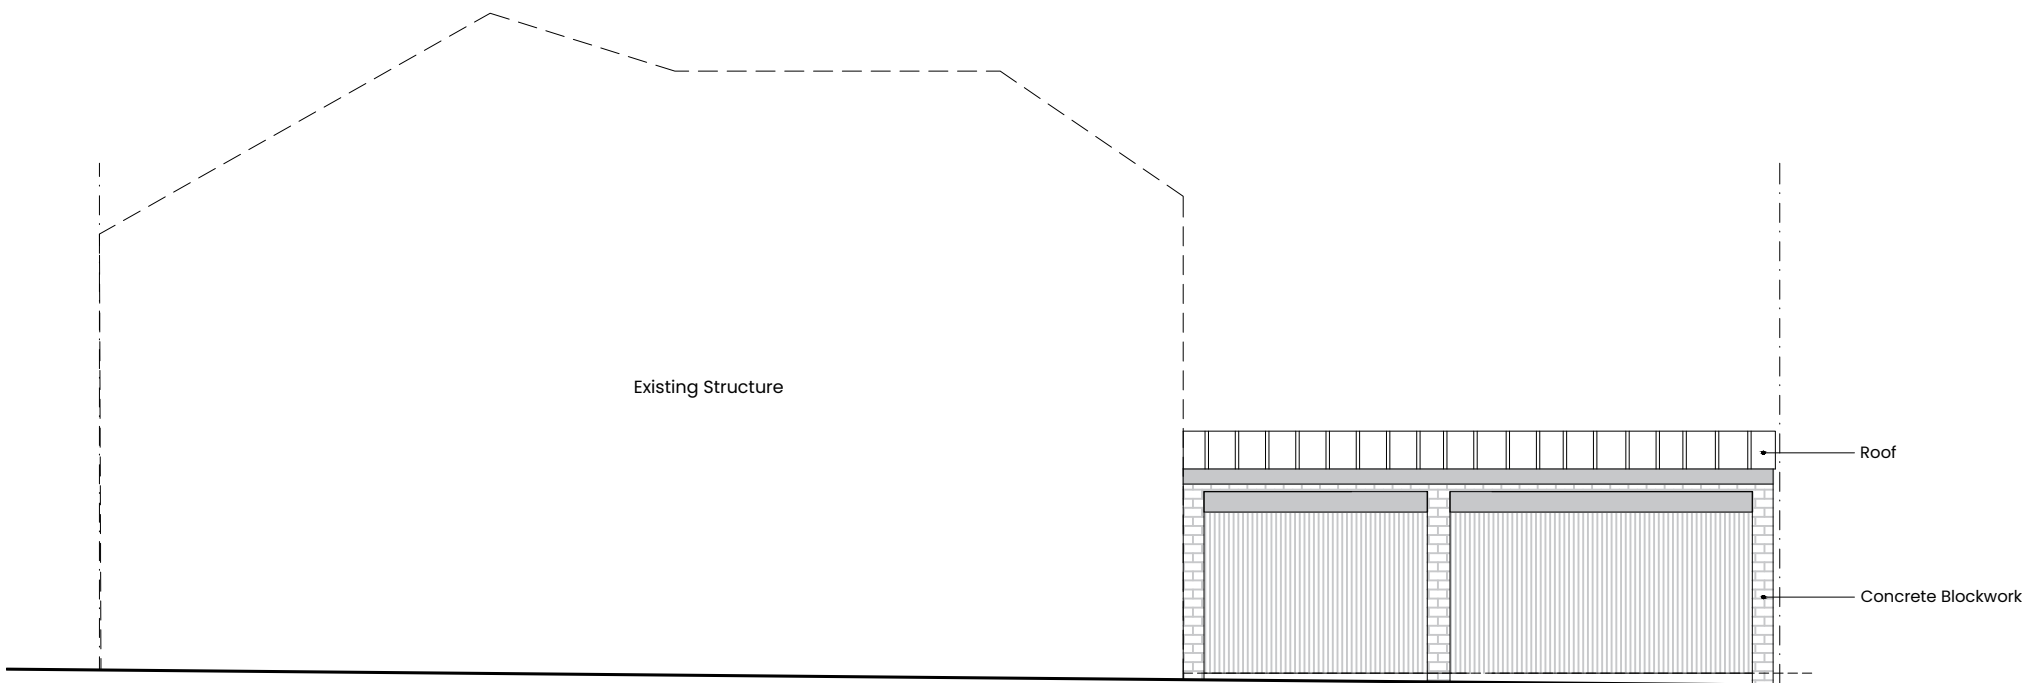

Existing GA Front Elevation (As Built)
Scale 1:100 @ A3



SCALE BAR 1:100


General Notes:

All site dimensions shall be verified by the Contractor on site prior to commencing any works.

Do not scale from this drawing.


Design intent drawing only. Construction to comply with latest building regulation requirements.

This drawing is the property of "Studio Tashkeel Architecture Ltd." and copyright is reserved by them. The drawing is not to be copied or disclosed by or to any unauthorised persons without the prior written consent of Studio Tashkeel Architecture Ltd.

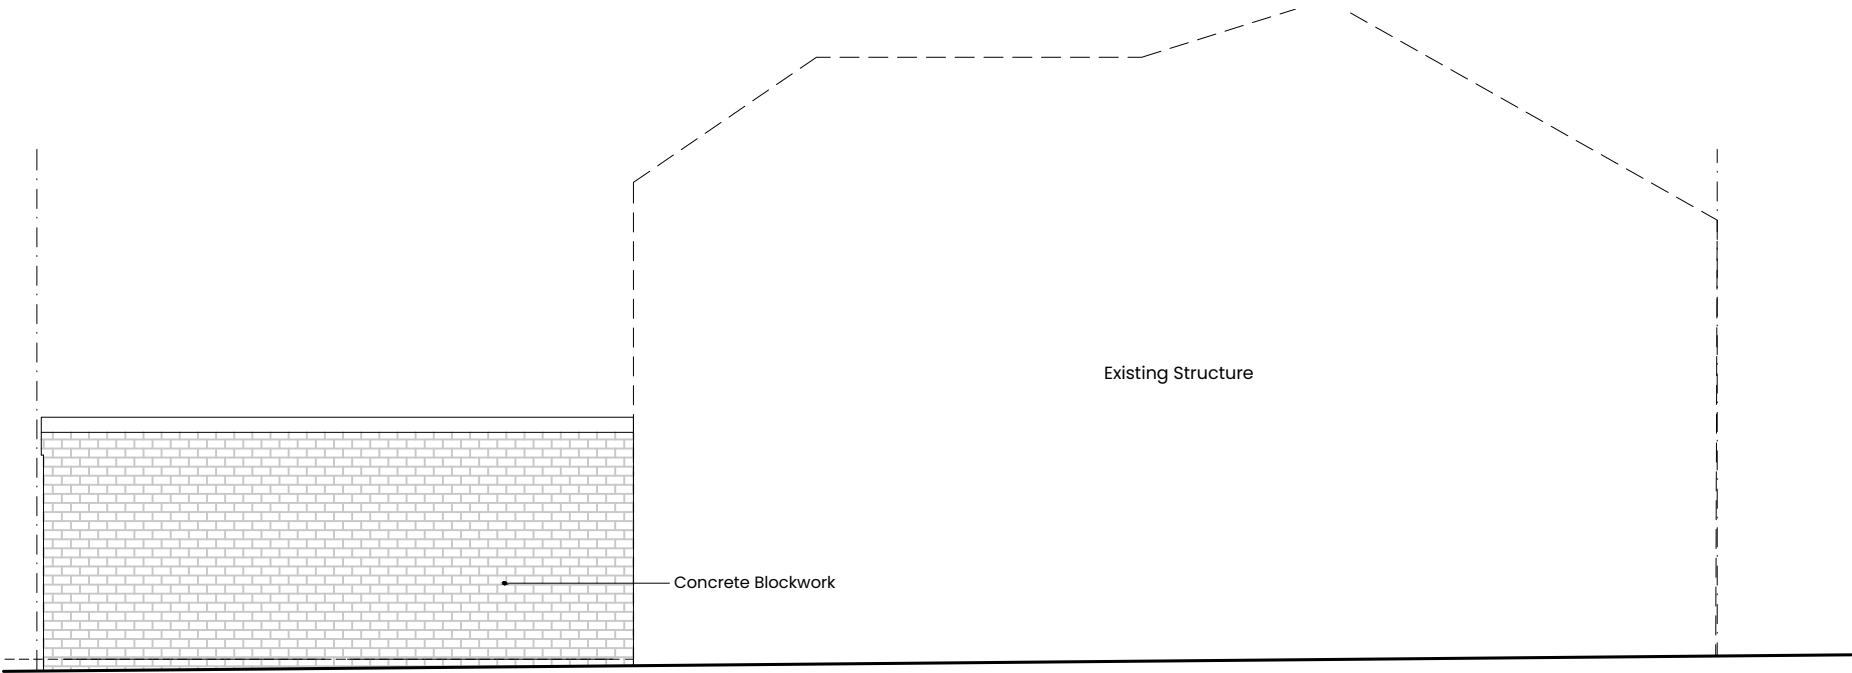

Existing GA Rear Elevation (As Built)
Scale 1:100 @ A3

-	First Issue	02.05.2024	SM	MK
Rev	Description	Date	Dr by	App by

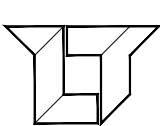

STUDIO TASHKEEL
ARCHITECTURE LTD.
89 Princess Street
Manchester M1 4HT
United Kingdom

T +44(0)161 694 6375
E info@StudioTashkeel.com
www.studiotashkeel.com

client name		
Mr Mohammed Abbas		
project		
461 Cheetham Hill Rd, M8 9PA		
drawing		
As Built Elevations A		
project number		scale
23_151		1:100 @ A3
drawing number	rev	issue status
PL_003	-	Planning
This drawing is to be read in conjunction with all related drawings. All dimensions must be checked and verified on site before commencing any work or producing shop drawings. The originator should be notified immediately of any discrepancy. This drawing is copyright and remains the property of Studio Tashkeel Architecture Ltd.		