






01 Location Plan
Scale 1:1250 @ A3

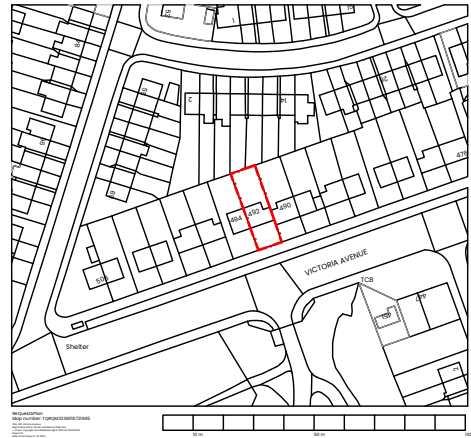


02 Existing Boundary Treatment Site Plan
Scale 1:200 @ A3

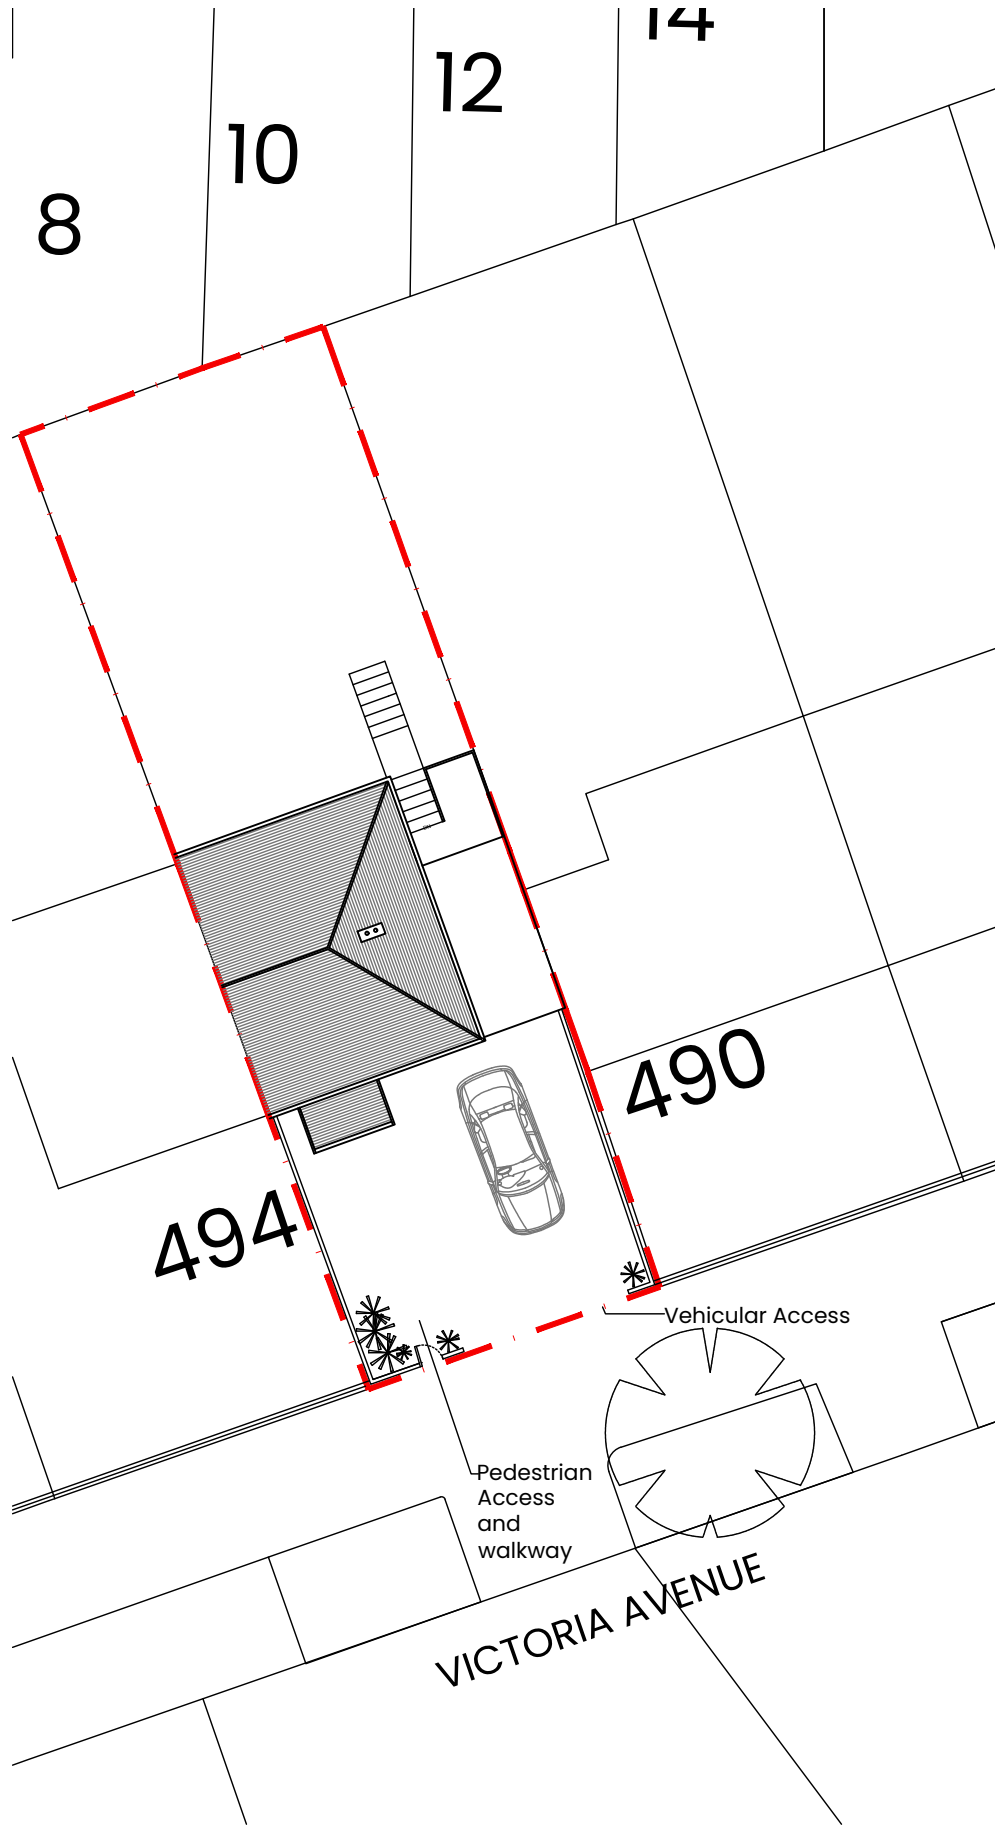

03 As-Built Boundary Treatment Site Plan
Scale 1:200 @ A3

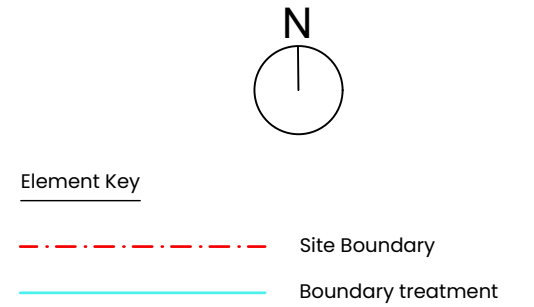

SCALE BAR 1:200

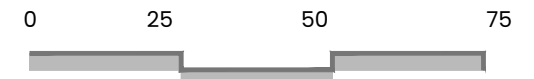

SCALE BAR 1:1250

General Notes:

All site dimensions shall be verified by the Contractor on site prior to commencing any works.


Do not scale from this drawing.

Design intent drawing only. Construction to comply with latest building regulation requirements.

All statutory approvals must be sought prior to development.

This drawing is the property of "Studio Tashkeel Architecture Ltd." and copyright is reserved by them. The drawing is not to be copied or disclosed by or to any unauthorised persons without the prior written consent of Studio Tashkeel Architecture Ltd.

A	As per planning officer comments First Issue	22/05/24 19/04/2024	AM AM	MK MK
Rev	Description	Date	Dr by	App by

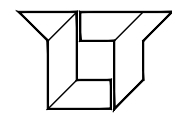

**STUDIO TASHKEEL
ARCHITECTURE LTD.**
89 Princess Street
Manchester M1 4HT
United Kingdom
T +44(0)161 694 6375
E info@StudioTashkeel.com
www.studiotashkeel.com

client name		
Mr & Mrs Kayani		
project		
492 Victoria Avenue, M9 0PL		
drawing		
Location and Site Plan		
project number		scale
24_153		varies @ A3
drawing number	rev	issue status
PL01	A	Planning

This drawing is to be read in conjunction with all related drawings. All dimensions must be checked and verified on site before commencing any work or producing shop drawings. The originator should be notified immediately of any discrepancy. This drawing is copyright and remains the property of Studio Tashkeel Architecture Ltd.