



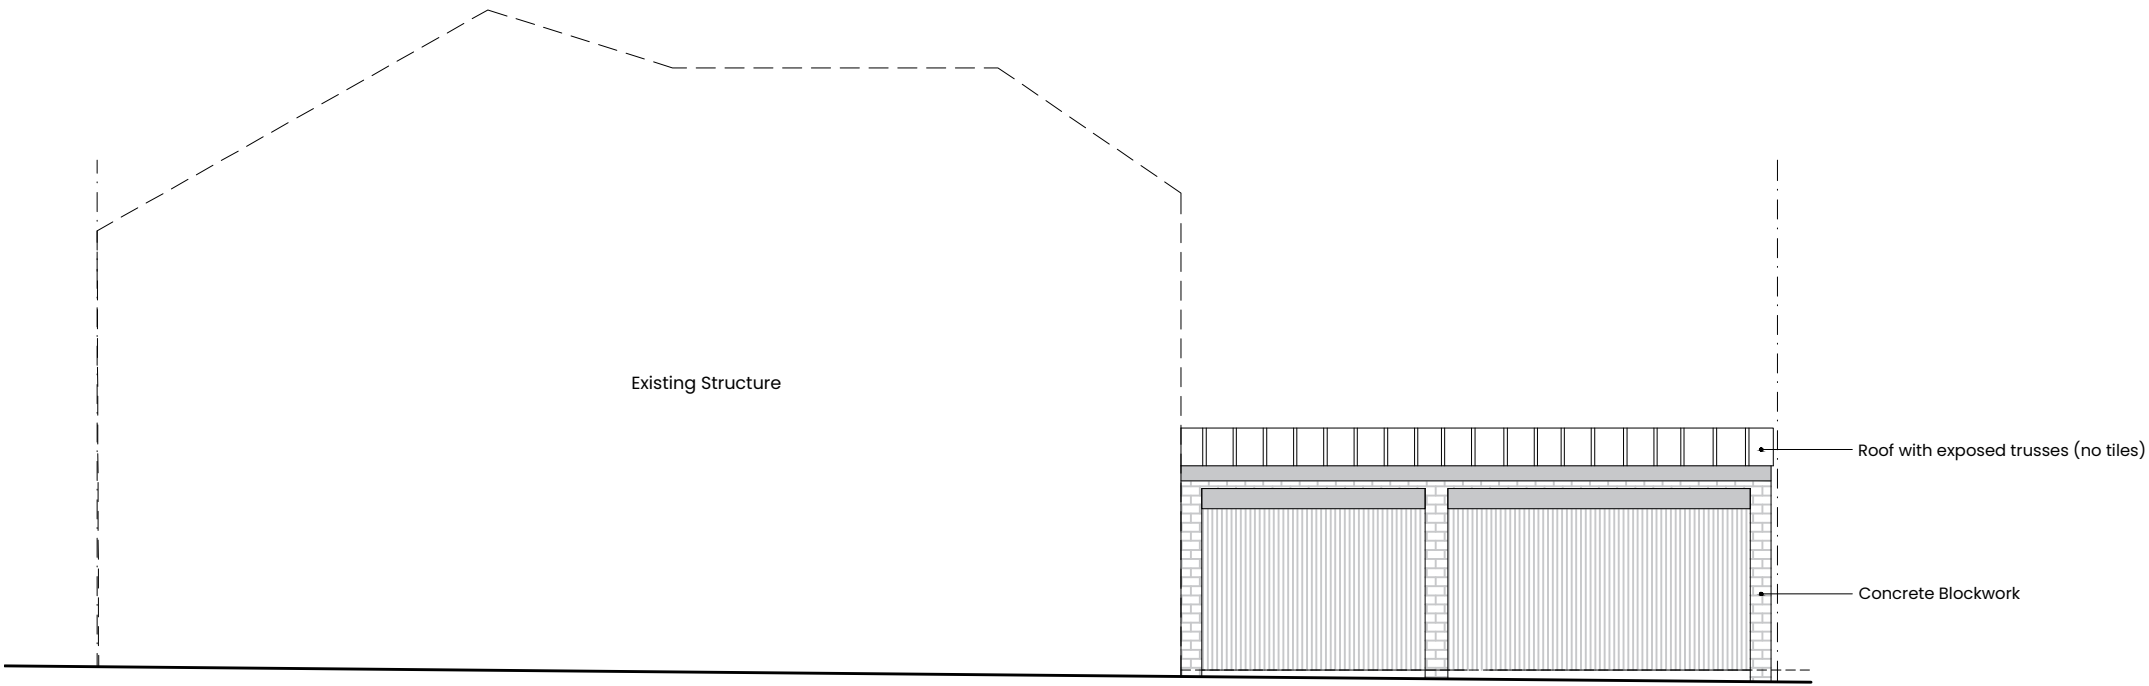

Existing GA Front Elevation (As Built)  
Scale 1:100 @ A3

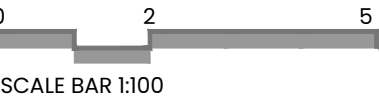


**General Notes:**

All site dimensions shall be verified by the Contractor prior to commencing any works.

Do not scale from this drawing.


Design intent drawing only. Construction to comply with latest building regulation requirements.

This drawing is the property of "Studio Tashkeel Architecture Ltd." and copyright is reserved by the firm. It is not to be copied or disclosed by or to any unauthorised persons without the prior written consent of Studio Tashkeel Architecture Ltd.

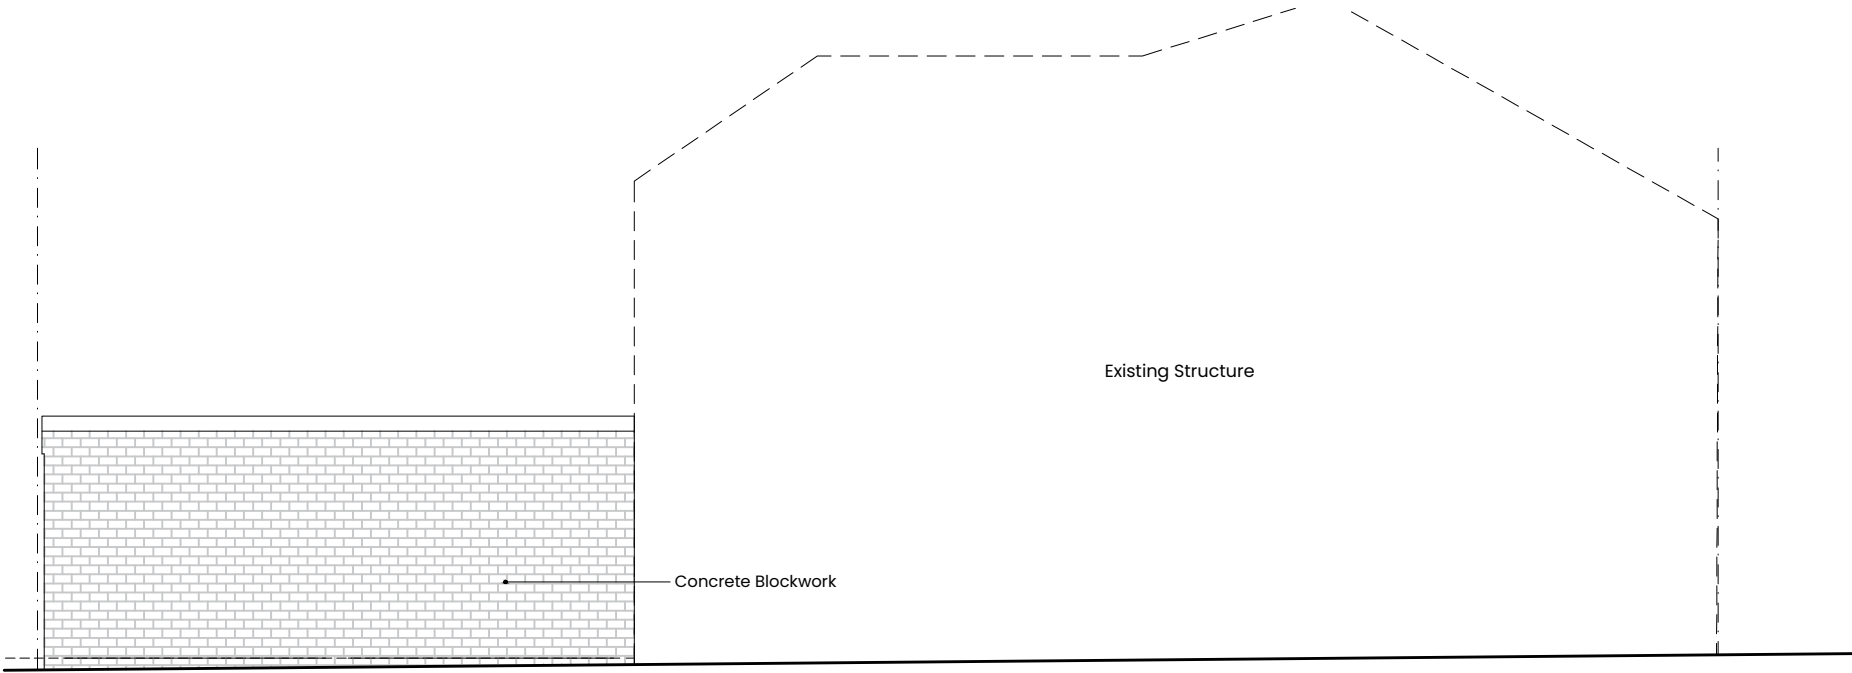

Existing GA Rear Elevation (As Built)  
Scale 1:100 @ A3

|     |             |            |       |          |
|-----|-------------|------------|-------|----------|
|     |             |            |       |          |
| -   | First Issue | 12.01.2024 | SM    | MK       |
| Rev | Description | Date       | Dr by | App'd by |

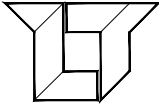

**STUDIO TASHKEEL  
ARCHITECTURE LTD.**  
89 Princess Street  
Manchester M1 4HT  
United Kingdom

T +44(0)161 694 6375  
E info@StudioTashkeel.com  
www.studiotashkeel.com

|                                                                                                                                                                                                                                                                                                                                                         |                            |                                 |
|---------------------------------------------------------------------------------------------------------------------------------------------------------------------------------------------------------------------------------------------------------------------------------------------------------------------------------------------------------|----------------------------|---------------------------------|
| <b>client name</b><br>Mr Mohammed Abbas                                                                                                                                                                                                                                                                                                                 |                            |                                 |
| <b>project</b><br>461 Cheetham Hill Rd, M8 9PA                                                                                                                                                                                                                                                                                                          |                            |                                 |
| <b>drawing</b><br>As Built Elevations A                                                                                                                                                                                                                                                                                                                 |                            |                                 |
| <b>project number</b><br>23_151                                                                                                                                                                                                                                                                                                                         | <b>scale</b><br>1:100 @ A3 |                                 |
| <b>drawing number</b><br>PL_003                                                                                                                                                                                                                                                                                                                         | <b>rev</b><br>-            | <b>issue status</b><br>Planning |
| <small>This drawing is to be read in conjunction with all related drawings. All dimensions must be checked and verified on site before commencing any work or producing shop drawings. The originator should be notified immediately of any discrepancy. This drawing is copyright and remains the property of Studio Tashkeel Architecture Ltd</small> |                            |                                 |