




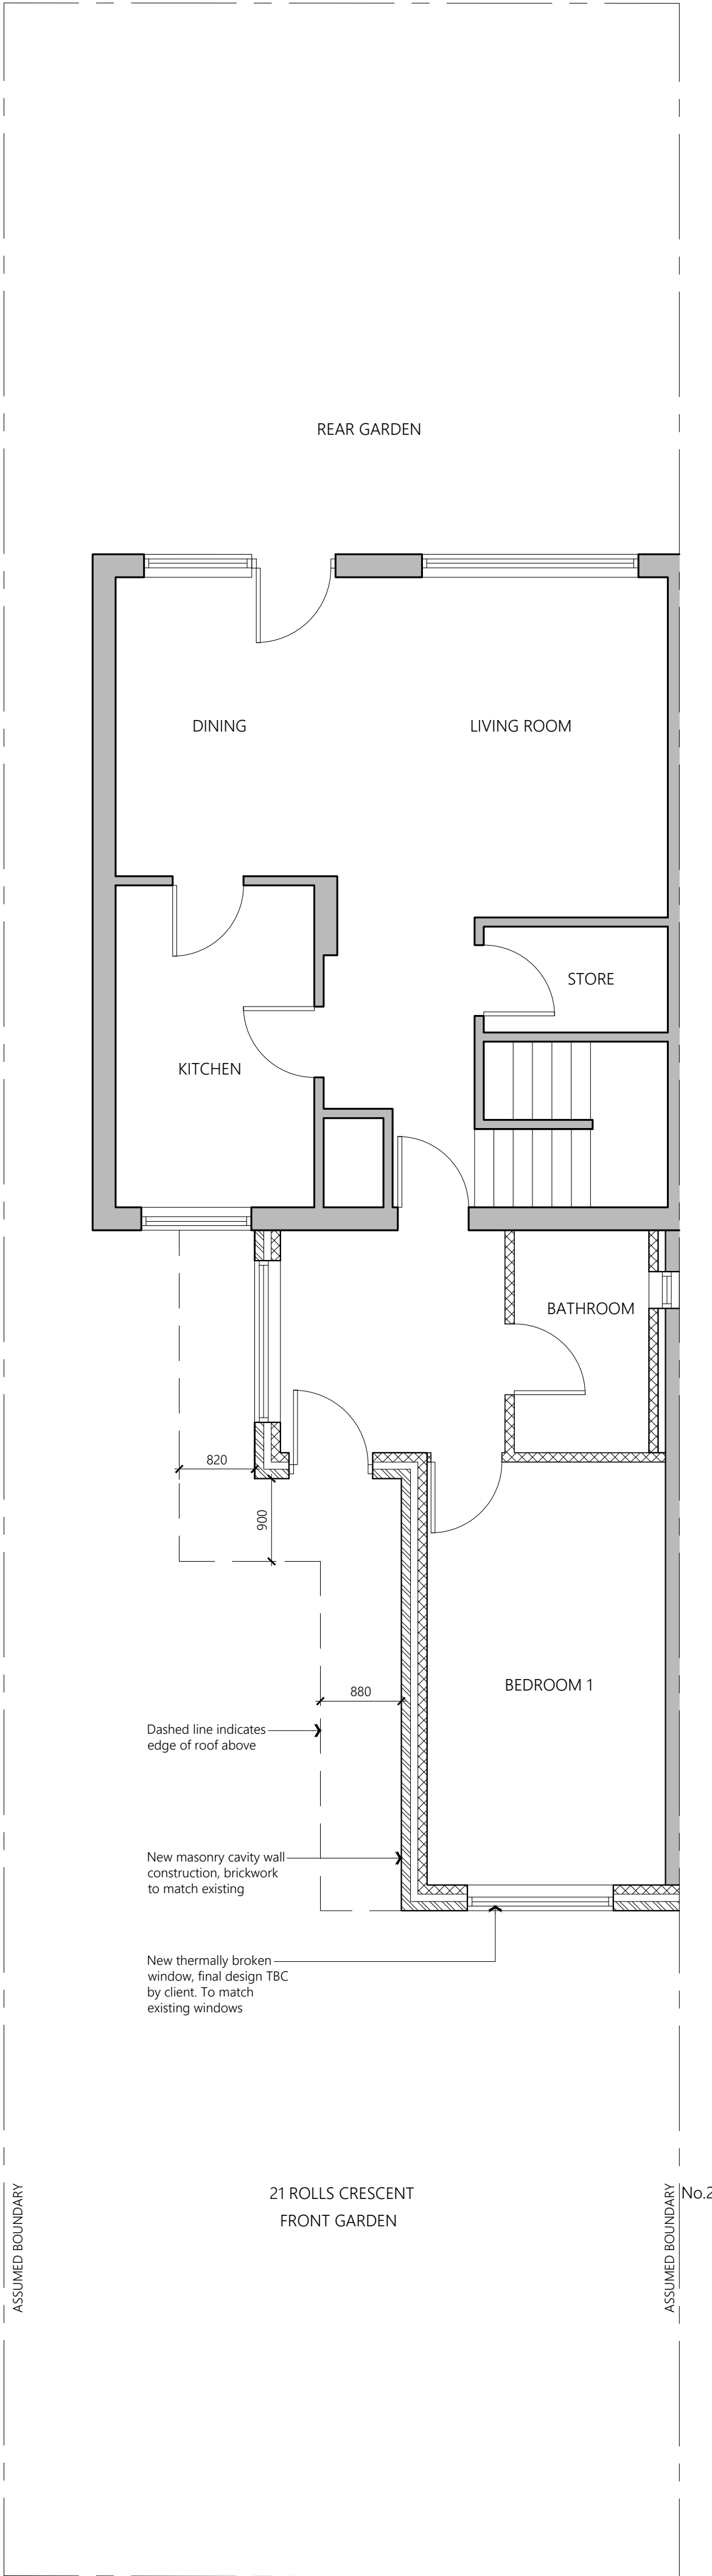


PROPOSED/ AS BUILT GROUND FLOOR PLAN

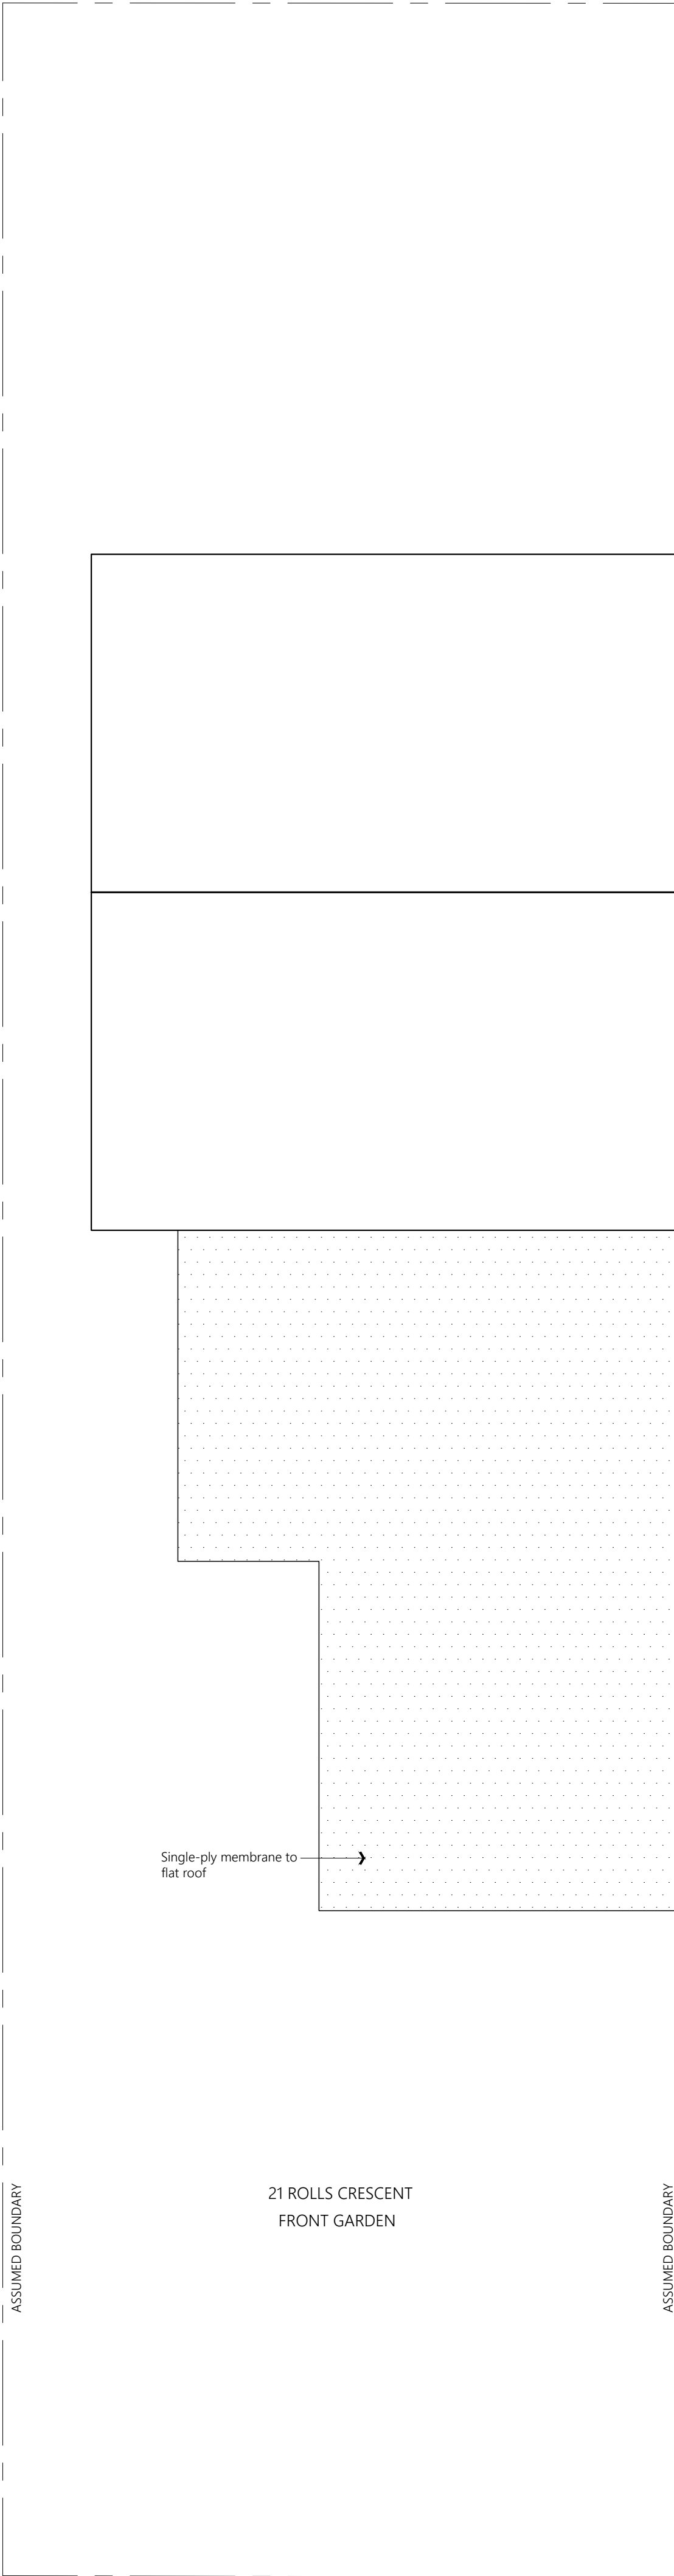

PROPOSED/ AS BUILT ROOF PLAN

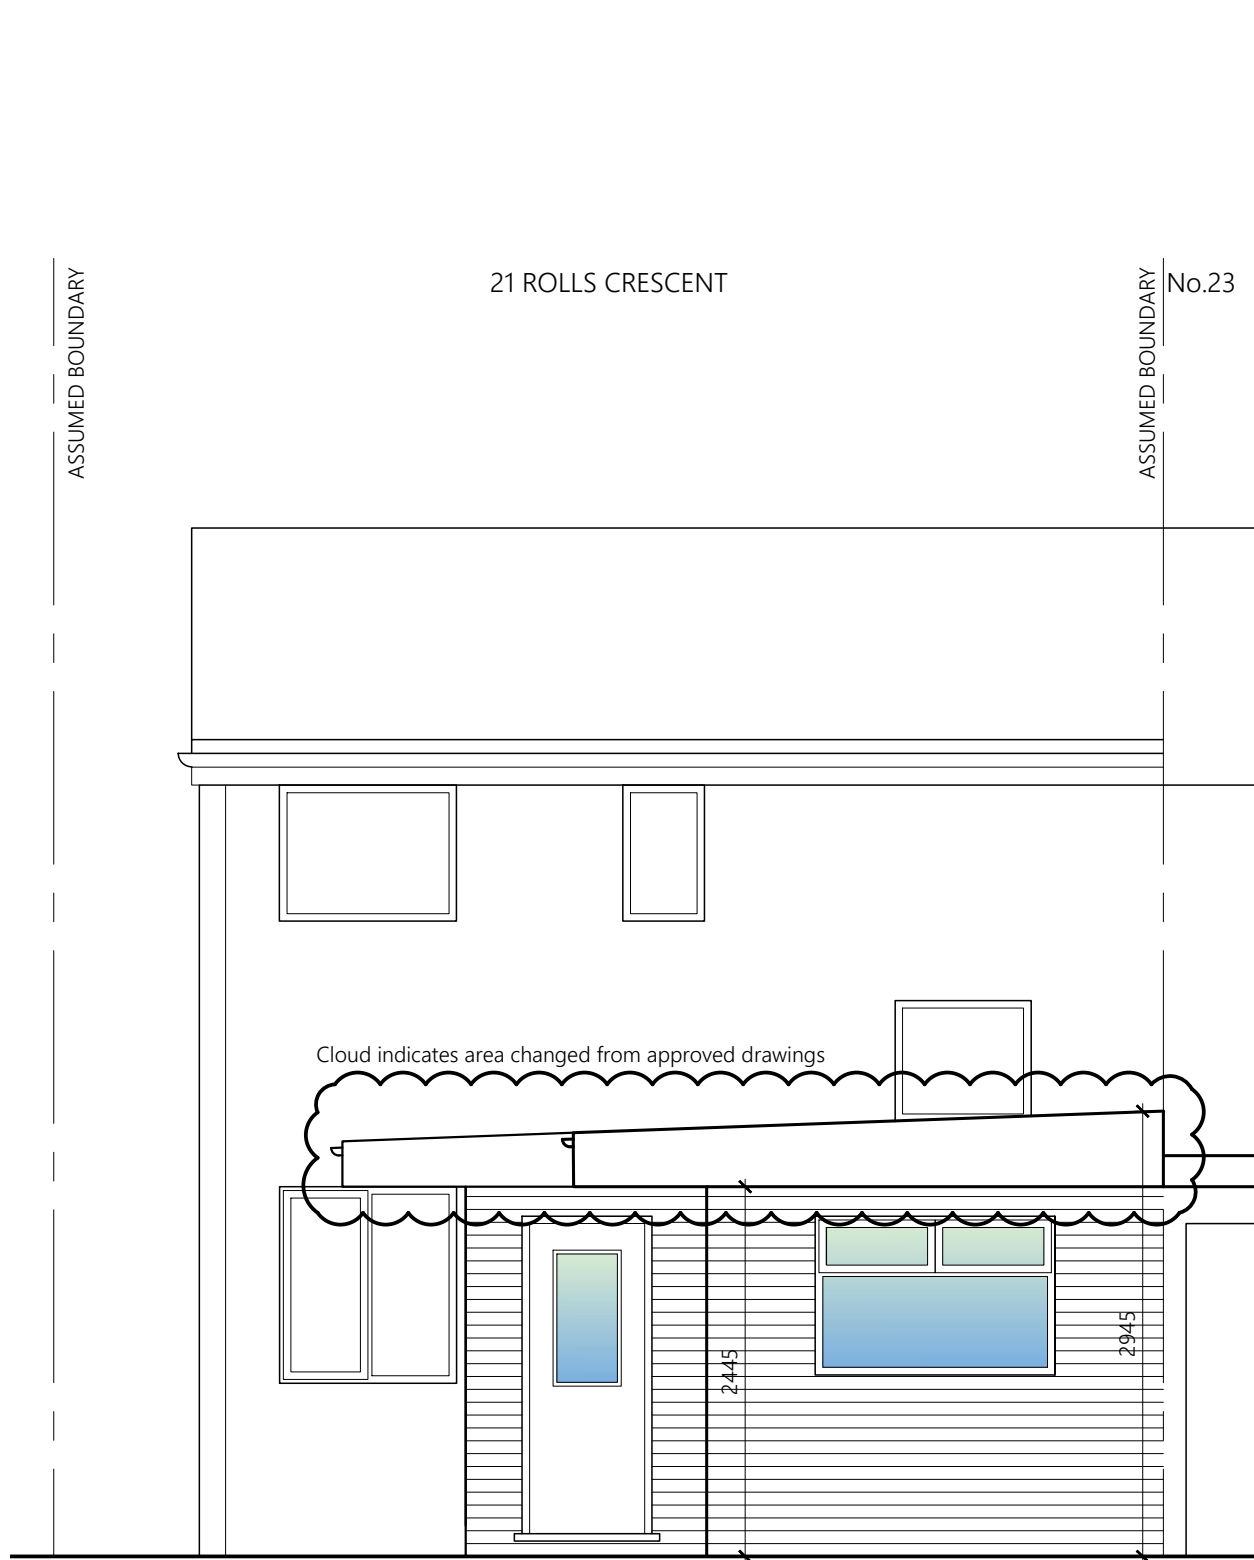


PROPOSED/ AS BUILT FRONT ELEVATION

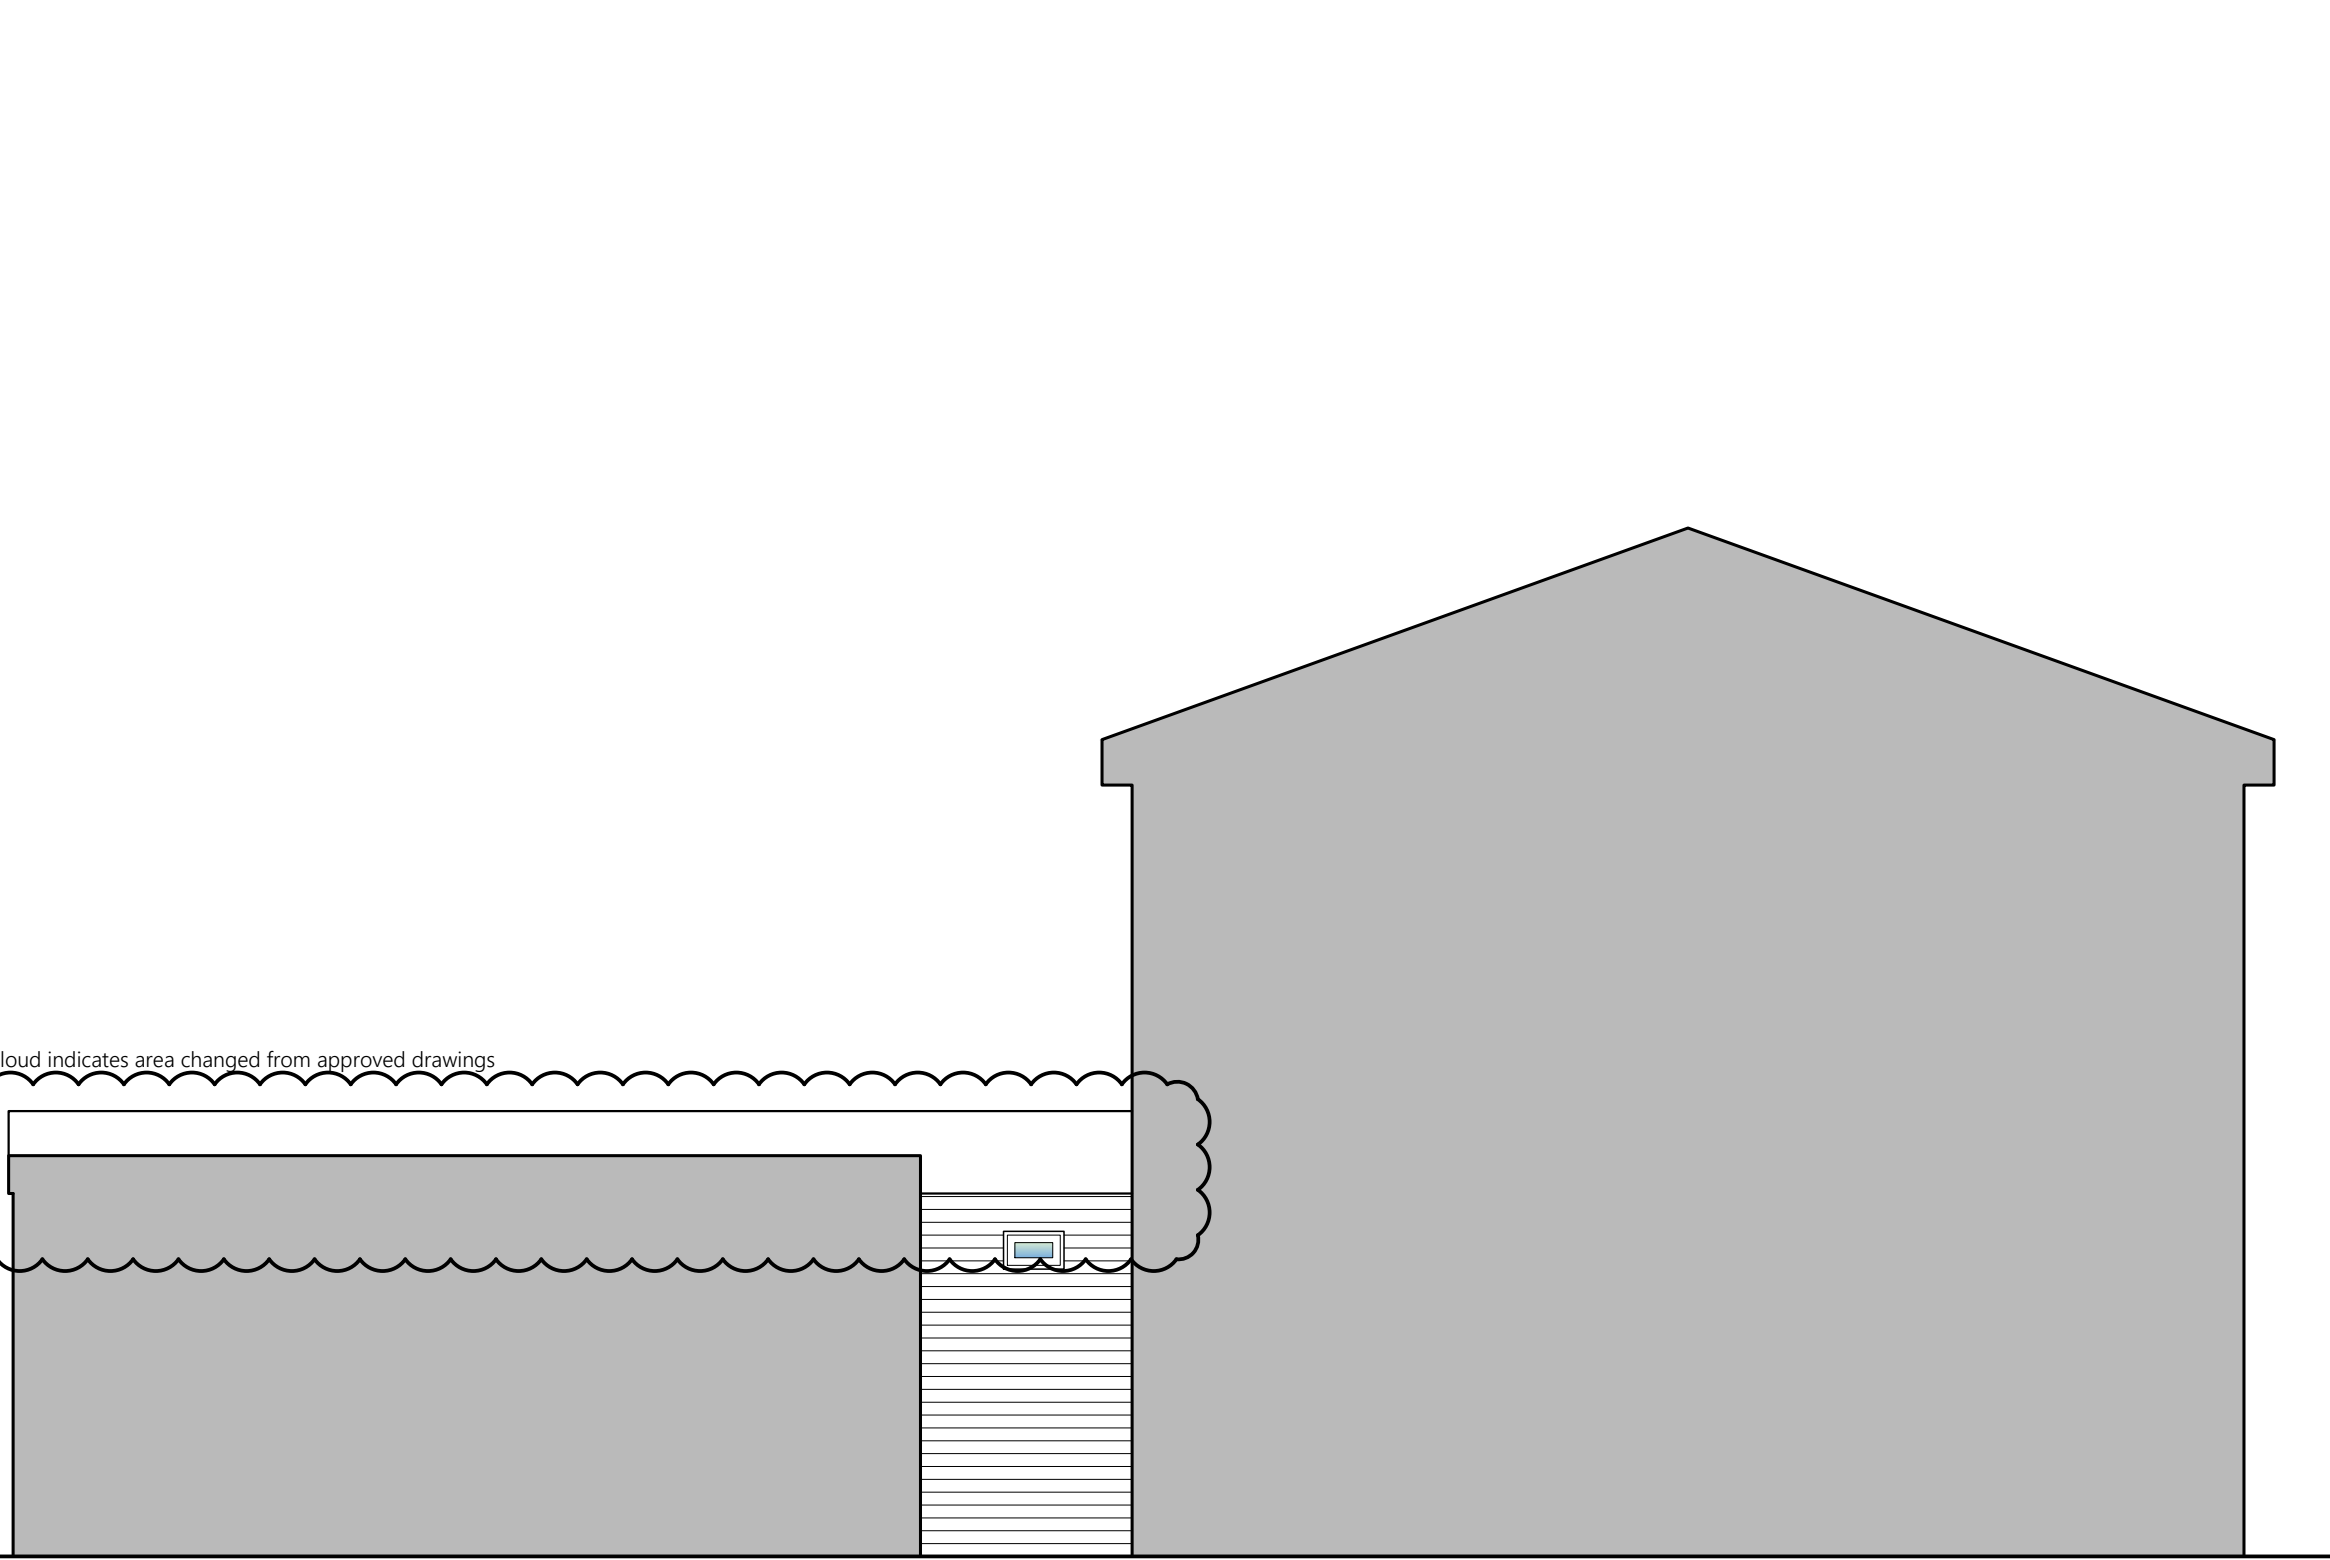


PROPOSED/ AS BUILT SIDE ELEVATION



EXISTING REAR ELEVATION
NO CHANGE

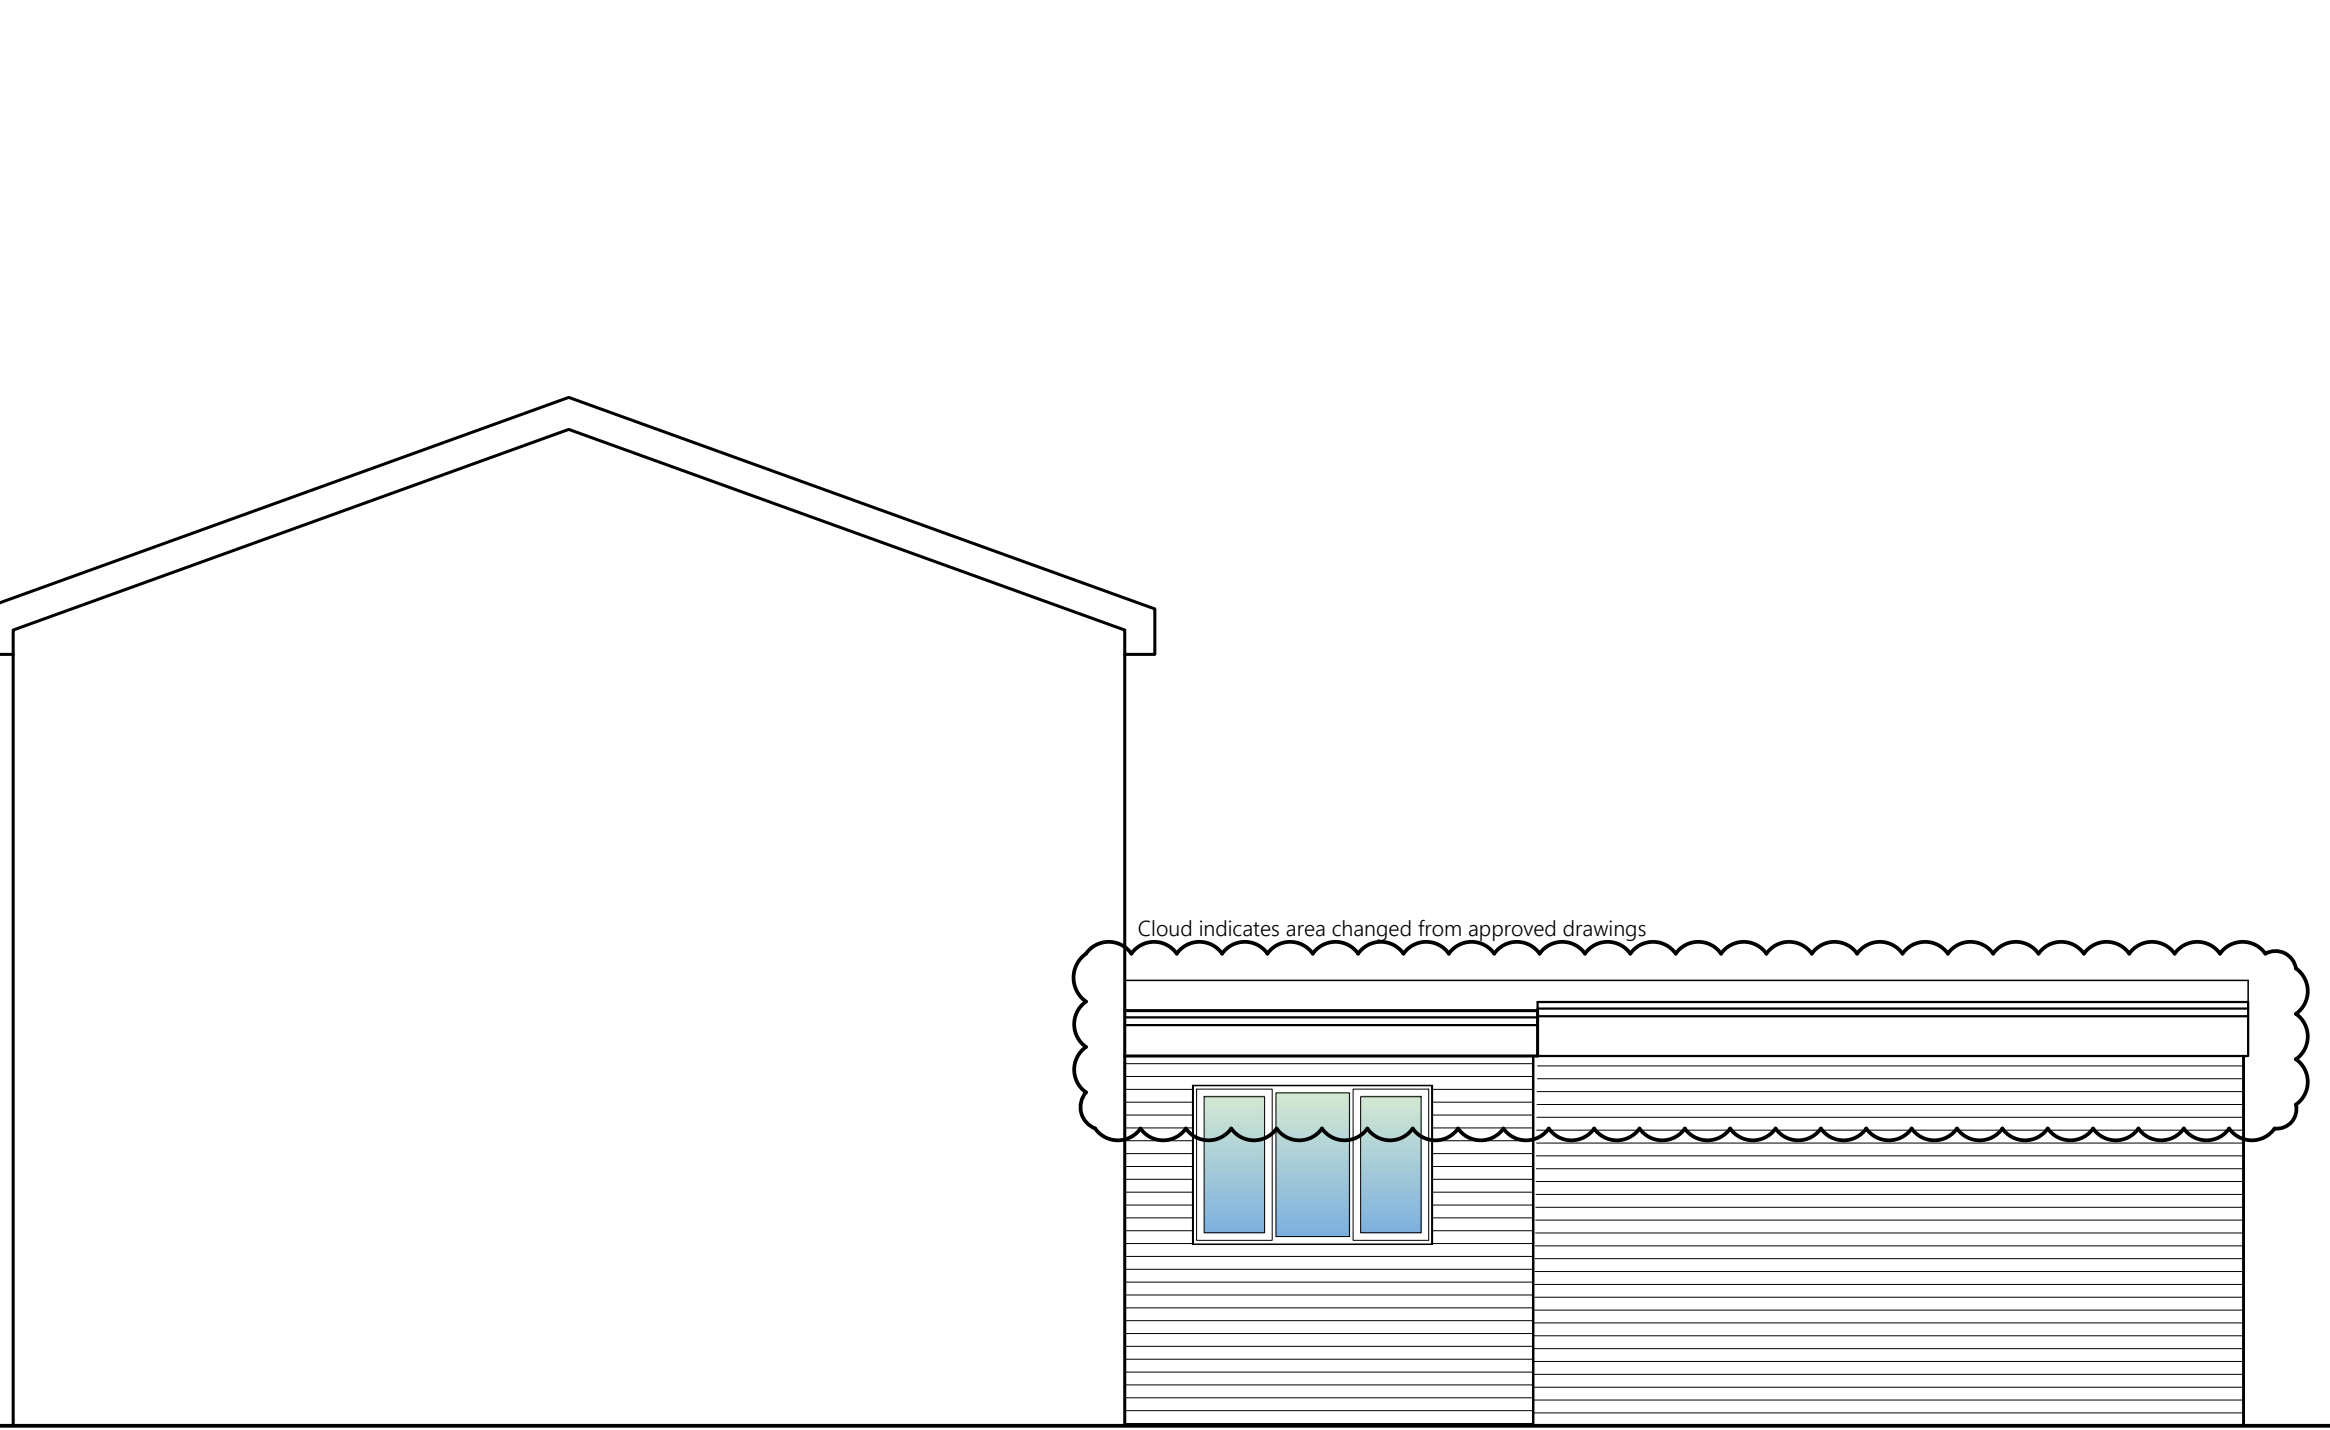

PROPOSED/ AS BUILT SIDE ELEVATION

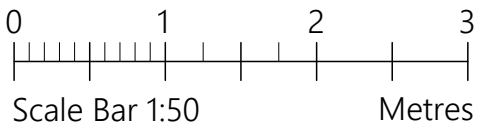

PROJECT	21 Rolls Crescent Hulme M15 5FT		
CLIENT	H Patasiova		
STATUS	Information		
DRAWING	Proposed Plans & Elevations		
DWG No.	2427-03	REV	
SCALE	1:50@A1	DATE	April '24
AGB CAD SERVICES			
website: www.agbcad.co.uk email: info@agbcad.co.uk telephone: 07912 090 125 DO NOT SCALE FROM THIS DRAWING			