
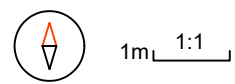


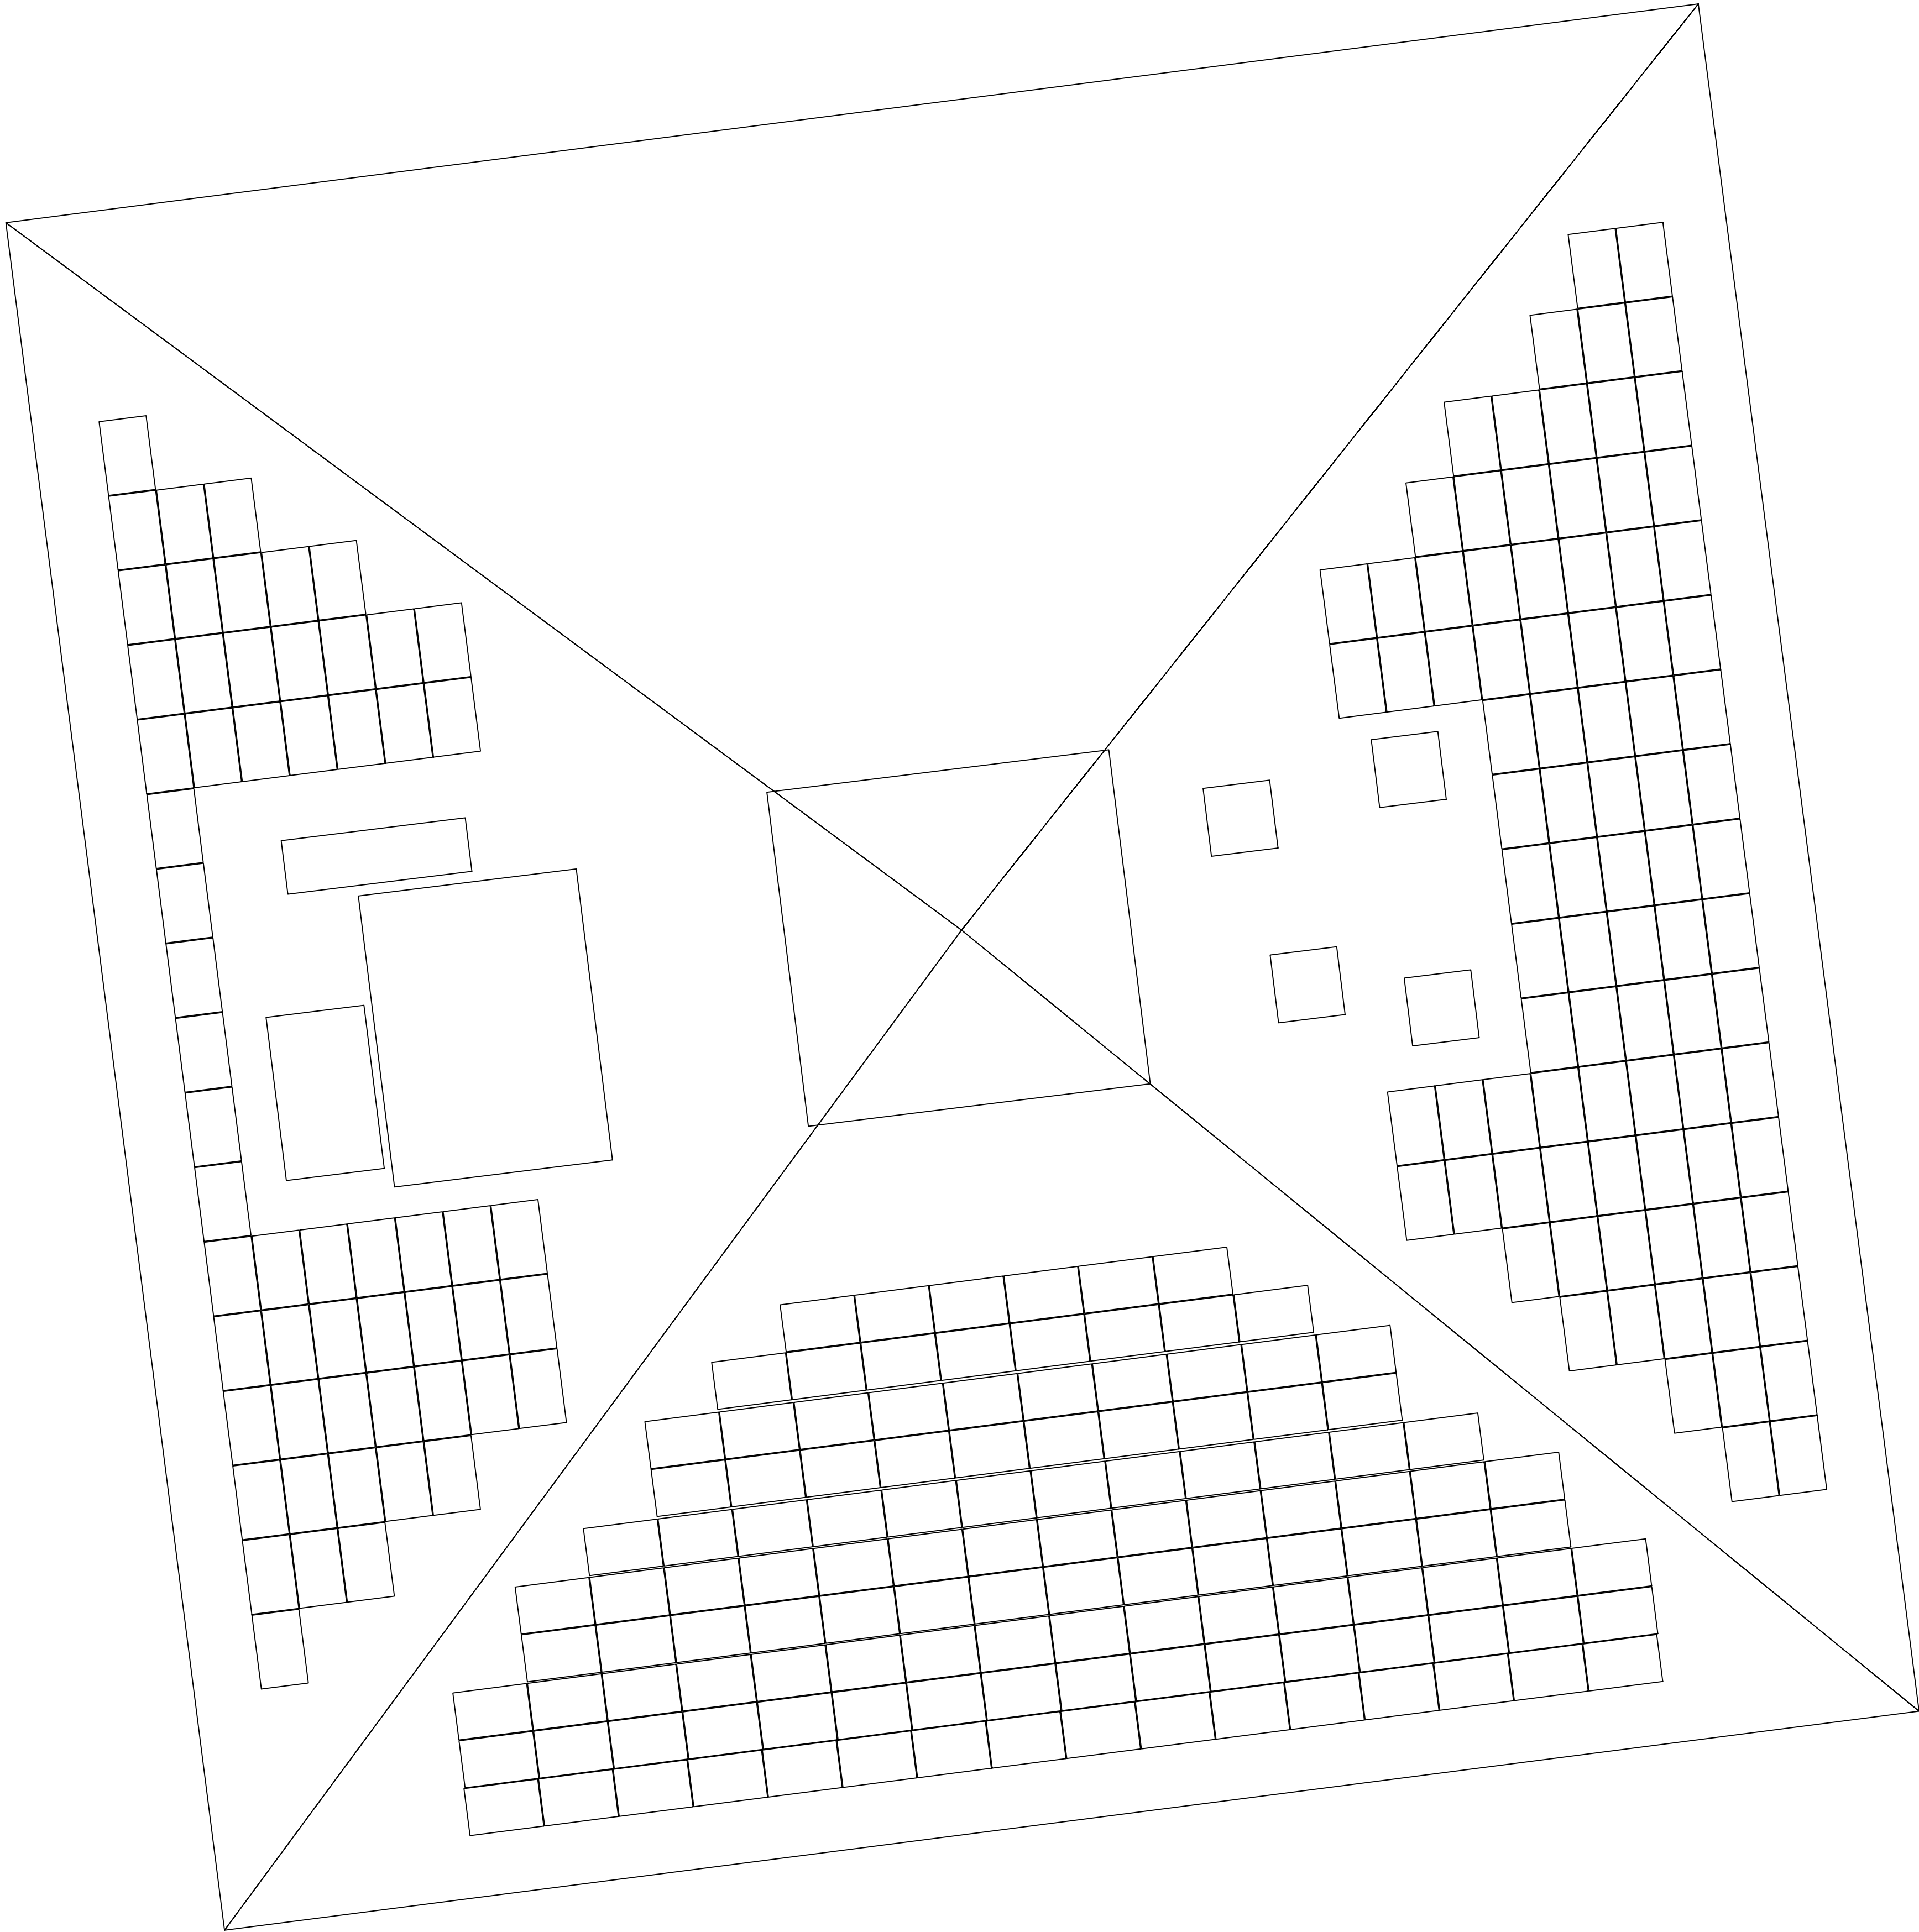

Drawing Review

As Built

General Notes

Ocean,  
  
Towers Business Park,  
Didsbury,  
Manchester  
M20 2YY

|     |             |      |
|-----|-------------|------|
|     |             |      |
|     |             |      |
|     |             |      |
| No. | Description | Date |

DRAWING REVISIONS



Project Name  
**Ocean**  
**Towers Business Park**  
Client  
**MJ Quinn Solar**  
CAD  
**Hyperion Zero Ltd.**  
Drawing Title  
**Ocean As Built Roof Layout**

|                                       |                                  |          |
|---------------------------------------|----------------------------------|----------|
| Project Number<br><b>HZ-MJQ-022</b>   | Drawing Number<br><b>TOW-004</b> |          |
| First Issue Date<br><b>24/01/2024</b> | Drawn<br>GD                      | Revision |
| Scale<br><b>1:100</b>                 | Checked<br>GD                    |          |