


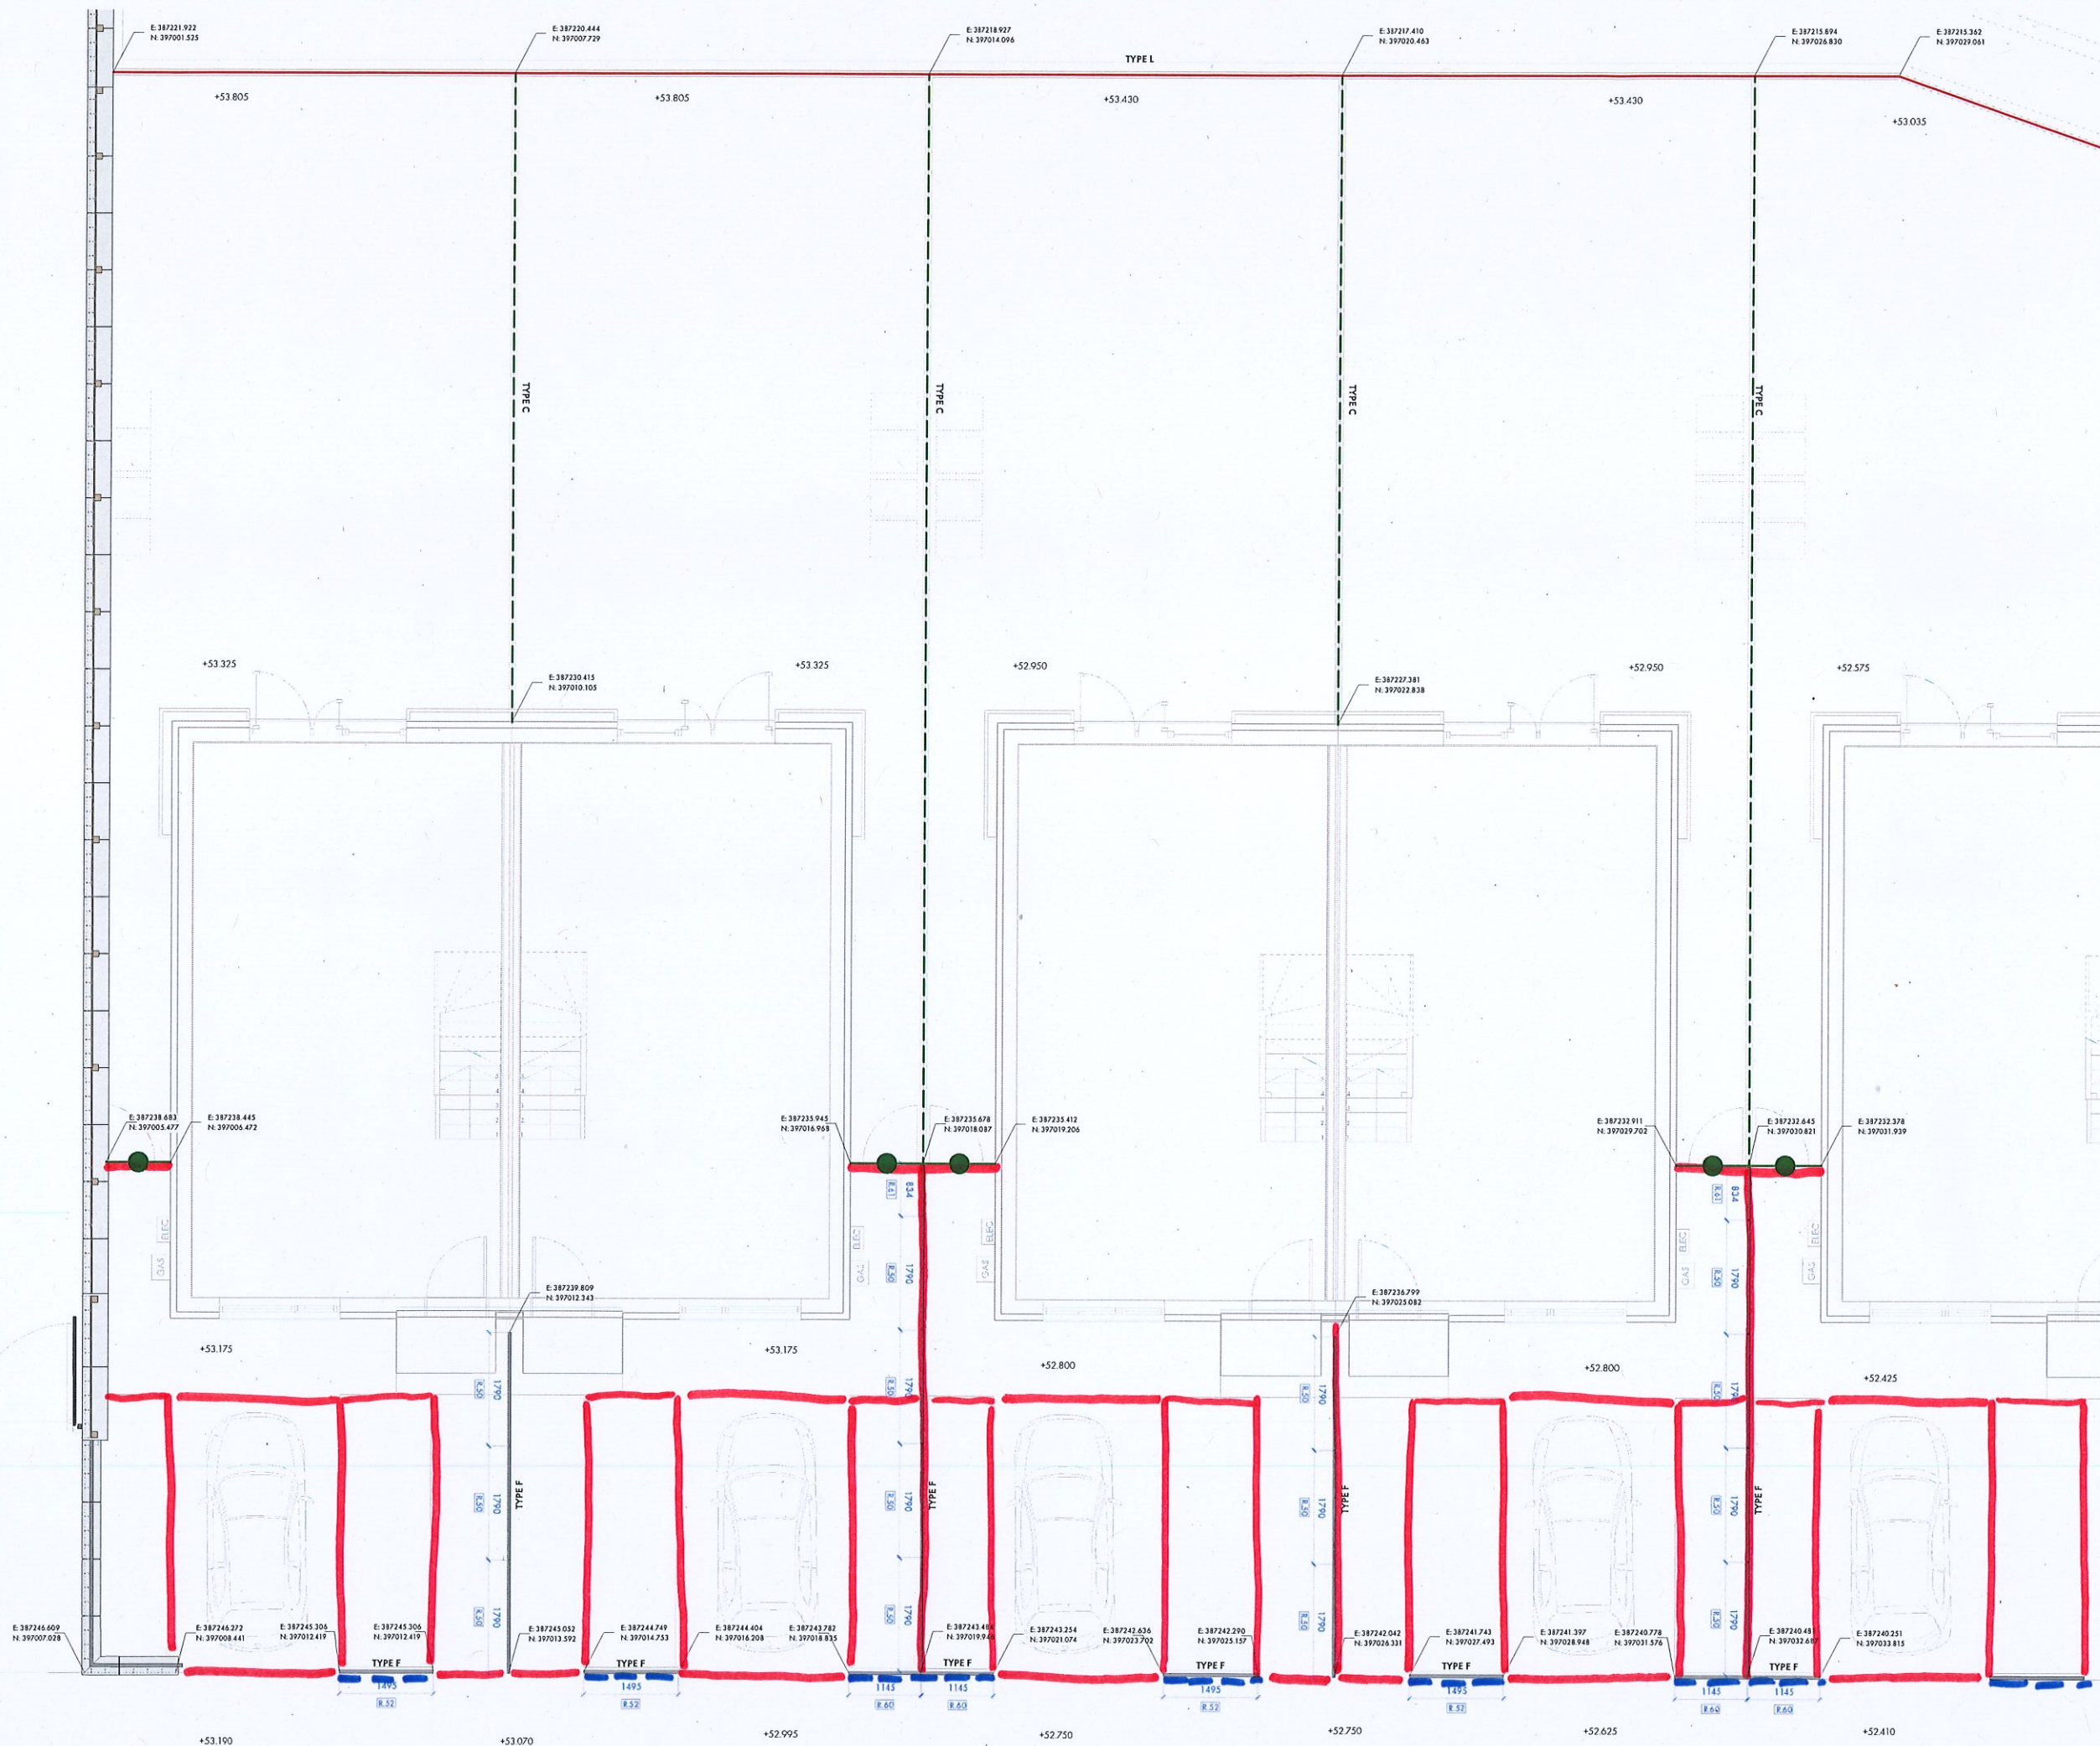

REVISION	DATE	DESCRIPTION
P01	15.08.22	PRELIMINARY ISSUE

NOTE:
BRICKWORK SETTING OUT SHOWN WITH **BLACK** DIMENSIONS.

COPING SETTING OUT SHOWN IN **RED** DIMENSIONS.

RAILING SETTING OUT SHOWN IN **BLUE** DIMENSIONS.

KEY:

TYPE B
1800mm HIGH, VERTICAL, CLOSE
BOARDED TIMBER FENCE; ADDITIONAL
300mm TIMBER TRELLIS

TYPE C
1200mm HIGH, VERTICAL, CLOSE
BOARDED TIMBER FENCE; ADDITIONAL
300mm TIMBER TRELLIS

1800mm HIGH LOCKABLE
CLOSE-BOARDED TIMBER GATE

FLUSH BLOCK PAVING EDGEW/
TORBERMOE FUSION
(ASPER DEP DESIGN)

CONSERVATION KERB UPSHAW
BELOW RAILINGS ON STREET
EDGES

UPSHAW KERB
MARKUP
18/01/23 SM
PRELIMINARY ISSUE

OMIArchitects


318 Blackfriars Road, Salford, Manchester, M3 7AQ
+44(0)161 832 3242 / info@omiarhitects.com / www.omiarhitects.com

PROJECT	GORTON LANE MANCHESTER			
DRAWING	SITE 1 - EXTERNAL WORKS SETTING OUT SHEET 4			
DATE	23.05.22	DRAWN BY	TB	SCALE 1:50 @A1
JOB NO	1405	DWG NO	8790-OMI-XX-XX-DI-A-A3717 P01	

REVISION	DATE	DESCRIPTION
PO1	15.08.22	PRELIMINARY ISSUE

NOTE:
 BRICKWORK SETTING OUT SHOWN WITH **BLACK** DIMENSIONS.
 COPING SETTING OUT SHOWN IN **RED** DIMENSIONS.
 RAILING SETTING OUT SHOWN IN **BLUE** DIMENSIONS.

- KEY:**
- TYPE B**
1800mm HIGH, VERTICAL, CLOSE BOARDED TIMBER FENCE; ADDITIONAL 300mm TIMBER TRELLIS
 - TYPE C**
1200mm HIGH, VERTICAL, CLOSE BOARDED TIMBER FENCE; ADDITIONAL 300mm TIMBER TRELLIS
 - 1800mm HIGH LOCKABLE CLOSE-BOARDED TIMBER GATE

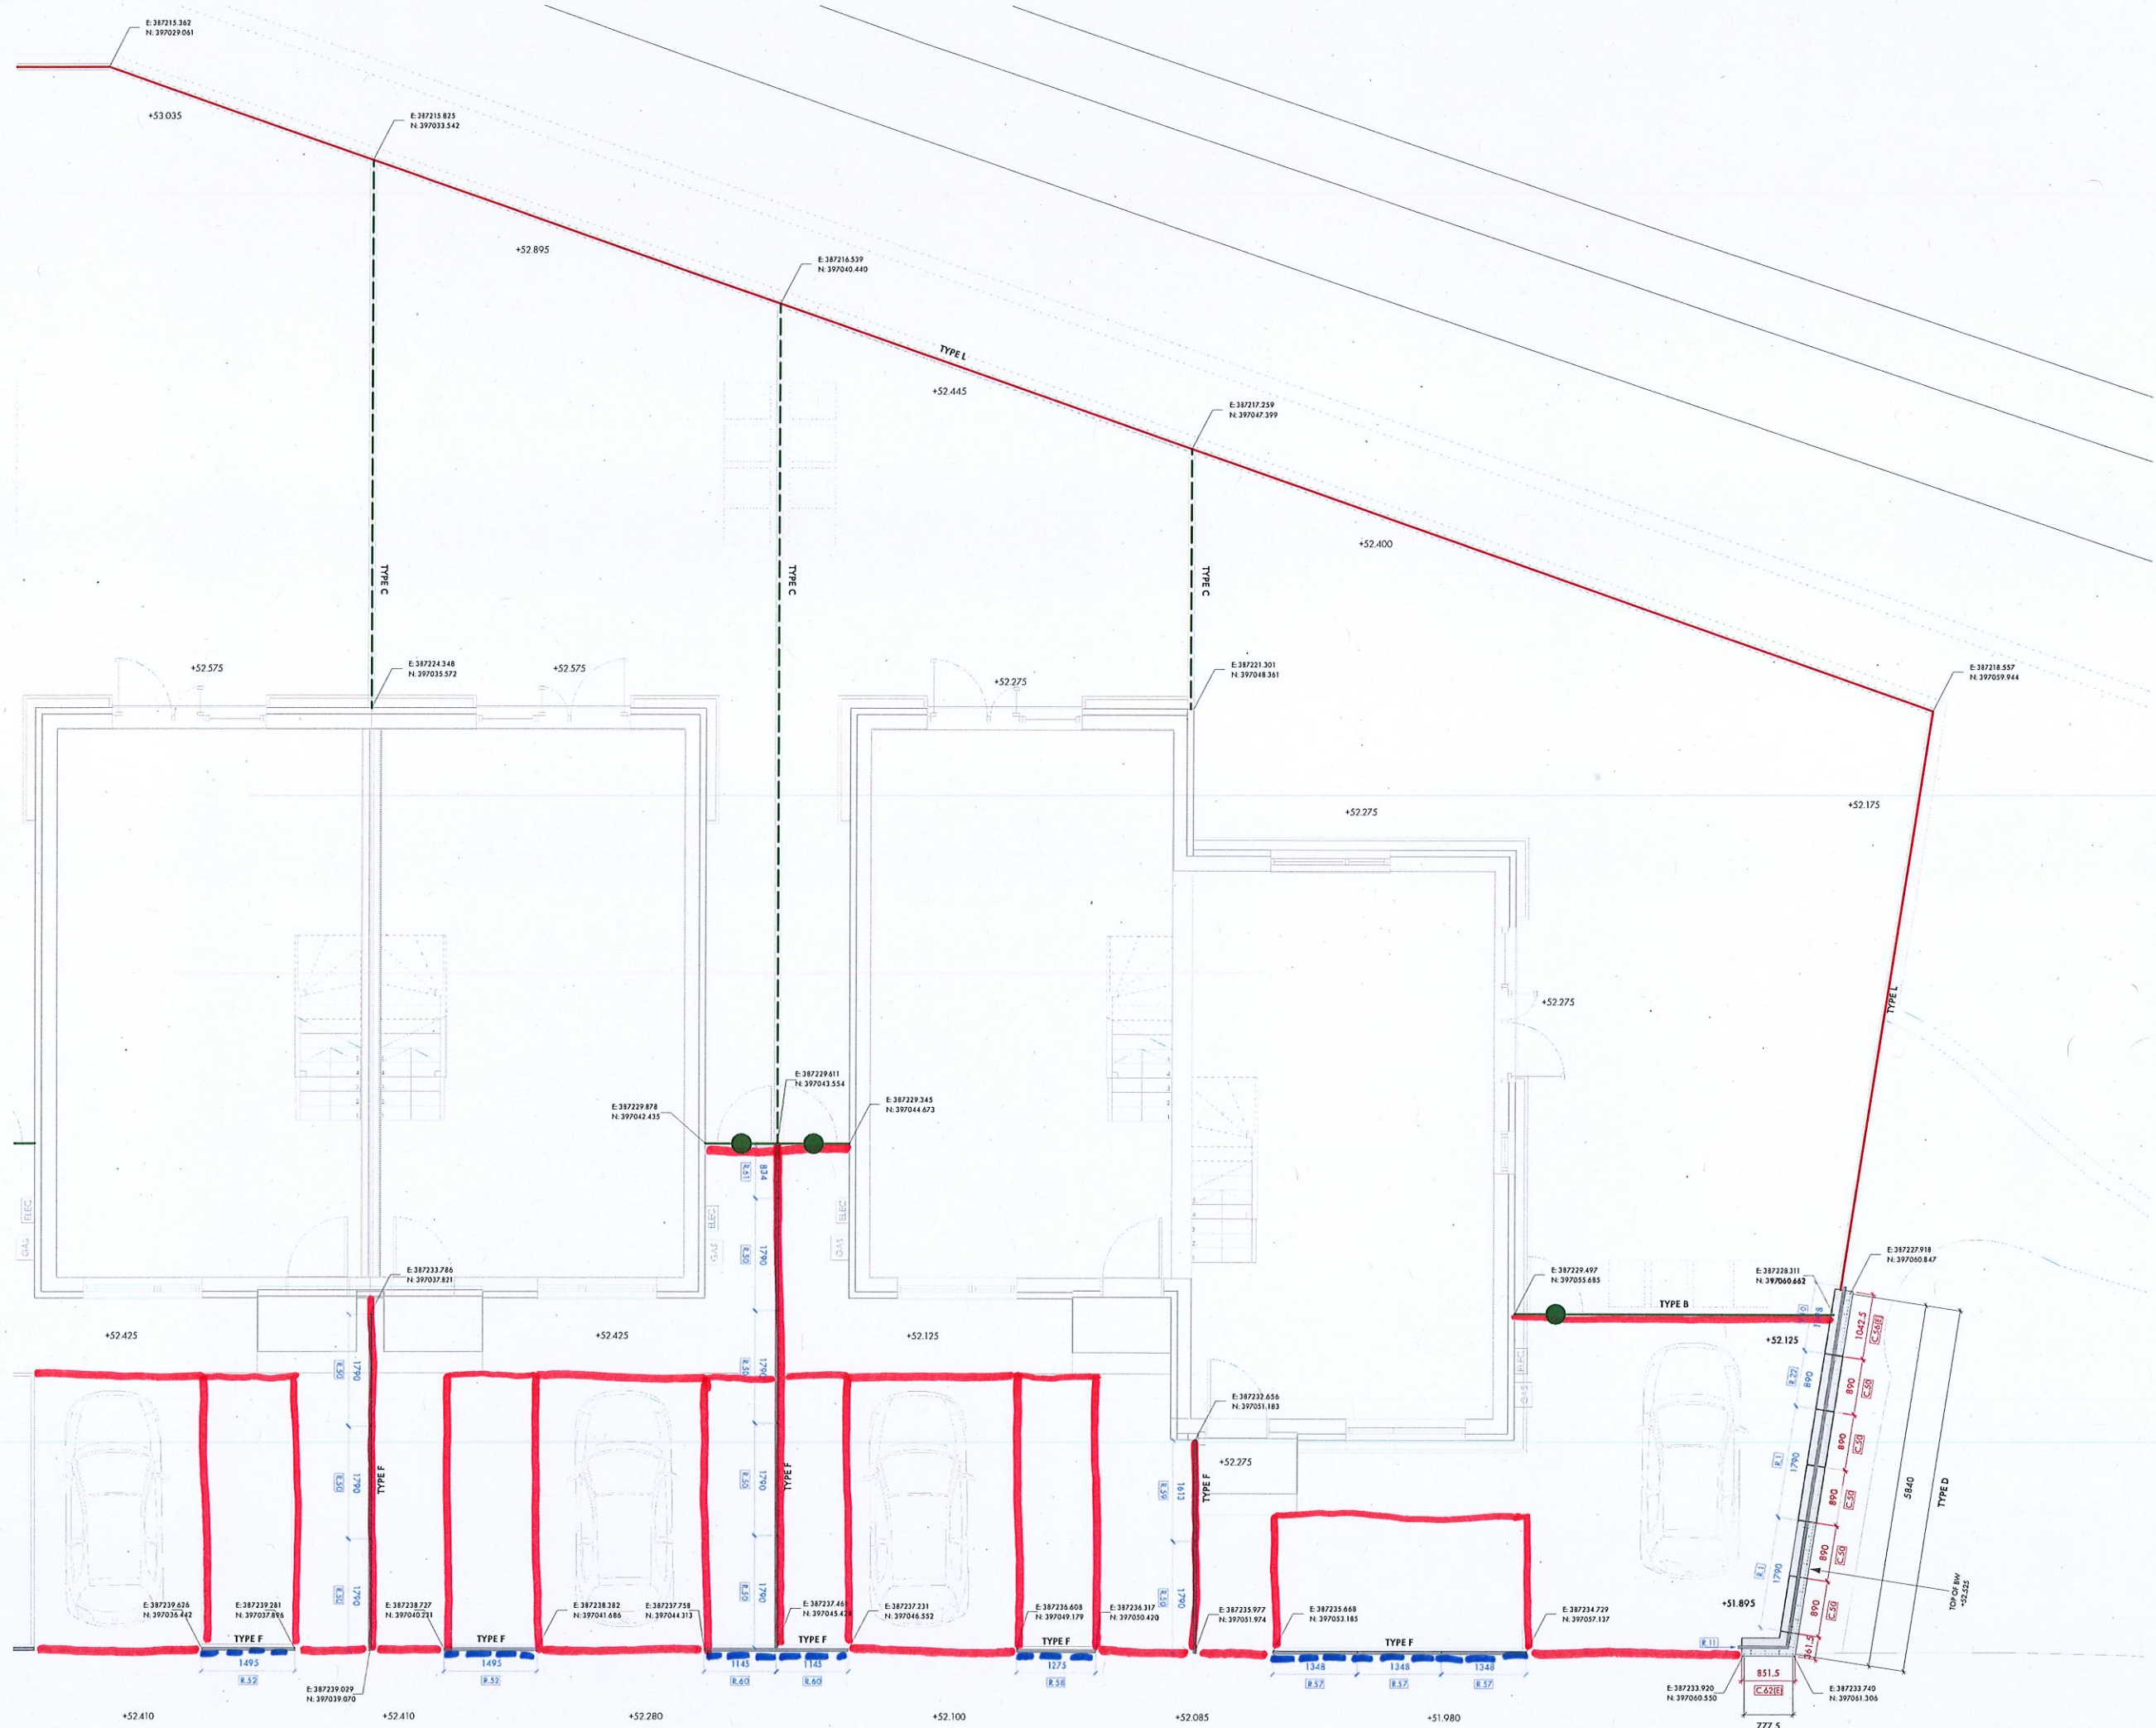

18/01/23 SM
 PRELIMINARY ISSUE

REVISION	DATE	DESCRIPTION
PO1	24.05.22	PRELIMINARY ISSUE
PO2	07.06.22	RAILING TYPES AMENDED
CO1	15.08.22	UPDATED INLINE WITH SCHEDULES

NOTE:
BRICKWORK SETTING OUT SHOWN WITH **BLACK** DIMENSIONS.

COPING SETTING OUT SHOWN IN **RED** DIMENSIONS.

RAILING SETTING OUT SHOWN IN **BLUE** DIMENSIONS.

KEY:

TYPE B
1800mm HIGH, VERTICAL, CLOSE
BOARDED TIMBER FENCE; ADDITIONAL
300mm TIMBER TRELLIS

TYPE C
1200mm HIGH, VERTICAL, CLOSE
BOARDED TIMBER FENCE; ADDITIONAL
300mm TIMBER TRELLIS

1800mm HIGH LOCKABLE
CLOSE-BOARDED TIMBER GATE

18/01/23 *SL*
PRELIMINARY ISSUE

OMIArchitects

318 Rochford Road, Salford, Manchester, M3 7AQ
+44(0)161 832 3242 / info@omichitects.com / www.omichitects.com

PROJECT	GORTON LANE MANCHESTER		
DRAWING	SITE 2 - EXTERNAL WORKS SETTING OUT SHEET 4		
DATE	23.05.22	DRAWN BY	TB
JOB NO	1405	SCALE	1:50 @A1
		ENGINEER	8790-OMI-XX-XX-DI-A-A3713 CO1



REVISION	DATE	DESCRIPTION
P01	20.05.22	PRELIMINARY REVISION
P02	07.06.22	RAILING TYPES AMENDED
C01	15.08.22	UPDATED IN LINE WITH SCHEDULES

NOTE:
BRICKWORK SETTING OUT SHOWN WITH **BLACK** DIMENSIONS.

COPING SETTING OUT SHOWN IN **RED** DIMENSIONS.

RAILING SETTING OUT SHOWN IN **BLUE** DIMENSIONS.

KEY:

TYPE B
1800mm HIGH, VERTICAL, CLOSE
BOARDED TIMBER FENCE; ADDITIONAL
300mm TIMBER TRELLIS

TYPE C
1200mm HIGH, VERTICAL, CLOSE
BOARDED TIMBER FENCE; ADDITIONAL
300mm TIMBER TRELLIS

1800mm HIGH LOCKABLE
CLOSE-BOARDED TIMBER GATE





CONSTRUCTION ISSUE

OMIArchitects

318 Ludlow Road, Salford, Manchester, M3 7AG
+44(0)161 832 3242 / info@omichitects.com / www.omichitects.com

PROJECT	GORTON LANE MANCHESTER		
DRAWING	SITE 2 - EXTERNAL WORKS SETTING OUT SHEET 3		
DATE	MAY'22	DRAWN BY	TB
JOB NO.	1405	SCALE	1:50 @A1
		DWG NO.	8790-OMI-XX-XX-DI-A-A3712 C01

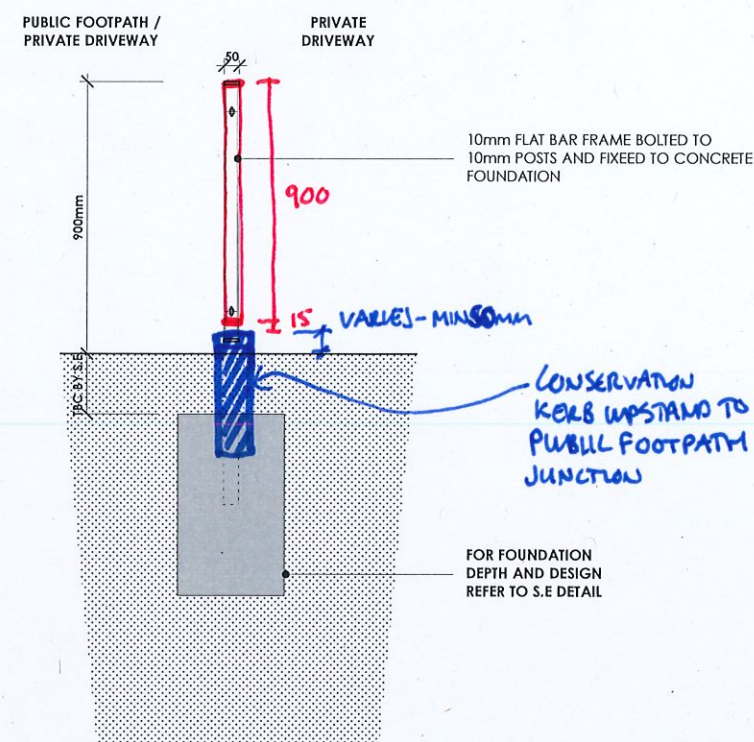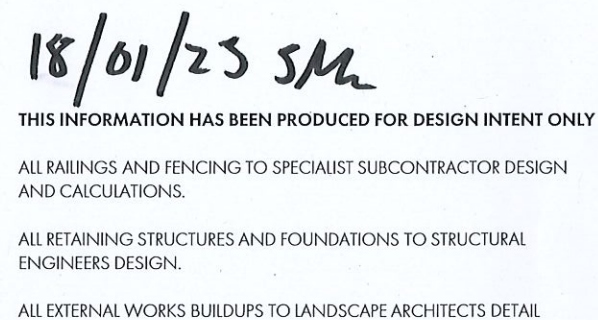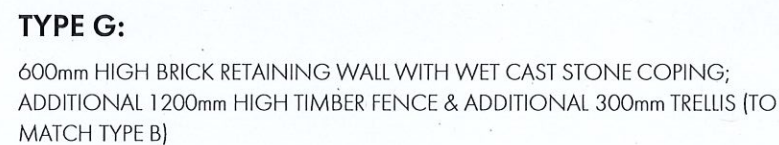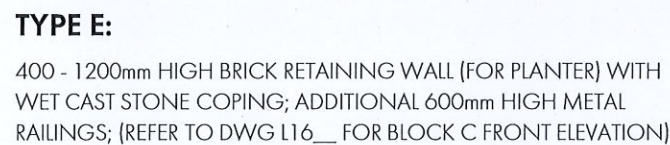

[illegible]

OMI Architects

31 Blackfriars Road, Salford, Manchester, M3 7AQ
+44(0)161 832 3242 / info@omiarchitects.com / www.omiarchitects.com

PROJECT	GORTON LANE - GORTON					
DRAWING	EXTERNAL WORKS TYPICAL DETAILS SHEET 2					
DATE	09.05.22	DRAWN BY	SMG	SCALE	1:25	@A3
JOB NO.	1405	DWG.NO.	8790-OMI-XX-XX-DT-A-A3701 P01			