
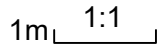


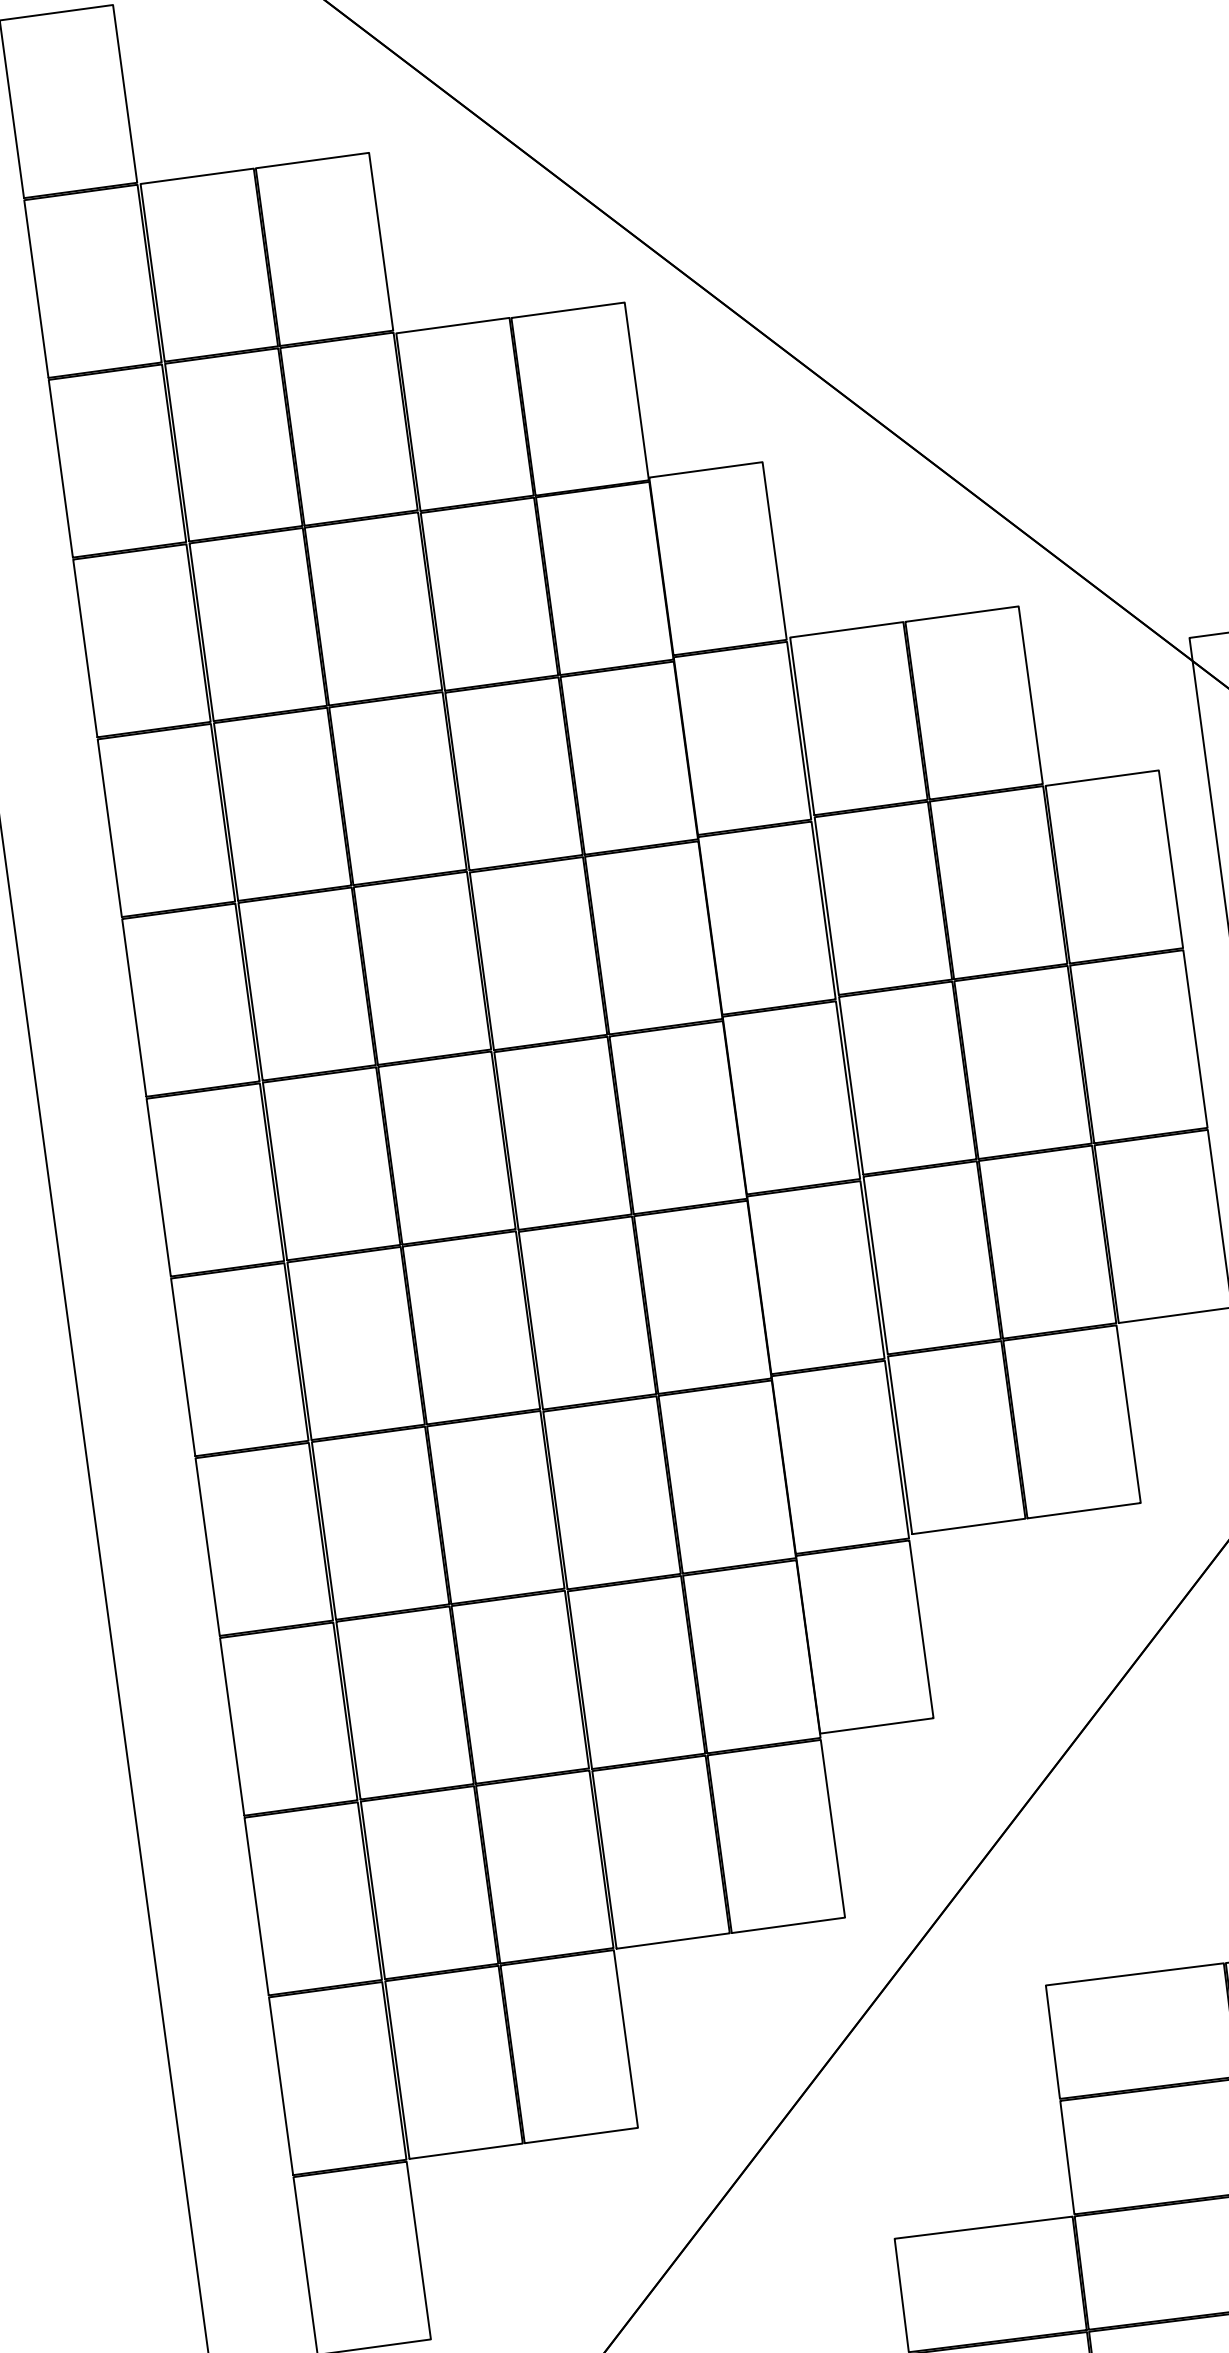

As Built

Kingston,

Towers Business Park,
Didsbury,
Manchester
M20 2YY

No.	Description	Date
-----	-------------	------



Kingston

Towers Business Park

MJ Quinn Solar

Hyperion Zero Ltd.

Kingston As Built Roof Layout

First Issue Date	24/01/2024
------------------	------------

TOW-003

Revision

Check
GD

A1 ORIGINAL

© THIS DRAWING IS THE COPYRIGHT OF HYPERION ZERO LTD AND MAY NOT BE REPRODUCED OR USED EXCEPT BY WRITTEN PERMISSION.