


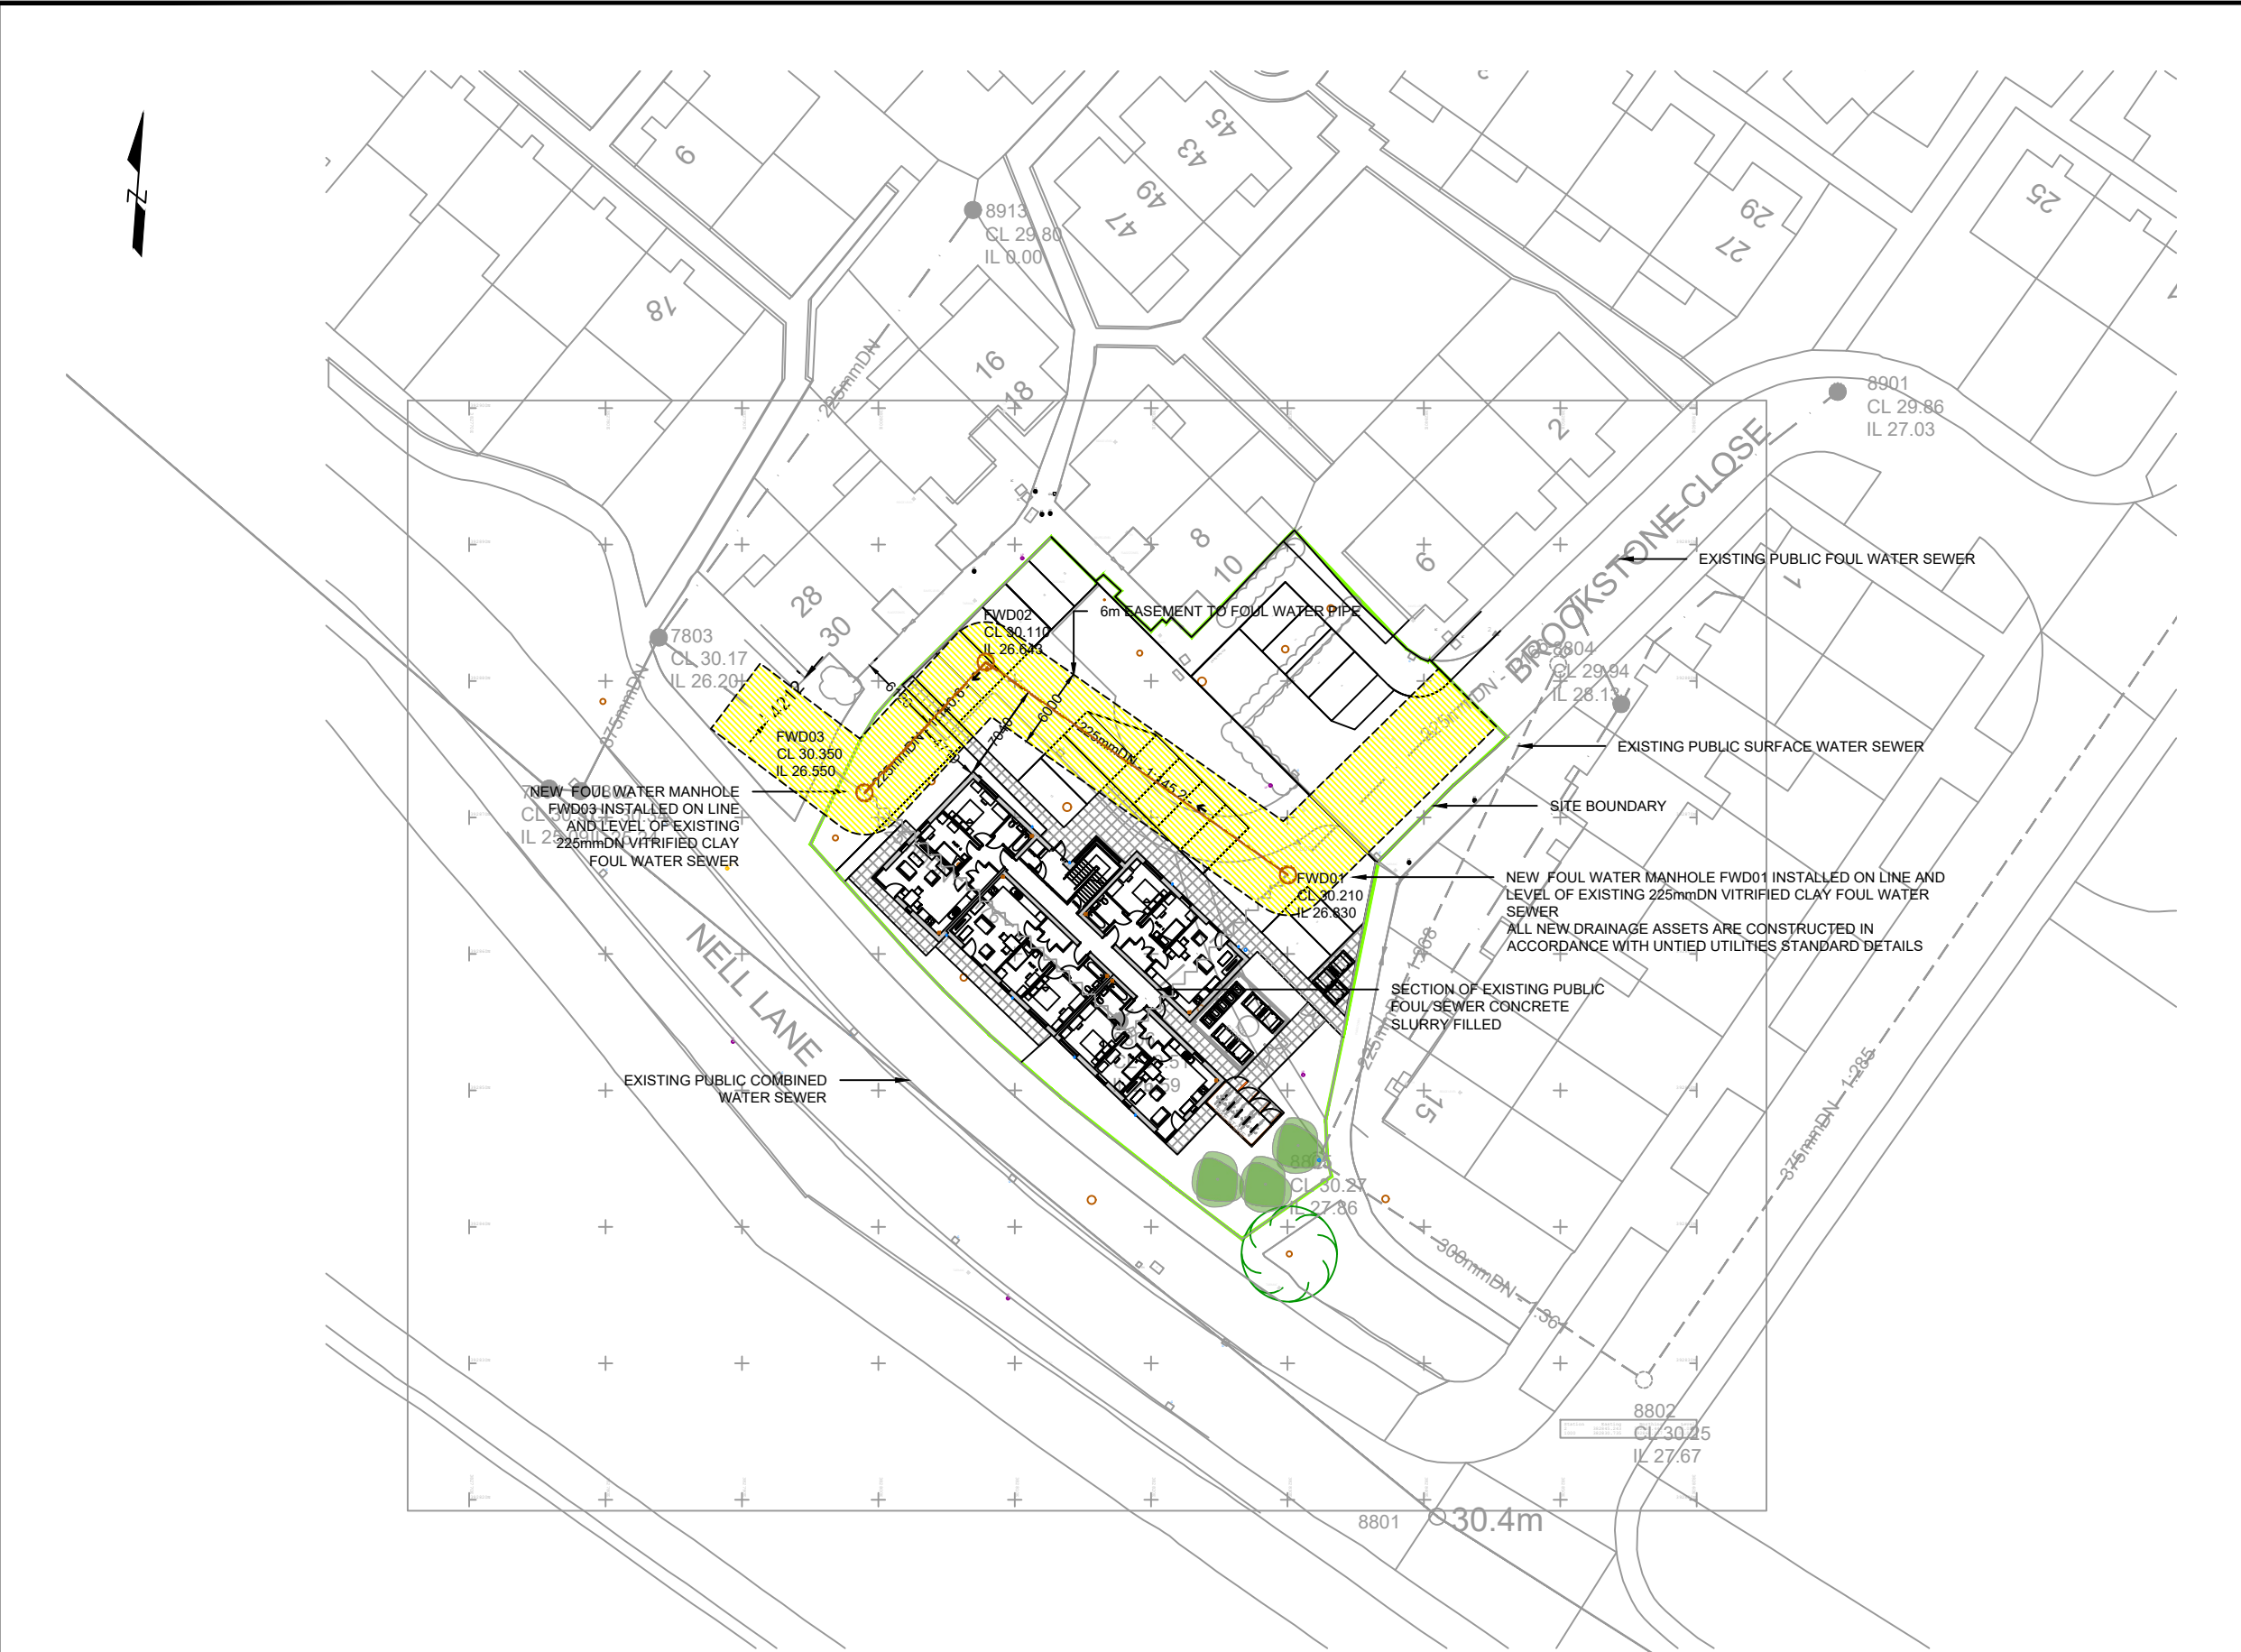

Ordnance Survey, (c) Crown Copyright 2018. All rights reserved. Licence number 100022432

AS BUILT DRAWING

THIS DRAWING IS A TRUE REPRESENTATION OF THE AS-BUILT INFORMATION HBL ASSOCIATES HAVE BEEN PROVIDED WITH. WE DO NOT ACCEPT ANY LIABILITY FOR THE DESIGN OR CONSTRUCTION OF THE SURFACE AND/OR FOUL DRAINAGE SYSTEMS AS THESE DEVIATED FROM THE PROPOSED DESIGN

THIS DRAWING IS TO BE READ IN CONJUNCTION WITH ALL OTHER HBL DRAWINGS ISSUED FOR THIS PROJECT

C02	JAN'24	AP	AS BUILT RECORD	AP	LDM
C01	MAY'23	AP	FINAL CONSTRUCTION	AP	LDM
P06	MAY'23	AP	DIVERSION ADJUSTED	AP	AP
P05	FEB'22	AP	DIVERSION ADJUSTED	AP	HL
P04	JAN'22	AP	EASEMENT ADJUSTED	AP	HL
P03	DEC'21	AP	DIVERSION DETAILS ADDED	AP	HL
P02	NOV'21	AP	DIVERSION DETAILS ADDED	AP	HL
P01	SEPT'21	AP	FIRST ISSUE	AP	HL
REV.	DATE	DRAWN	DESCRIPTION	CHKD	APPRD

STATUS	DESCRIPTION	STATUS
	AS BUILT RECORD	CR



Brook House
Weybrook Road,
Manchester M19 2QD
+44 (0)161 432 9977 | www.hbl.td
Consulting Civil & Structural Engineers

PROJECT

**NEW APARTMENTS
NELL LANE, CHORLTON**

DRAWING TITLE

**SECTION 185
AS-BUILT SEWER DIVERSION**

CLIENT

SOUTHWAY HOMES

HBL REF.	DATE	SCALE(S)	A3
8796	SEPTEMBER' 21	1:500	
DRAWN	CHECKED	APPROVED	
A. PRINCE	A. PRINCE	H. LONG	

DRAWING No.	REV
8796-HBL-XX-XX-DR-D-0509	C02