



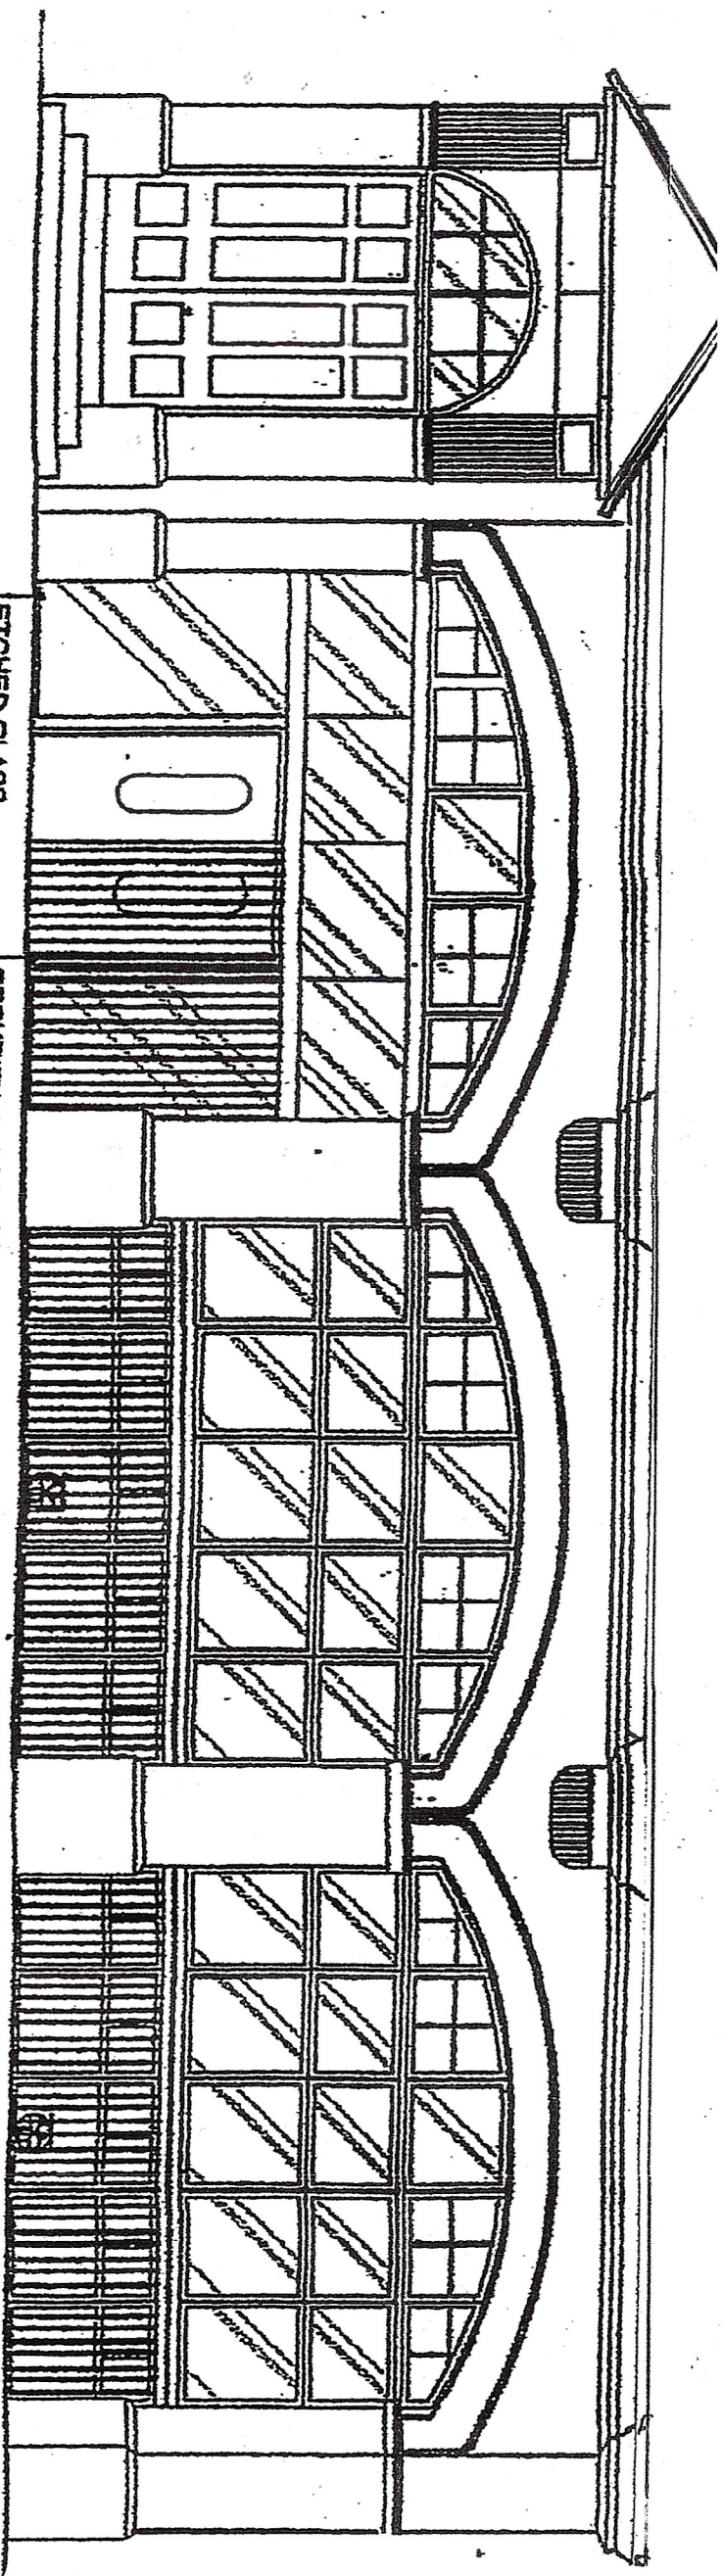

ETCHED GLASS
WINDOWS

SECURITY GRILLE AND
FOLD BACK DOORS

BLOOM STREET ELEVATION AS BUILT 2007

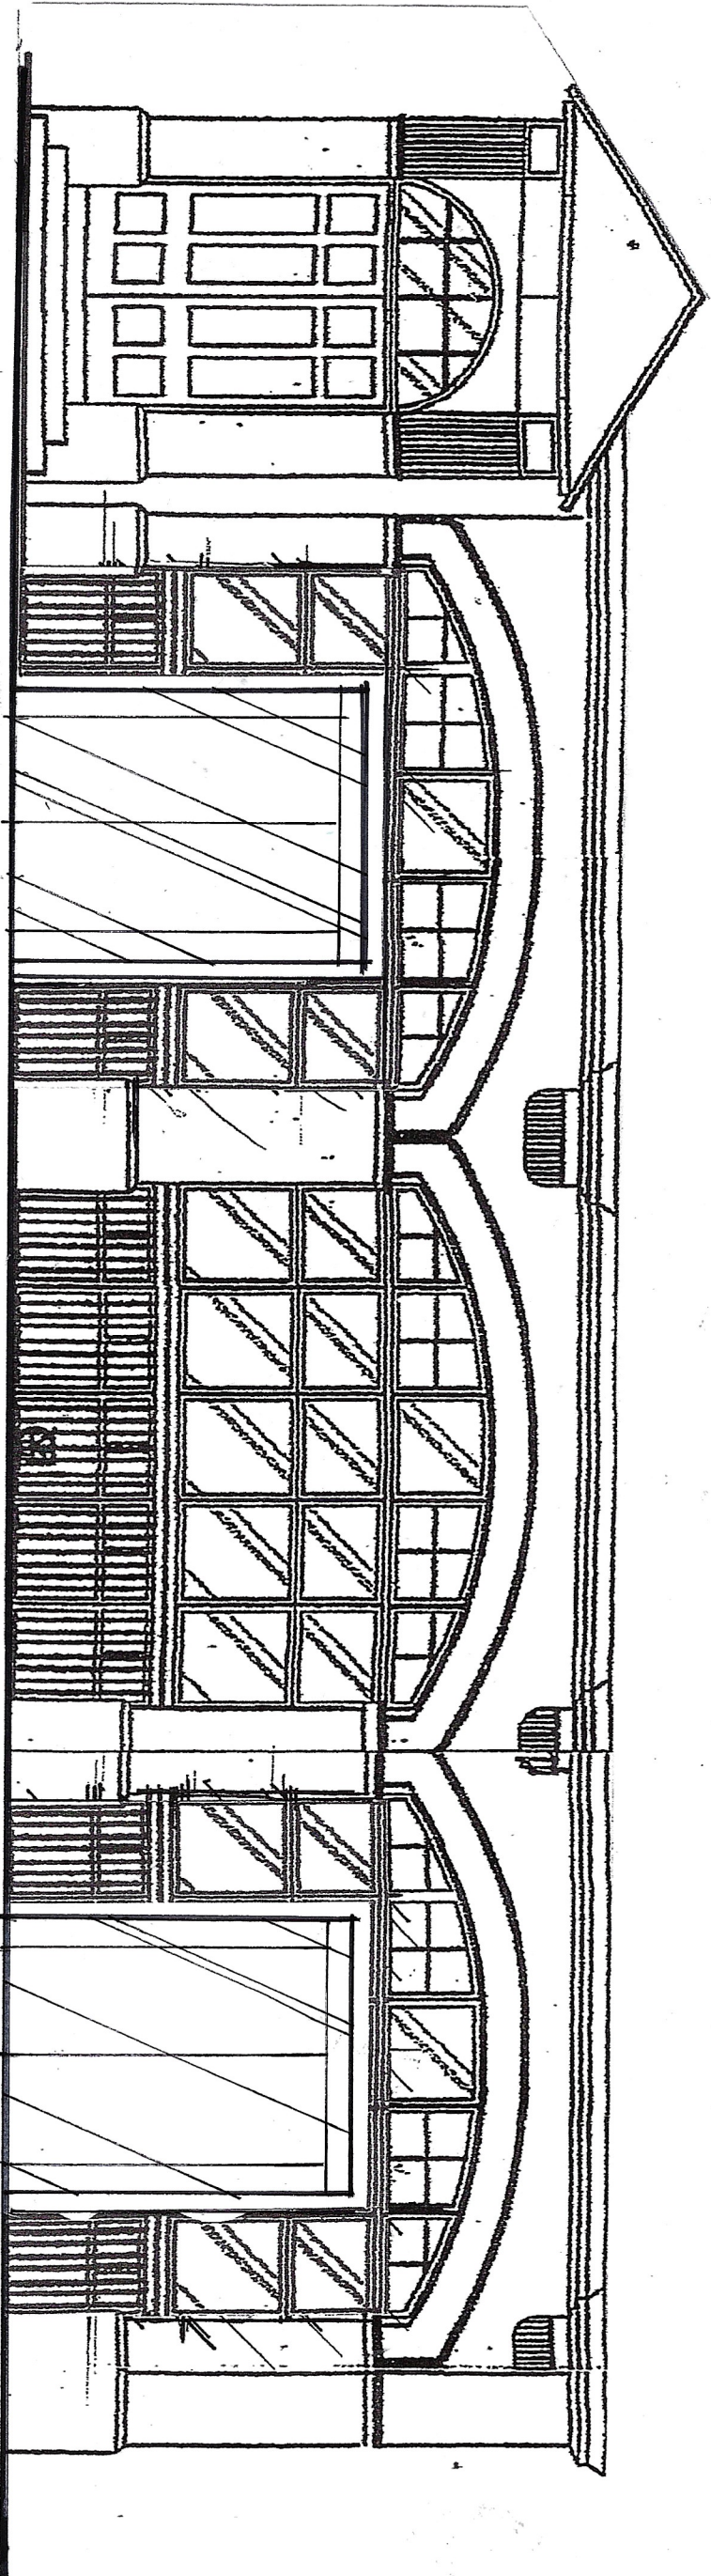

DRG NO. RS /038/ 23
RCA INTERIORS

PROPOSED NEW EXTERNAL MILD
STEEL FRAME BY SPECIALIST.
FINISH TO BE POWDER COATED
WITH PATENT GLAZING DOORS

PROPOSED ELEVATION REV B
BLOOM STREET 1/50 @ A3