
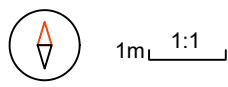


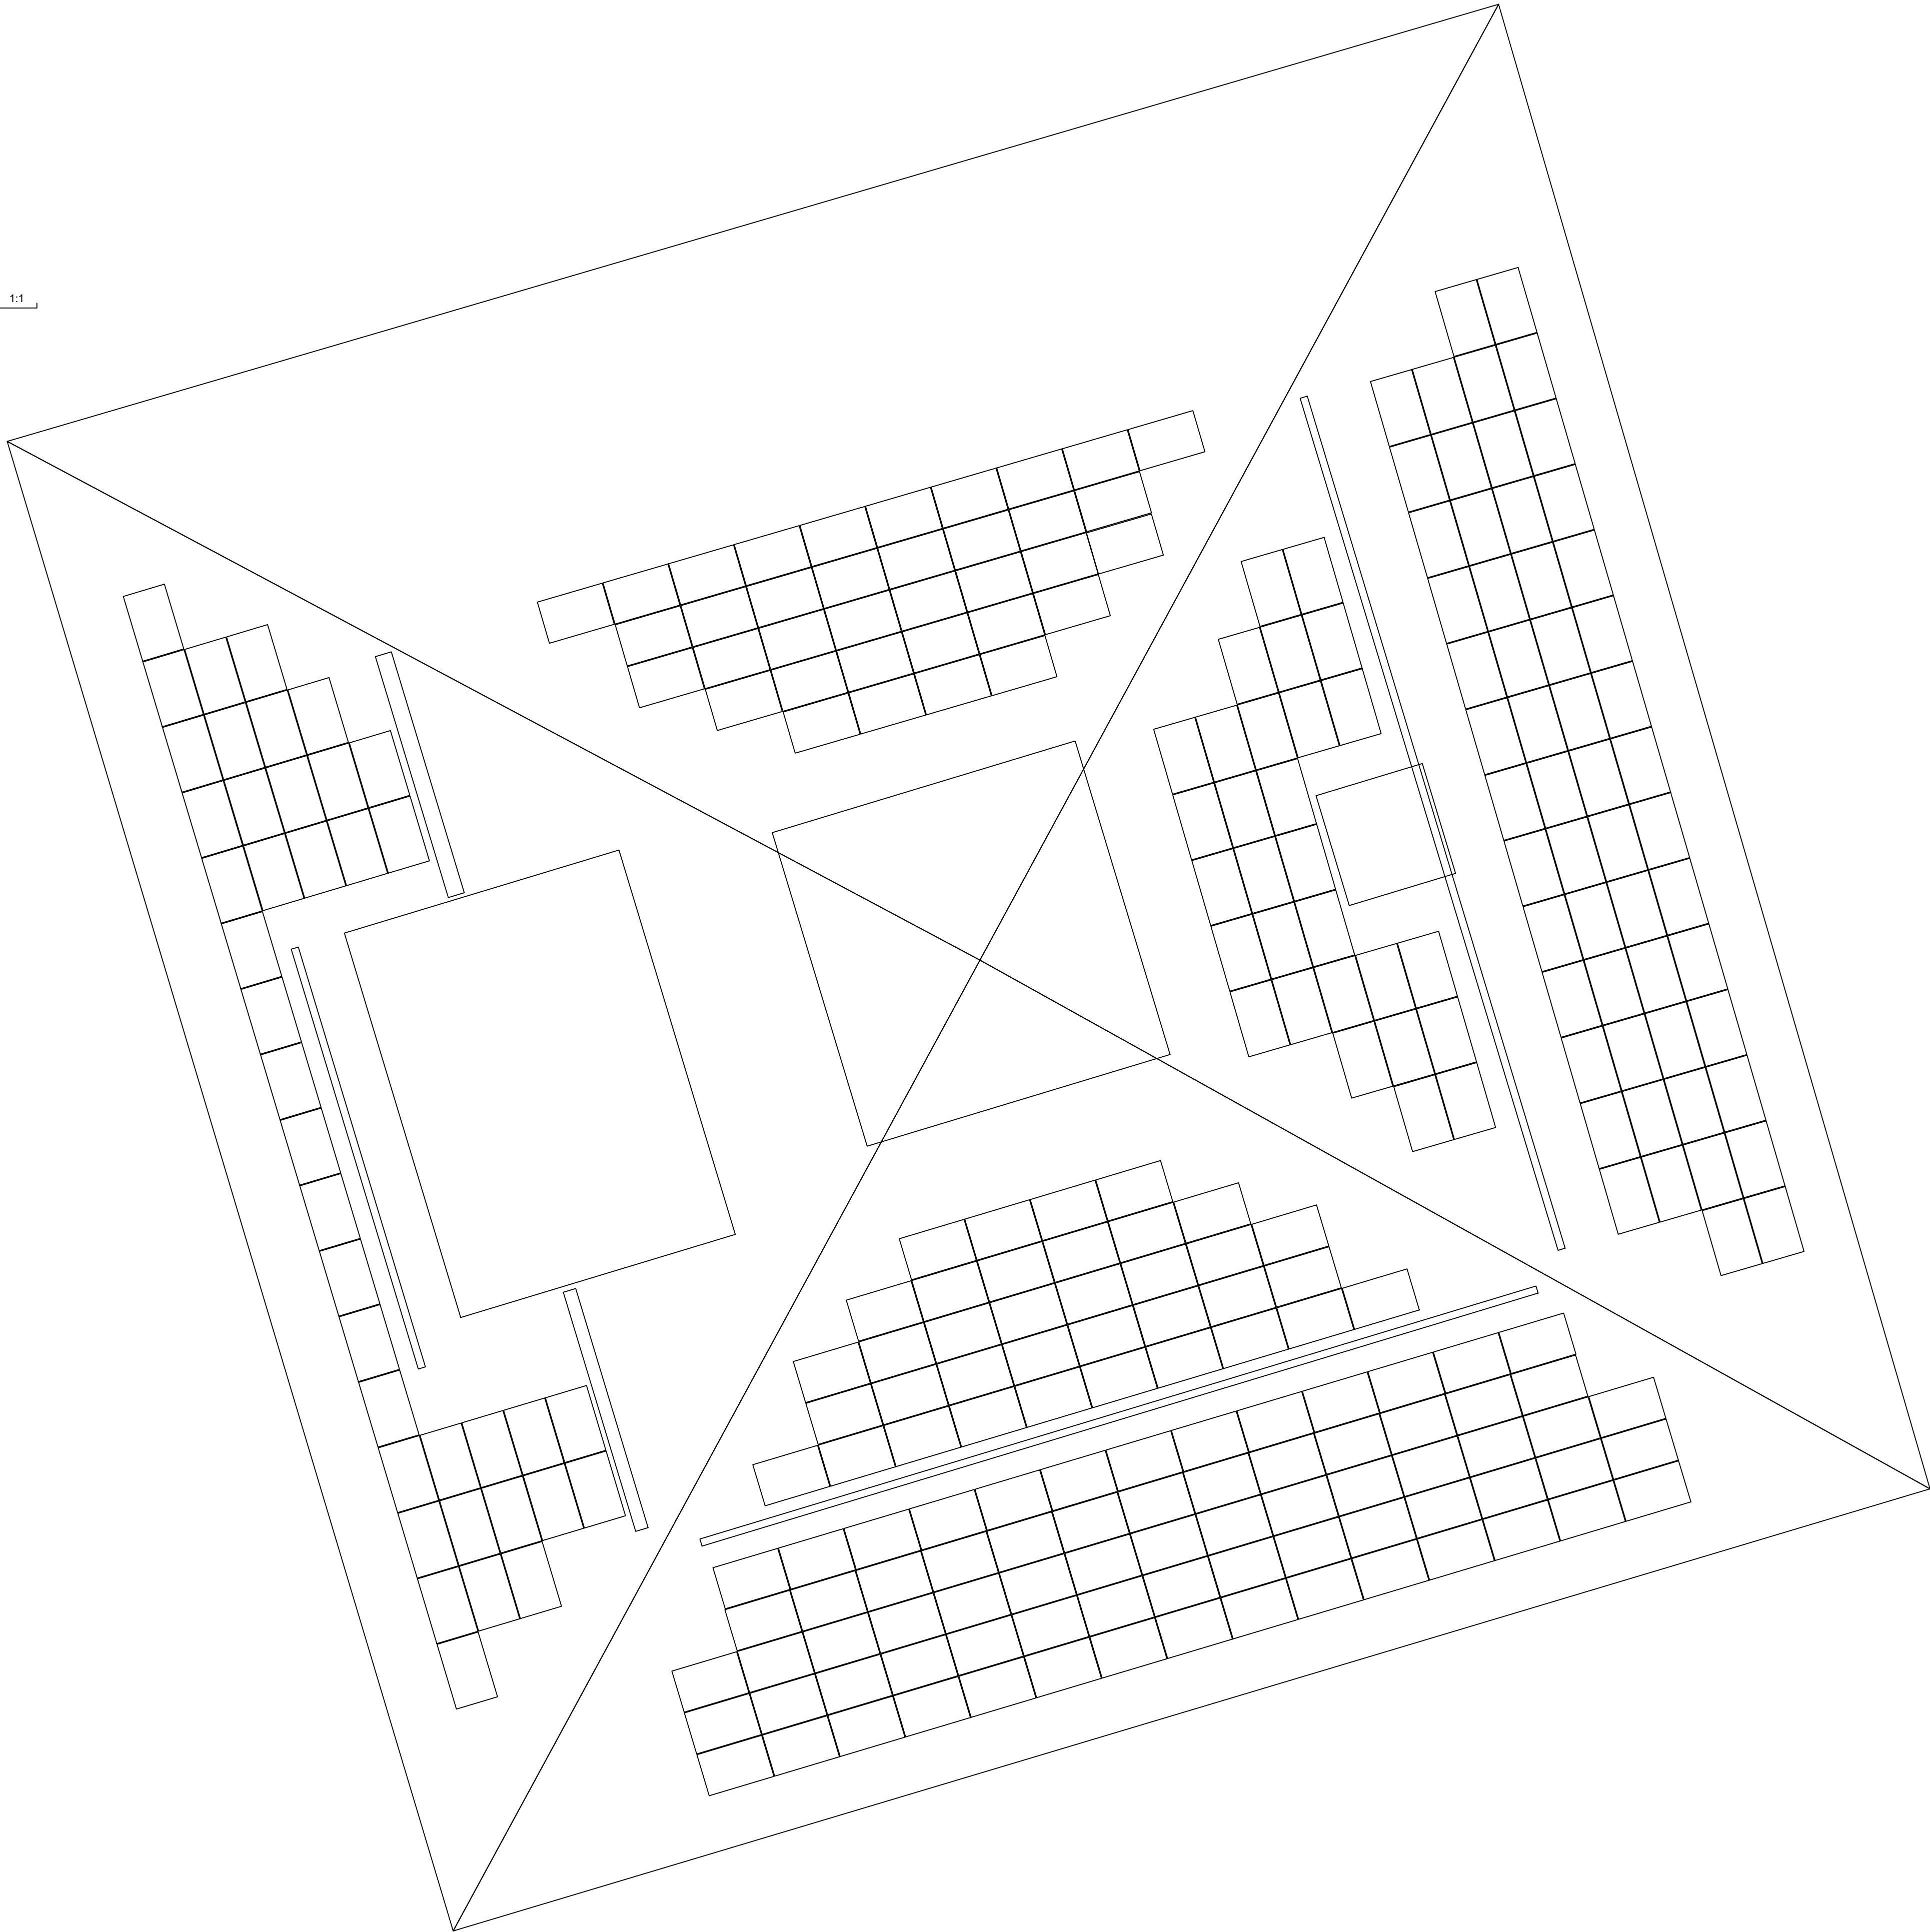

Drawing Review

As Built

General Notes

Adamson,

Towers Business Park,
Didsbury,
Manchester
M20 2YY

No.	Description	Date

DRAWING REVISIONS



Project Name
Adamson
Towers Business Park
Client
MJ Quinn Solar
CAD
Hyperion Zero Ltd.
Drawing Title
Adamson As Built Roof
Layout

Project Number HZ-MJQ-022	Drawing Number TOW-005	
First Issue Date 24/01/2024	Drawn GD	Revision
Scale 1:100	Checked GD	