
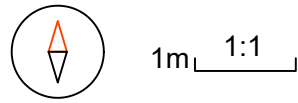


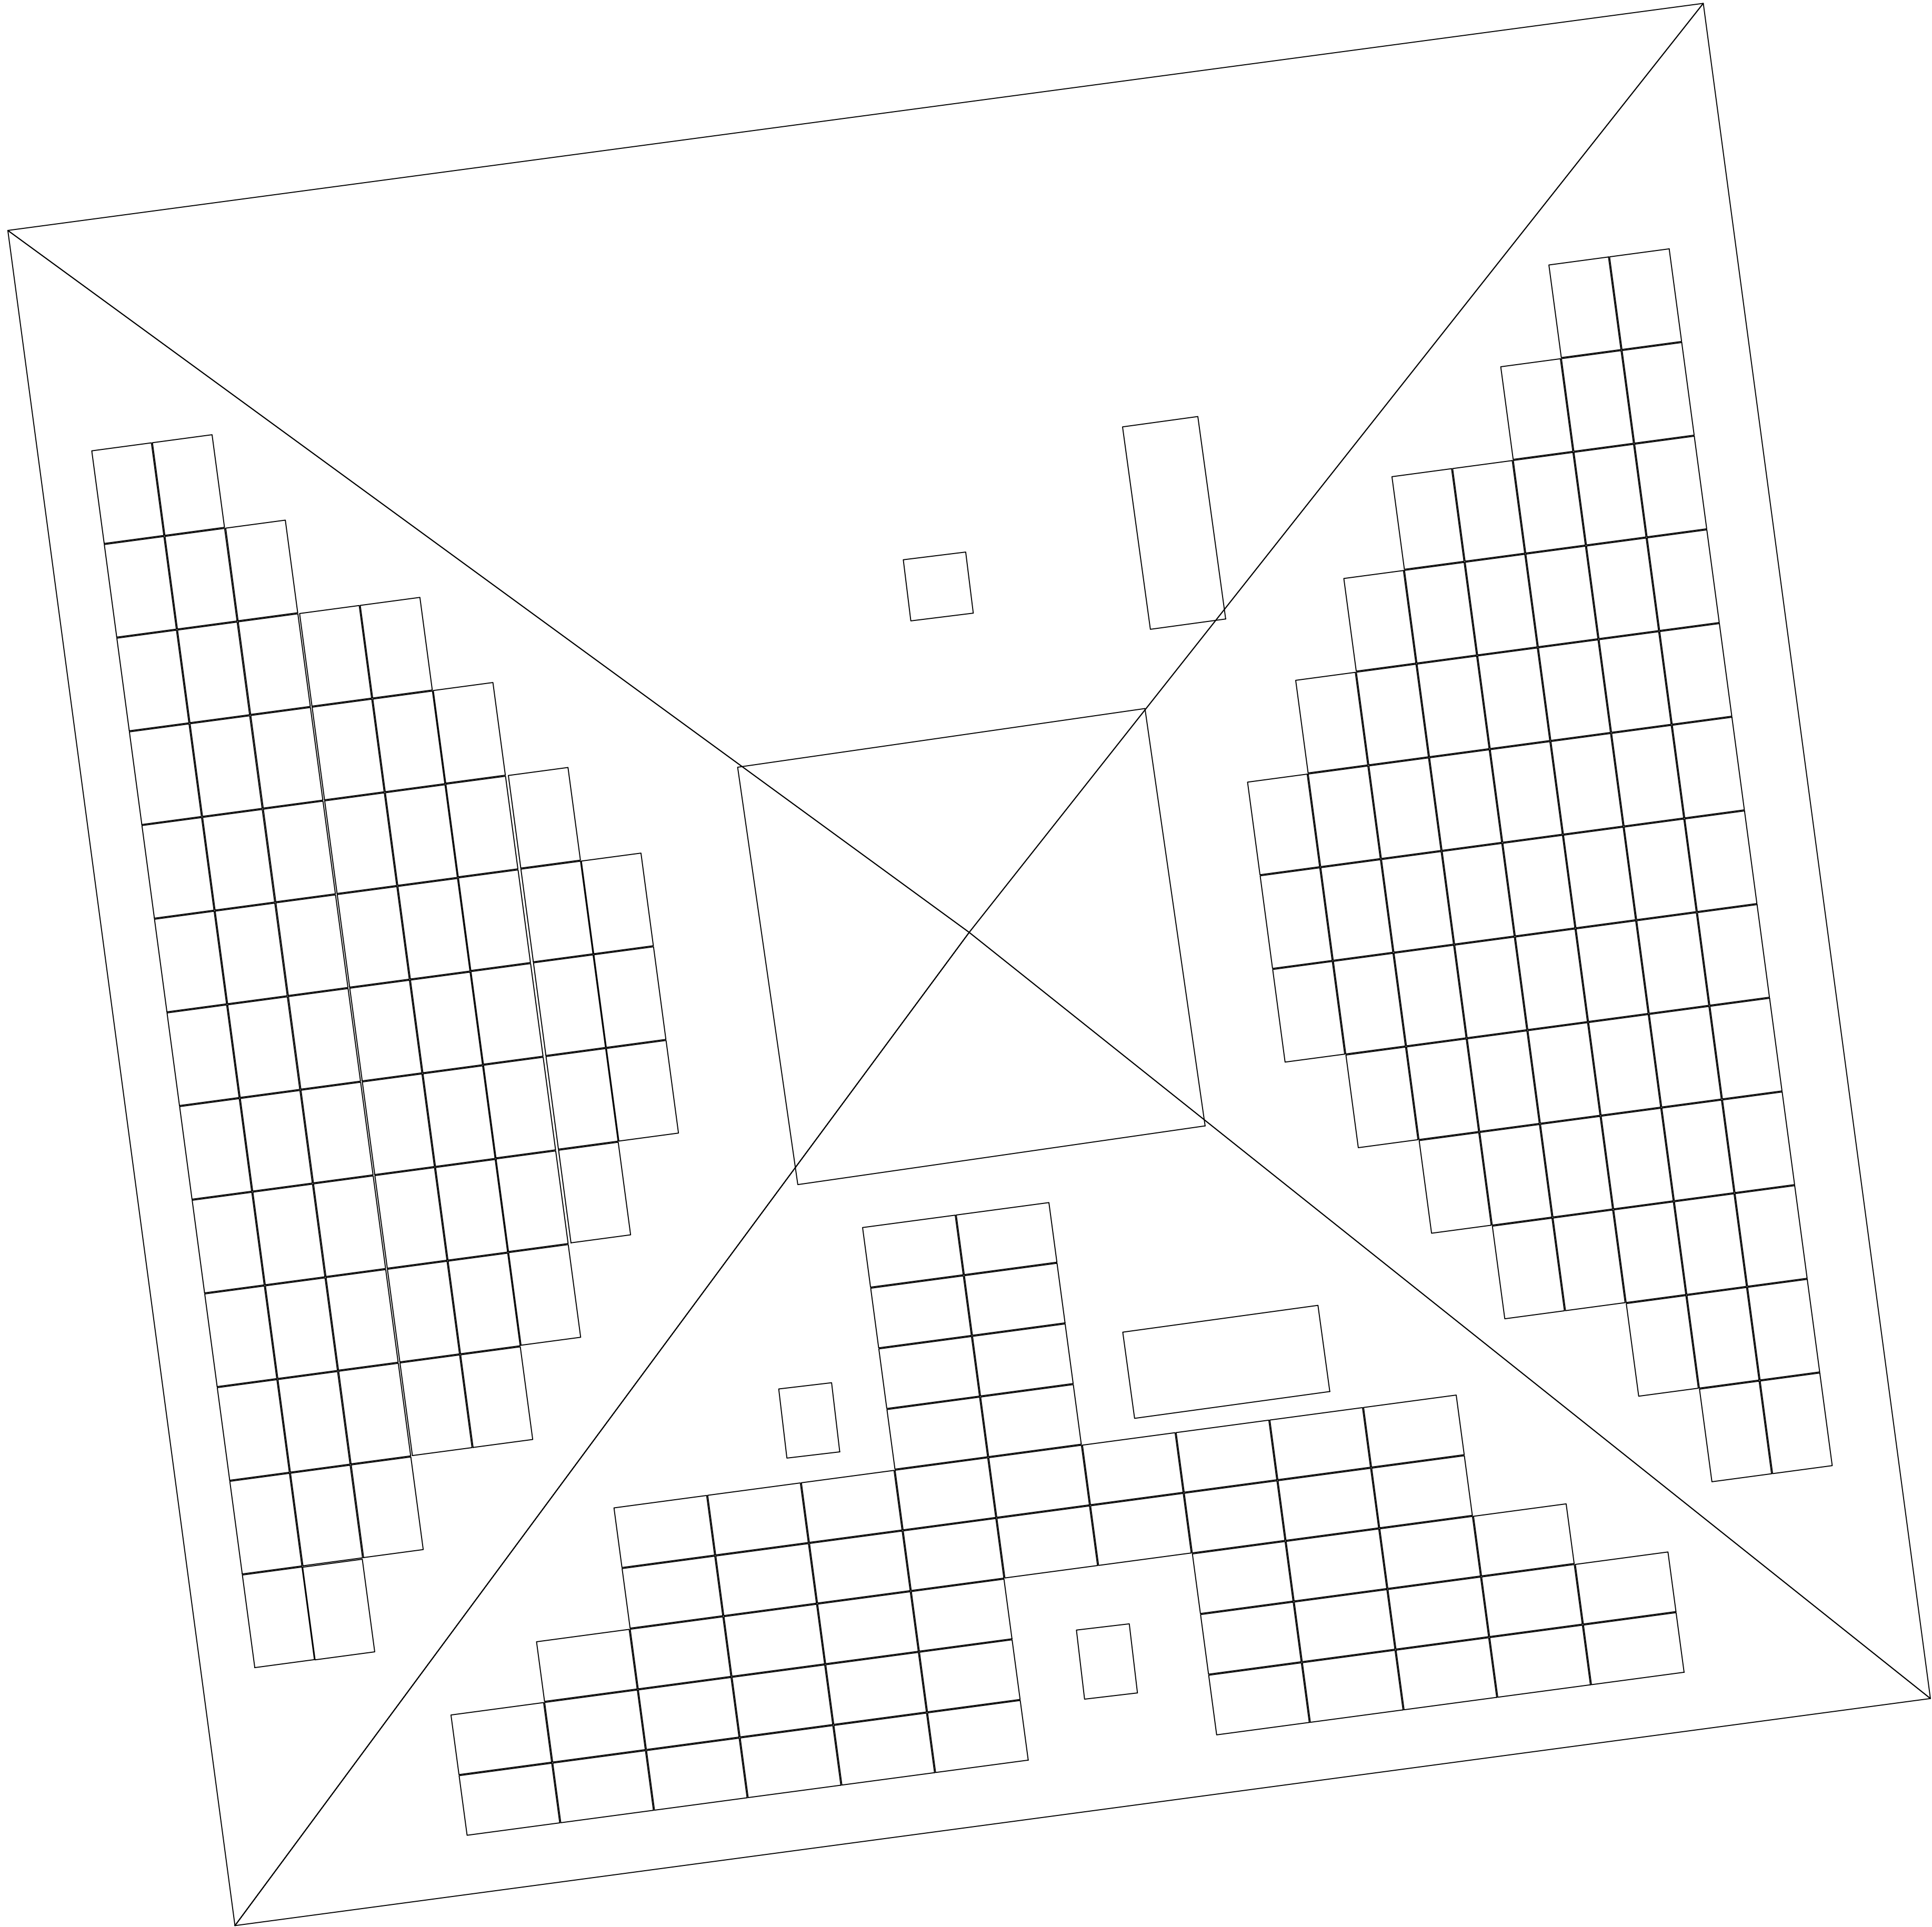

Drawing Review

As Built

General Notes

Worthington,

Towers Business Park,
Didsbury,
Manchester
M20 2YY

No.	Description	Date
DRAWING REVISIONS		



Project Name
Worthington
Towers Business Park
Client
MJ Quinn Solar
CAD
Hyperion Zero Ltd.
Drawing Title
Worthington As Built Roof
Layout

Project Number HZ-MJQ-022	Drawing Number TOW-002	
First Issue Date 24/01/2024	Drawn GD	Revision
Scale 1:75	Checked GD	