




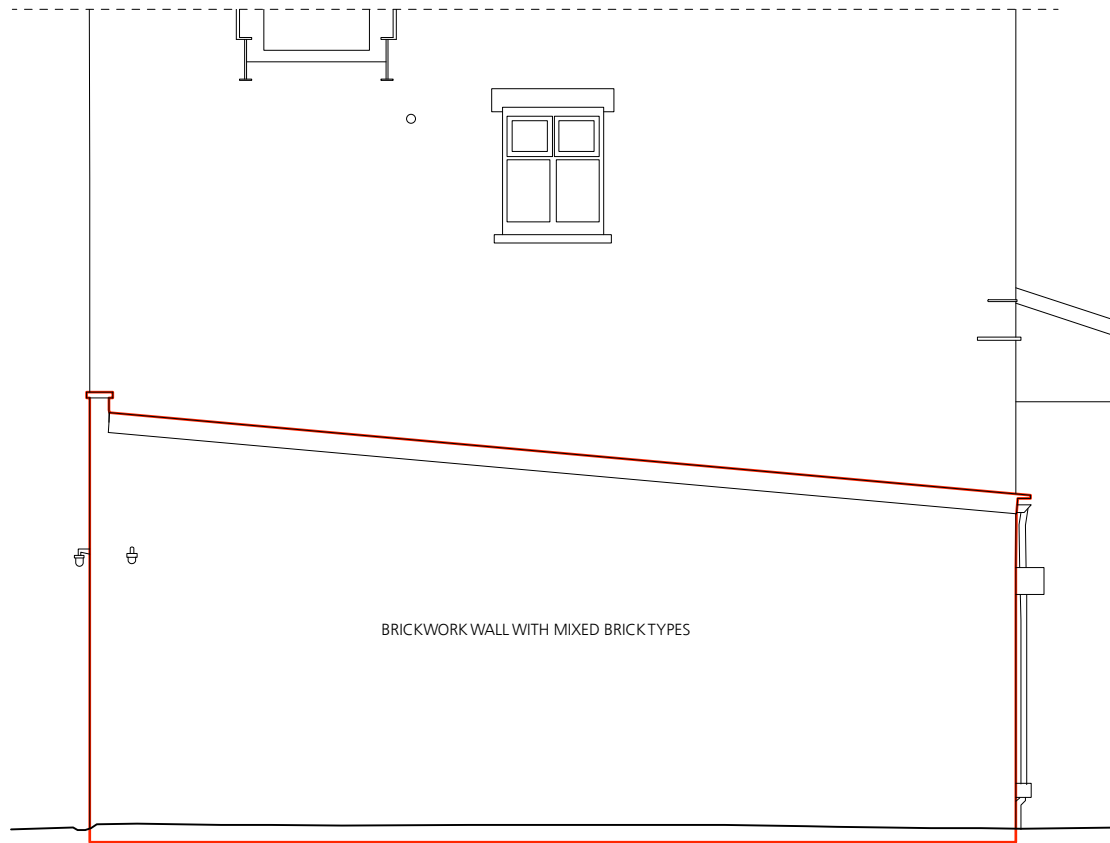


ELEVATION A

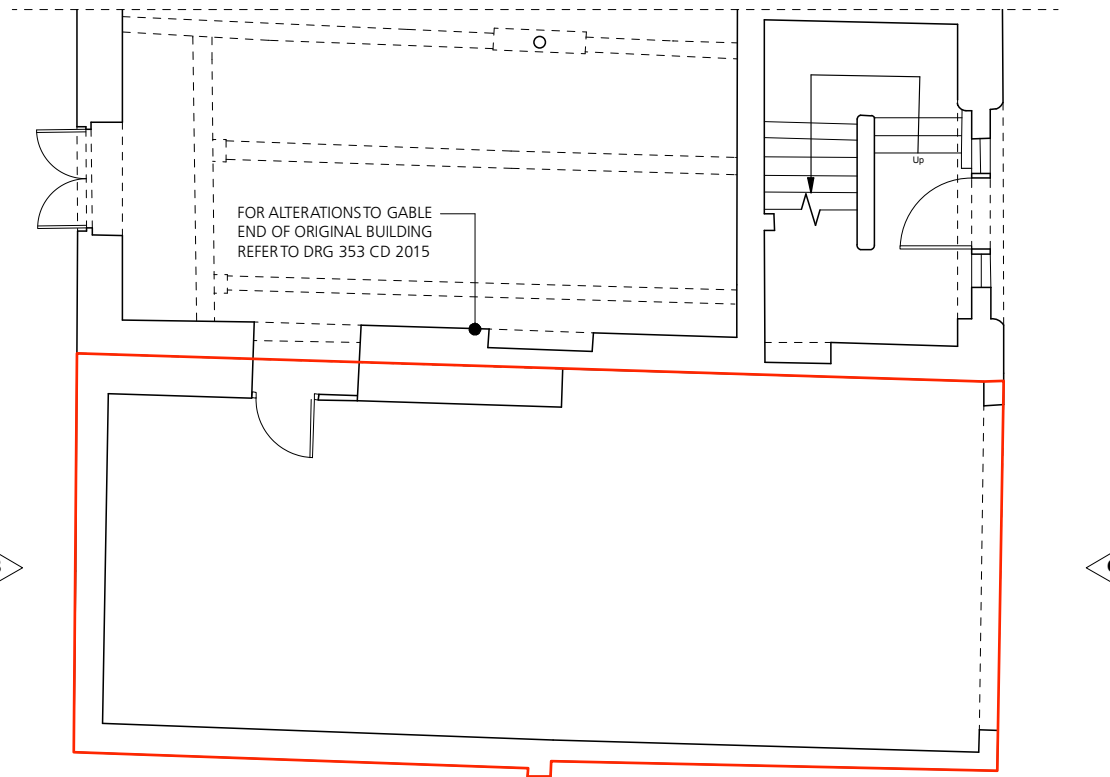

GROUND FLOOR PLAN

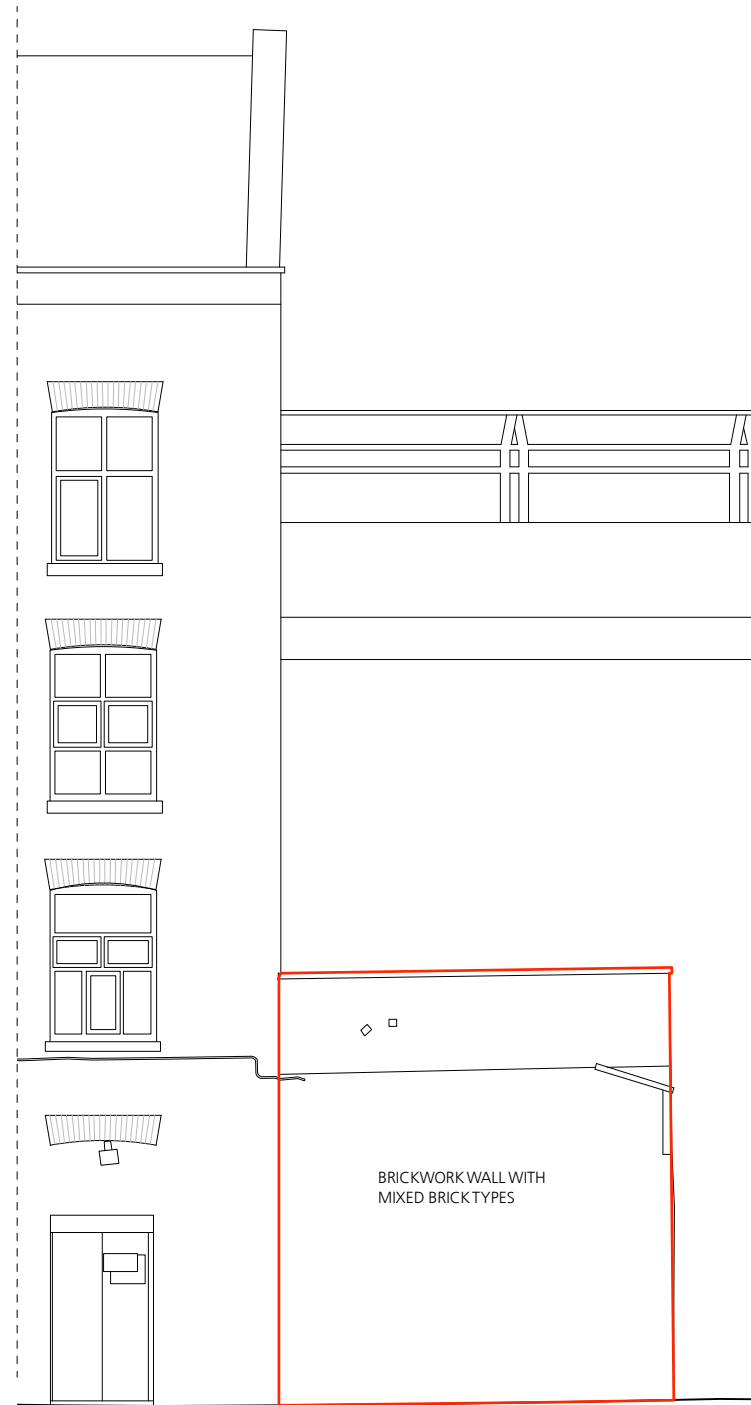


ELEVATION B

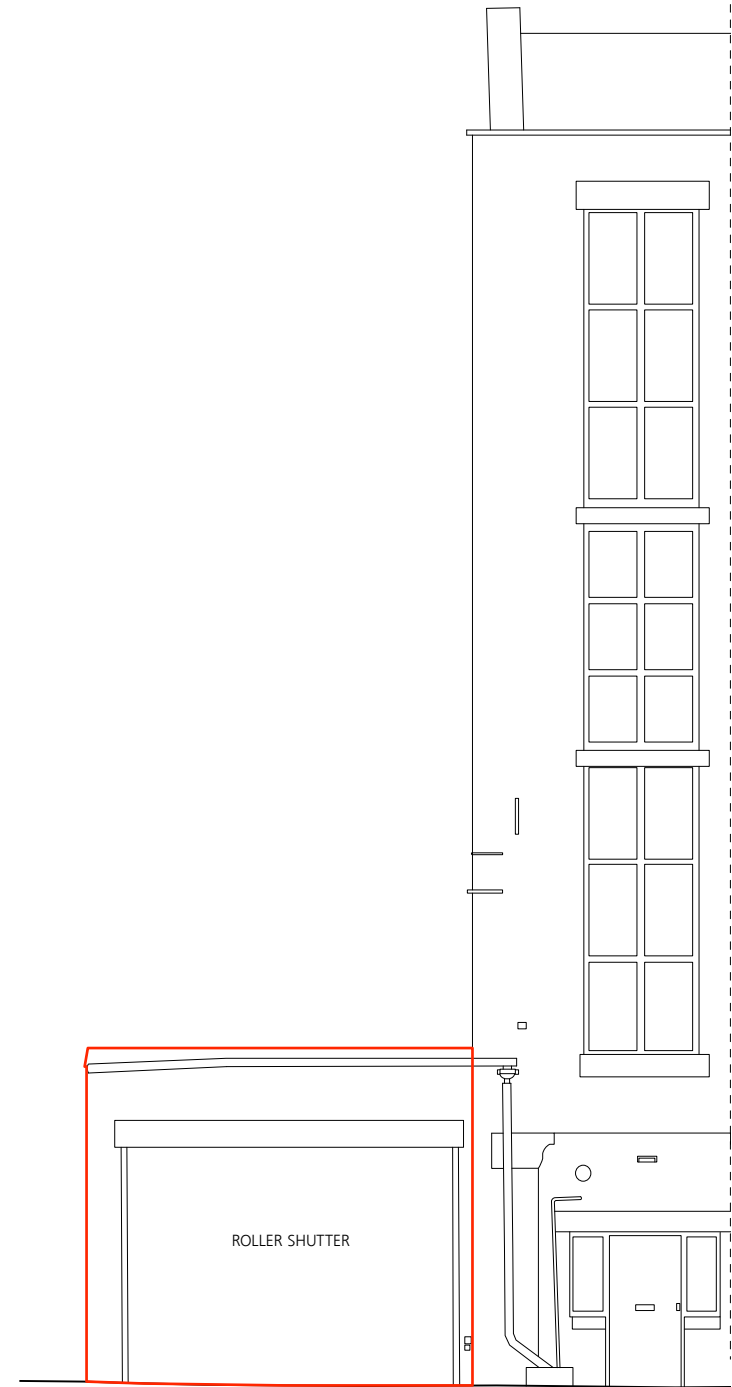

ELEVATION C

REDLINE INDICATES EXTENT OF SINGLE STOREY OFFSHOOT TO BE REMOVED TO INCLUDE WALLS, CORRUGATED ROOF COVERING, STEEL BEAMS AND FLOOR STRUCTURE.

ALL MATERIALS ARISING TO BE RETAINED FOR POTENTIAL INCORPORATION INTO LANDSCAPE PROPOSALS. REFER TO LANDSCAPE DESIGNERS INFORMATION

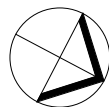

0 1 2 3 4 5
Metres

Jonathan Davidson Architects

Architecture & Industrial Design | 47 Hilton Street
MANCHESTER
M1 2EF
t: 0161 711 0835
e: inbox@jddavidsonarchitects.com
w: www.jddavidsonarchitects.com

Client Capital & Centric
Project **Neptune Mill**
Chapelton St, Manchester
Scale 1:100 @ A3
Date March 2023

Document **Fabric Alterations**
Offshoot to East Gable
Status For information

Doc Ref 353 CD 2011 T1

Rev T1 - 11/23 -Tender issue