
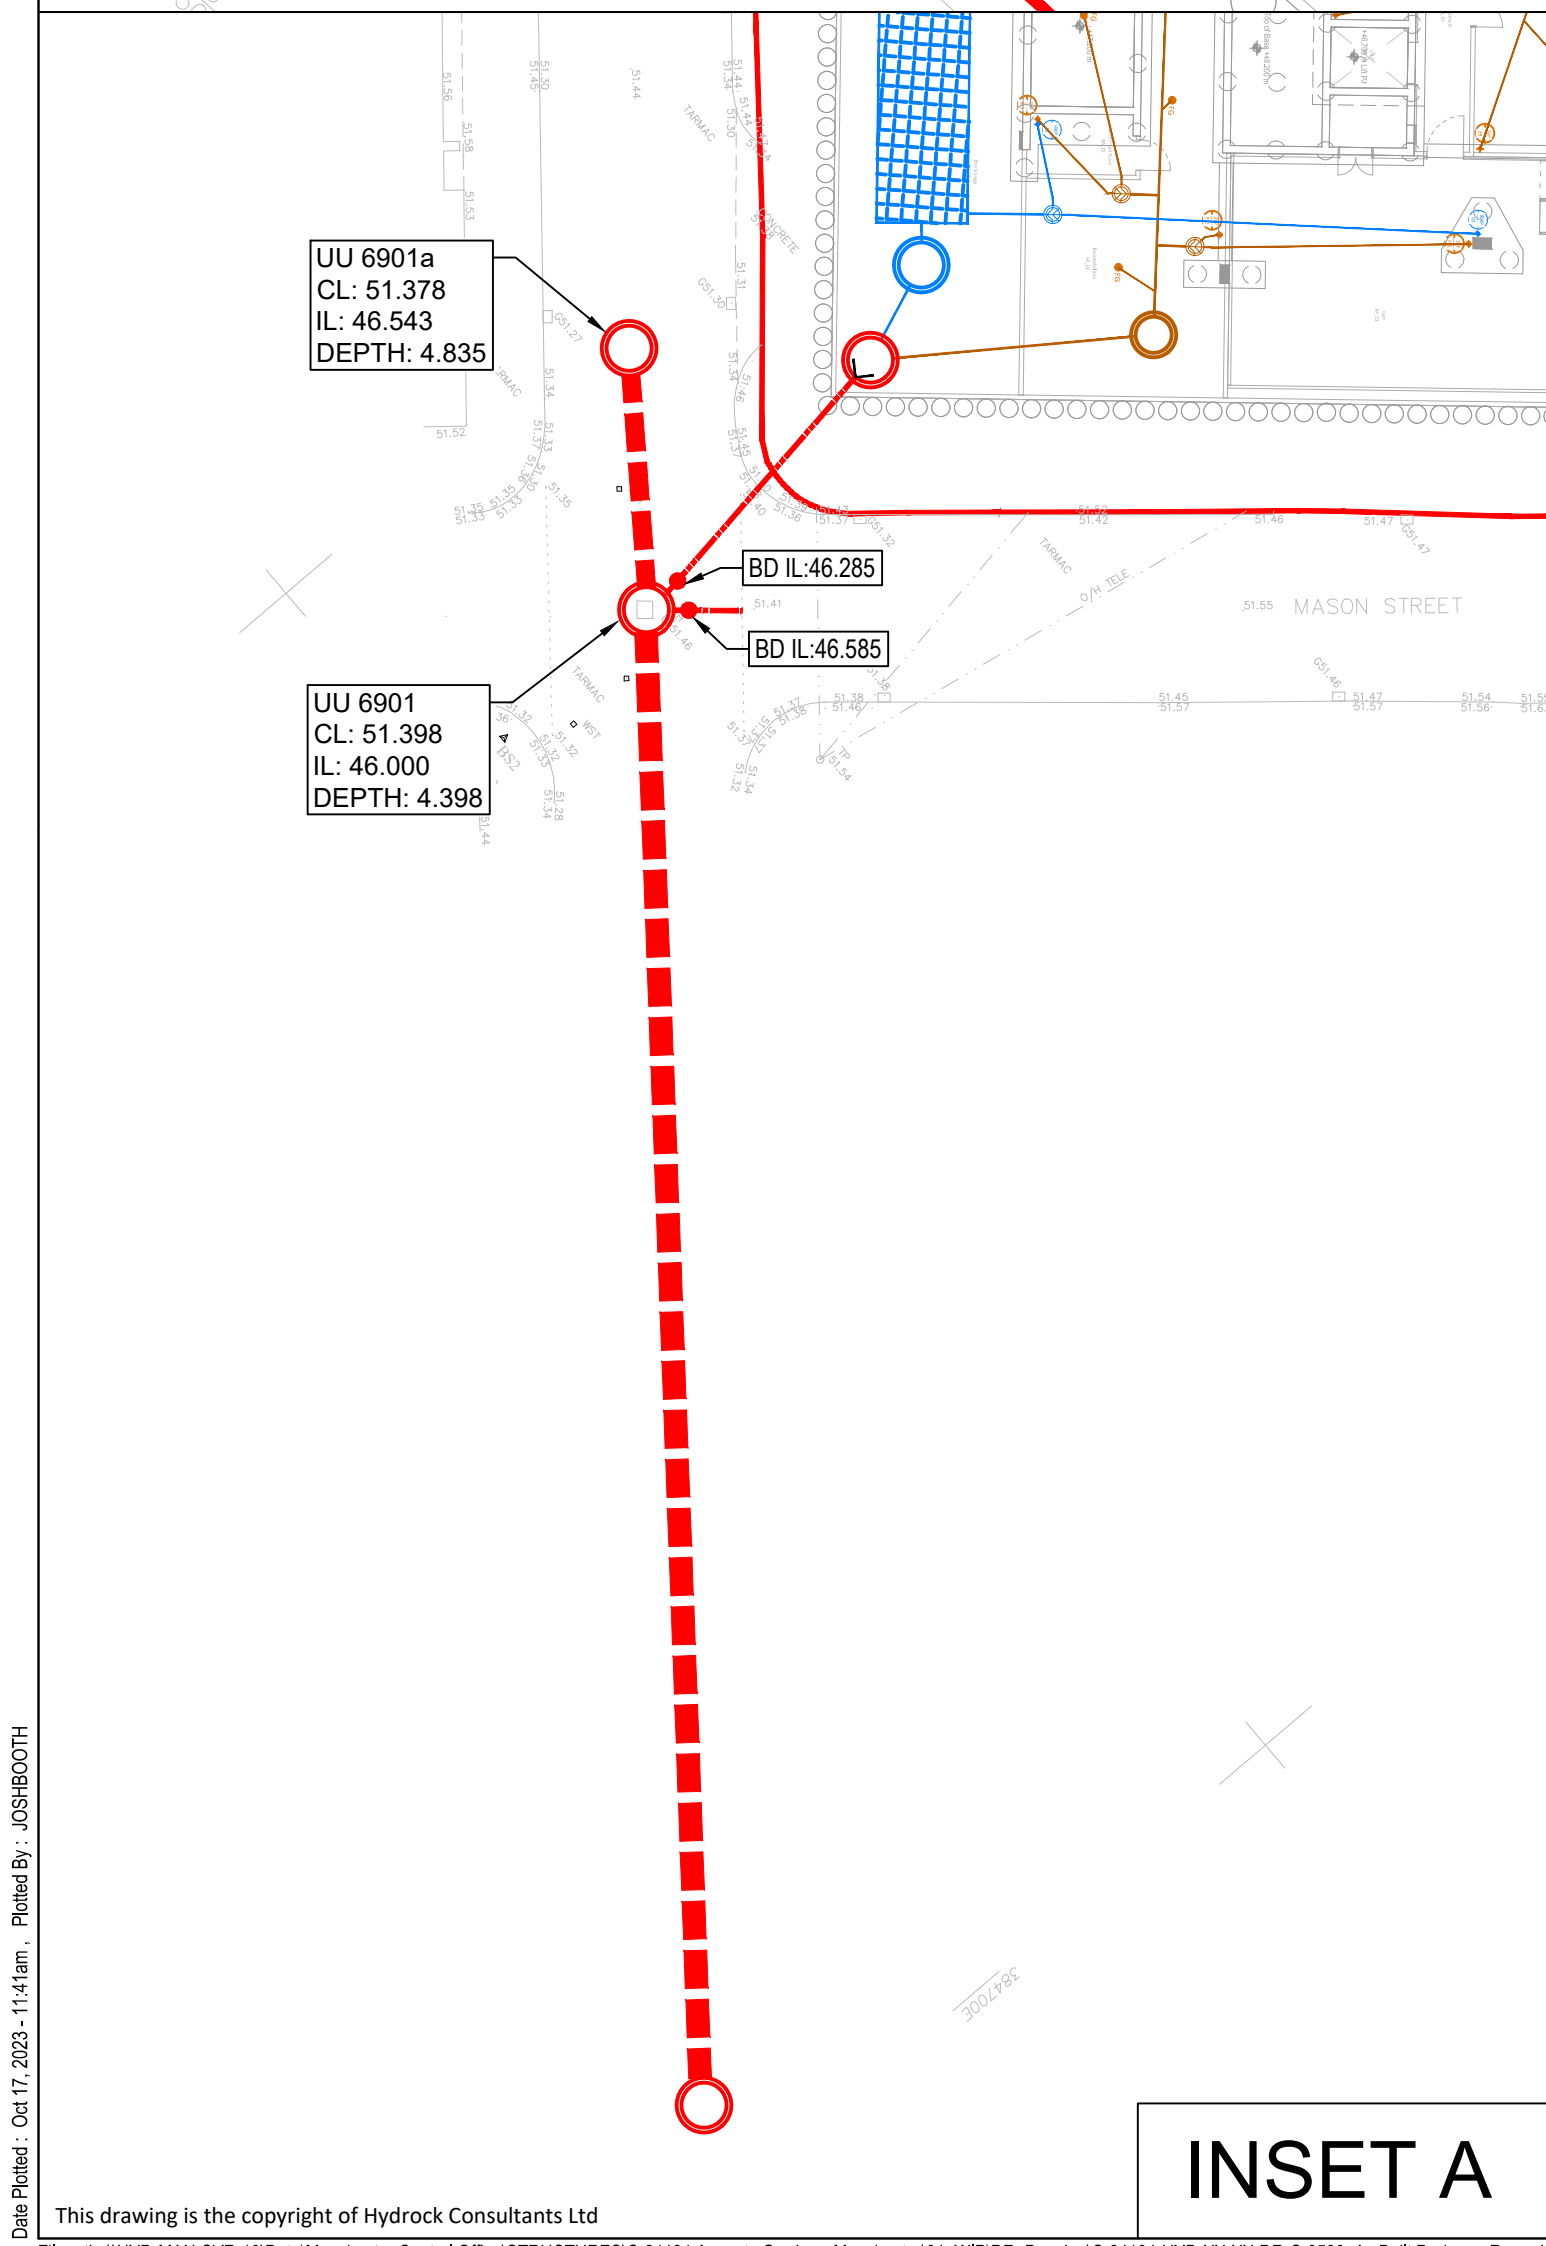


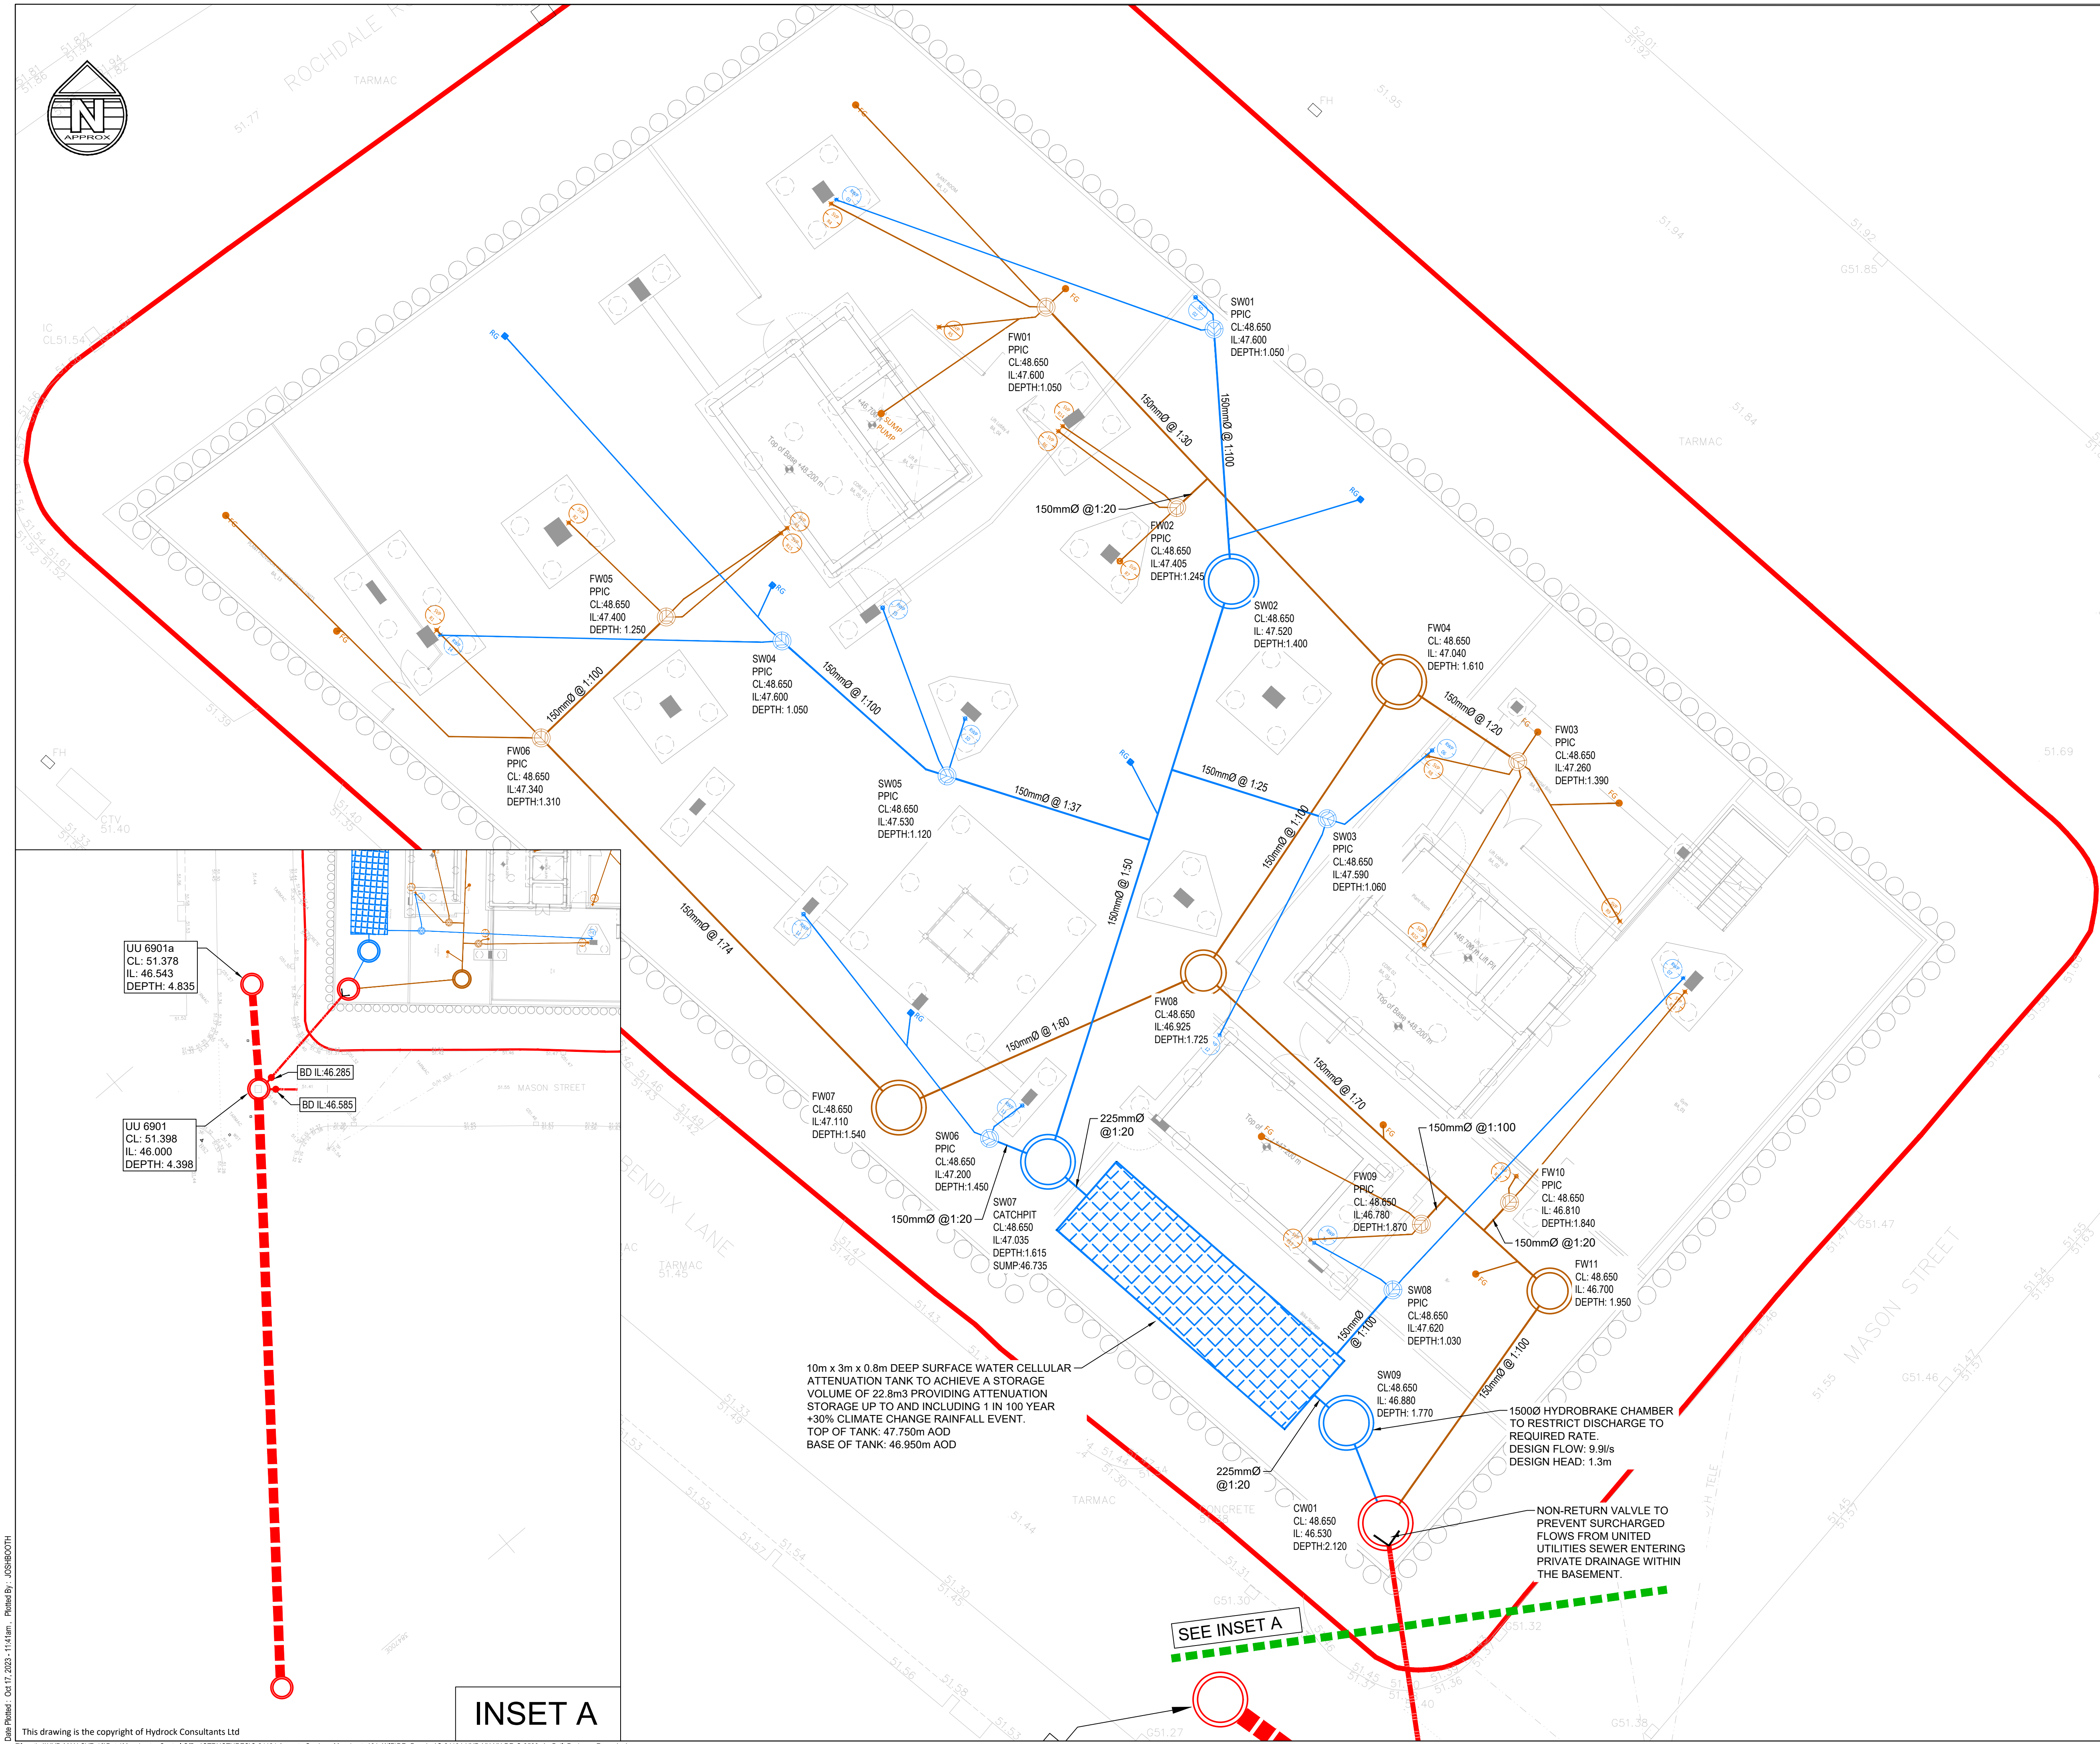

NOTES

1. THIS DRAWING IS NOT TO BE SCALED.

2. ALL DIMENSIONS AND LEVELS ARE TO BE CHECKED ON SITE BEFORE THE COMMENCEMENT OF WORKS. ANY DISCREPANCIES ARE TO BE REPORTED TO THE ARCHITECT AND ENGINEER FOR VERIFICATION. FIGURED DIMENSIONS ONLY ARE TO BE TAKEN FROM THIS DRAWING.

3. THIS DRAWING IS TO BE READ IN CONJUNCTION WITH ALL RELEVANT ENGINEERS' AND SERVICE ENGINEERS' DRAWINGS AND SPECIFICATIONS.

4. ALL LEVELS ARE IN METRES UNLESS NOTED OTHERWISE

5. EXISTING GROUND INFORMATION SHOWN ON THIS DRAWING IS ARE BASED UPON TOPOGRAPHICAL SURVEY "LS065-CCTV Bendix Street" DATED 30.06.2022.

NOTE:

THIS DRAWING IS BASED ON AS-CONSTRUCTED INFORMATION PROVIDED BY THE CONTRACTOR.

AB2	UNITED UTILITIES SEWER AS BUILTS					
	J. BOOTH	17.10.23	J. GREENE	17.10.23	N. BYRNE	17.10.23
AB1	AS BUILT RECORDS					
	J. MANTLE	01.08.23	J. BOOTH	01.08.23	N. BYRNE	01.08.23
REV	REVISION NOTES/COMMENTS					
	DRAWN BY	DATE	CHECKED BY	DATE	APPROVED BY	DATE

Hydrock

North Assurance Buildings
9-21 Princess Street, St Alberts Square
Manchester
M2 4DN
t: +44(0)161 804 5550
e: manchester@hydrock.com

CLIENT

BEECH DEVELOPMENTS

PROJECT

ANCOATS GARDEN, MANCHESTER

TITLE

AS BUILT DRAINAGE RECORDS

HYDROCK PROJECT NO.	SCALE @ A1
C-24134	1:200
STATUS DESCRIPTION	STATUS
AS BUILT RECORDS	
DRAWING NO. (PROJECT CODE-ORIGINATOR-ZONE-LEVEL-TYPE-ROLE-NUMBER)	REVISION
C-24134-HYD-XX-XX-DR-C-0530	AB2

Date Plotted: 04/17/2023 - 11:41am
Plotted By: J059B00TH

This drawing is the copyright of Hydrock Consultants Ltd
Filepath: \\HYD-MAN-SVR-10\Data\Manchester Central Office\STRUCTURES\C-24134-HYD-XX-XX-DR-C-0530_As Built Drainage Records.dwg

INSET A