

IMPORTANT NOTE:

ALL DIMENSIONS AND LEVELS SHOWN ON THIS DRAWING ARE TO BE CHECKED BY THE CONTRACTOR MANUFACTURER PRIOR TO THE COMMENCEMENT OF ANY WORKS ON SITE OR THE MANUFACTURE OF ANY SITE COMPONENTS.




THIS DRAWING IS NOT TO BE SCALED.

DIMENSIONS ARE INDICATED IN MILLIMETRES UNLESS CLEARLY STATED OTHERWISE.

COPYRIGHT OF THIS DRAWING BELONGS SOLELY TO CUBE PSL.

LIMITATIONS & THIRD PARTY CLAUSE:

WHERE PARTS OF THE PROPERTY WERE COVERED OR INACCESSIBLE AT TIME OF SURVEY POSITIONS OF ELEMENTS ARE MARKED "ASSUMED" ACCORDINGLY.

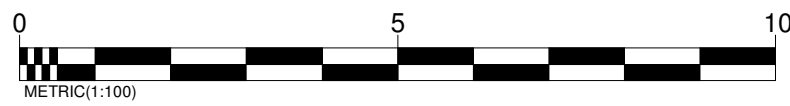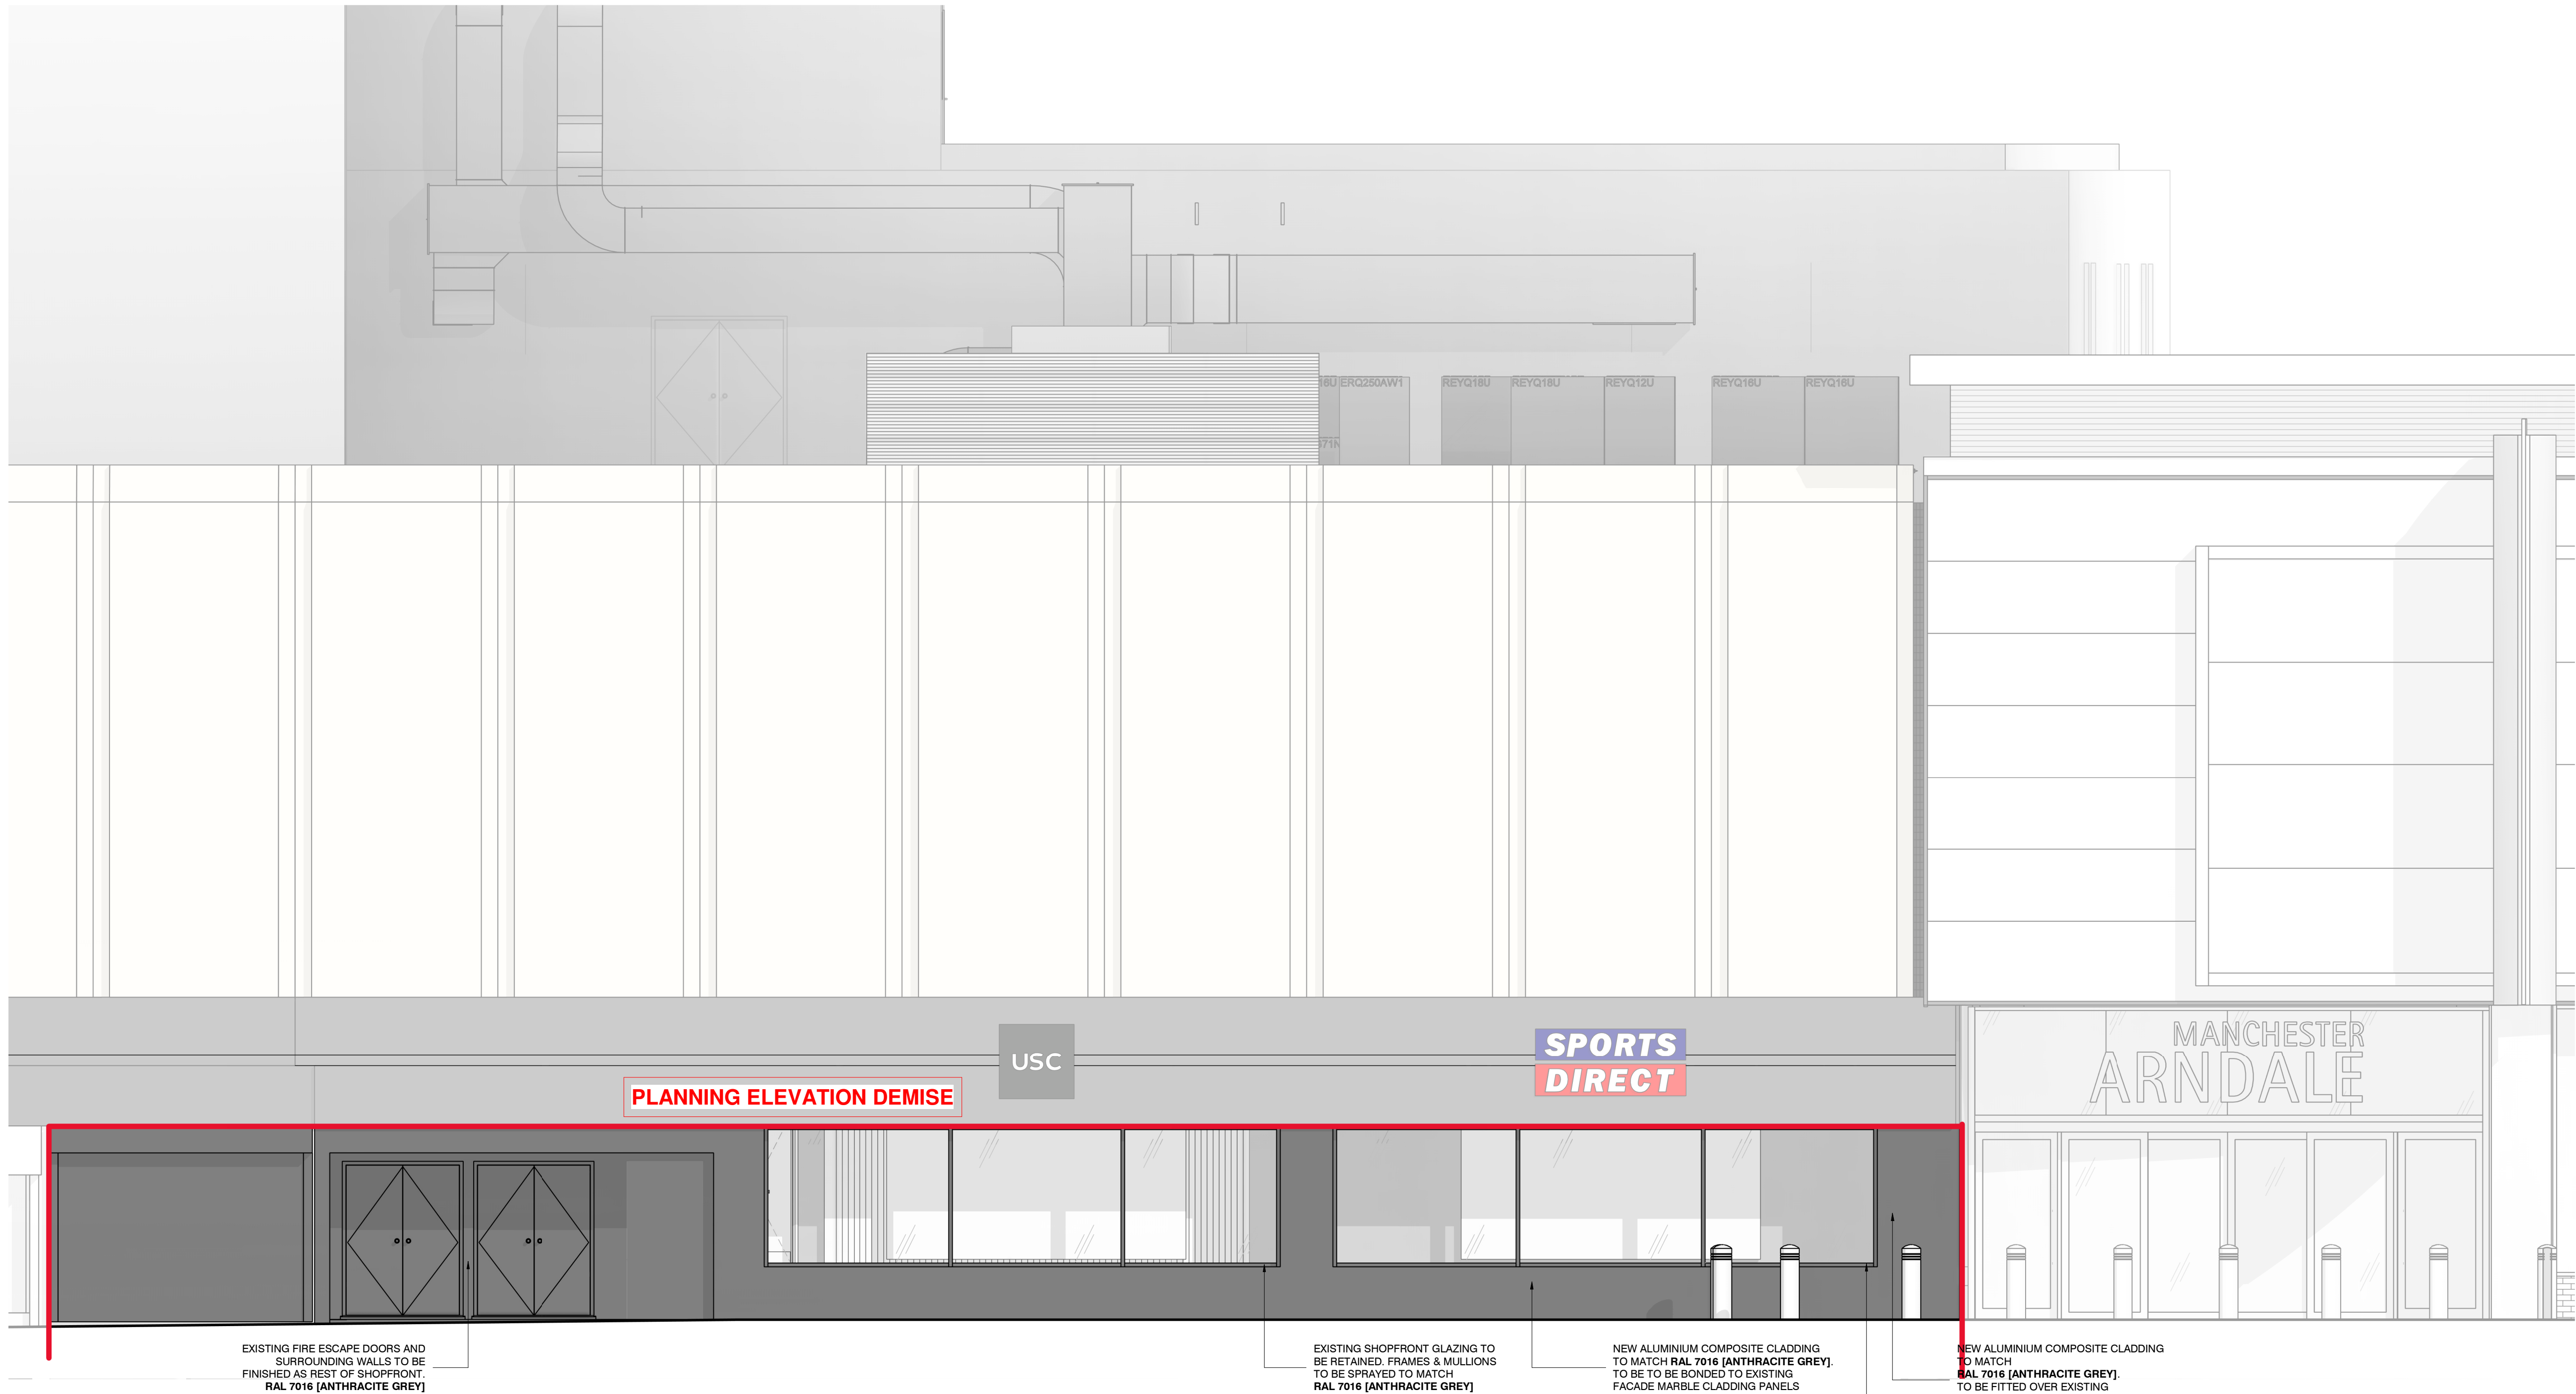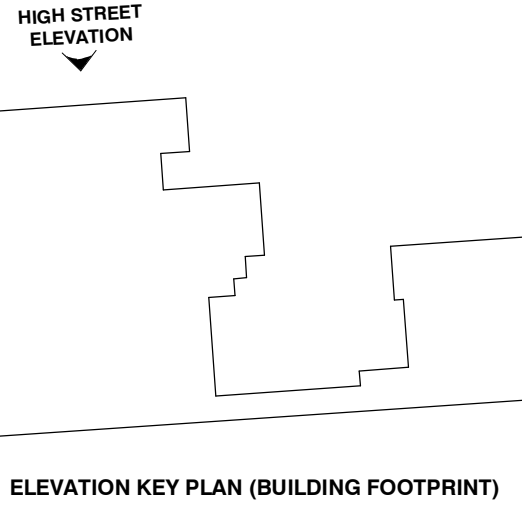

PROPOSED HIGH STREET ELEVATION FINISHES & SIGNAGE

Scale: 1 : 50

I	DRAWINGS PREPARED FOR 'AS BUILT' ISSUE	14 03 2023	RG
H	SECTION THROUGH SIGNAGE ADDED TO SHEET	07 12 2022	RG
G	AMENDS FOR PLANNING ISSUE	02 12 2022	RG
F	SONAGE PROPOSALS AMENDED TO MATCH ADJUSTMENTS BY T.O.O	22 11 2022	RG
E	SONAGE DRAWINGS AMENDED FOR PLANNING	16 08 2022	RG
D	LIGHT BONES REMOVED FROM SHOPFRONT SIGNAGE DRAWING	08 07 2022	RG
REV	DESCRIPTION	DATE	BY

REVISIONS

CLIENT			
FRASERS GROUP			
PROJECT			
MANCHESTER ARNDALE			
DRAWING TITLE			
PROPOSED HIGH ST ELEVATION FINISHES & SIGNAGE			
DRAWN BY	RG	DATE	28 06 2021
CHECKED BY	SP	SCALE	As indicated @ A1
DRAWING NO.	CPS 20 077 111 I		