




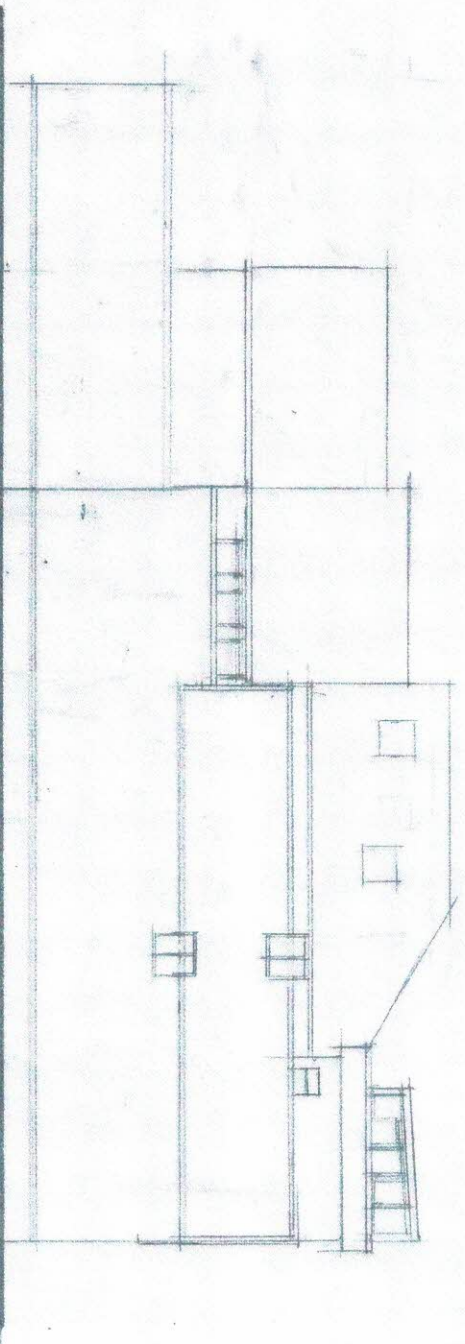

SIDE ELEVATION

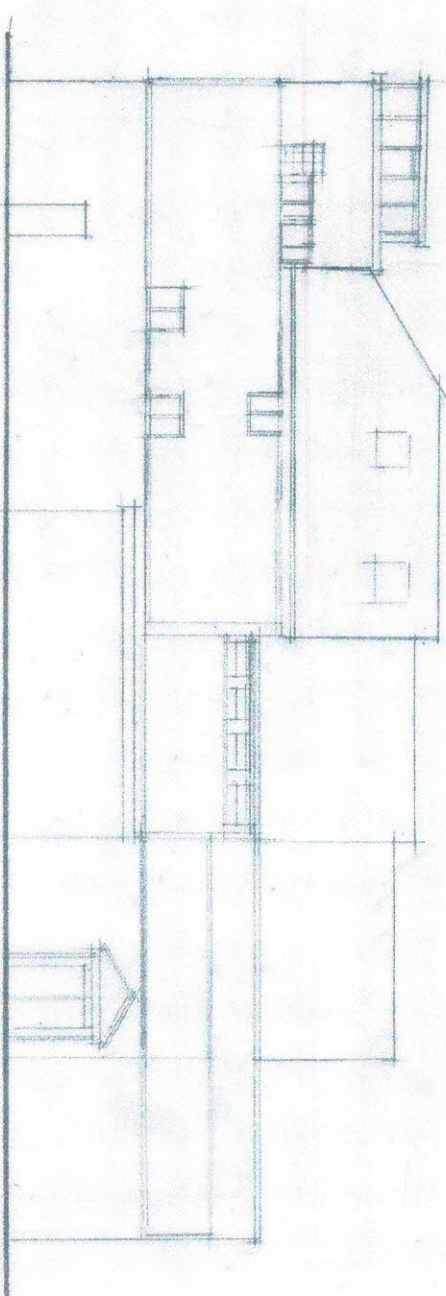


SIDE ELEVATION

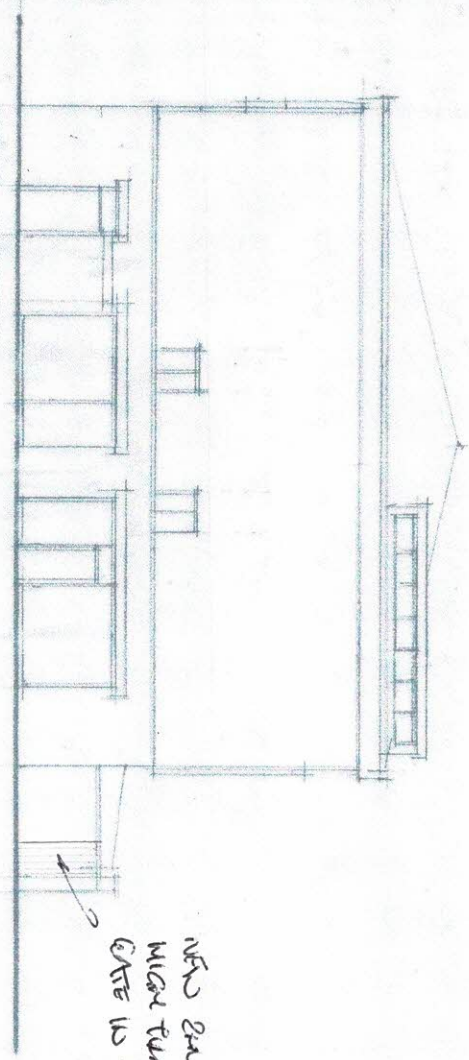


FRONT ELEVATION


new 2nd
floor
entrance
is ex wall

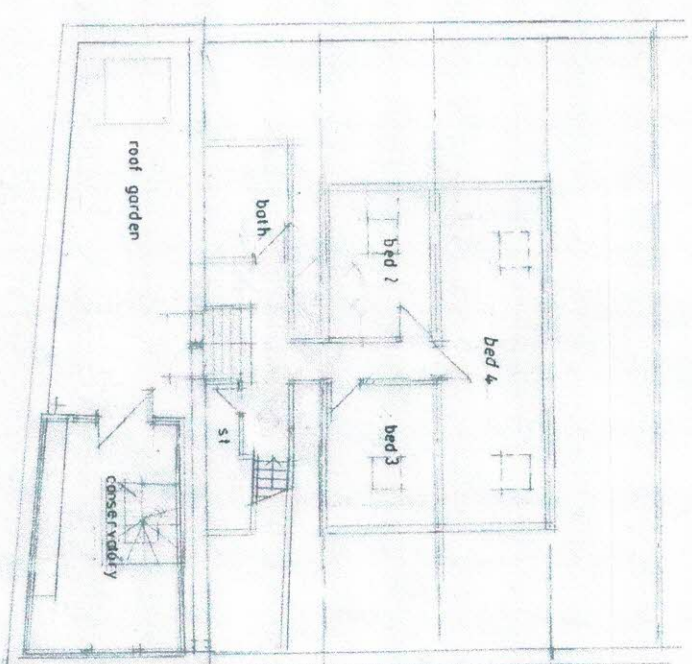

THIRD FLOOR PLAN

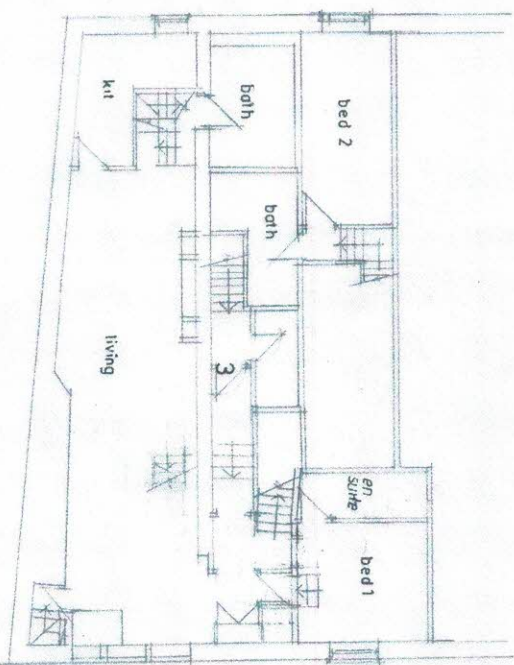


SECOND FLOOR PLAN

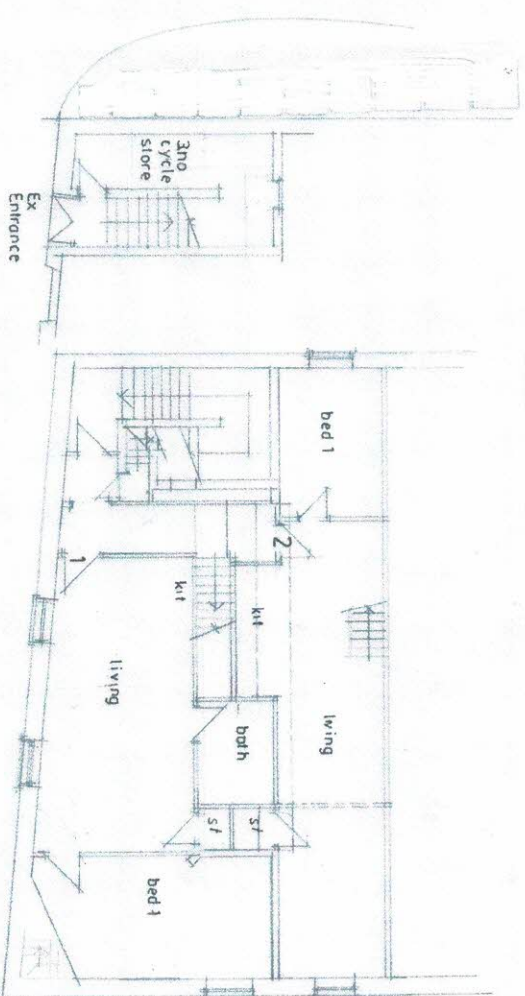

FIRST FLOOR PLAN

PART GROUND FLOOR PLAN

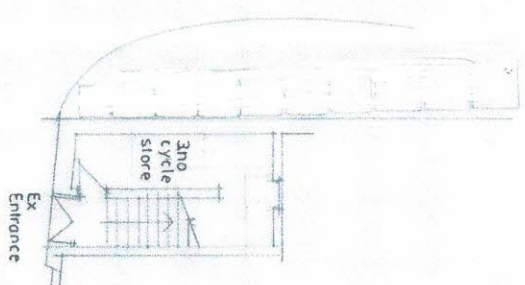

CLIENT		MR. H. RAZZAQ						
2-4 THORP ROAD		MANCHESTER M40 5BQ						
JOB TITLE		PROPOSED NEW FLATS						
DRG. TITLE		PLANS AND ELEVATIONS AS CONSTRUCTED						
HOLBOROW + ORMESHER +		architectural & interior design						
Station House		Adams Hill						
Knuttsford		Cheshire WA16 6DN						
telephone : 01566 662275		fax : 01566 788501						
ISSUE	DATE	1	2	3	4	5	6	7
REVISION								
DRAWN								
CHECKED								
APPROVED								
SCALE	1:100 at A1							
DRAWING NUMBER	1721/19/03							