


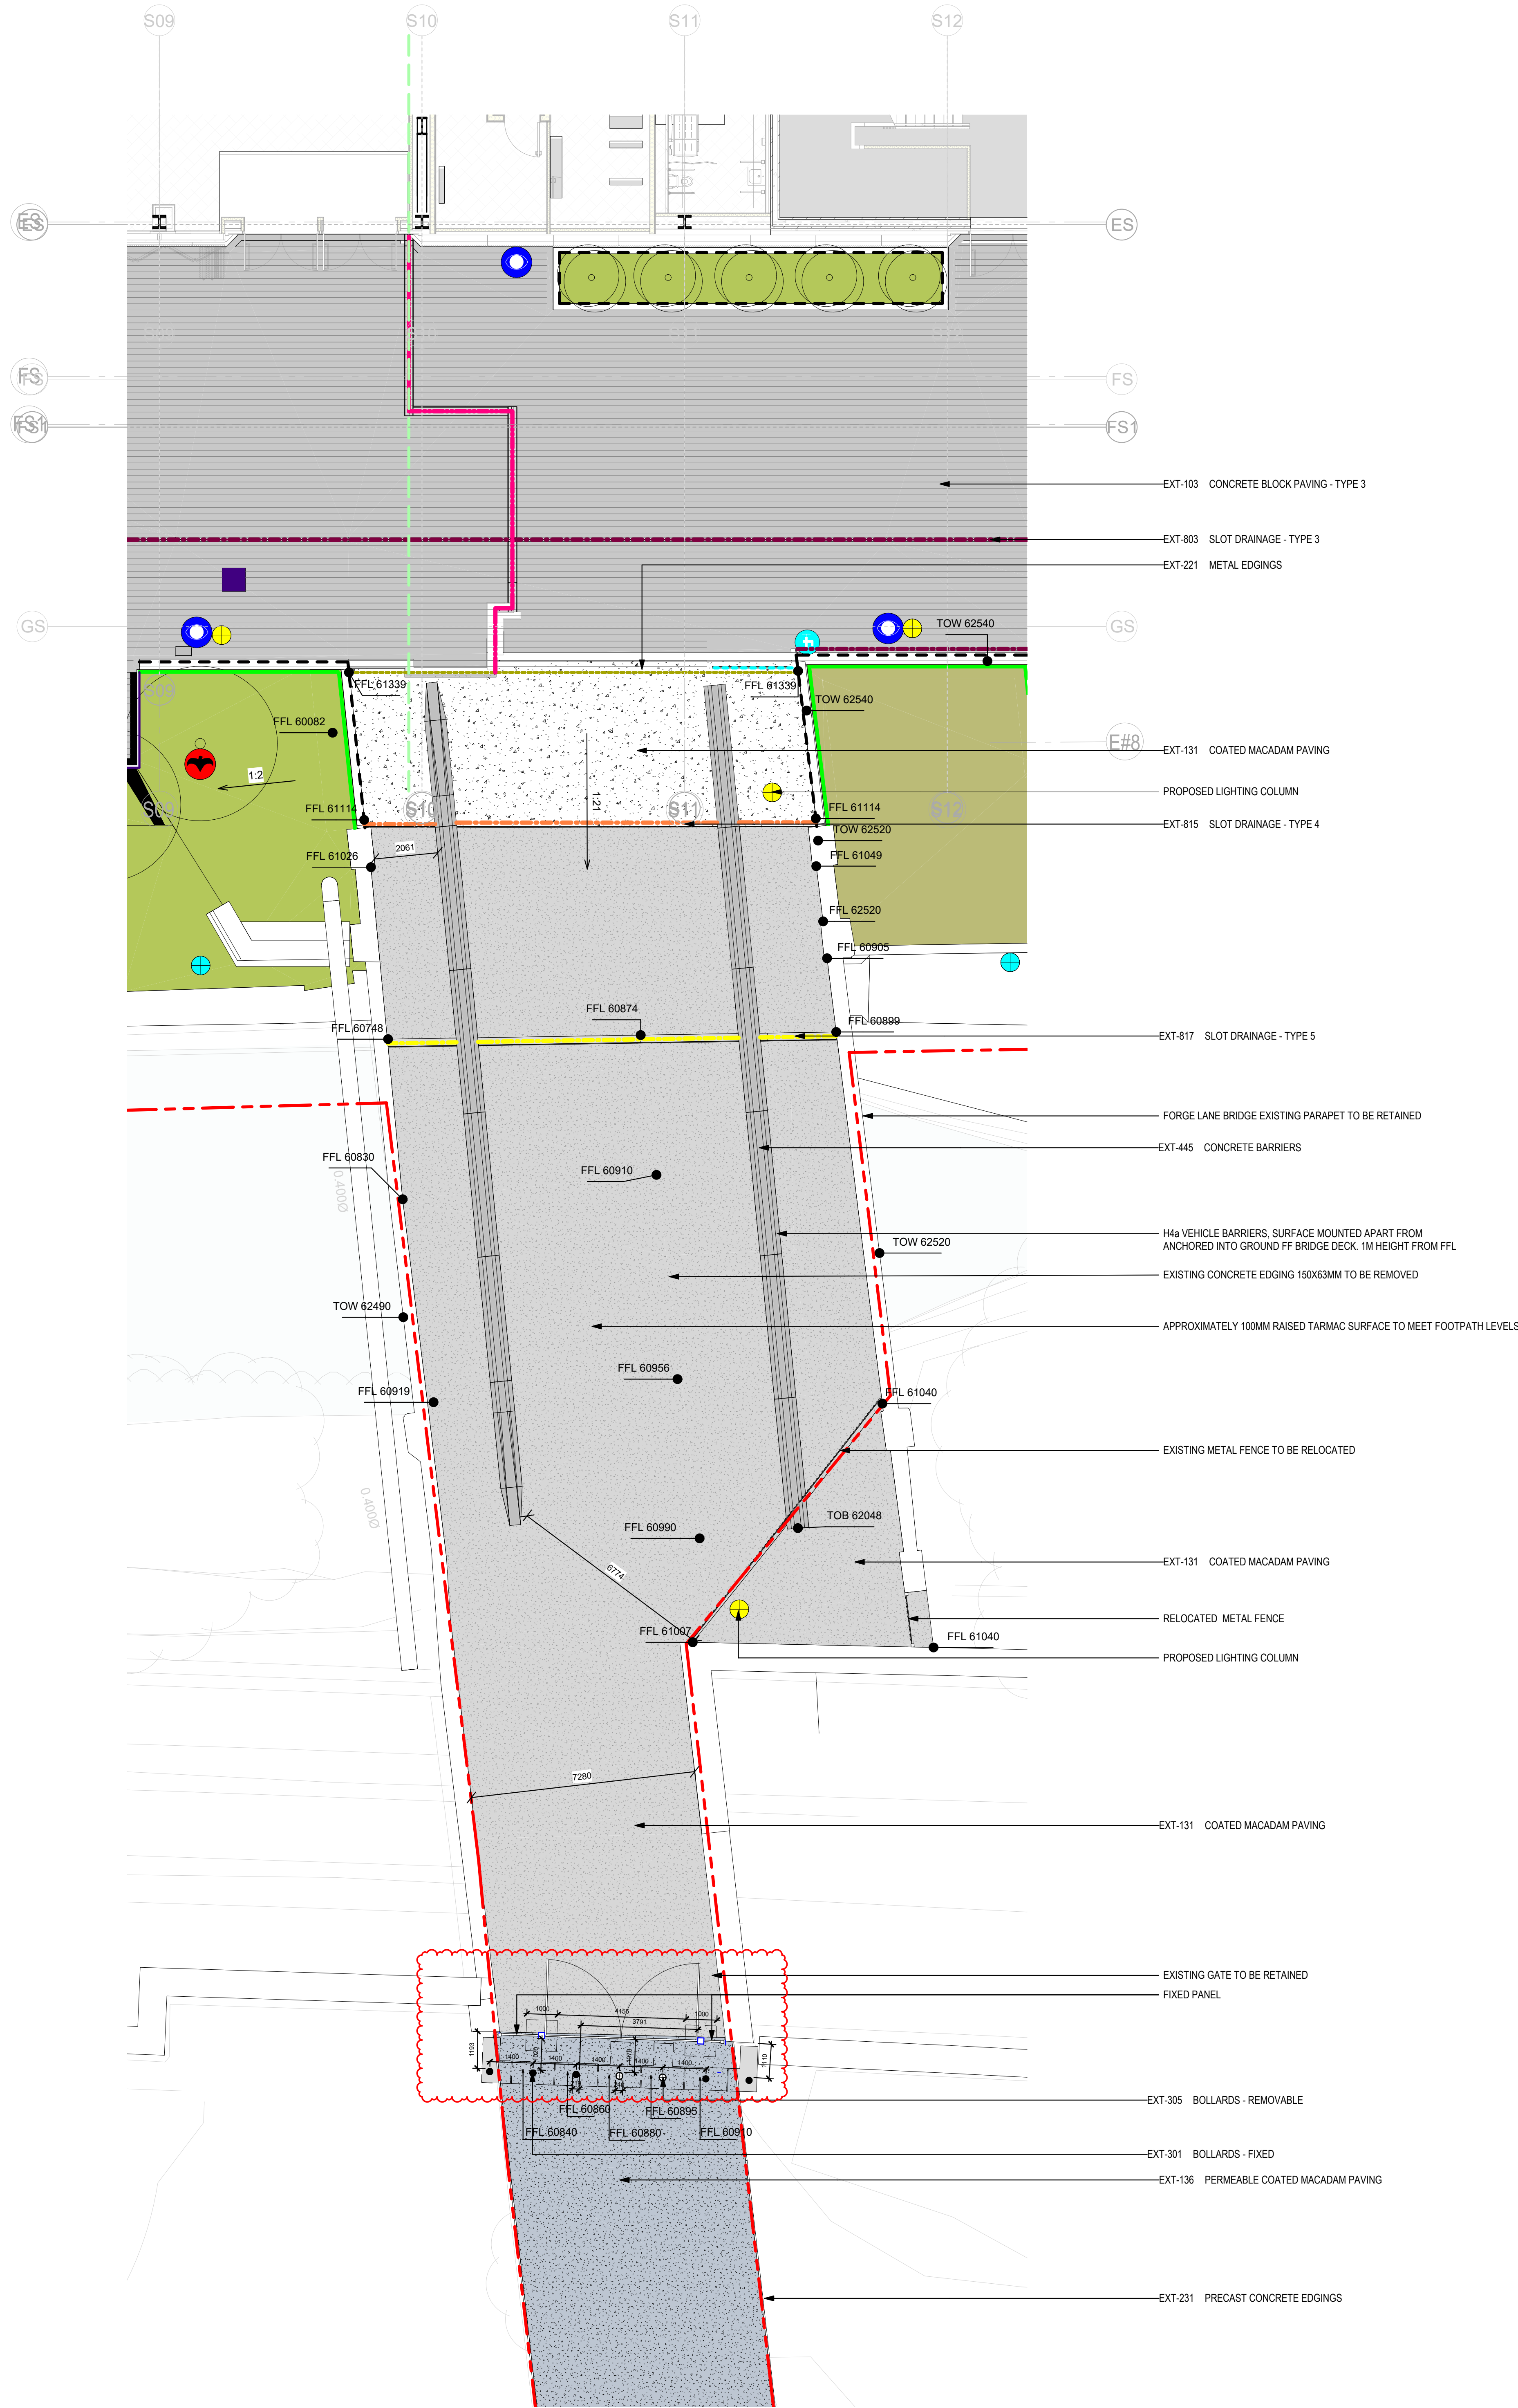

Suitability Code (as defined in ISO 19650-2:2018)

Work in Progress (WIP)

S0 - Under Construction

S1 - Suitable for co-ordination

S2 - Suitable for information

S3 - Suitable for review & comment

S4 - Suitable for final approval

S5 - Withdrawn

S6 - Suitable for final authorisation

S7 - Suitable for final authorisation

Published (Contractual)


A1, A2, A3, etc - Authorised and accepted

B1, B2, B3, etc - Partial sign-off (with comments)

Published (AIM Acceptance)

CR - As constructed record document

KEY PLAN

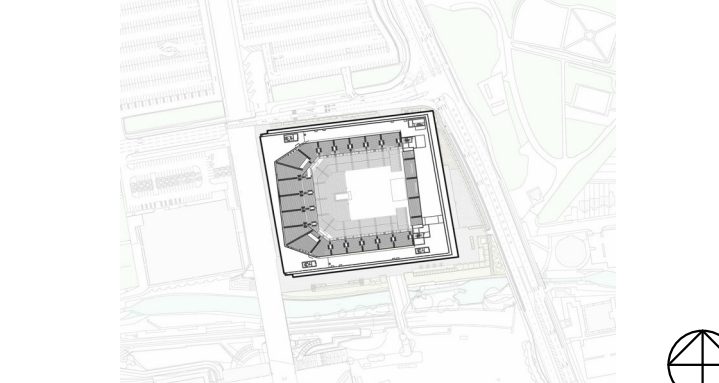

- KEY**
- PROJECT BOUNDARY
 - CONCRETE BLOCK PAVING IMPERMEABLE
 - EXT-112 CONCRETE PAVING SLAB
 - EXT-181, EXT-183 TIMBER DECKING
 - PAVING SURFACE TO MATCH EXISTING
 - EXT-131 TARMAC
 - EXT-136 PERMEABLE TARMAC
 - EXT-135 COATED MACADAM PAVING - WITH TEXTUREFLEX TOP COAT
 - EXT-191 TACTILE HAZARD WARNING STRIP
 - EXT-201, EXT-202, EXT-203 CONCRETE KERB
 - EXT-221 METAL EDGING
 - EXT-312 TIMBER TOP TO SEATING WALL
 - EXT-311 NATURAL STONE SEATING WALL
 - EXT-313 ACCESSIBLE ARMREST FOR SEATING WALL
 - EXT-321 LITTER BIN
 - EXT-331 METAL PLANTER
 - EXT-333 CONCRETE PLANTER
 - EXT-301 PAS RATED STATIC BOLLARD
 - EXT-302 PAS RATED RETRACTABLE BOLLARD - TYPE 1
 - EXT-305 PAS RATED REMOVABLE BOLLARD
 - EXISTING GATE TO BE RETAINED
 - EXT-194 FLOORBOX
 - EXT-471 CONCRETE WALL
 - RELOCATED METAL FENCE
 - EXT-445 VEHICLE MITIGATION CONCRETE BARRIER
 - EXT-415, EXT-416 HANDRAIL
 - EXT-411, EXT-412 BALUSTRADE
 - EXT-418, HEAD OF STEP BARRIER
 - EXT-419 BARRIER INTEGRATED WITH SHELF
 - EXT-541 GREEN SCREEN
 - EXT-815 SLOT DRAIN TYPE 4
 - EXT-817 SLOT DRAIN TYPE 5
 - WAYFINDING ITEM
 - ZONE FOR NAMING RIGHTS SIGNAGE
 - EXT-561 PROPOSED TREES
 - EXISTING TREES TO BE RETAINED
 - EXISTING TREES TO BE REMOVED
 - EXT-568 SHRUB AND UNDERSTORY PLANTING
 - EXT-571 WILDFLOWER
 - EXISTING PLANTING
 - PROPOSED LIGHTING COLUMN
 - EXISTING LIGHTING COLUMN TO BE RETAINED
 - EXISTING LIGHTING COLUMN TO BE REMOVED
 - LIGHTING COLUMN INTEGRATED ON BOLLARD
 - CCTV CAMERA
 - BAT BOX
 - BIRD BOX

THIS DRAWING IS ONLY TO SCALE IF IT IS REPRODUCED AT THE CORRECT PAPER SIZE

1:100@A0

ALL INTERNAL LAYOUTS AND USES ARE SHOWN FOR ILLUSTRATIVE PURPOSES ONLY AND ARE NOT FOR DETERMINATION



© COPYRIGHT. ALL RIGHTS RESERVED

THIS WORK IS COPYRIGHTED AND CANNOT BE REPRODUCED OR COPIED IN ANY FORM OR BY ANY MEANS WITHOUT THE WRITTEN PERMISSION OF POPULOUS. ANY UNAUTHORIZED REPRODUCTION OR USE OF THIS DOCUMENT FOR ANY PURPOSE WHATSOEVER IS PROHIBITED TO THE EXTENT OF THE AGREEMENT OR IMPLIED AGREEMENT BETWEEN POPULOUS AND THE INSTRUCTING PARTY

USE FOLLOWED DIMENSIONS IN PREFERENCE TO SCALED. CHECK ALL DIMENSIONS ON SITE BEFORE FABRICATION OR SETTING OUT

POPULOUS®

14 BLADES COURT | DEODAR ROAD | LONDON | SW15 2NU | UNITED KINGDOM
TELEPHONE +44 (0)20 8874 7666 FACSIMILE +44 (0)20 8874 7470
ALL PRODUCTION & INTELLECTUAL PROPERTY RIGHTS RESERVED © POPULOUS 2019

REVISIONS

REV	DATE	DESCRIPTION
00	30.10.2020	STAGE 4A - INCREASE IN SCOPE TO PLANNING BOUNDARY
01	16.11.2020	STAGE 4A - INCREASE IN SCOPE TO PLANNING BOUNDARY
02	09.07.2021	STAGE 4B TO INCORPORATE VE UPDATE
03	02.12.2021	HARD LANDSCAPE PACKAGE FOR CONSTRUCTION
04	11.02.2022	LANDSCAPE UPDATES DCR #003 FOLLOWING RFI #1017, BIRD & BAT BOXES INCLUDED FOR CLARITY
05	11.04.2022	LANDSCAPE UPDATE RFI #1055 AND EA #005
06	07.06.2022	LANDSCAPE UPDATE FOLLOWING DCR #003 AND SI 204.1 POP-56
07	16.06.2022	ADDITIONAL INFORMATION INCLUDED
08	24.07.2022	FLB BOLLARD LAYOUT UPDATE

project name

Co-op Live

the LANDSCAPE ENLARGED PLAN

FORGE LANE BRIDGE

LEVEL 01

scale 1:100@A0

date 30.10.2020

drawn FP

checked TJ

project code originator volume level type role number

revisions BRA-POP-ZZ-01-DR-L-8177

1 FORGE LANE BRIDGE GA