


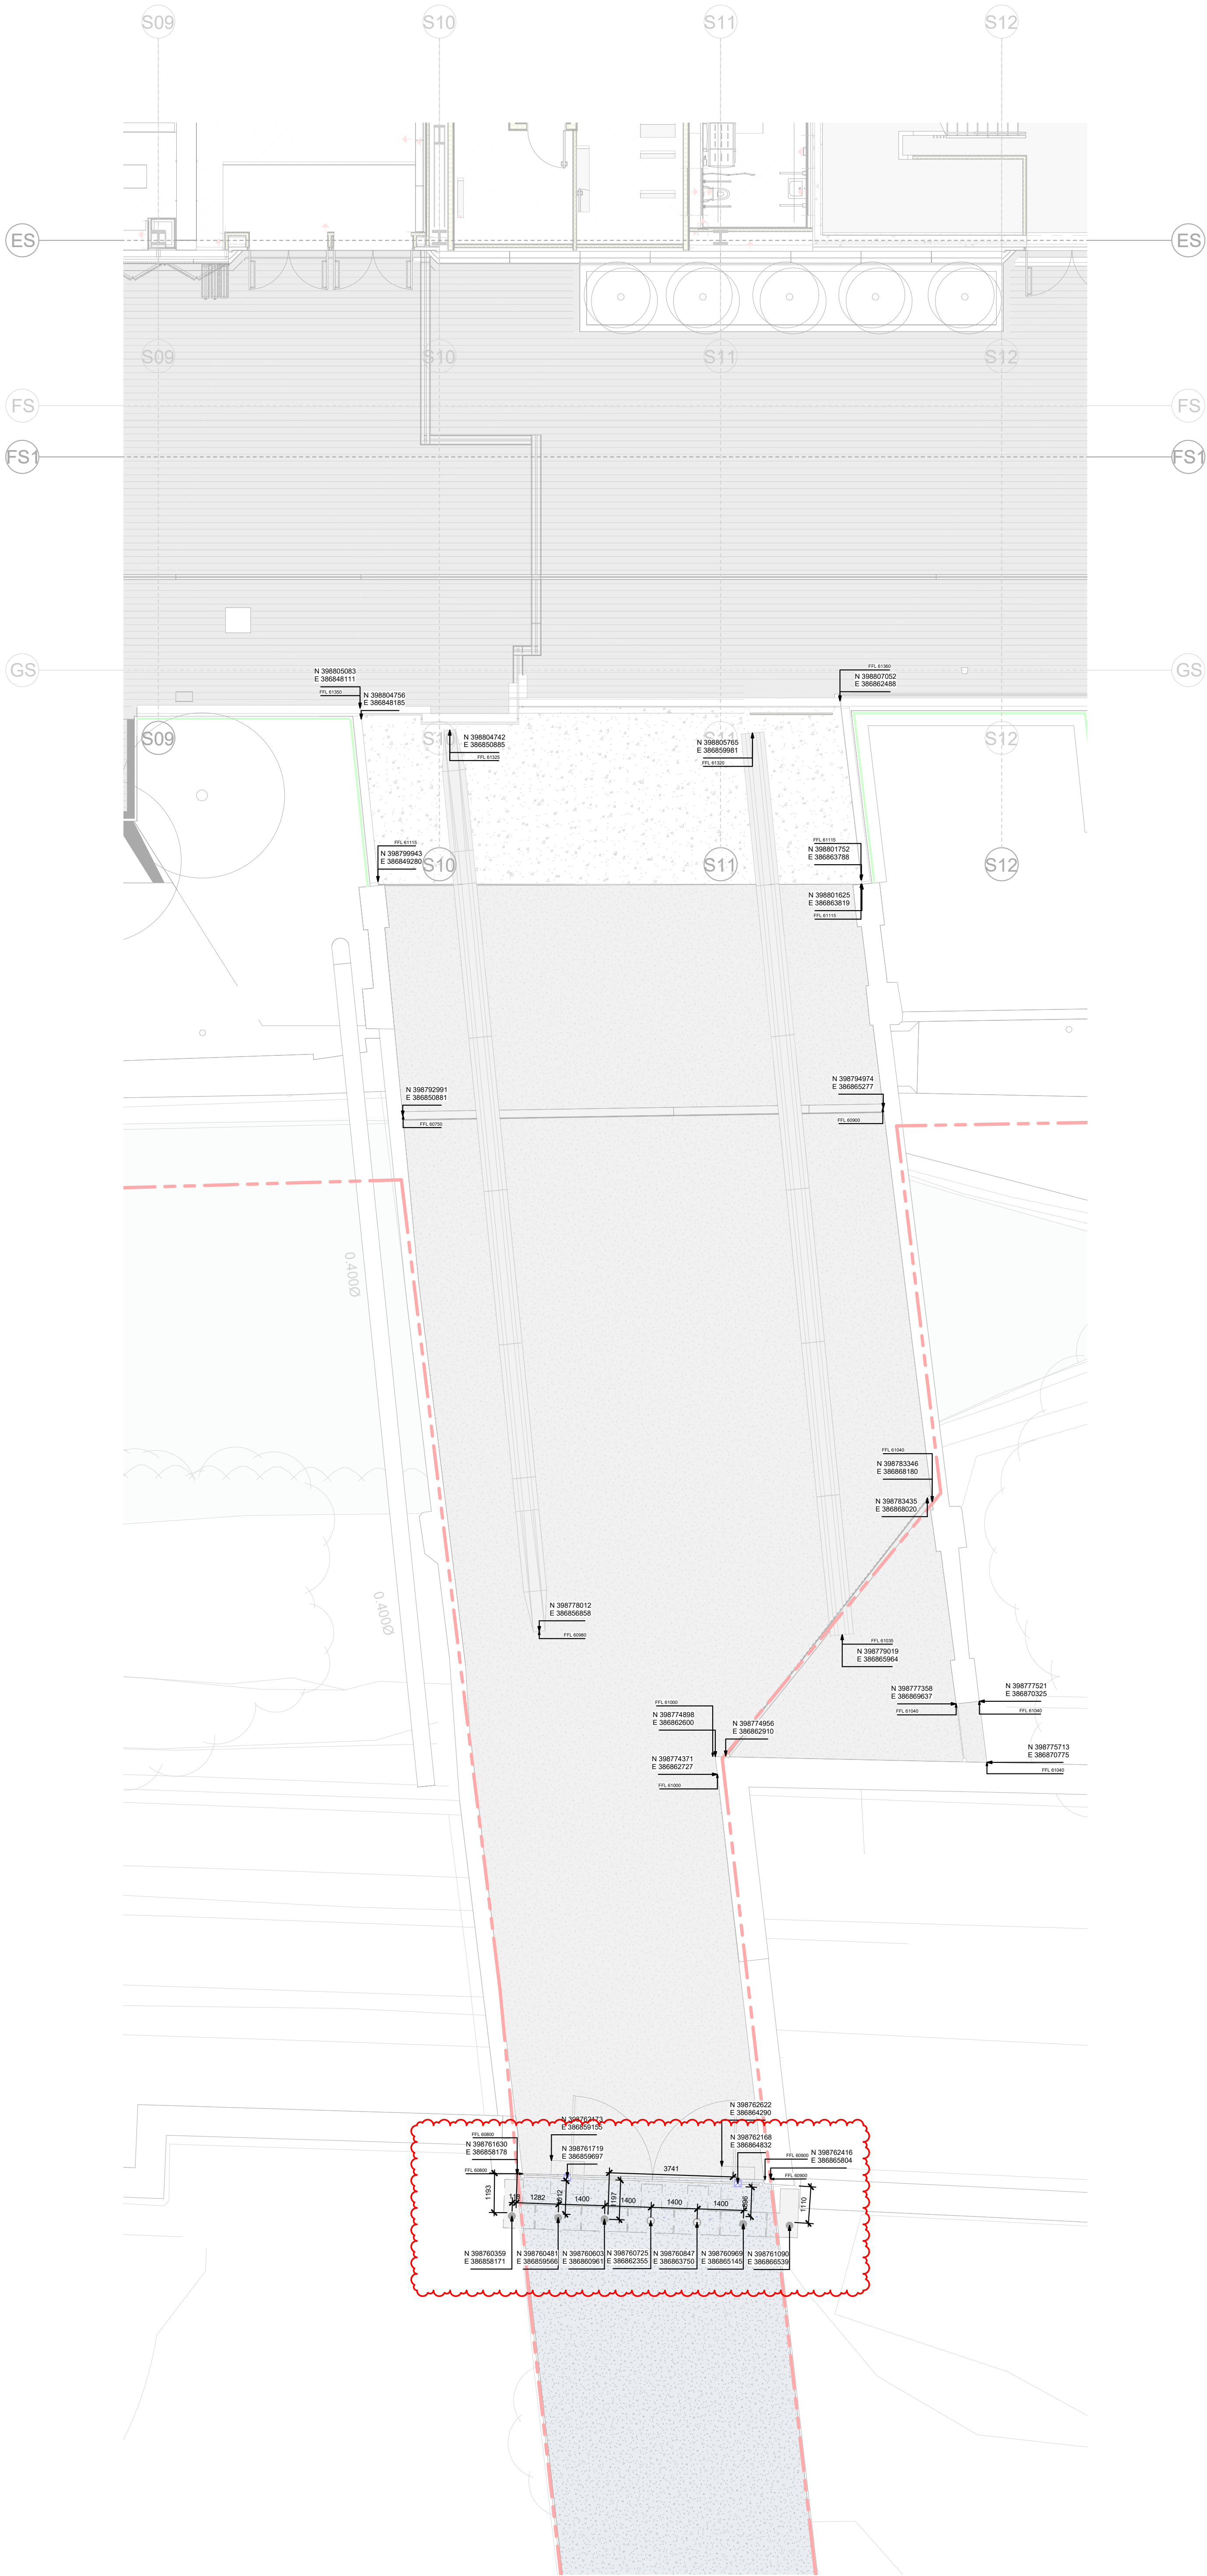

Suitability Code (as defined in ISO 19650-2:2018)

Work in Progress (WIP)

S0 - Issue Status

Shared (Non-Contractual)

S1 - Suitable for co-ordination

S2 - Suitable for information

S3 - Suitable for review & comment

S4 - Suitable for review & comment

S5 - Withdrawn

S6 - Suitable for BIM authorisation

S7 - Suitable for BIM authorisation

Published (Contractual)

A1, A2, A3, Etc - Authorised and accepted

B1, B2, B3, Etc - Partial sign-off (with comments)

Published (AIM Acceptance)

CR - As constructed record document

KEY PLAN

KEY

--- PLANNING APPLICATION BOUNDARY

••• COORDINATES AT SPOT

⊕ DRAINAGE PENETRATION OUTLET IN STRUCTURAL SLAB

THIS DRAWING IS ONLY TO SCALE IF IT IS REPRODUCED AT THE CORRECT PAPER SIZE

1:100@A0

ALL INTERNAL LAYOUTS AND USES ARE SHOWN FOR ILLUSTRATIVE PURPOSES ONLY AND ARE NOT FOR DETERMINATION

Safety, Health and Environmental Information

In addition to the hazards / risks normally associated with the types of work detailed on this drawing, note the following risks and information:

Construction	See risk register
No abnormal risks identified with this package of work.	

For information relating to Live, Closing and Maintenance see the Health and Safety File. It is assumed that all works will be carried out by a competent contractor working, where appropriate, to an approved method statement.



© COPYRIGHT. ALL RIGHTS RESERVED

THIS WORK IS COPYRIGHT AND CANNOT BE REPRODUCED OR COPIED IN ANY FORM OR BY ANY MEANS (ELECTRONIC OR MECHANICAL, INCLUDING PHOTOCOPYING, RECORDING, OR BY ANY INFORMATION STORAGE AND RETRIEVAL SYSTEM) WITHOUT THE WRITTEN PERMISSION OF POPULOUS ANY LICENSE, EXPRESS OR IMPLIED, TO USE THIS DOCUMENT FOR ANY PURPOSE WHATSOEVER IS RESTRICTED TO THE TERMS OF THE AGREEMENT OR IMPLIED AGREEMENT BETWEEN POPULOUS AND THE INSTRUCTING PARTY

USE FOLLOWED DIMENSIONS IN PREFERENCE TO SCALED. CHECK ALL DIMENSIONS ON SITE BEFORE FABRICATION OR SETTING OUT

14 BLADES COURT | DEODAR ROAD | LONDON | SW15 2NU | UNITED KINGDOM

TELEPHONE +44 (0)20 8874 7666 FACSIMILE +44 (0)20 8874 7470

ALL PRODUCTION & INTELLECTUAL PROPERTY RIGHTS RESERVED © POPULOUS 2019

POPULOUS®

REVISIONS		
REV	DATE	DESCRIPTION
00	12/02/2021	STAGE 4B BOLLARDS SCOPE ISSUE
001	10/10/2021	HARD LANDSCAPE PACKAGE FOR CONSTRUCTION
002	11/04/2022	LANDSCAPE UPDATE RFI#1656 AND EA #05
003	07/06/2022	LANDSCAPE UPDATE FOLLOWING DCR #0663 AND SI 2041 PPS-54
004	18/06/2023	ADDITIONAL INFORMATION INCLUDED
005	04/07/2023	FLB BOLLARD LAYOUT UPDATE

project name **Co-op Live**

the **SETTING OUT ENLARGED PLAN**

FORGE LANE BRIDGE

LEVEL 01

scale 1:100@A0

drawn FP

date 12/02/21

checked TJ

4933

project code originator volume level type role number

reborn BRA-POP-ZZ-01-DR-L-8193

Suitability **S4**

purpose of issue **CONSTRUCTION**

C05