




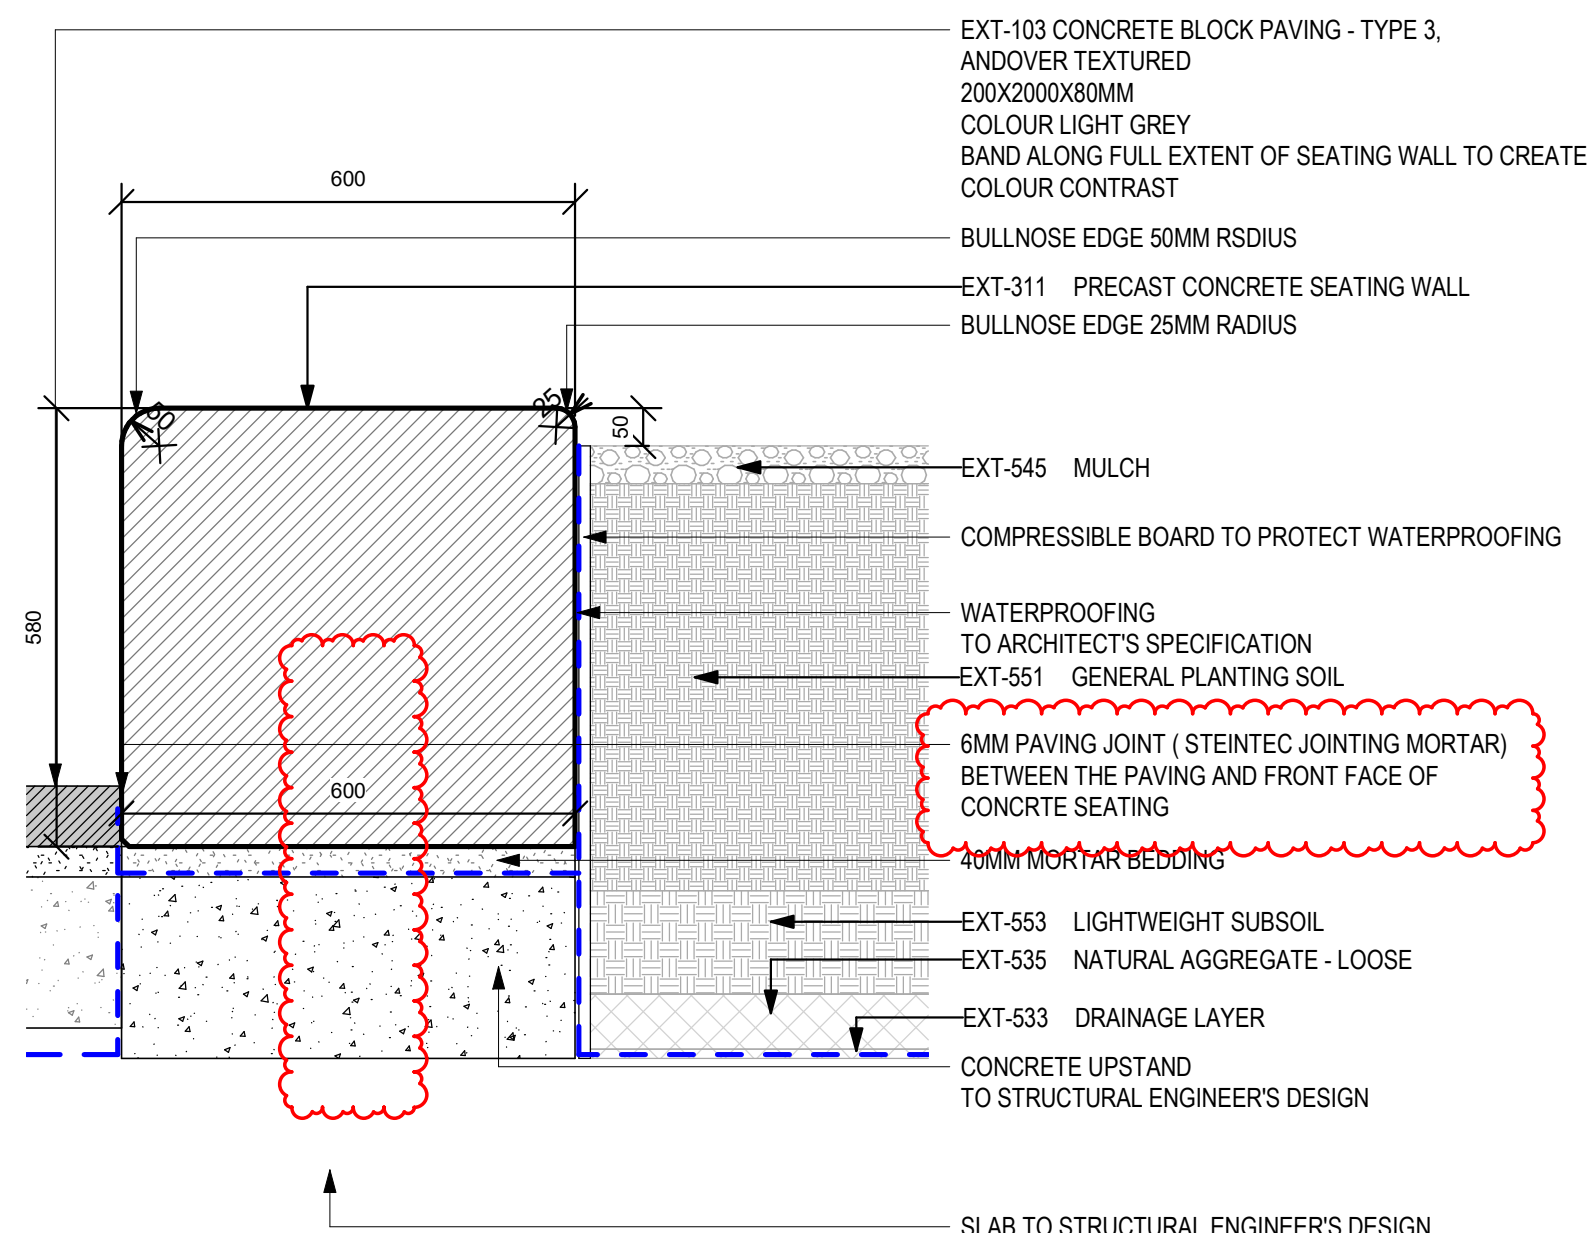


1 TYPICAL SEATING WALL DETAIL - MODULE 1

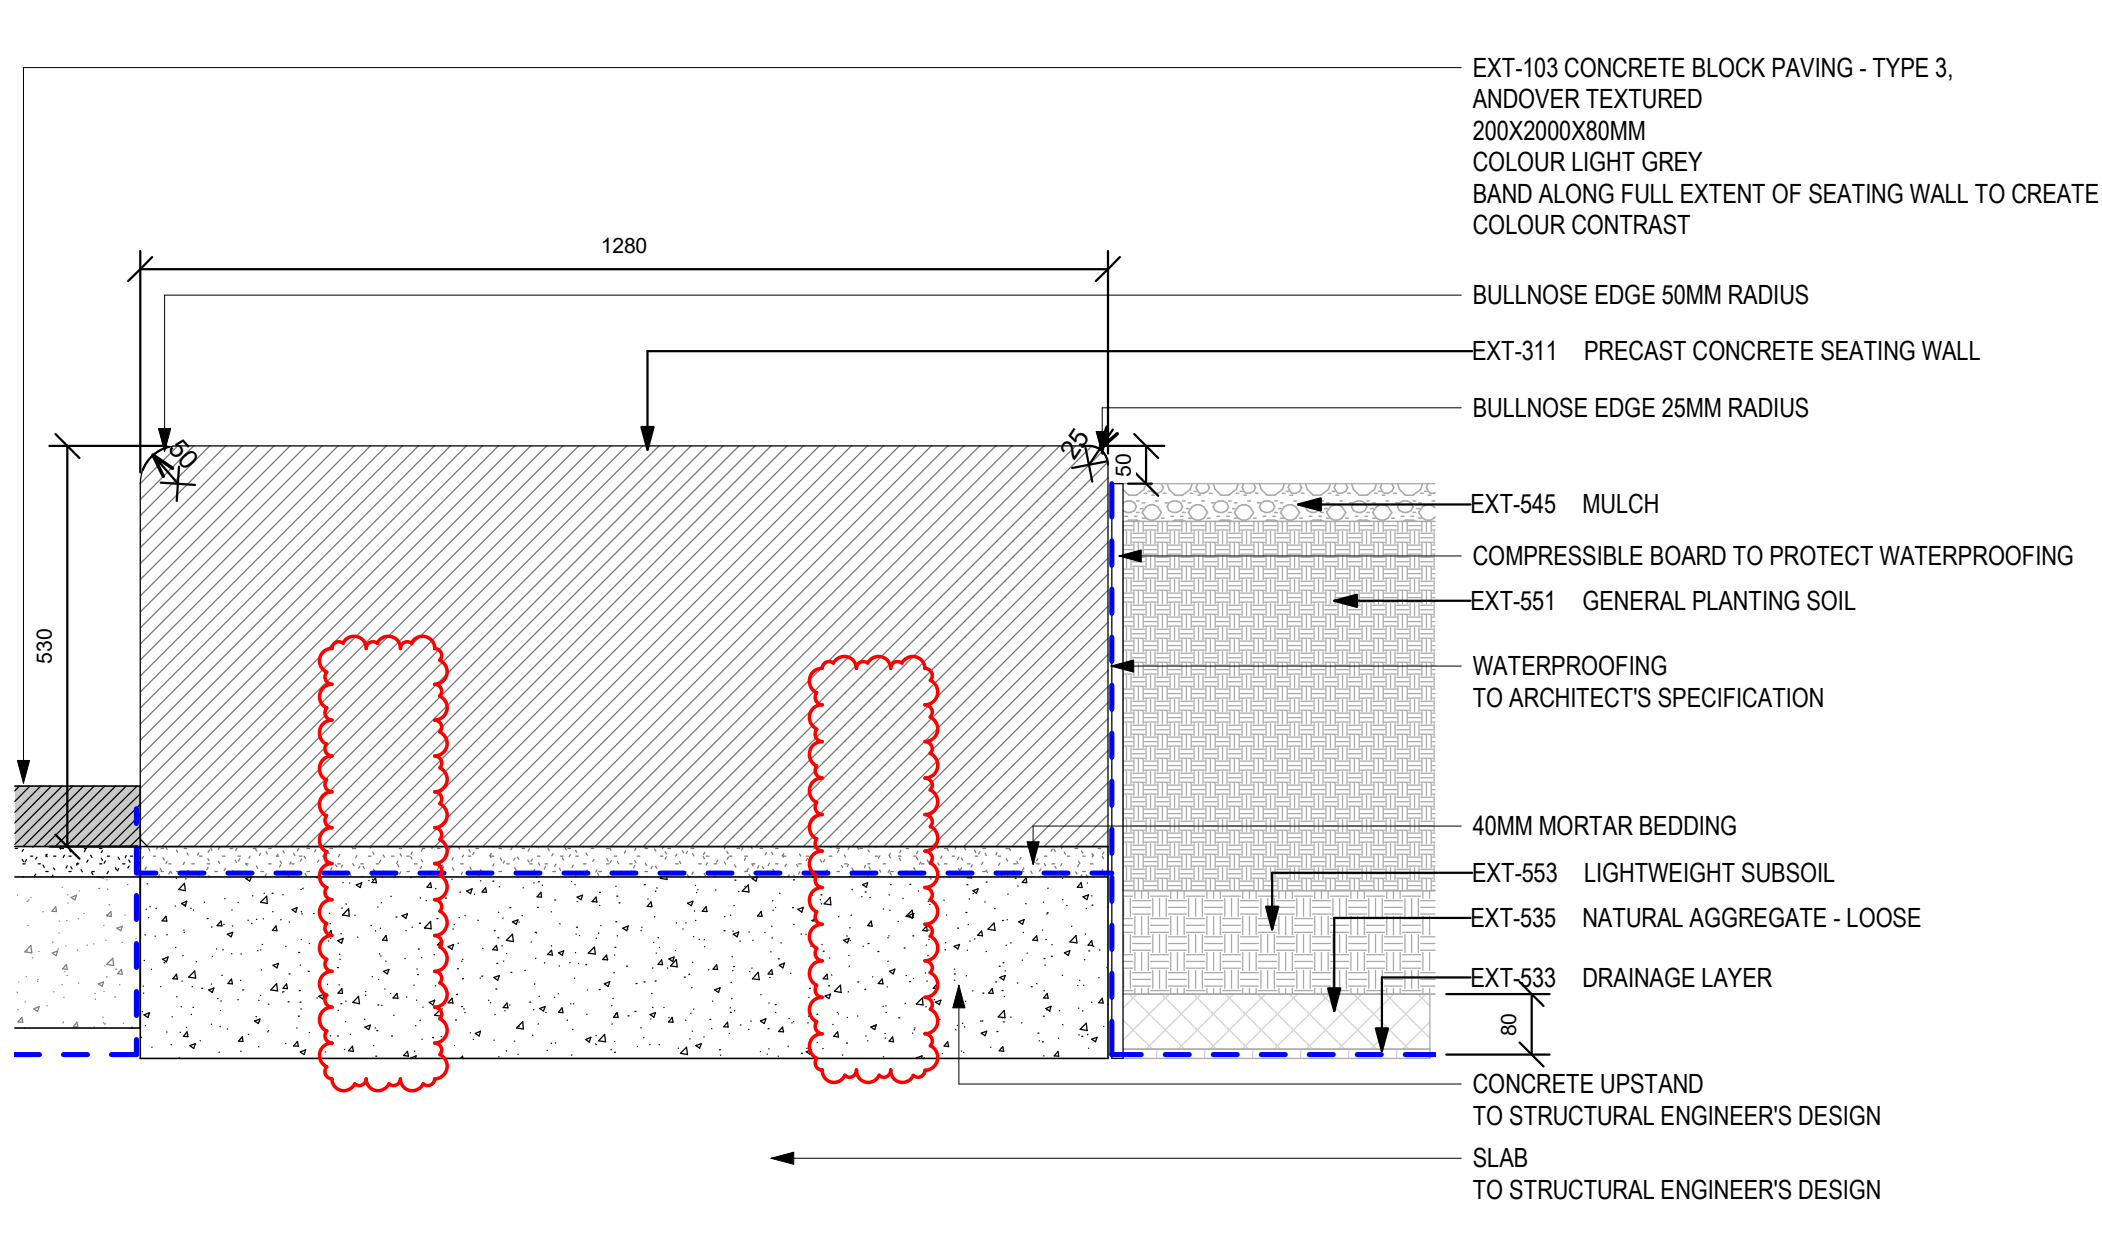


2 TYPICAL SEATING WALL DETAIL - MODULE 2

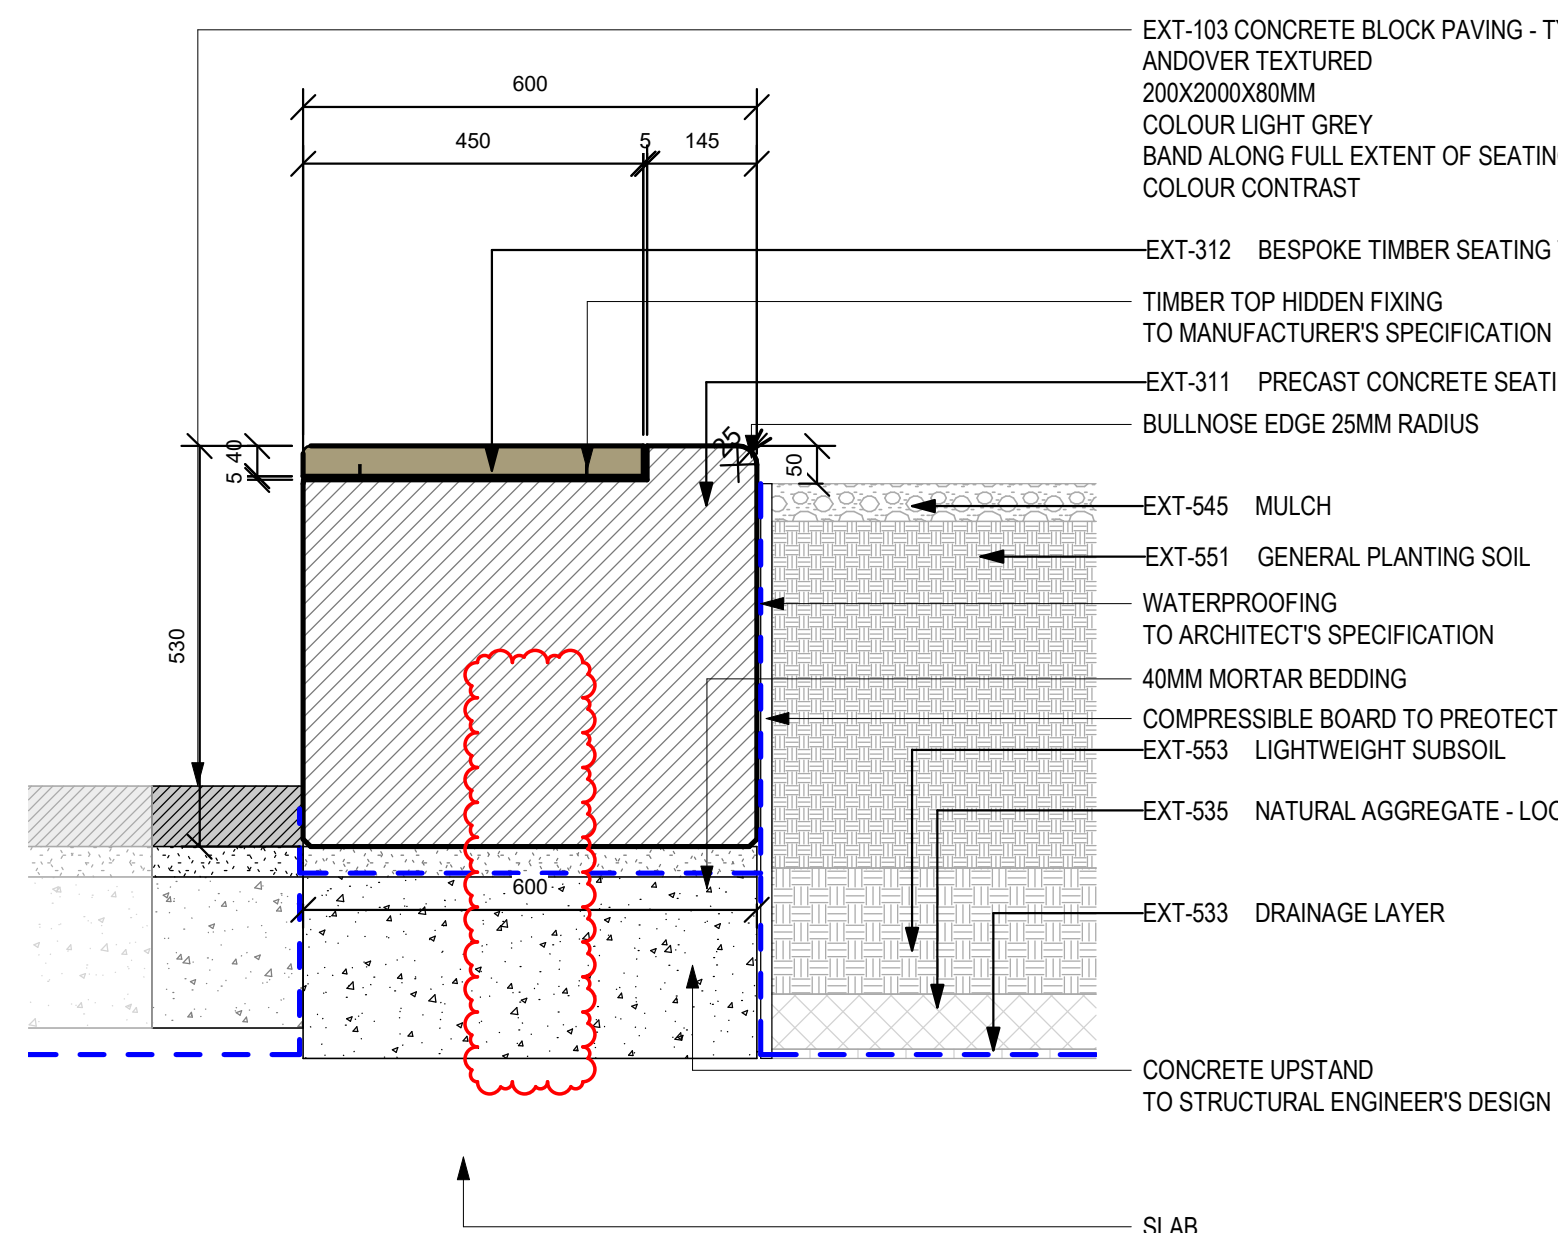


3 TYPICAL SEATING WALL DETAIL - MODULE 3

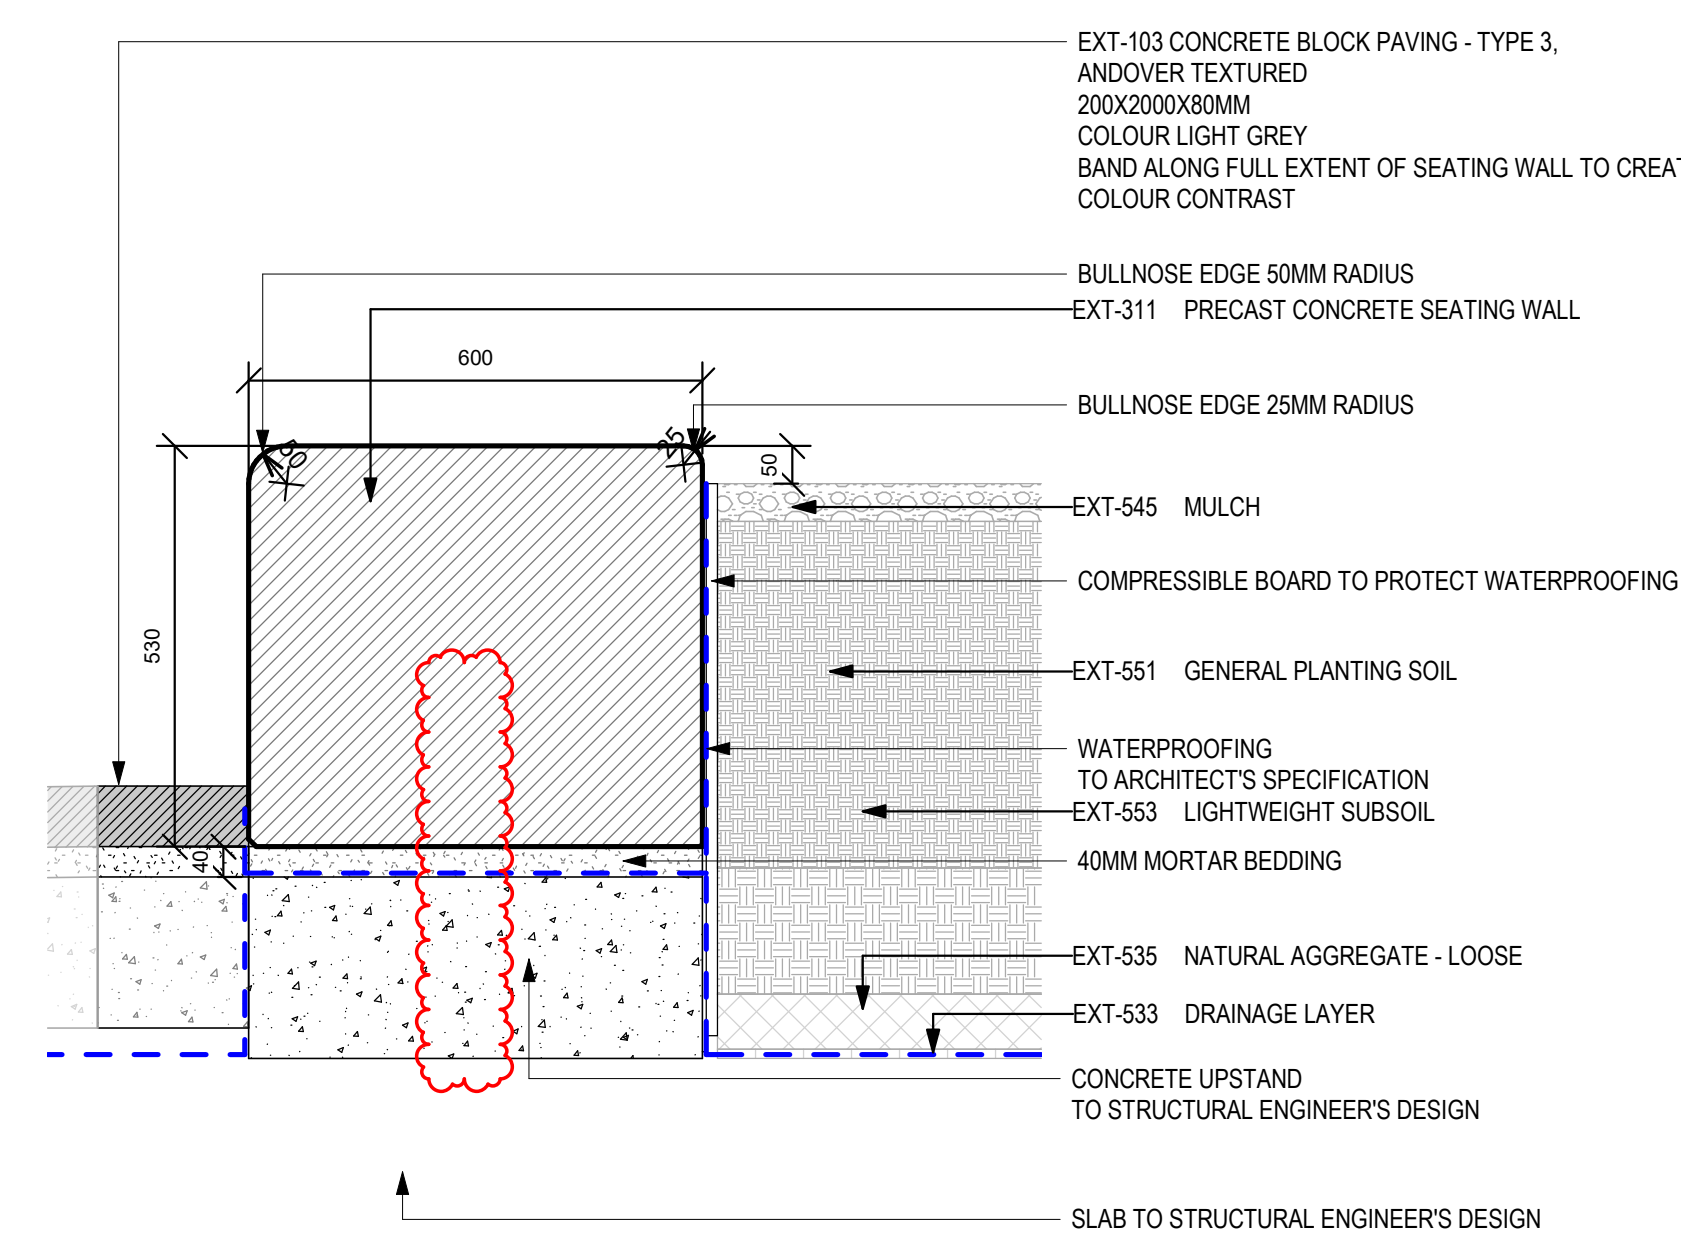


4 TYPICAL SEATING WALL DETAIL - MODULE 13

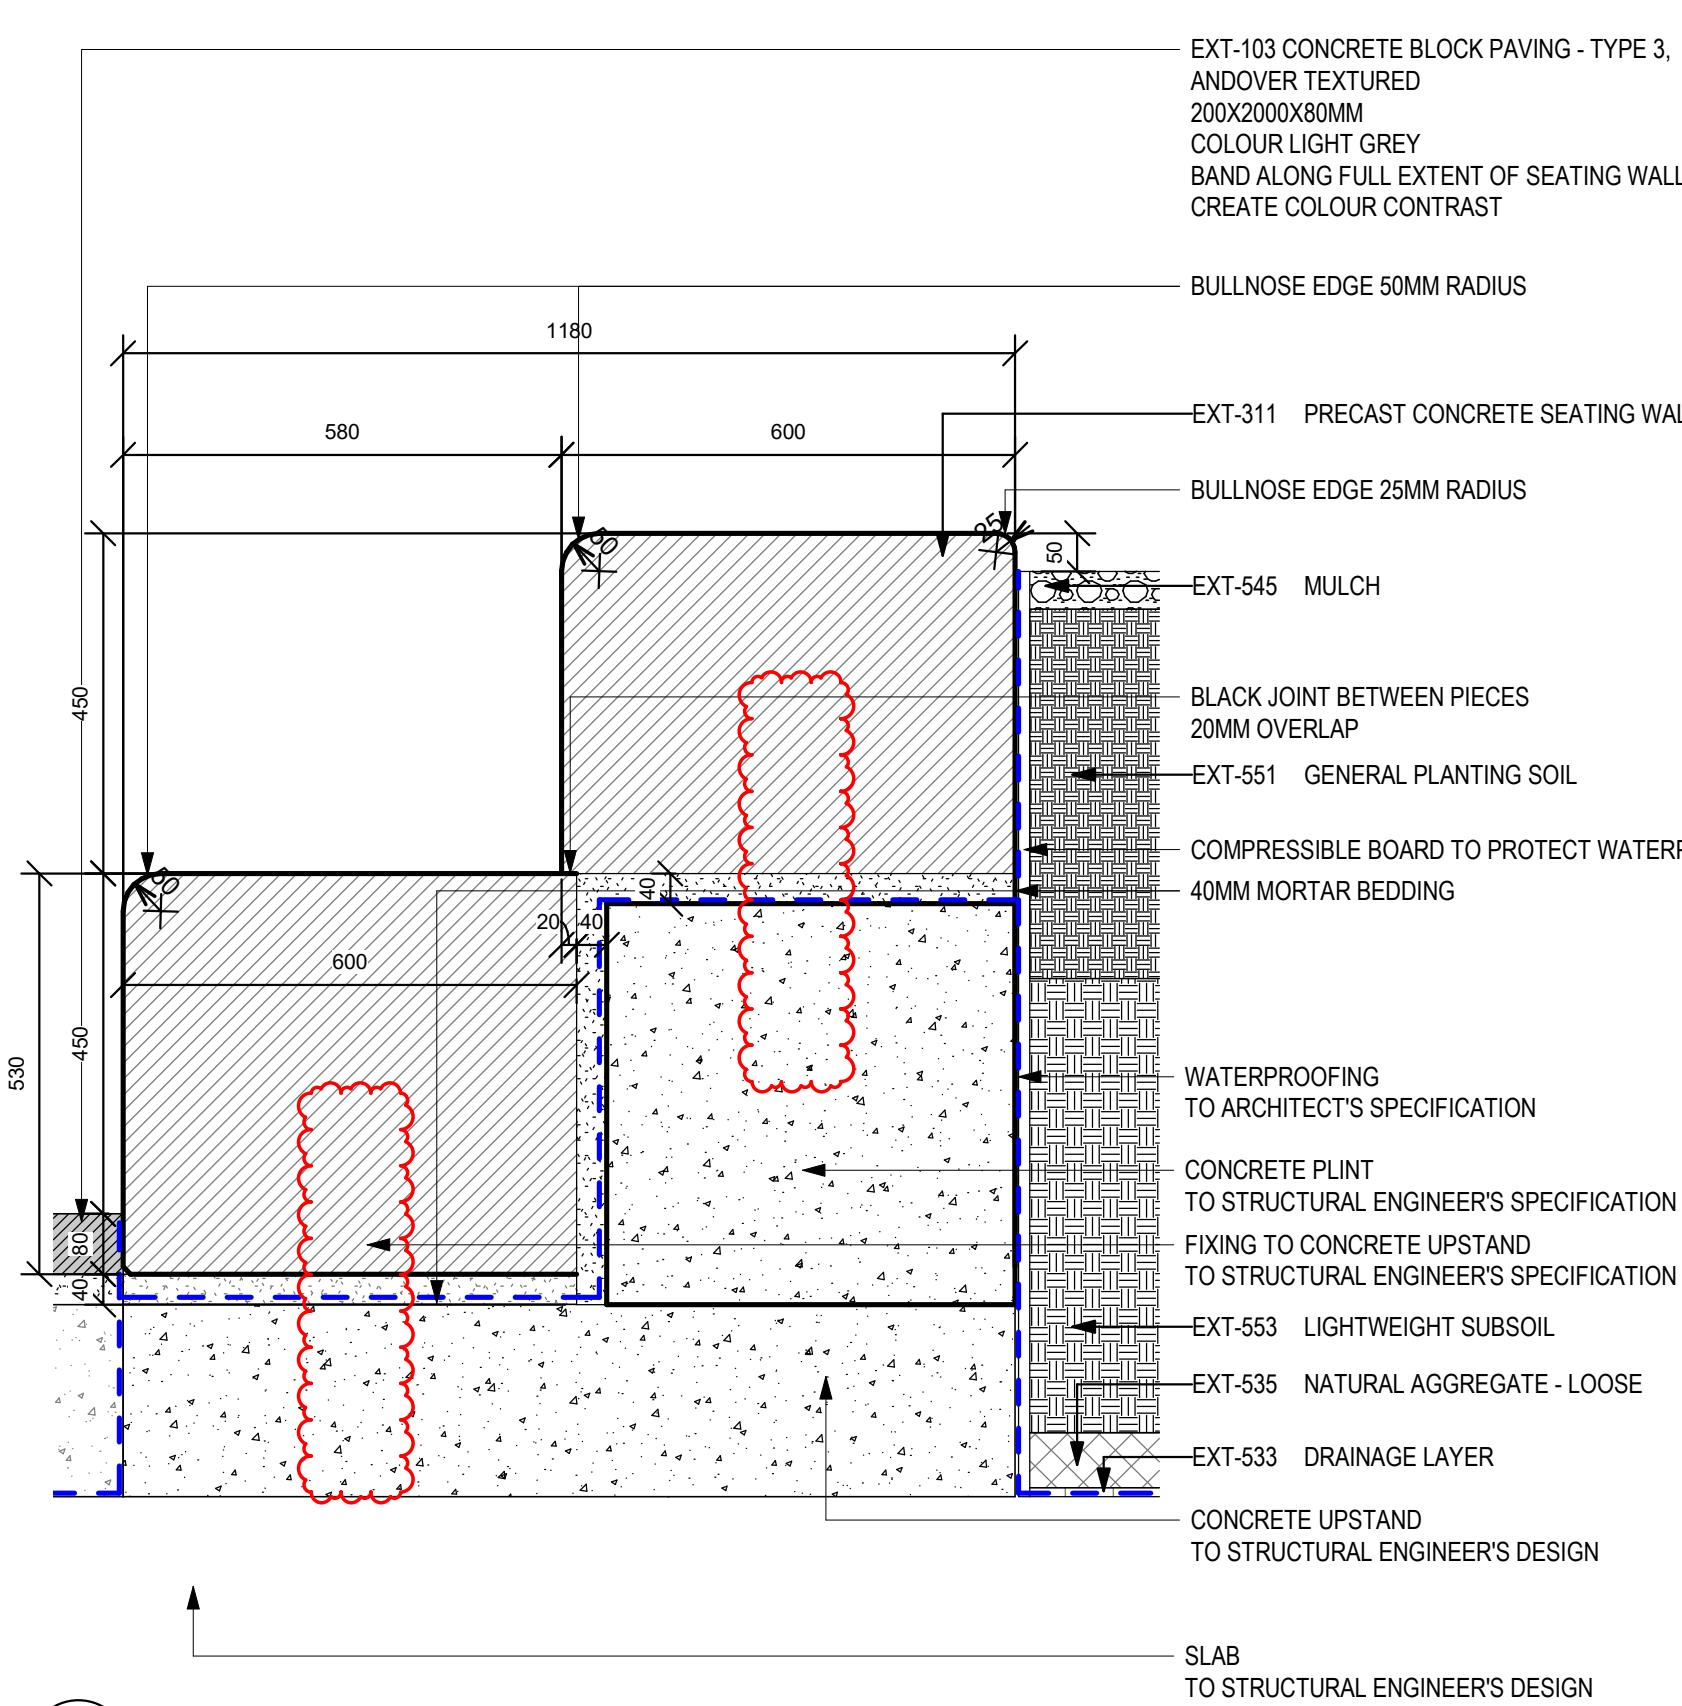


5 TYPICAL SEATING WALL DETAIL - MODULE 4, 5 & 8

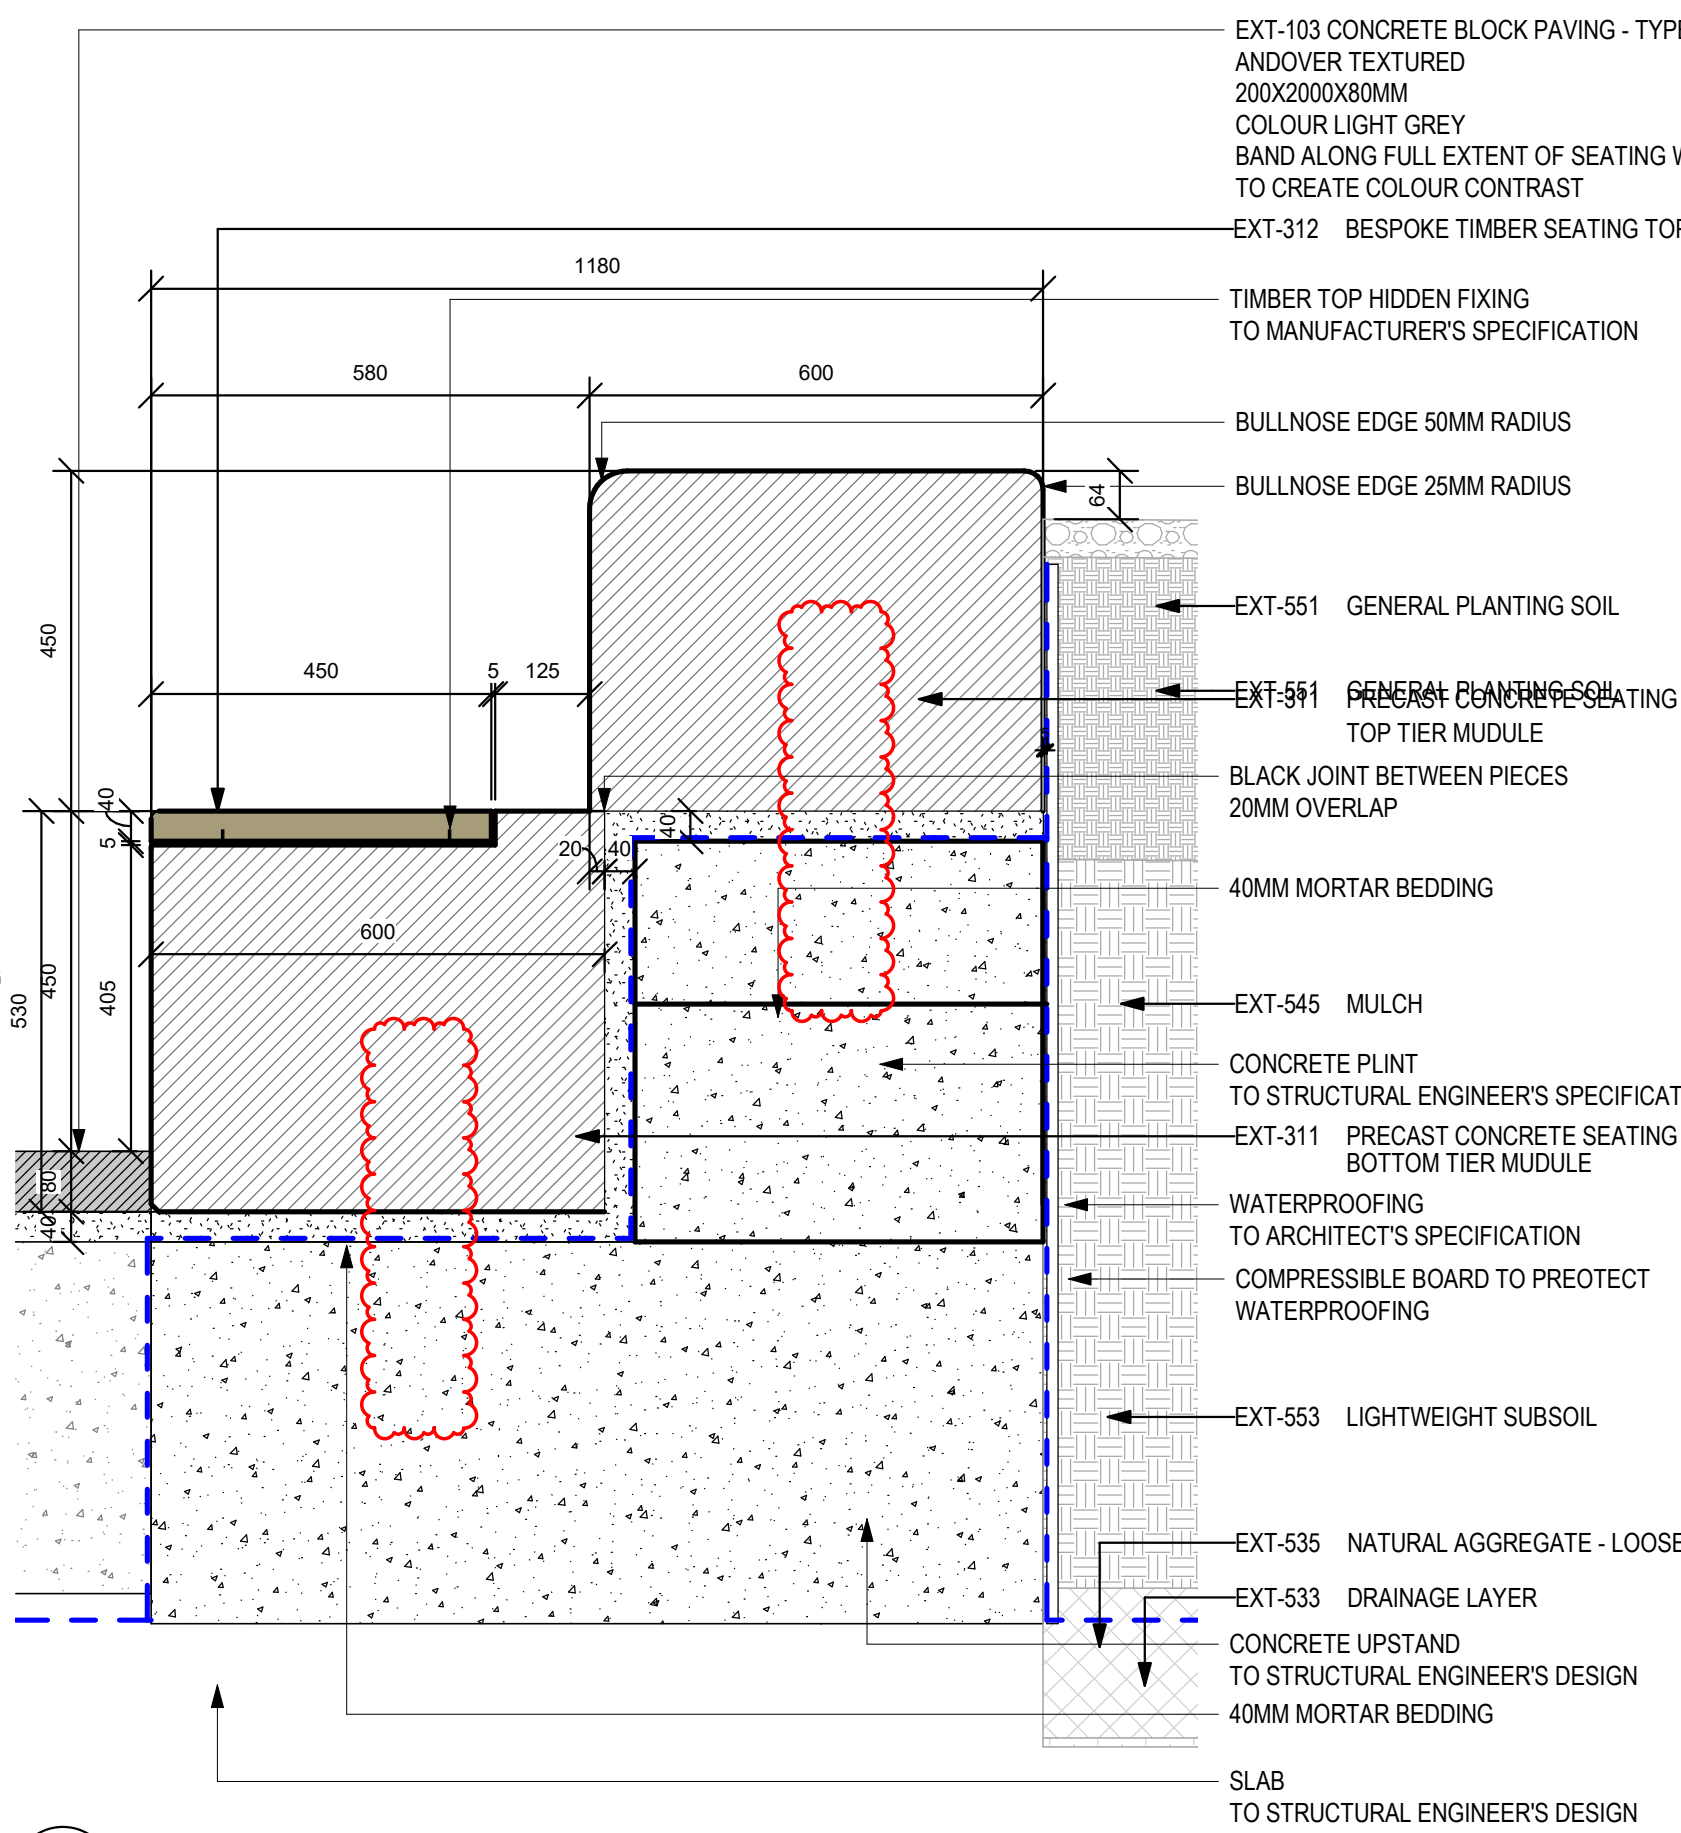


6 TYPICAL SEATING WALL DETAIL - MODULE 6, 7, 10 & 11

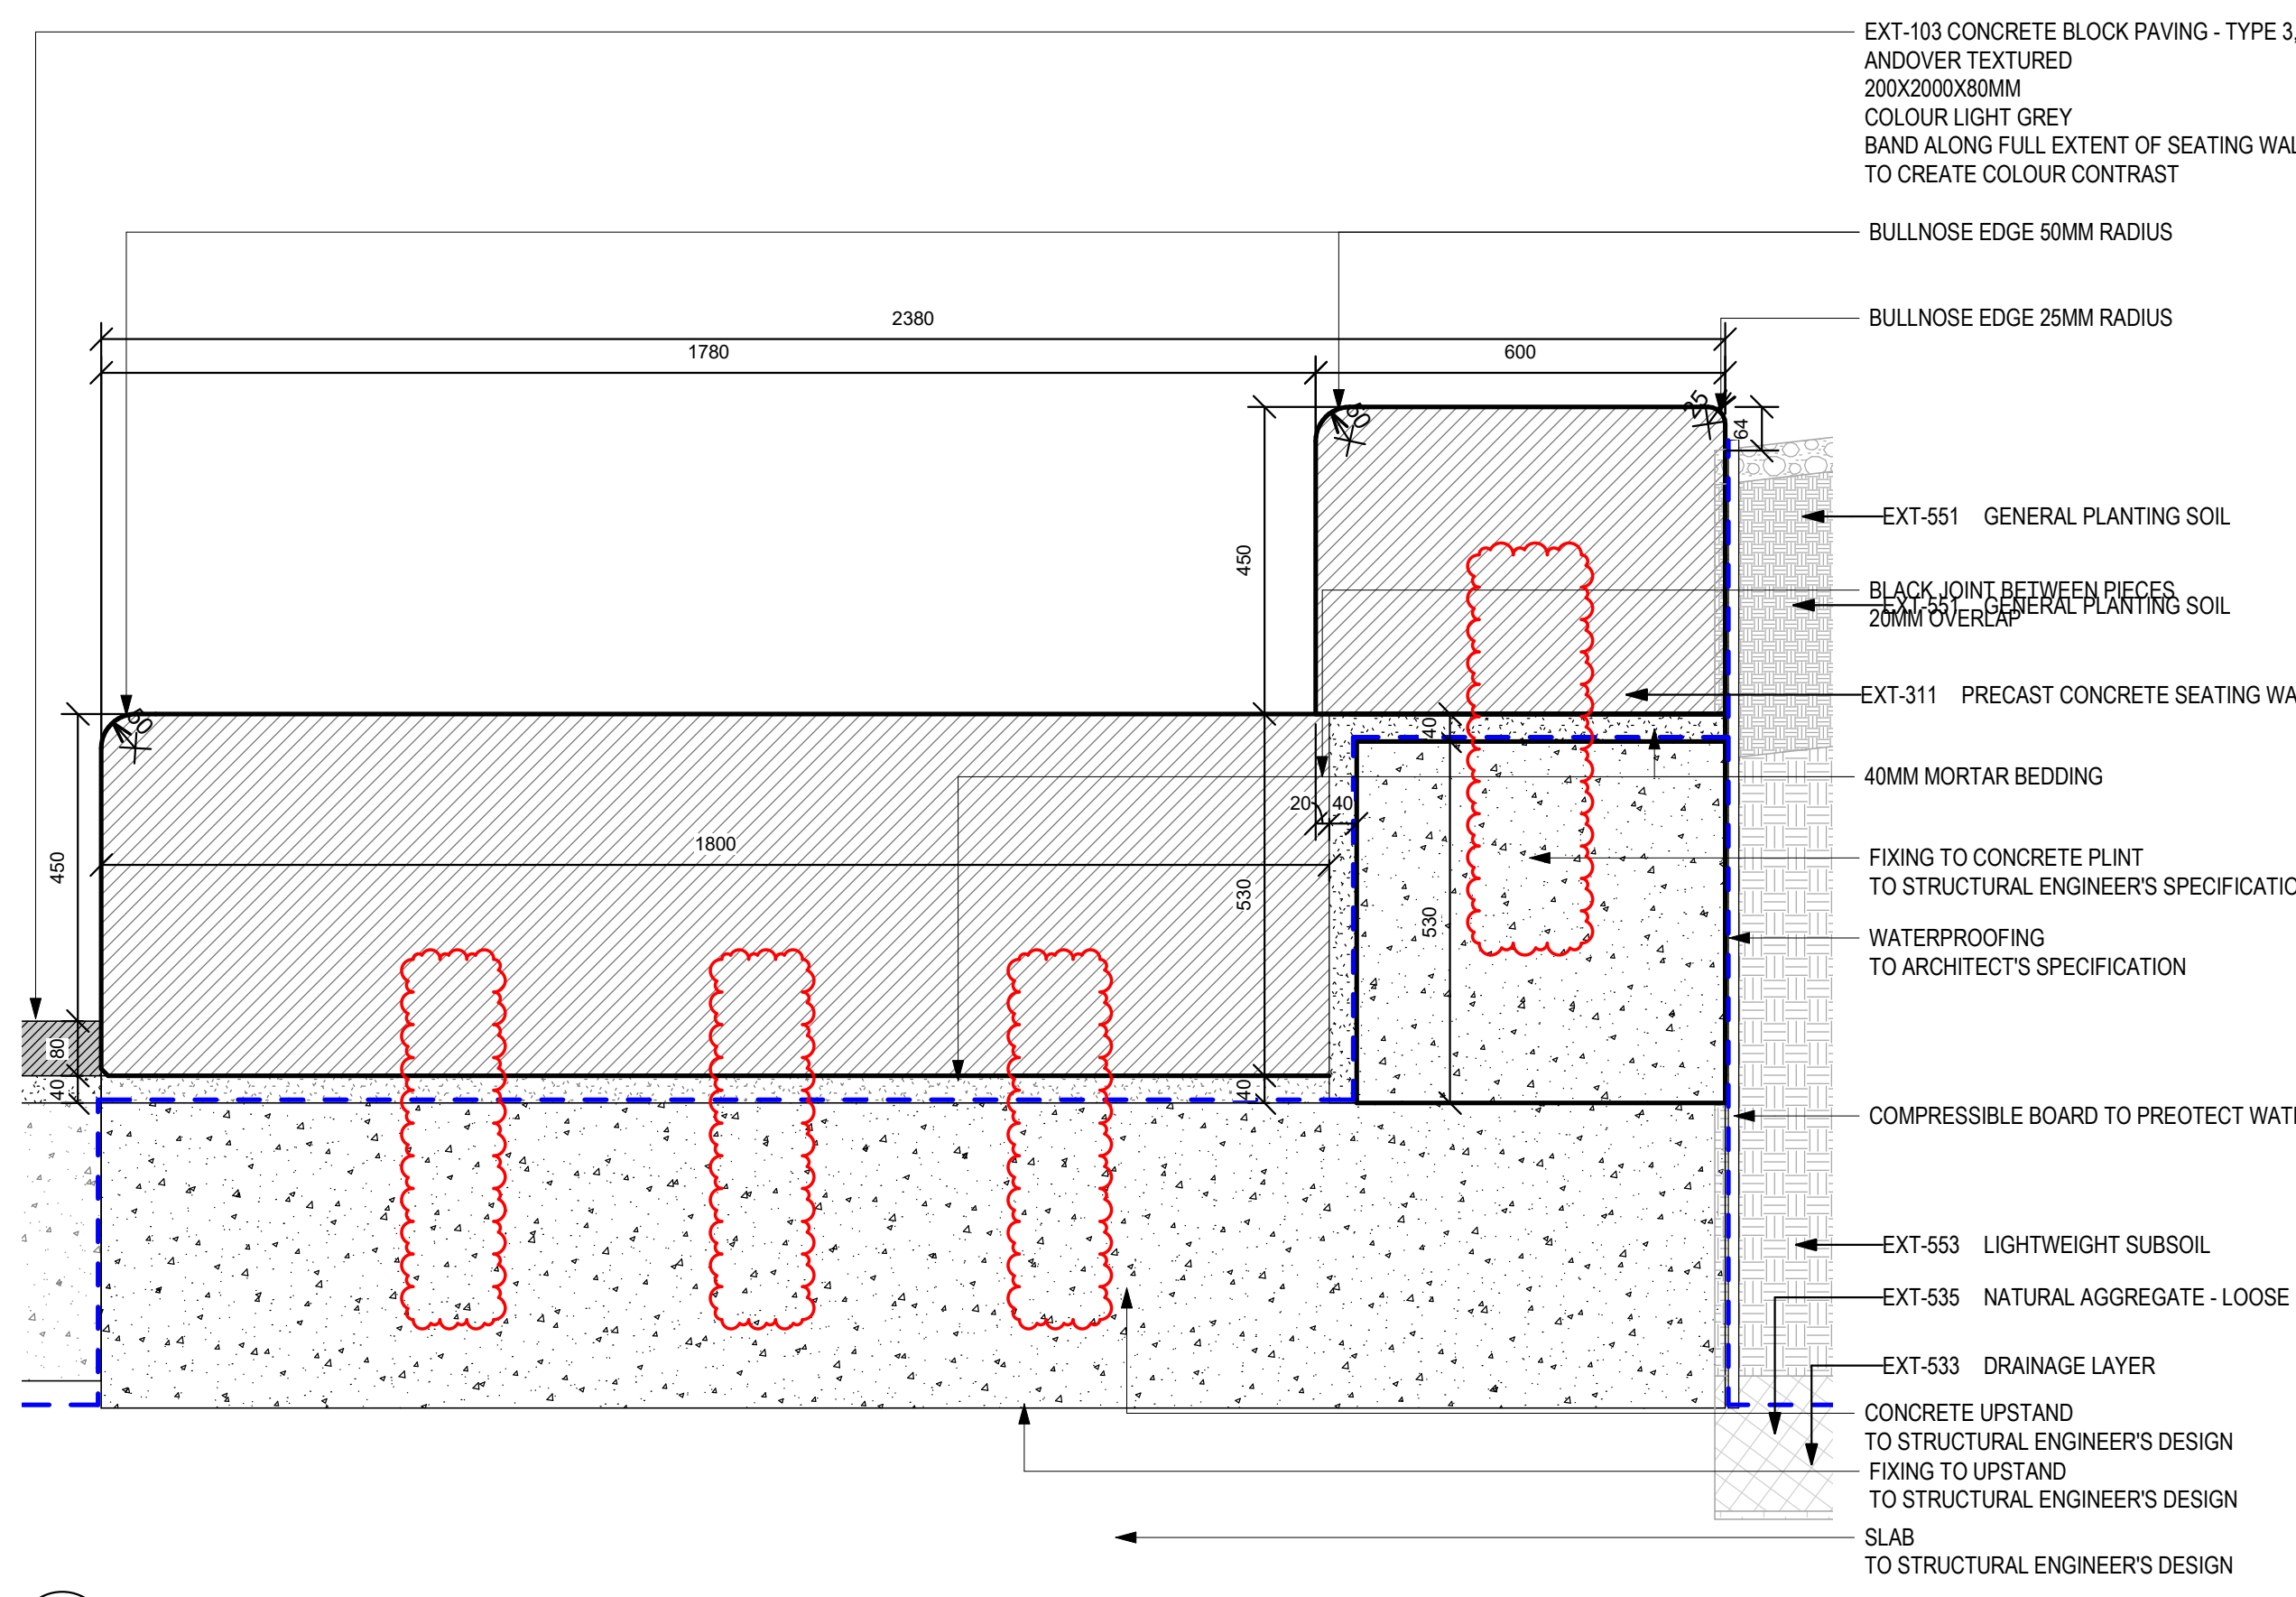


7 TYPICAL SEATING WALL DETAIL - MODULE 9

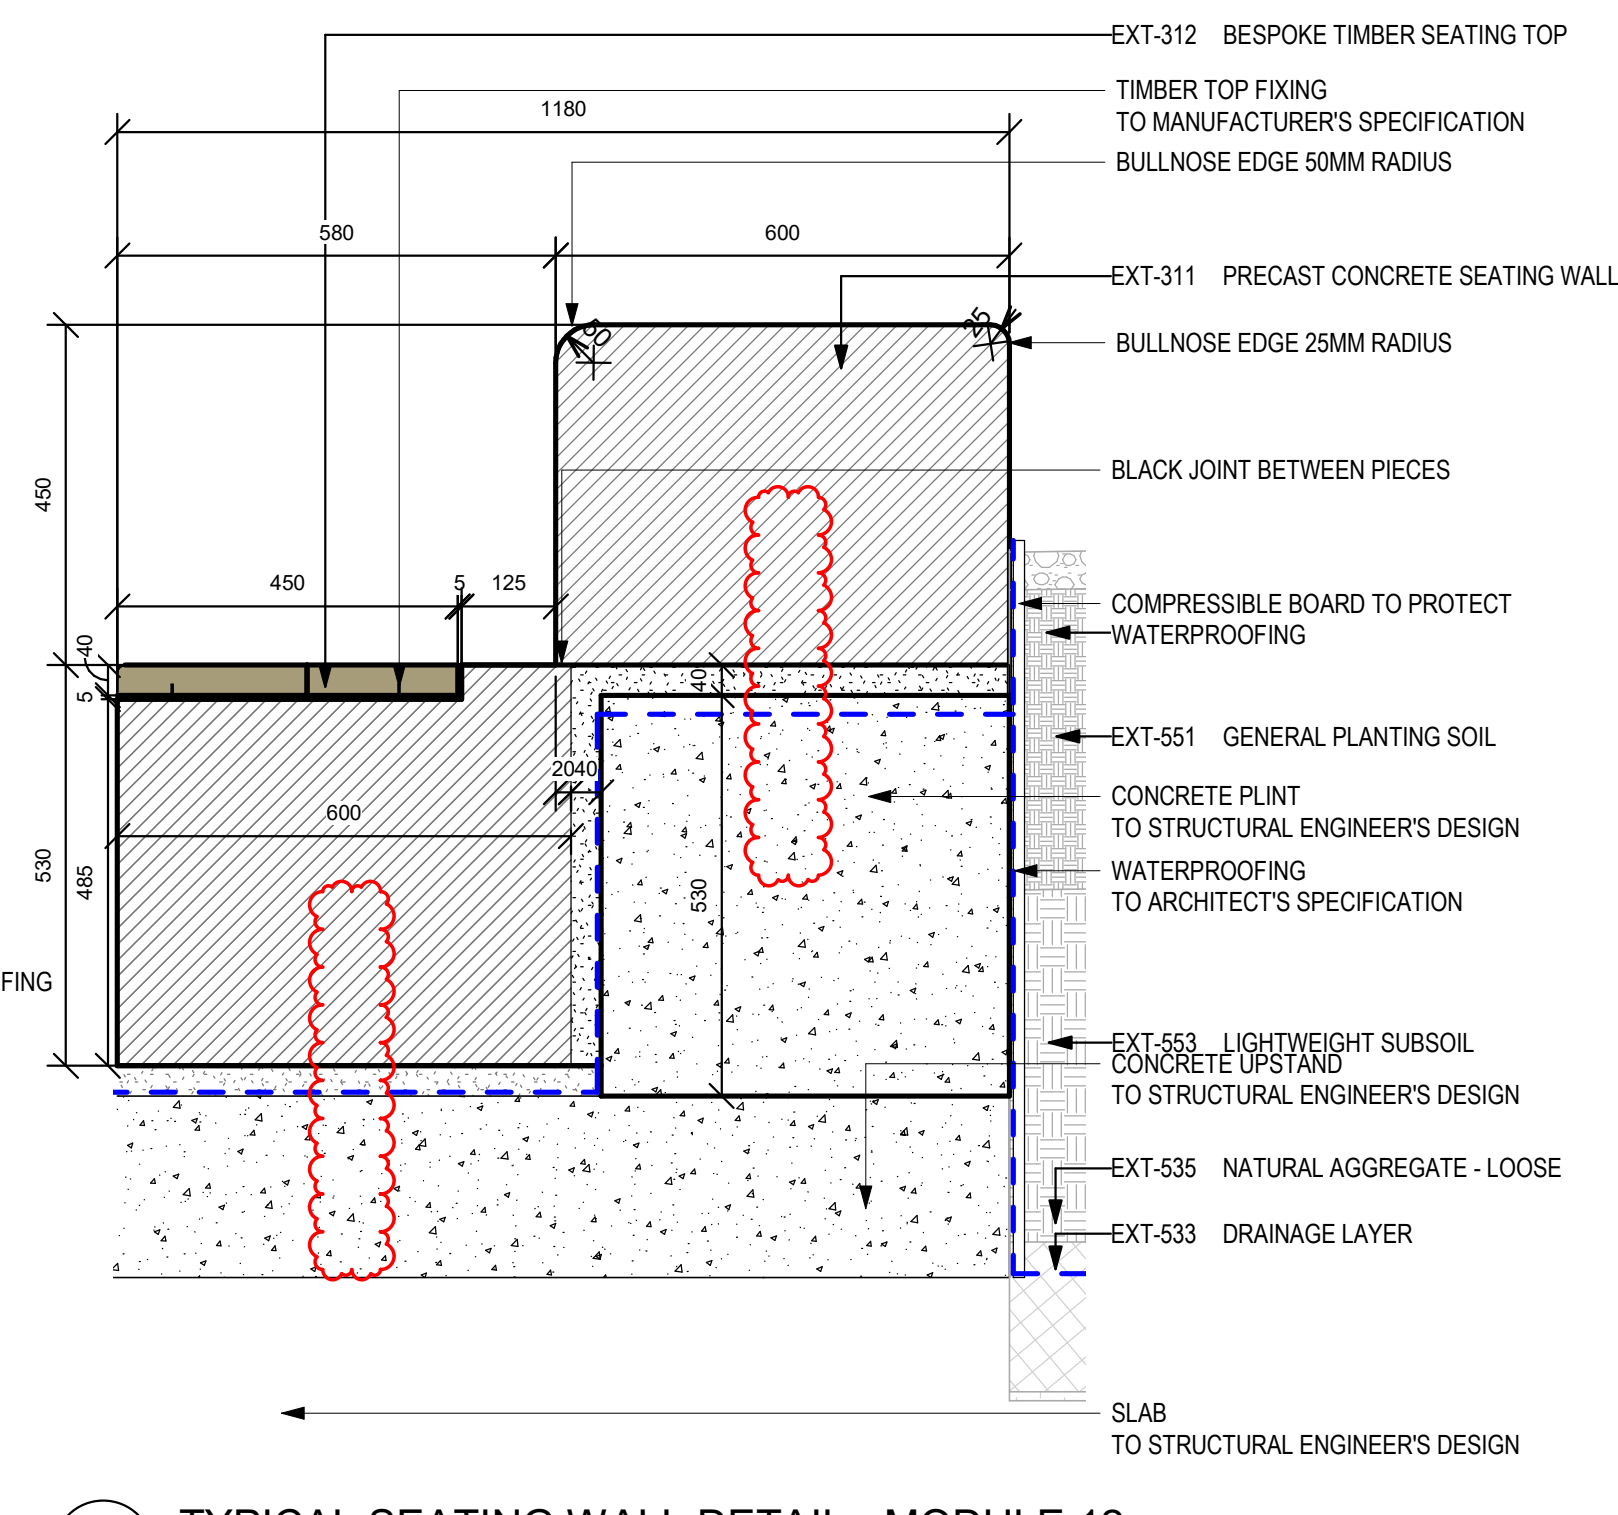


8 TYPICAL SEATING WALL DETAIL - MODULE 12

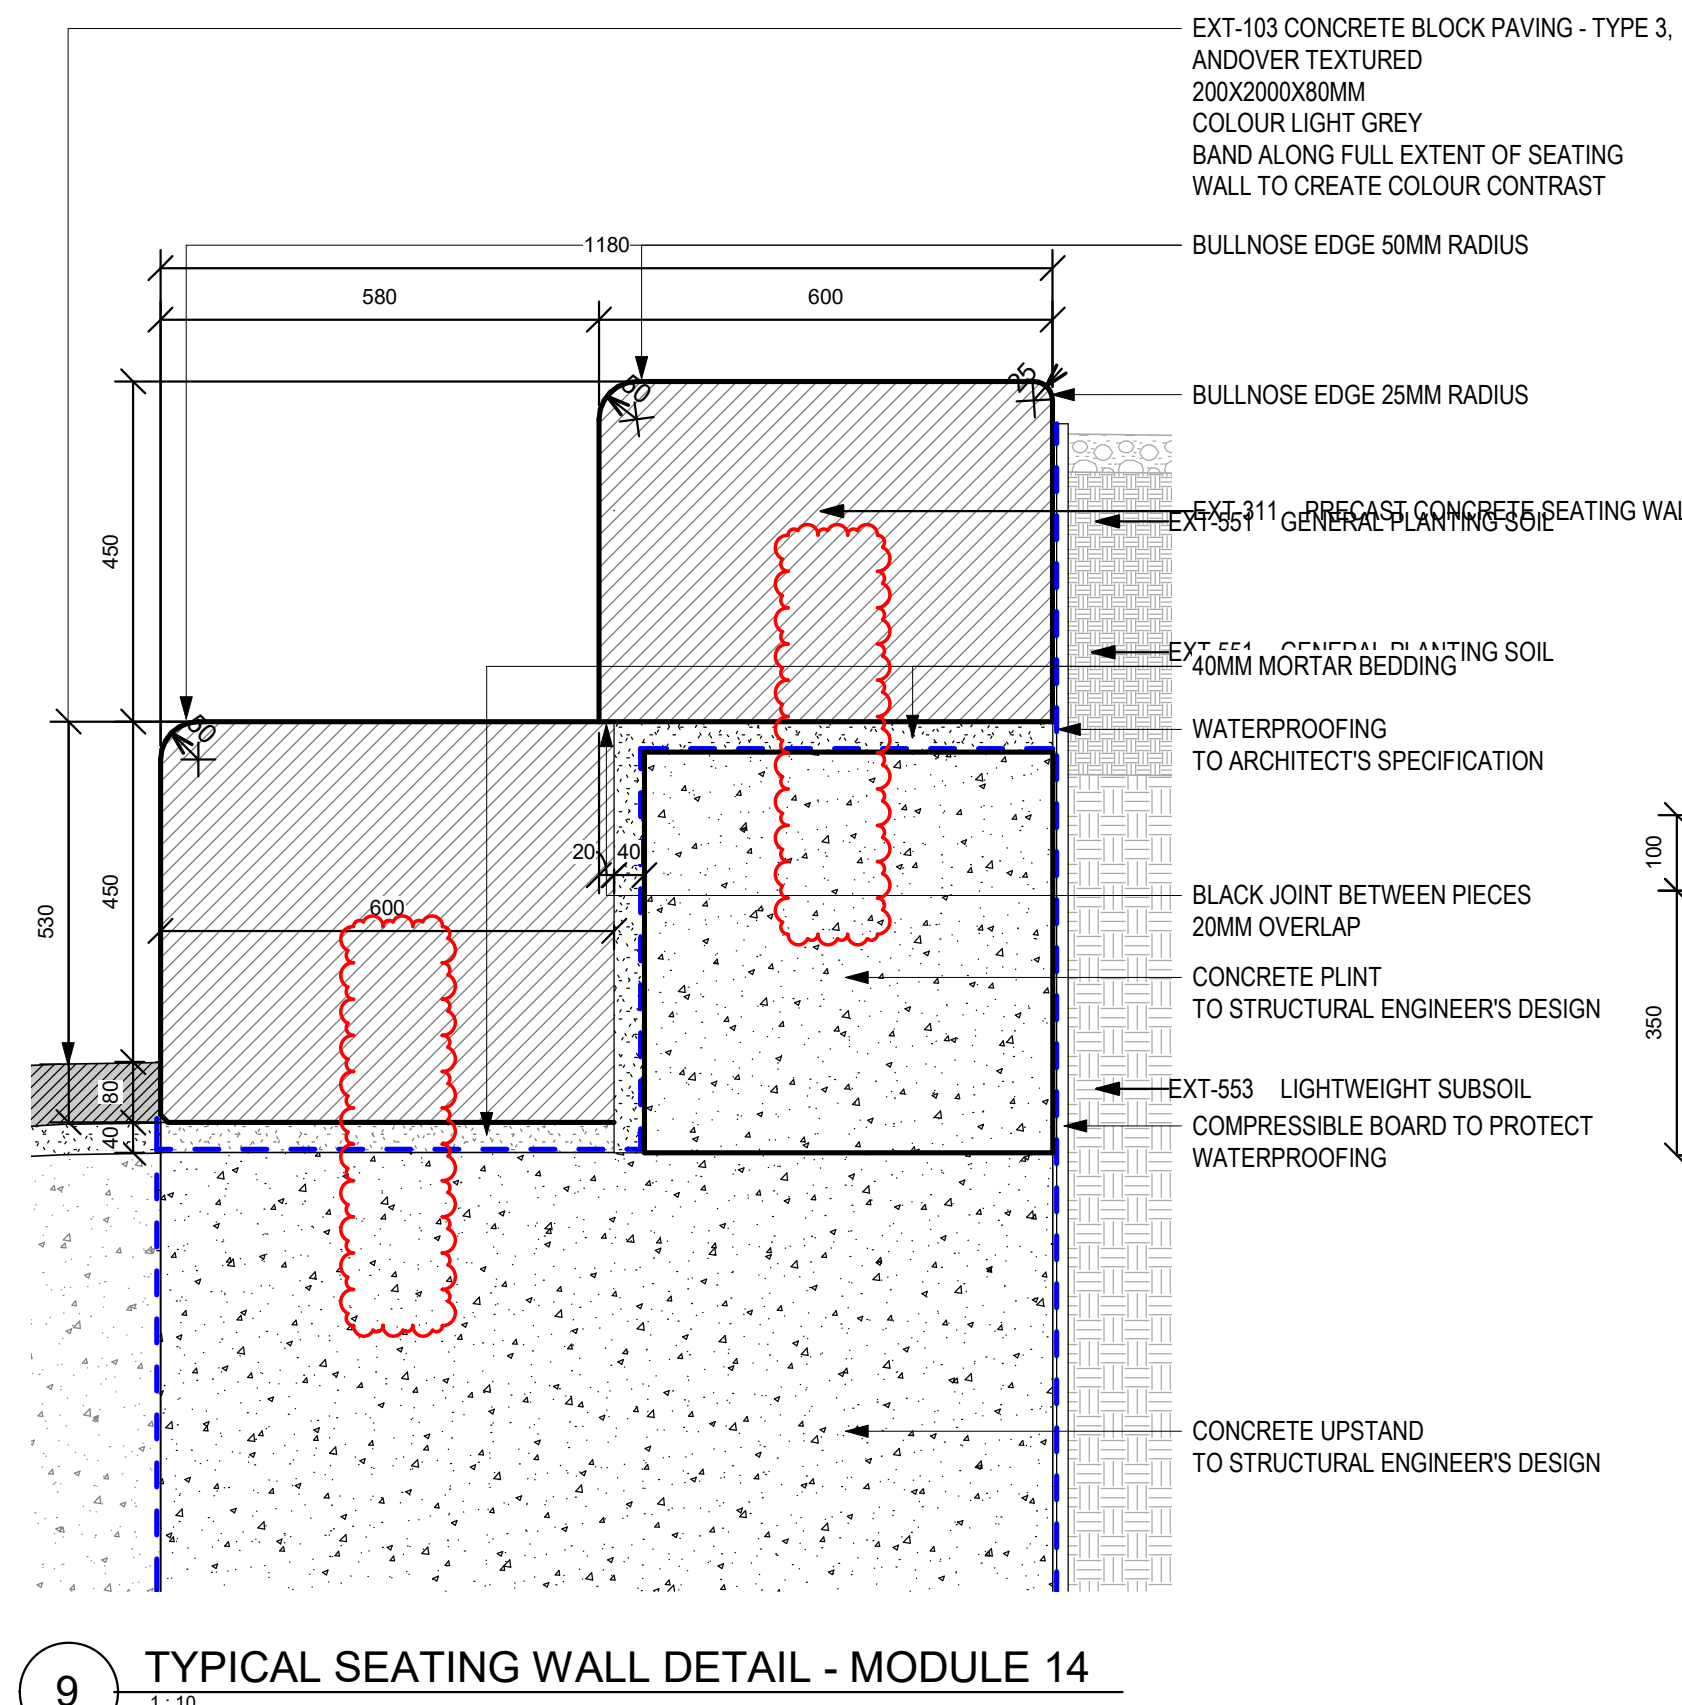


9 TYPICAL SEATING WALL DETAIL - MODULE 14

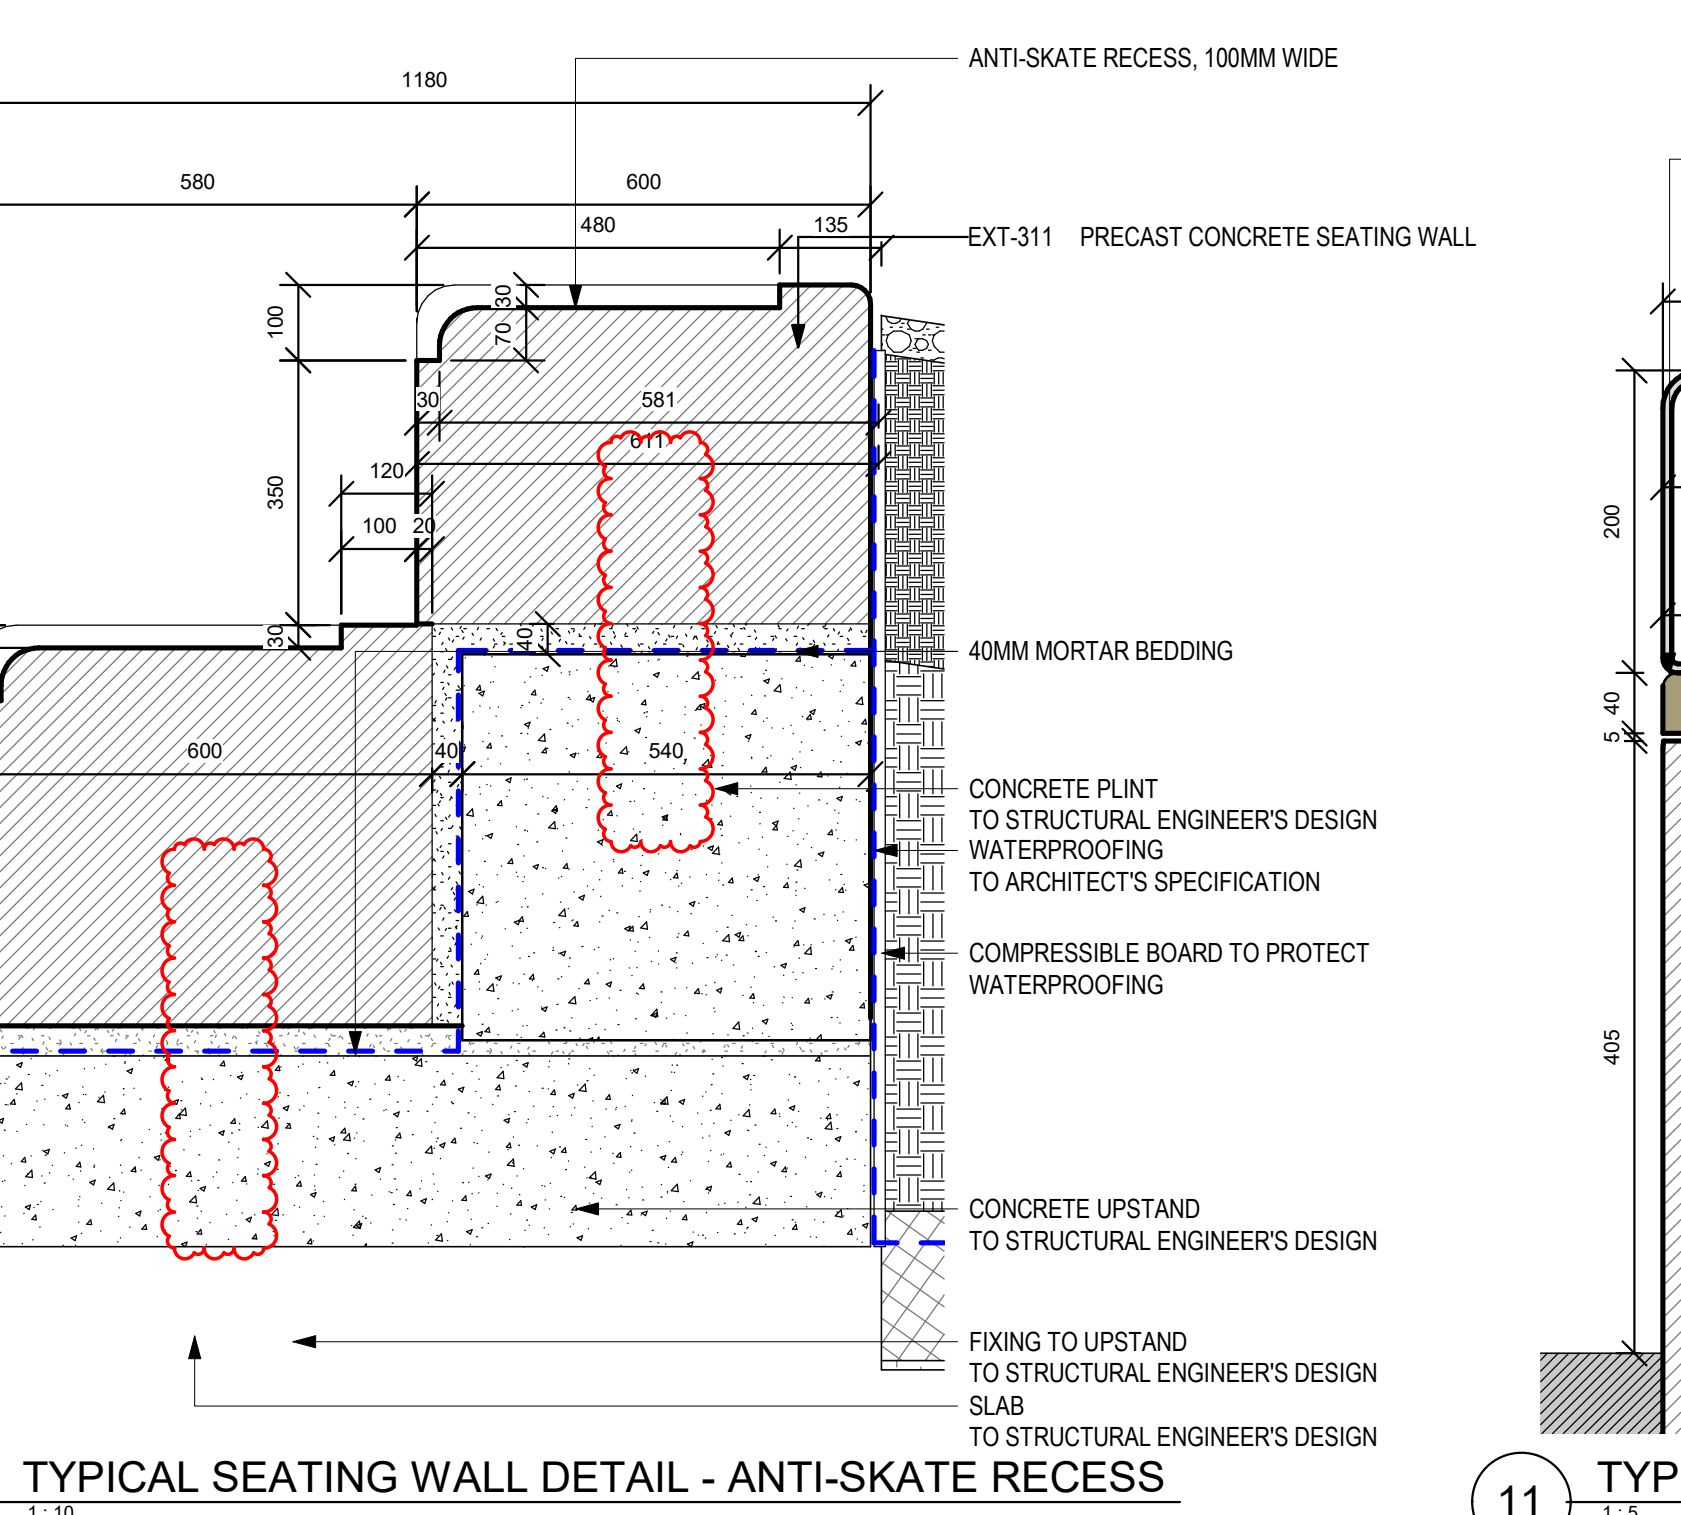

10 TYPICAL SEATING WALL DETAIL - ANTI-SKATE RECESS

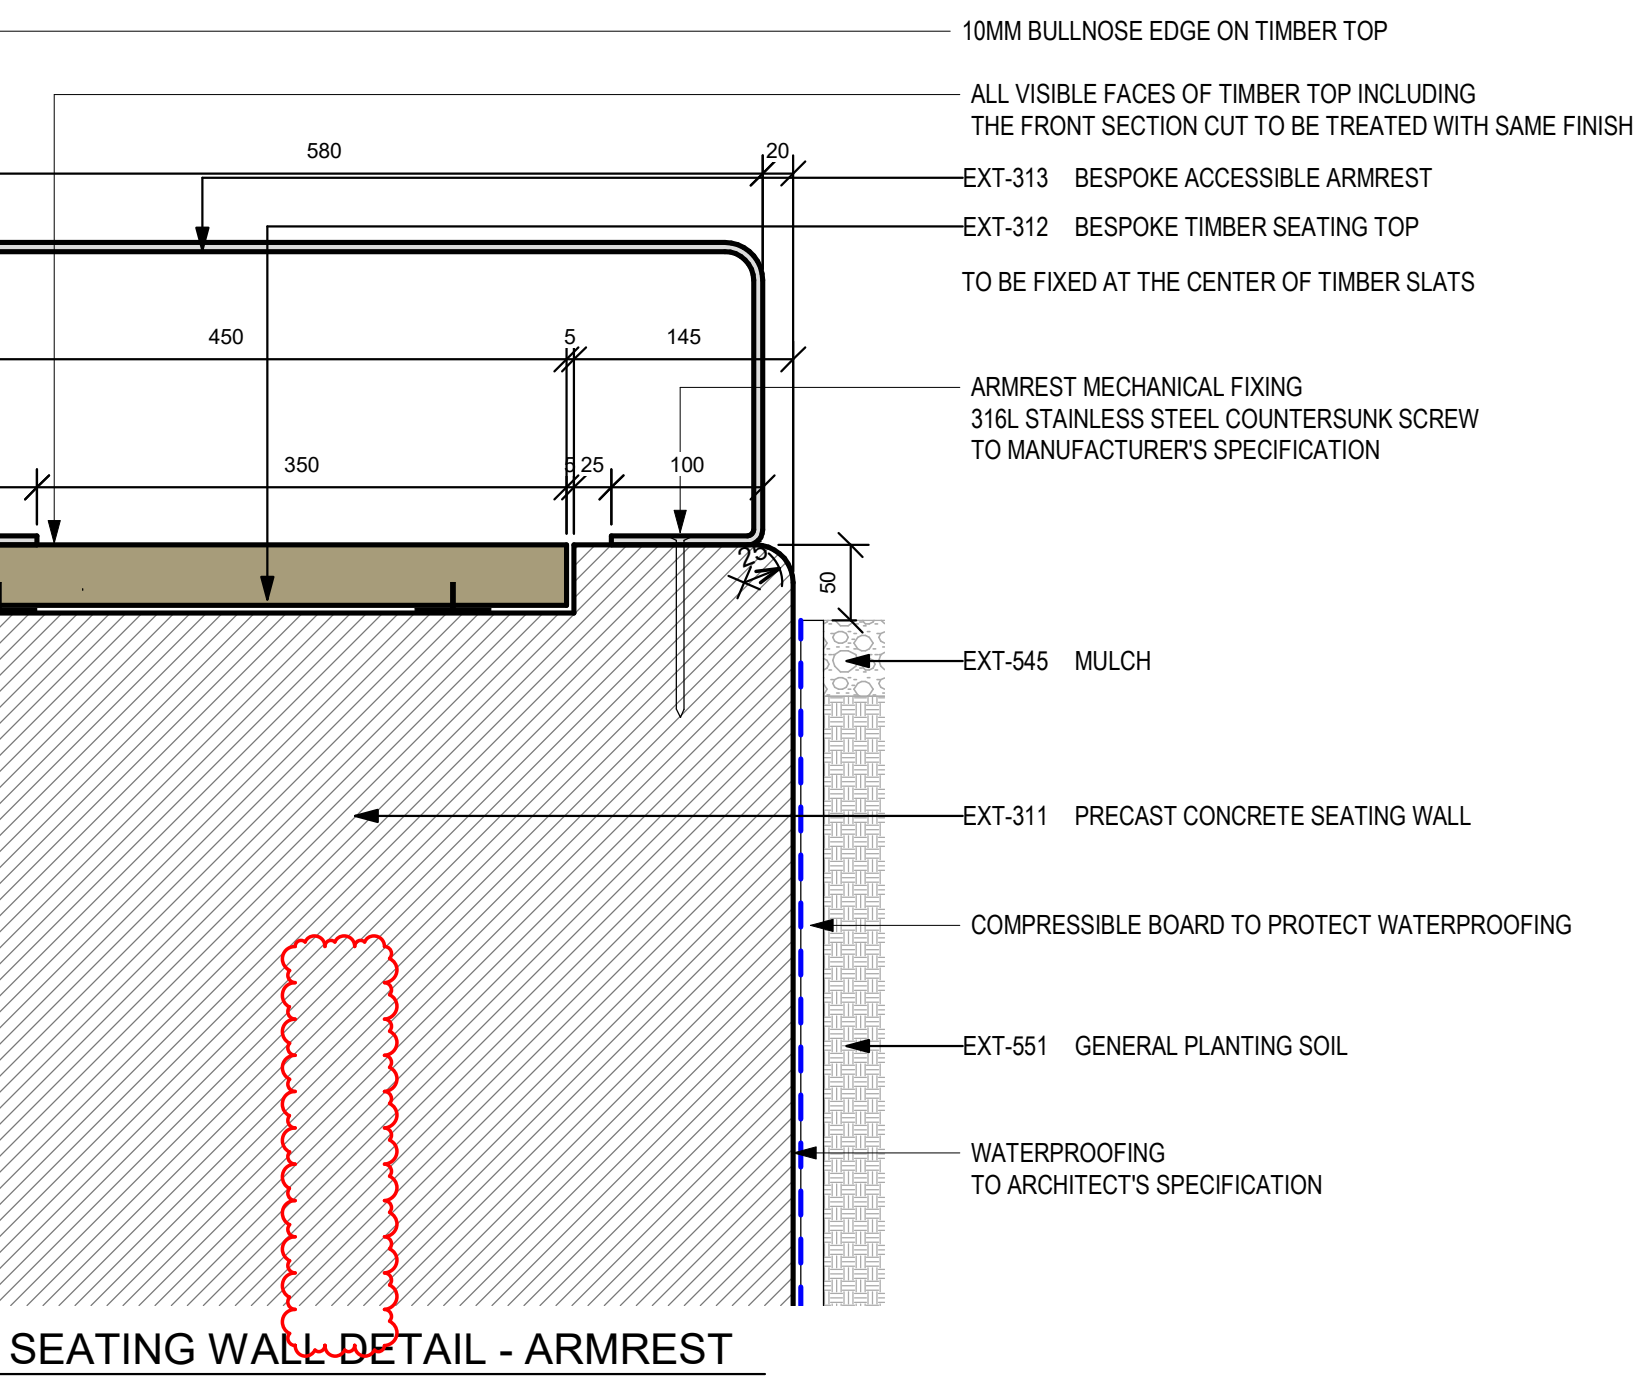

11 TYPICAL SEATING WALL DETAIL - ARMREST

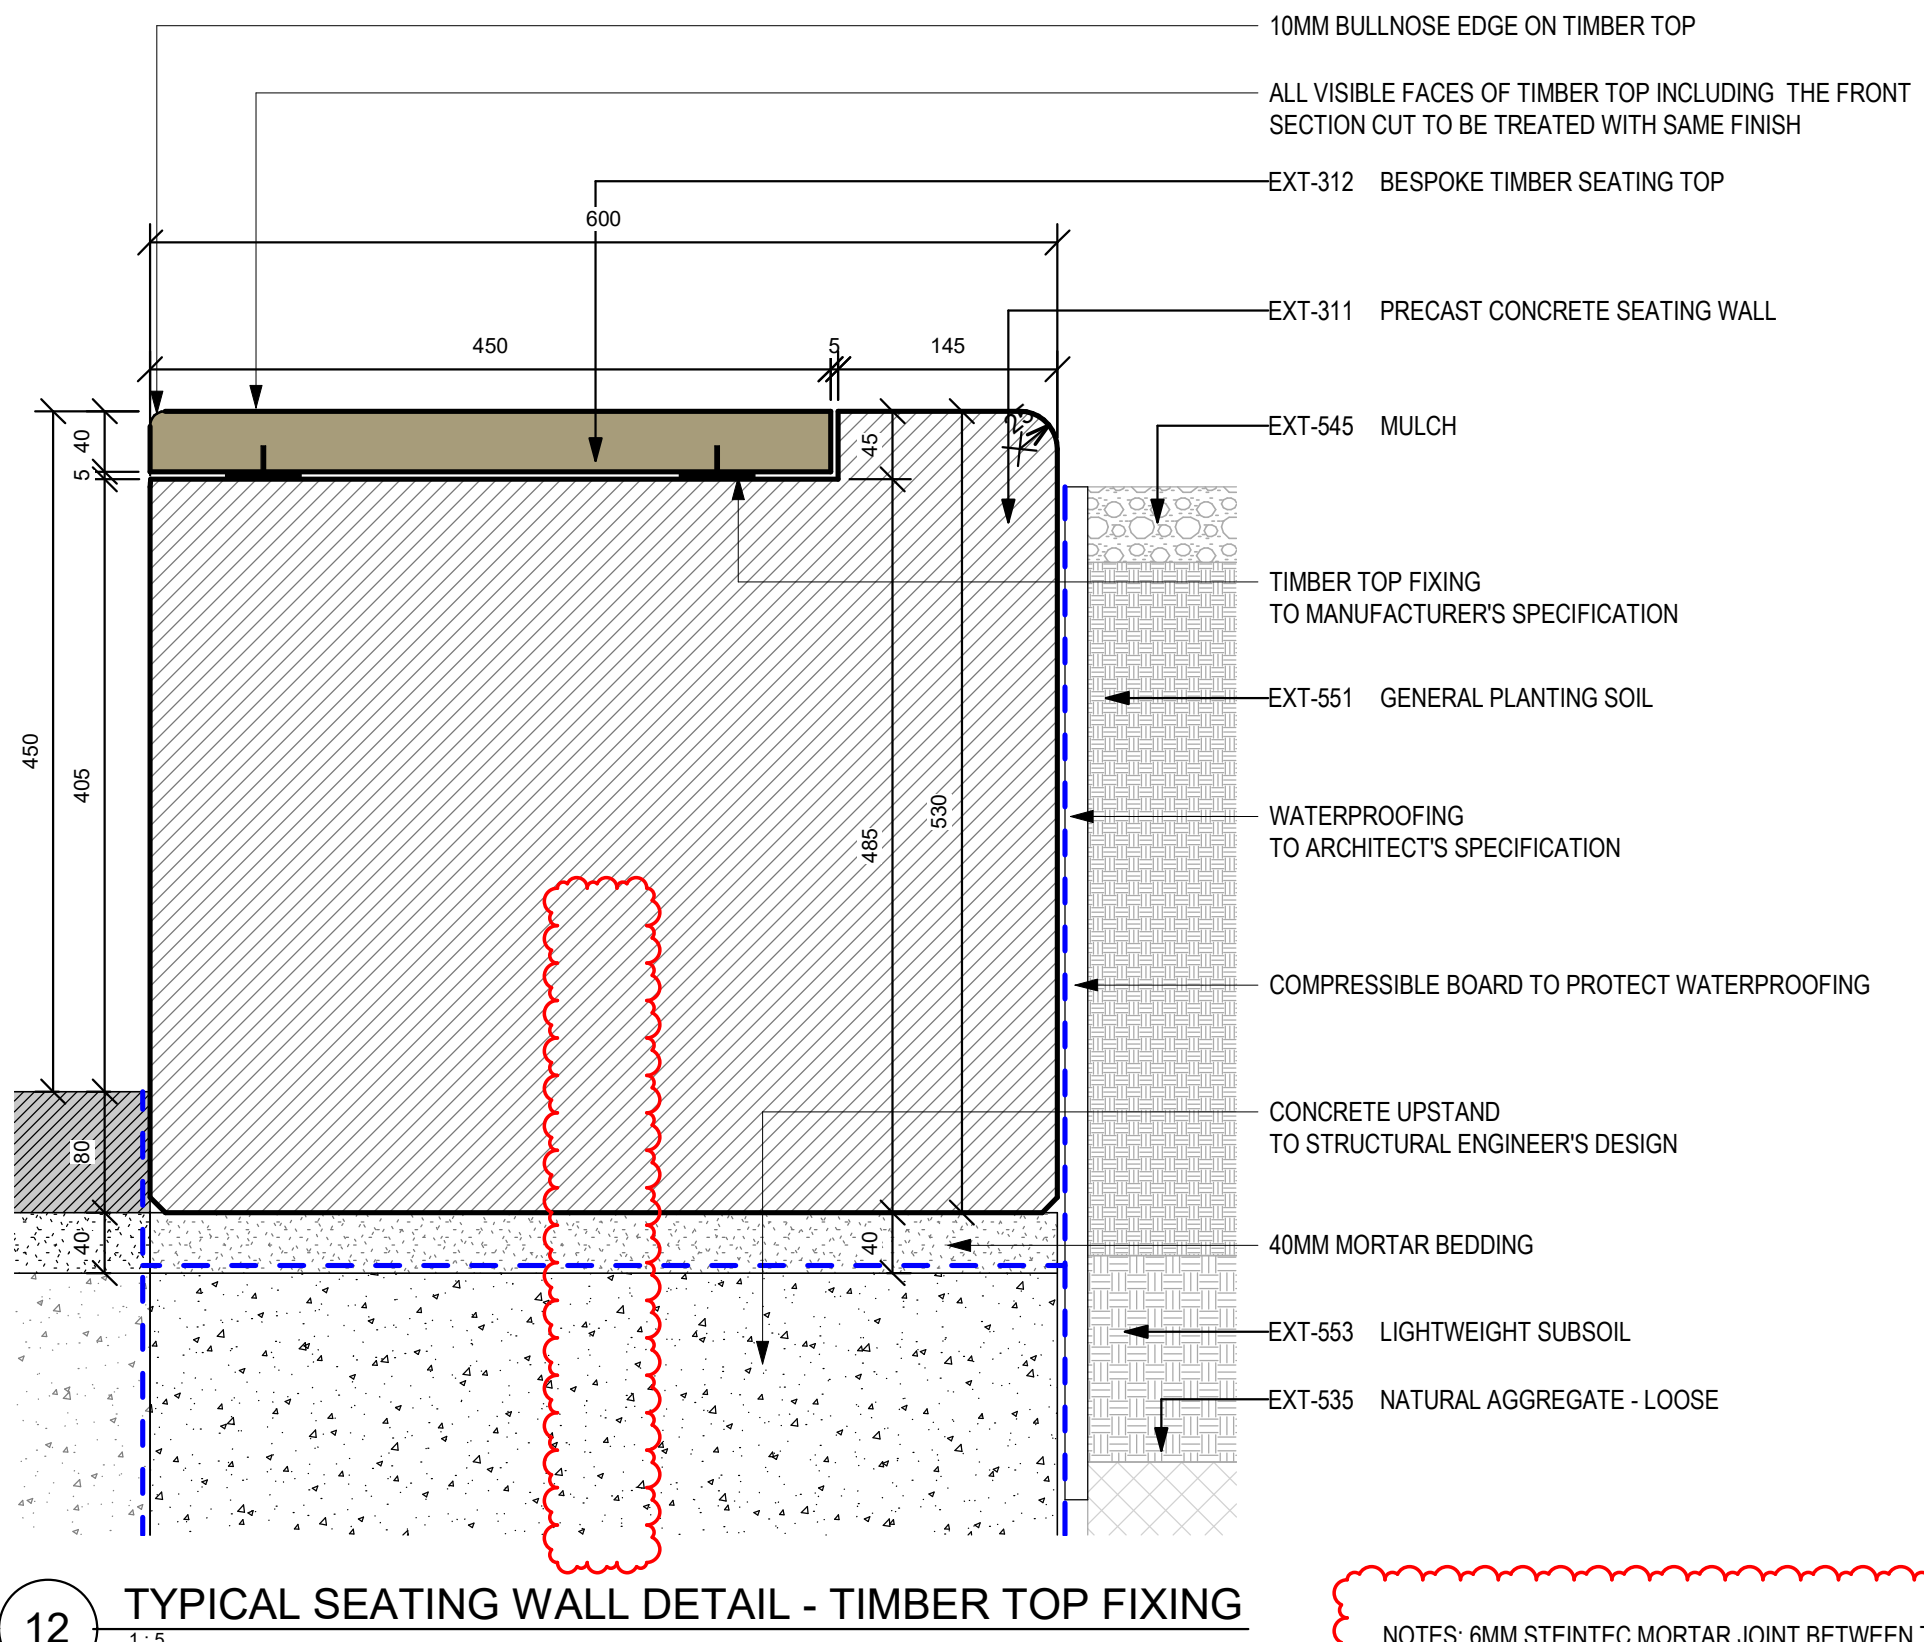

12 TYPICAL SEATING WALL DETAIL - TIMBER TOP FIXING

NOTES: 6MM STENTEC MORTAR JOINT BETWEEN THE PAVING AND SEATING UNIT

Stability Code (as defined in ISO 19650-2:2018)

Work in Progress (WIP)

50 - Under Review

Shared (Non-Contractual)

S1 - Suitable for co-ordination

S2 - Suitable for information

S3 - Suitable for review & comment

S4 - Suitable for stage approval

S5 - Withdrawn

S6 - Suitable for PM authorisation

S7 - Suitable for AM authorisation

Published (Contractual)

A1, A2, A3, etc. - Authorised and accepted

B1, B2, B3, etc. - Partial sign-off (with comments)

Published (AM Acceptance)

CR - As constructed record document

KEY PLAN

NOTES

- ALL JOINTS BETWEEN SEATING WALL PIECES TO BE BLACK
- FOR MODULAR PLAN REFER TO BRA-POP-ZZ-01-DR-L-8312
- FOR GENERAL SECTIONS REFER TO BRA-POP-ZZ-01-DR-L-8313

THIS DRAWING IS ONLY TO SCALE IF IT IS REPRODUCED AT THE CORRECT PAPER SIZE

1:10@A0

0 0.1 0.2 0.3 0.4 0.5

ALL INTERNAL LAYOUTS AND USES ARE SHOWN FOR ILLUSTRATIVE PURPOSES ONLY AND ARE NOT FOR DETERMINATION

THIS DRAWING IS ONLY TO SCALE IF IT IS REPRODUCED AT THE CORRECT PAPER SIZE

1:5@A0

0 0.05 0.1 0.15 0.2 0.3 0.4

ALL INTERNAL LAYOUTS AND USES ARE SHOWN FOR ILLUSTRATIVE PURPOSES ONLY AND ARE NOT FOR DETERMINATION

THIS DRAWING IS ONLY TO SCALE IF IT IS REPRODUCED AT THE CORRECT PAPER SIZE

1:2@A0

0 0.025 0.05 0.075 0.1 0.2

ALL INTERNAL LAYOUTS AND USES ARE SHOWN FOR ILLUSTRATIVE PURPOSES ONLY AND ARE NOT FOR DETERMINATION

Safety, Health and Environmental Information

In addition to the hazards / risks normally associated with the types of work detailed on this drawing, note the following risks and information:

Construction See risk register

No abnormal risks identified with this package of work.

For information relating to Use, Cleaning and Maintenance see the Health and Safety File. It is assumed that all works will be carried out by a competent contractor working, where appropriate, to an approved method statement.

client

OVG INTERNATIONAL

© COPYRIGHT. ALL RIGHTS RESERVED

THIS WORK IS COPYRIGHT AND CANNOT BE REPRODUCED OR COPIED IN ANY FORM OR BY ANY MEANS, IN ANY MANNER, WITHOUT THE WRITTEN PERMISSION OF POPULOUS. ANY UNLAWFUL REPRODUCTION OF THIS DOCUMENT OR ANY PARTS THEREOF IS PROHIBITED BY THE TERMS OF THE AGREEMENT OR IMPLIED AGREEMENT BETWEEN POPULOUS AND THE INSTRUCTING PARTY.

USE REQUIRED DIMENSIONS IN PREFERENCE TO SCALED. CHECK ALL DIMENSIONS ON SITE BEFORE FABRICATION OR SETTING OUT.

author

POPULOUS®

14 BLADES COURT | DODDAR ROAD | LONDON | SW15 2NU | UNITED KINGDOM

TELEPHONE +44 (0)20 8874 7686 FACSIMILE +44 (0)20 8874 7470

ALL PRODUCTION & INTELLECTUAL PROPERTY RIGHTS RESERVED © POPULOUS 2020

REVISIONS		
REV	DATE	DESCRIPTION
00	29.11.2019	DRAFT RIBA STAGE 3
01	14.04.2020	ISSUED FOR T1 DRAFT STAGE 4A
02	22.06.2020	ISSUED FOR T2 STAGE 4A
03	30.04.2021	STAGE 4B PRECAST SEATING WALL VER18064
04	18.06.2021	STAGE 4B REVISED TO INCORPORATE VE
05	18.07.2021	STAGE 4B SEATING WALL TO INCORPORATE VE
001	21.01.2022	SEATING WALL ISSUED FOR CONSTRUCTION
002	22.05.2023	CONCRETE SEATING UPDATE

project name

Co-op Live

the TYPICAL SEATING WALL DETAILS

LEVEL 01

purpose of issue

IT0001-48

scale 1:10, 1:5 @ A0

drawn FP

checked TJ

project no. 4933

date 29/11/19

project code original version level title number

revision BRA-POP-ZZ-01-DR-L-8304

no. 002

stability

S3