
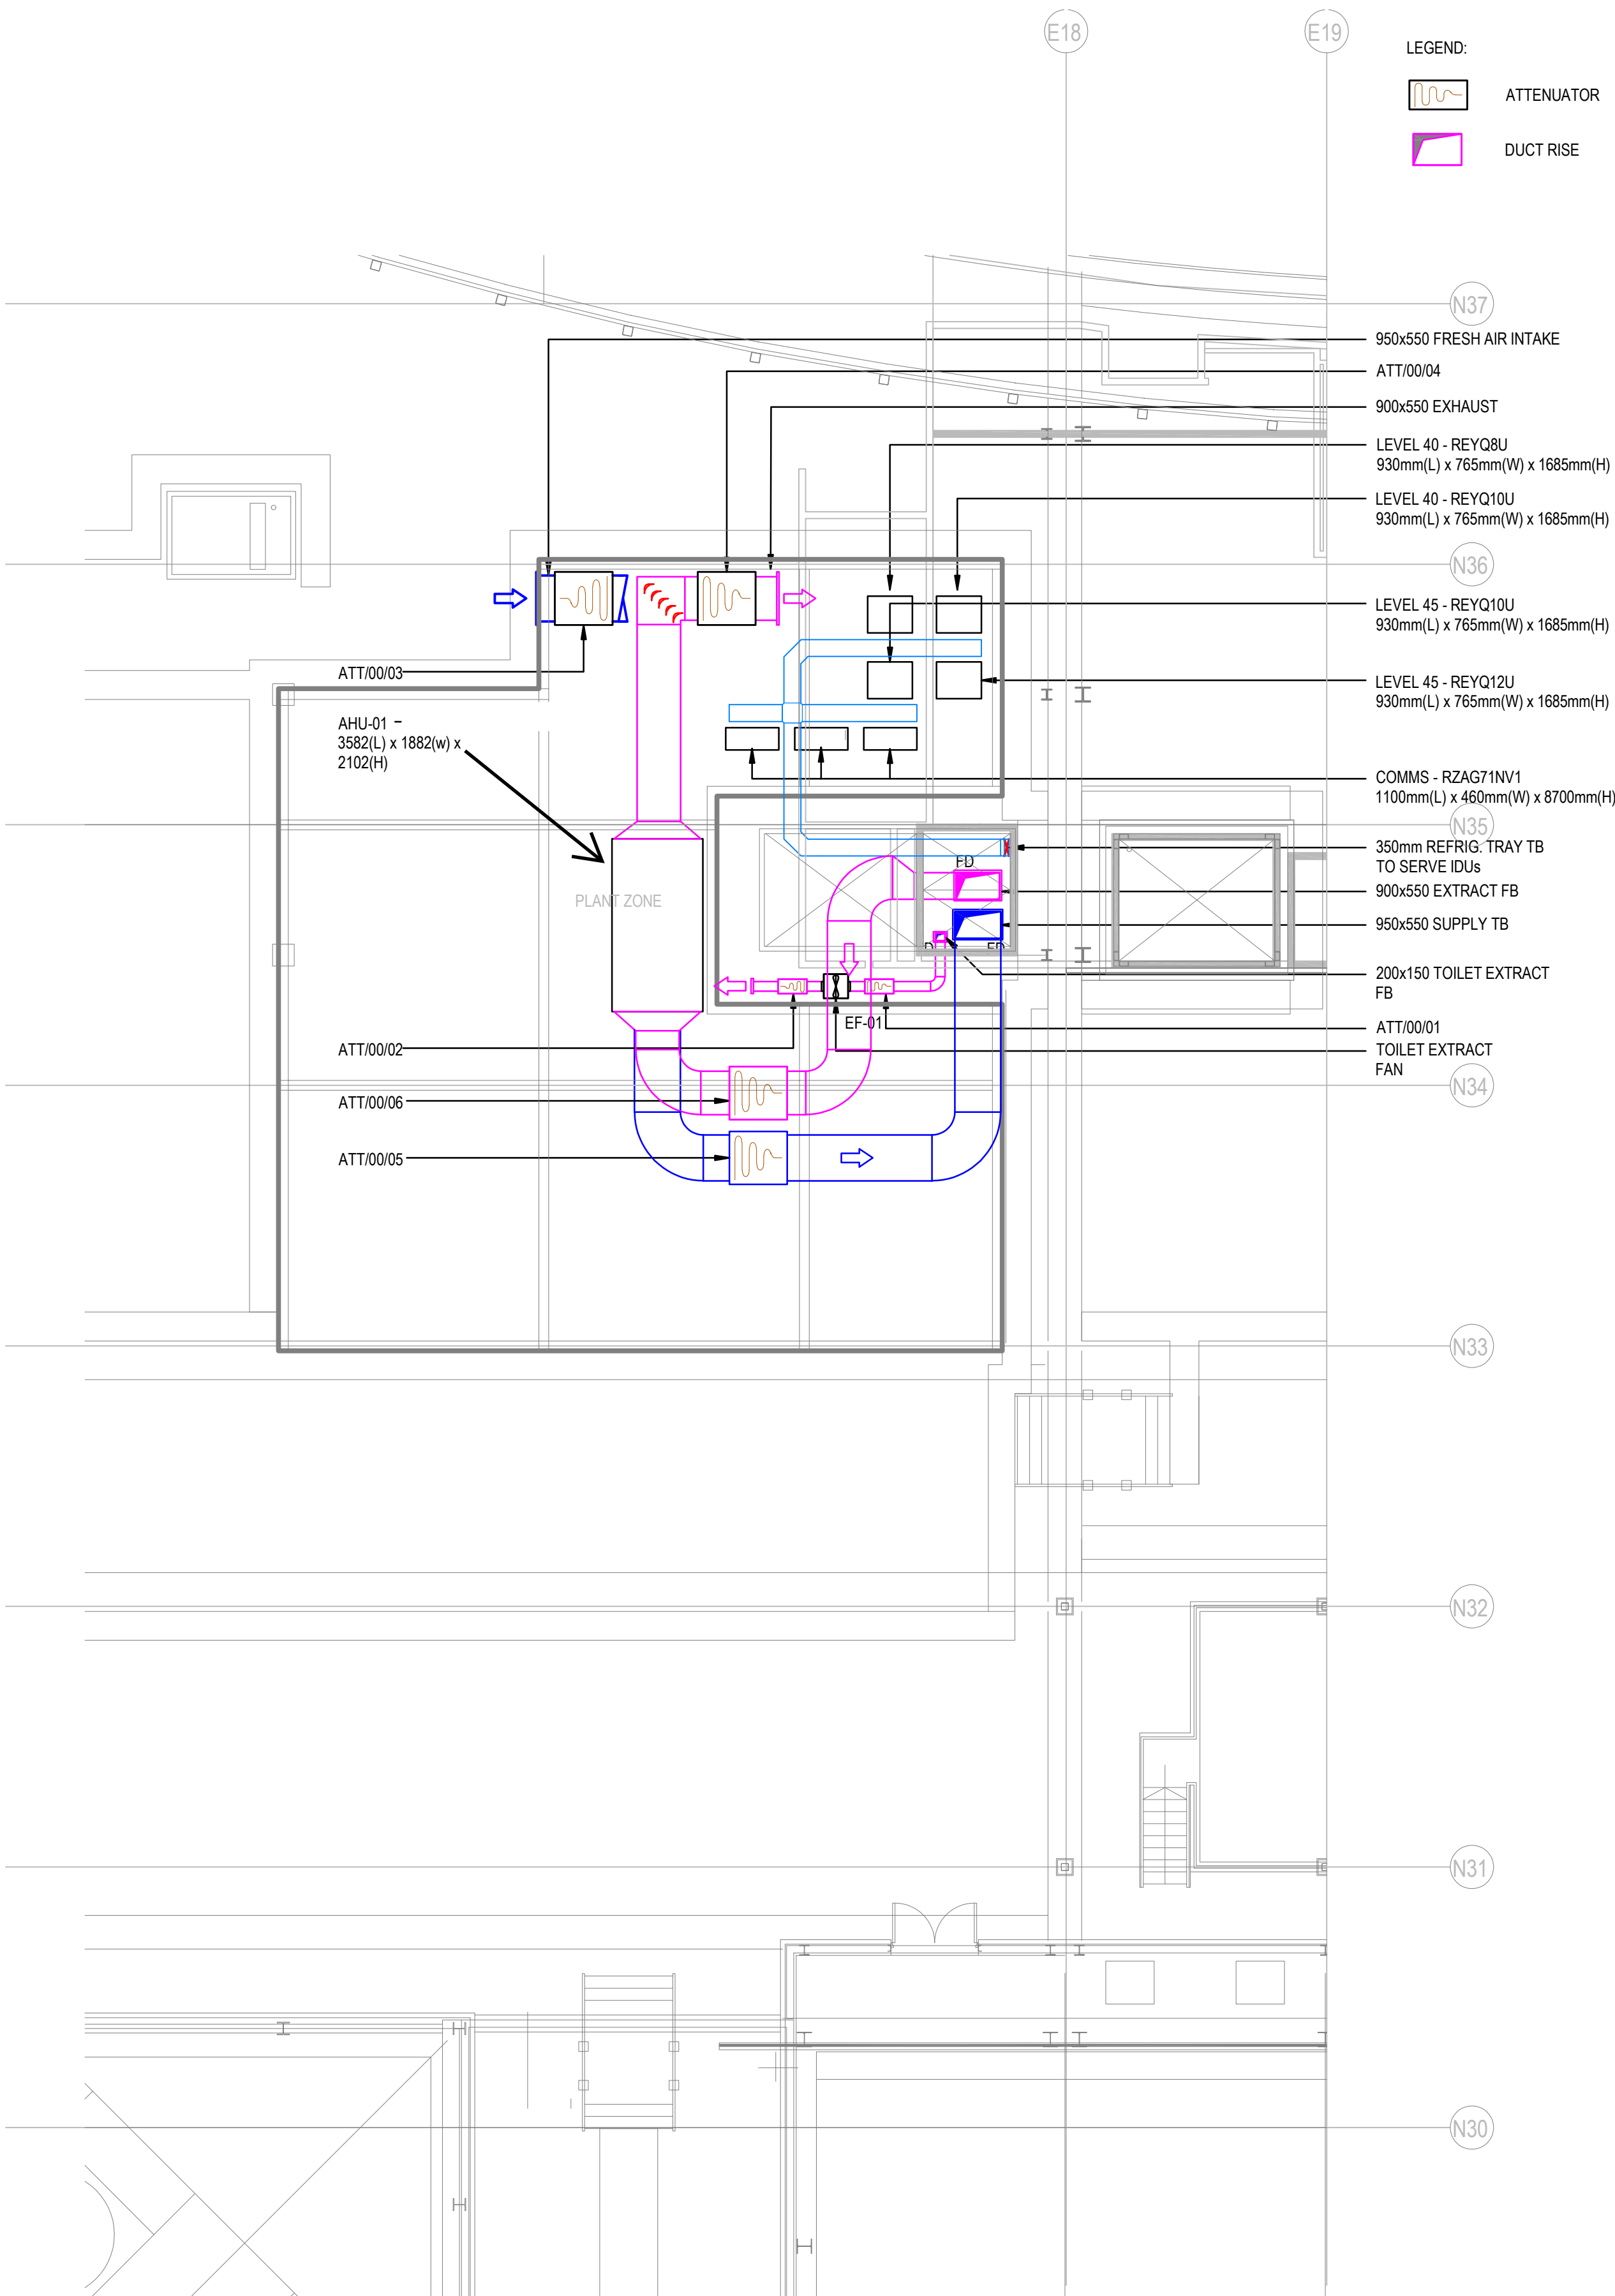


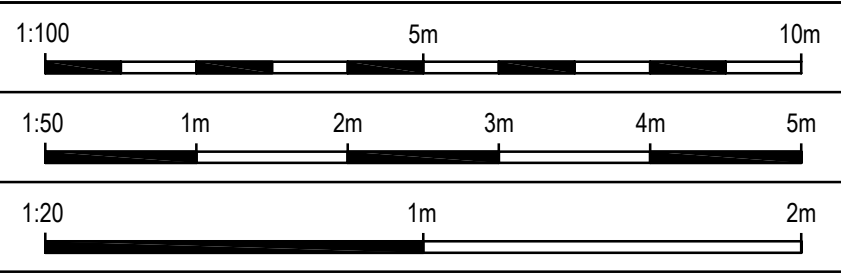

AS	KC	31/10/23	As Installed
Rev	By	Date	Description
REVISIONS			
For mechanical services design risk assessment refer to Woodward & Co. Document: N/A			
Title: Mechanical Services Ventilation & Air Conditioning Plant Deck			
Project: Nike Rise Stores Manchester			
Client: Nike			
Date:	OCT 23	Designed:	By Others
Scale at A1:	1:100	Drawn:	KC
Project No:	P2479	Approved:	RK
WOODWARD & C^o Woodward & Co. (Environmental) Ltd The Courtyard, Severn Drive Tewkesbury, Glos GL20 8GD Telephone: (01684) 850005 Email: office@woodward.uk.com Web: www.woodward.uk.com			
Drawing No: 2479-M-08			Rev: AS