
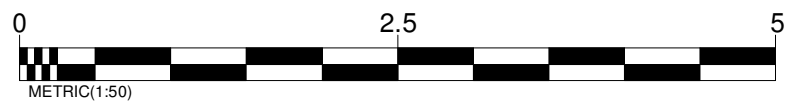


IMPORTANT NOTE:
ALL DIMENSIONS AND LEVELS SHOWN ON THIS DRAWING ARE TO BE CHECKED BY THE CONTRACTOR MANUFACTURER PRIOR TO THE COMMENCEMENT OF ANY WORKS ON SITE OR THE MANUFACTURE OF ANY SITE COMPONENTS.
THIS DRAWING IS NOT TO BE SCALED.
DIMENSIONS ARE INDICATED IN MILLIMETRES UNLESS CLEARLY STATED OTHERWISE.
COPYRIGHT OF THIS DRAWING BELONGS SOLELY TO CUBE PSL.
LIMITATIONS & THIRD PARTY CLAUSE:
WHERE PARTS OF THE PROPERTY WERE COVERED OR INACCESSIBLE AT TIME OF SURVEY POSITIONS OF ELEMENTS ARE MARKED "ASSUMED" ACCORDINGLY.

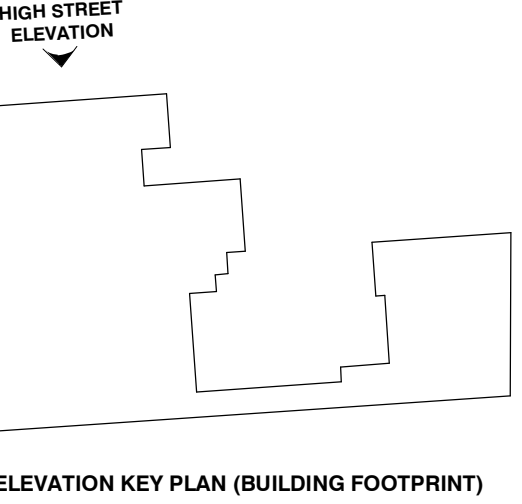

PROPOSED HIGH STREET ELEVATION WORKS

Scale: 1 : 50

REV	DESCRIPTION	DATE	BY
F	DRAWINGS PREPARED FOR 'AS BUILT' ISSUE	14 03 2023	RG
E	ADDITIONAL FACADE DETAILS ADDED FOR PLANNING	22 02 2023	RG
D	ANNOTATION AMENDMENTS FOR PLANNING	07 09 2022	RG
C	ELEVATION DRAWINGS AMENDED FOR PLANNING	02 09 2022	RG
B	SIGNAGE DRAWINGS AMENDED FOR PLANNING	16 08 2022	RG

REVISIONS

CLIENT			
FRASERS GROUP			
PROJECT			
MANCHESTER ARNDALE			
DRAWING TITLE			
PROPOSED HIGH ST ELEVATION WORKS			
DRAWN BY	RG	DATE	28 06 2021
CHECKED BY	SP	SCALEs	As indicated @ A1
DRAWING NO.	CPS 20 077 110 F		