

COLT PLANT ENQUIRIES

C.A TELECOM UK LIMITED
Unit 2, CA Business Park
Colewood Road
Whitstable
Kent CT5 2RP



Email: plantenquiries@catelecomuk.com

Tel: 01227 768427

Our Reference: P038650

OVERSEEING ORGANISATION AGENT ACHEME REFERENCE

O.O Agent – Cornerstone Projects
Contact – Ryan Lowndes
Title – Brunswick Mill, Manchester, M40 7EZ
Scheme Ref – N/A

10th August 2023

Dear Sir/Madam,

Thank you for your enquiry for the above reference. We can confirm that Colt Technology Services do have apparatus near the above location within the scheme reference and enclose the relevant drawings showing the approximate location of Colt apparatus for purpose of initial plant enquiry. Detailed network location will be presented via Scheme Identification Study Process. All reasonable effort has been made to capture network however image may not reflect unprocessed new build track. Search is based on Overseeing Organisation Agent data supplied; we do not accept responsibility for O.O Agent inaccurate data.

If your proposed works are likely to affect or expose the Colt Technology Services apparatus in anyway please contact Colt Civils Team members below to discuss any plant protection/diversionary measures that may be required, as per the code of Practice Measures necessary where apparatus is affected under NRSWA 1991 Diversionary Works Scheme Identification & Preliminary C2 Enquires. Along with proposed start dates for works to begin.

Clients request for C3 budget costs will trigger the onsite survey to ascertain the requirement's needed to ensure a safe area for the affected COLT network

Colt company policy negates any potentially detrimental effect on the network as well as protecting us from any potential costs and damages.

Please note as COLT moves to C3 status we will require an estimated start date for the project to allow for COLT policy lead-time's

Please email plantenquiries@catelecomuk.com with your official C3 Request.

We would remind you that mechanical excavators or borers should never be used within 1500mm of any COLT Technology Service apparatus.

If we can be of any further assistance please do not hesitate to contact us.

Yours sincerely,
Plant Enquiry Team



CONFIDENTIAL

PREPARED BY C.A. TELECOM UK LTD

DATE: 10th August 2023

Our Ref: P038650

UTILITY UNDERTAKER

colt

Colt Technology Services
Beaufort House,
15 St Botolph Street,
London, EC3A 7QN

www.colt.net

PLANT ENQUIRY AGENT FOR Colt




C.A. TELECOM UK LTD
Unit 2
CA Business Park
Colewood Road
Whitstable
Kent CT5 2RP

CONTACT Tel: 01227 768427
Fax: 01227 458884
email: plantenquiries@catelecomuk.com

MAP IMAGE PERMISSIONS


Centara supplied map
Promap

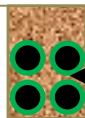

NOMINAL DEPTH
OF COVER
250mm F/W
550mm C/W

COLT NETWORK LEGEND

Colt
Infrastructure
Network

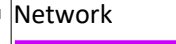

NRSWA 1991 Diversionary Works

SCHEME & PRELIMINARY INQUIRIES C2
Colt Technology Services External
Infrastructure general location indicated
only for purposes of initial plant enquiry,
detailed network location will be presented
via Scheme Identification Study process. All
reasonable effort has been made to capture
network however image may not reflect
unprocessed new build track.

OVERSEEING ORGANISATION AGENT REFERENCE

O.O Agent – Cornerstone Projects
Contact – Ryan Lowndes
Title – Brunswick Mill, Manchester, M40 7EZ
Scheme Ref – N/A

Our Ref: 30451195 Your Ref: Brunswick

Wednesday, 09 August 2023

Duncan Phillips
91 91 Market Street
Hoylake
MSY
CH47 5AA

Dear Duncan Phillips

Neos Networks - Asset Network Plans

We acknowledge with thanks your request for information on the location of our assets.

We have attached a plan showing the location of Neos Networks apparatus in the proposed work area for your information. If the map provided is missing any required information e.g. a background map, then please email C2requests@neosnetworks.com who will provide a more detailed map.

If you're laying your own services, please use the map provided showing our apparatus and follow your safe dig procedures. There is no need to contact us for permission to dig or arrange any supervision.

If you have determined your works may impact our existing apparatus, then please contact alterations@neosnetworks.com for a Budget Estimate. For us to provide you with a Budget Estimate we will require the following information in order to progress your query as quickly and as efficiently as possible:

- A covering letter or details on the email
- Plans / maps showing existing & proposed conditions (min 1:500 scale and PDF format if emailed)
- Scheme cost apportionment information with confirmation of who the works principal is (the person or company funding your project)

Neos Networks will respond with a Budget Fee letter (if your scheme falls outside of NRSWA) showing the payment required to prepare a Budget Estimate.


Yours sincerely

Neos Networks Team

Address: Neos Networks, 4 Penner Road, Havant, Hampshire, PO9 1QH
Telephone: 023 92 494 923
Email: C2requests@neosnetworks.com

For more information, visit our website:

<https://neosnetworks.com/our-network/plant-enquires>

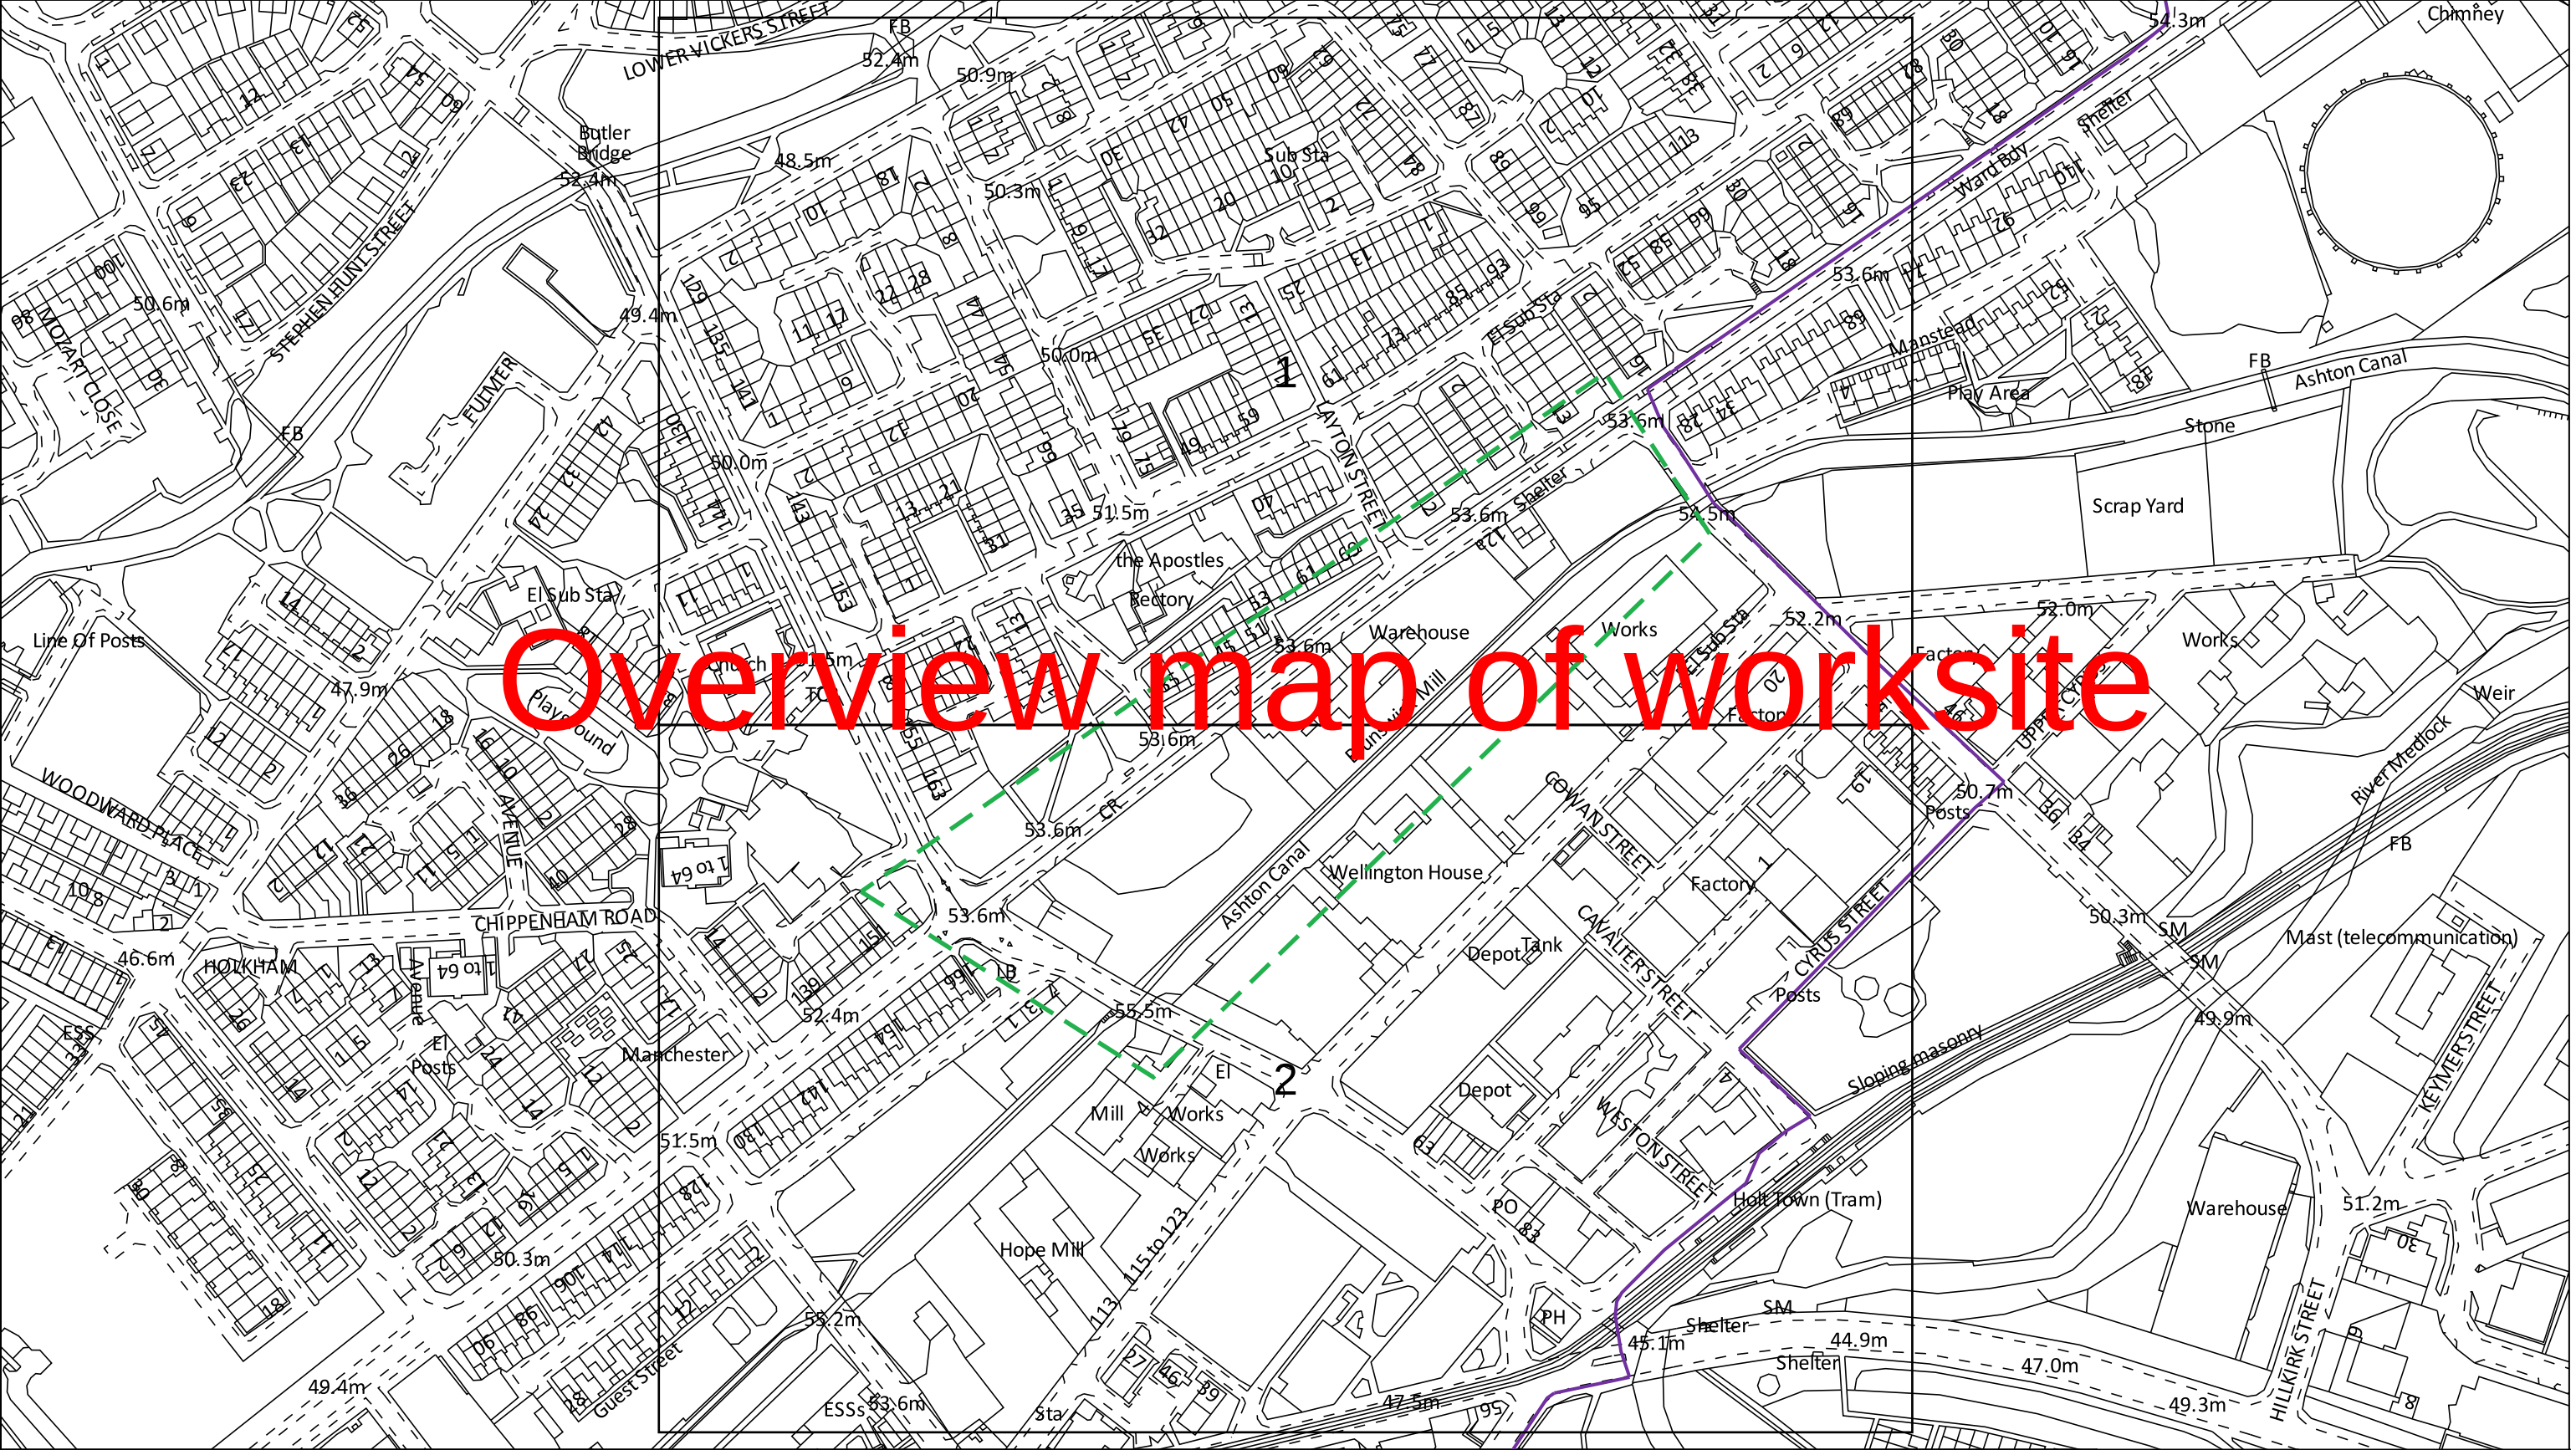

Date Requested: 09/08/2023
Job Reference: 30451195
Site Location: 385846 398726

Requested by:
Mr Duncan Phillips
Your Scheme/Reference: Brunswick

Scale: 1:2562 (When plotted at A3)

The information on this document is proprietary and shall not be used, copied, reproduced or disclosed in whole or in part without written consent of Neos Networks. Approximate location only is shown. To determine exact location a trial hole must be dug with a Neos Networks Supervisor present. Neos Networks accept no liability for errors or omissions.

Neos Network Underground Route

Emergency Number: 0345 305 3337

Dig Sites Area: Line:

The quality and accuracy of any print will depend on your printer, your computer and its print settings. Measurements scaled from this plan may not match measurements between the same points on the ground.


Registered Office:

Inveralmond House,
200 Dunkeld Road,
Perth, PH1 3AQ

Some of the material on this plot has been reproduced from an Ordnance Survey map with permission of the Controller of Her Majesty's Stationery Office, © Crown Copyright. Licence No. 0100048661
Warning: PDF designed for colour print only with no page scaling. This Information is given as a guide only and its accuracy cannot be guaranteed
Plans generated by DigSAFE Pro™ software provided by LinesearchbeforeUdig.



<p>0 100 m</p> <p>Date Requested: 09/08/2023 Job Reference: 30451195 Site Location: 385846 398726</p> <p>Requested by: Mr Duncan Phillips Your Scheme/Reference: Brunswick</p> <p>Scale: 1:1250 (When plotted at A3)</p>		<p>Dig Sites Area: Line:</p> <p>The quality and accuracy of any print will depend on your printer, your computer and its print settings. Measurements scaled from this plan may not match measurements between the same points on the ground.</p>		<p>NEOS NETWORKS</p> <p>Registered Office: Inveralmond House, 200 Dunkeld Road, Perth, PH1 3AQ</p>	
<p>The information on this document is proprietary and shall not be used, copied, reproduced or disclosed in whole or in part without written consent of Neos Networks. Approximate location only is shown. To determine exact location a trial hole must be dug with a Neos Networks Supervisor present. Neos Networks accept no liability for errors or omissions.</p>		<p>Neos Network Underground Route</p>		<p>Emergency Number: 0345 305 3337</p>	
<p>Some of the material on this plot has been reproduced from an Ordnance Survey map with permission of the Controller of Her Majesty's Stationery Office, © Crown Copyright. Licence No. 0100048661 Warning: PDF designed for colour print only with no page scaling. This Information is given as a guide only and its accuracy cannot be guaranteed Plans generated by DigSAFE Pro™ software provided by LinesearchbeforeUdig.</p>					

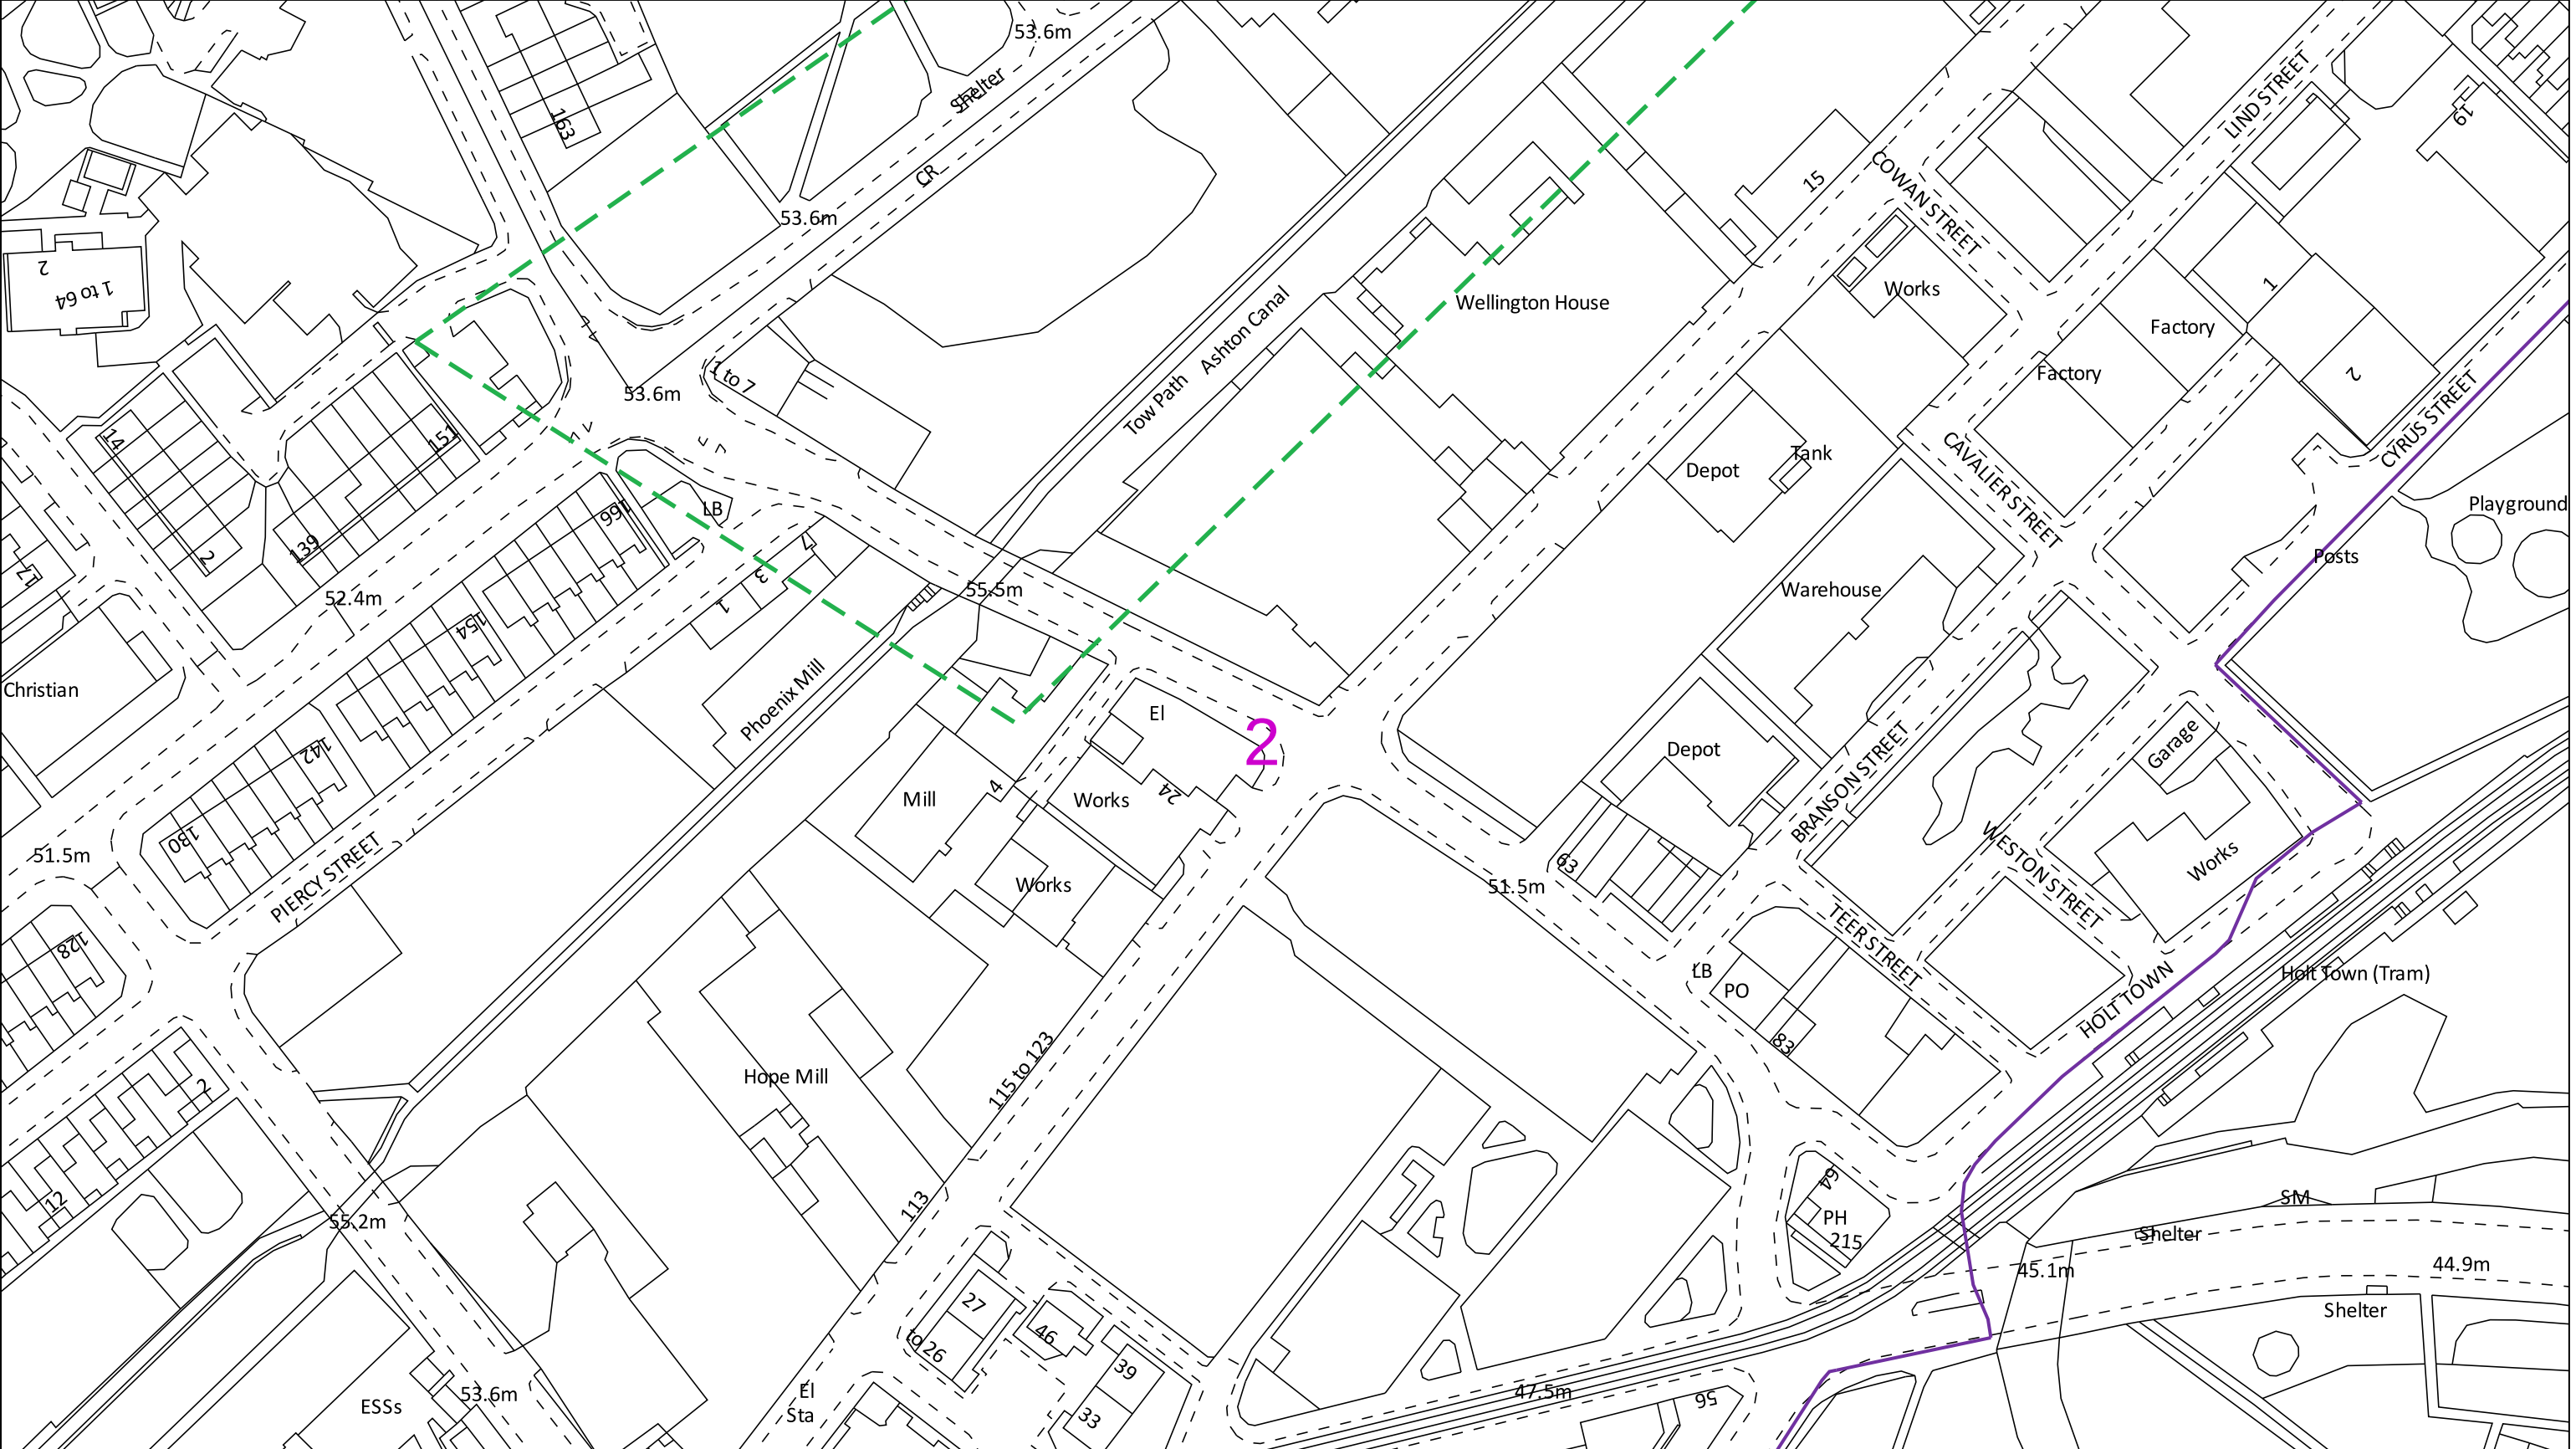

<p>0 100 m</p> <p>Dig Sites Area: Line:</p> <p>The quality and accuracy of any print will depend on your printer, your computer and its print settings. Measurements scaled from this plan may not match measurements between the same points on the ground.</p>		<p>NEOS NETWORKS</p>
<p>Date Requested: 09/08/2023 Job Reference: 30451195 Site Location: 385846 398726</p> <p>Requested by: Mr Duncan Phillips Your Scheme/Reference: Brunswick</p>	<p>The information on this document is proprietary and shall not be used, copied, reproduced or disclosed in whole or in part without written consent of Neos Networks. Approximate location only is shown. To determine exact location a trial hole must be dug with a Neos Networks Supervisor present. Neos Networks accept no liability for errors or omissions.</p>	
<p>Scale: 1:1250 (When plotted at A3)</p>	<p>Neos Network Underground Route</p>	<p>Emergency Number: 0345 305 3337</p>
<p>Some of the material on this plot has been reproduced from an Ordnance Survey map with permission of the Controller of Her Majesty's Stationery Office, © Crown Copyright. Licence No. 0100048661 Warning: PDF designed for colour print only with no page scaling. This Information is given as a guide only and its accuracy cannot be guaranteed Plans generated by DigSAFE Pro™ software provided by LinesearchbeforeUdig.</p>		

Searches - Cornerstone Projects Ltd

From: online.plantenquiries@cityfibre.com
Sent: 09 August 2023 10:30
To: searches@cornerstoneprojects.co.uk
Subject: CityFibre Plant Enquiry, issued on 8/9/23 9:29 AM. Reference e136fba5-a4c7-4839-8ed9-3357b5522378.
Attachments: emap.pdf

You recently requested information pertaining to the above location and in relation to CityFibre Holdings Ltd plant.

Reference e136fba5-a4c7-4839-8ed9-3357b5522378

User: User

Title: Brunswick

Comment:

Please find attached a plan of the area of your interest that may contain plant which may be affected by your proposed works.

The validity of this response is 6 weeks, after such time a new enquiry would need to be made.

Please see the points of contact below if they are required:

Plant Enquiries
Rutherford House
Birchwood Park
Warrington
WA3 6ZH
asset.team@cityfibre.com

Please quote the Reference ID in the subject line in any correspondence.


Please be aware that all information included in this eMap is the property of the sender and subject to copyright. It is illegal to copy or send this information to any third party without the permission of the sender.

[CityFibre]<<https://cityfibre.com/>>

Plant Enquiries

0203 5100 602

Disclaimer: CityFibre Limited is incorporated in England (No. 09759465) and its registered office is 15 Bedford Street, London WC2E 9HE. This email, together with any attachments, is confidential and for use by the addressee(s) only. If you are not the intended recipient, please notify the sender immediately, delete the message from your system and do not copy, use, distribute or disclose the email, its contents or attachments for any purpose. CityFibre Ltd accepts no liability for damage caused to a recipient's system by this email nor for any unauthorised access to or interference with this email.

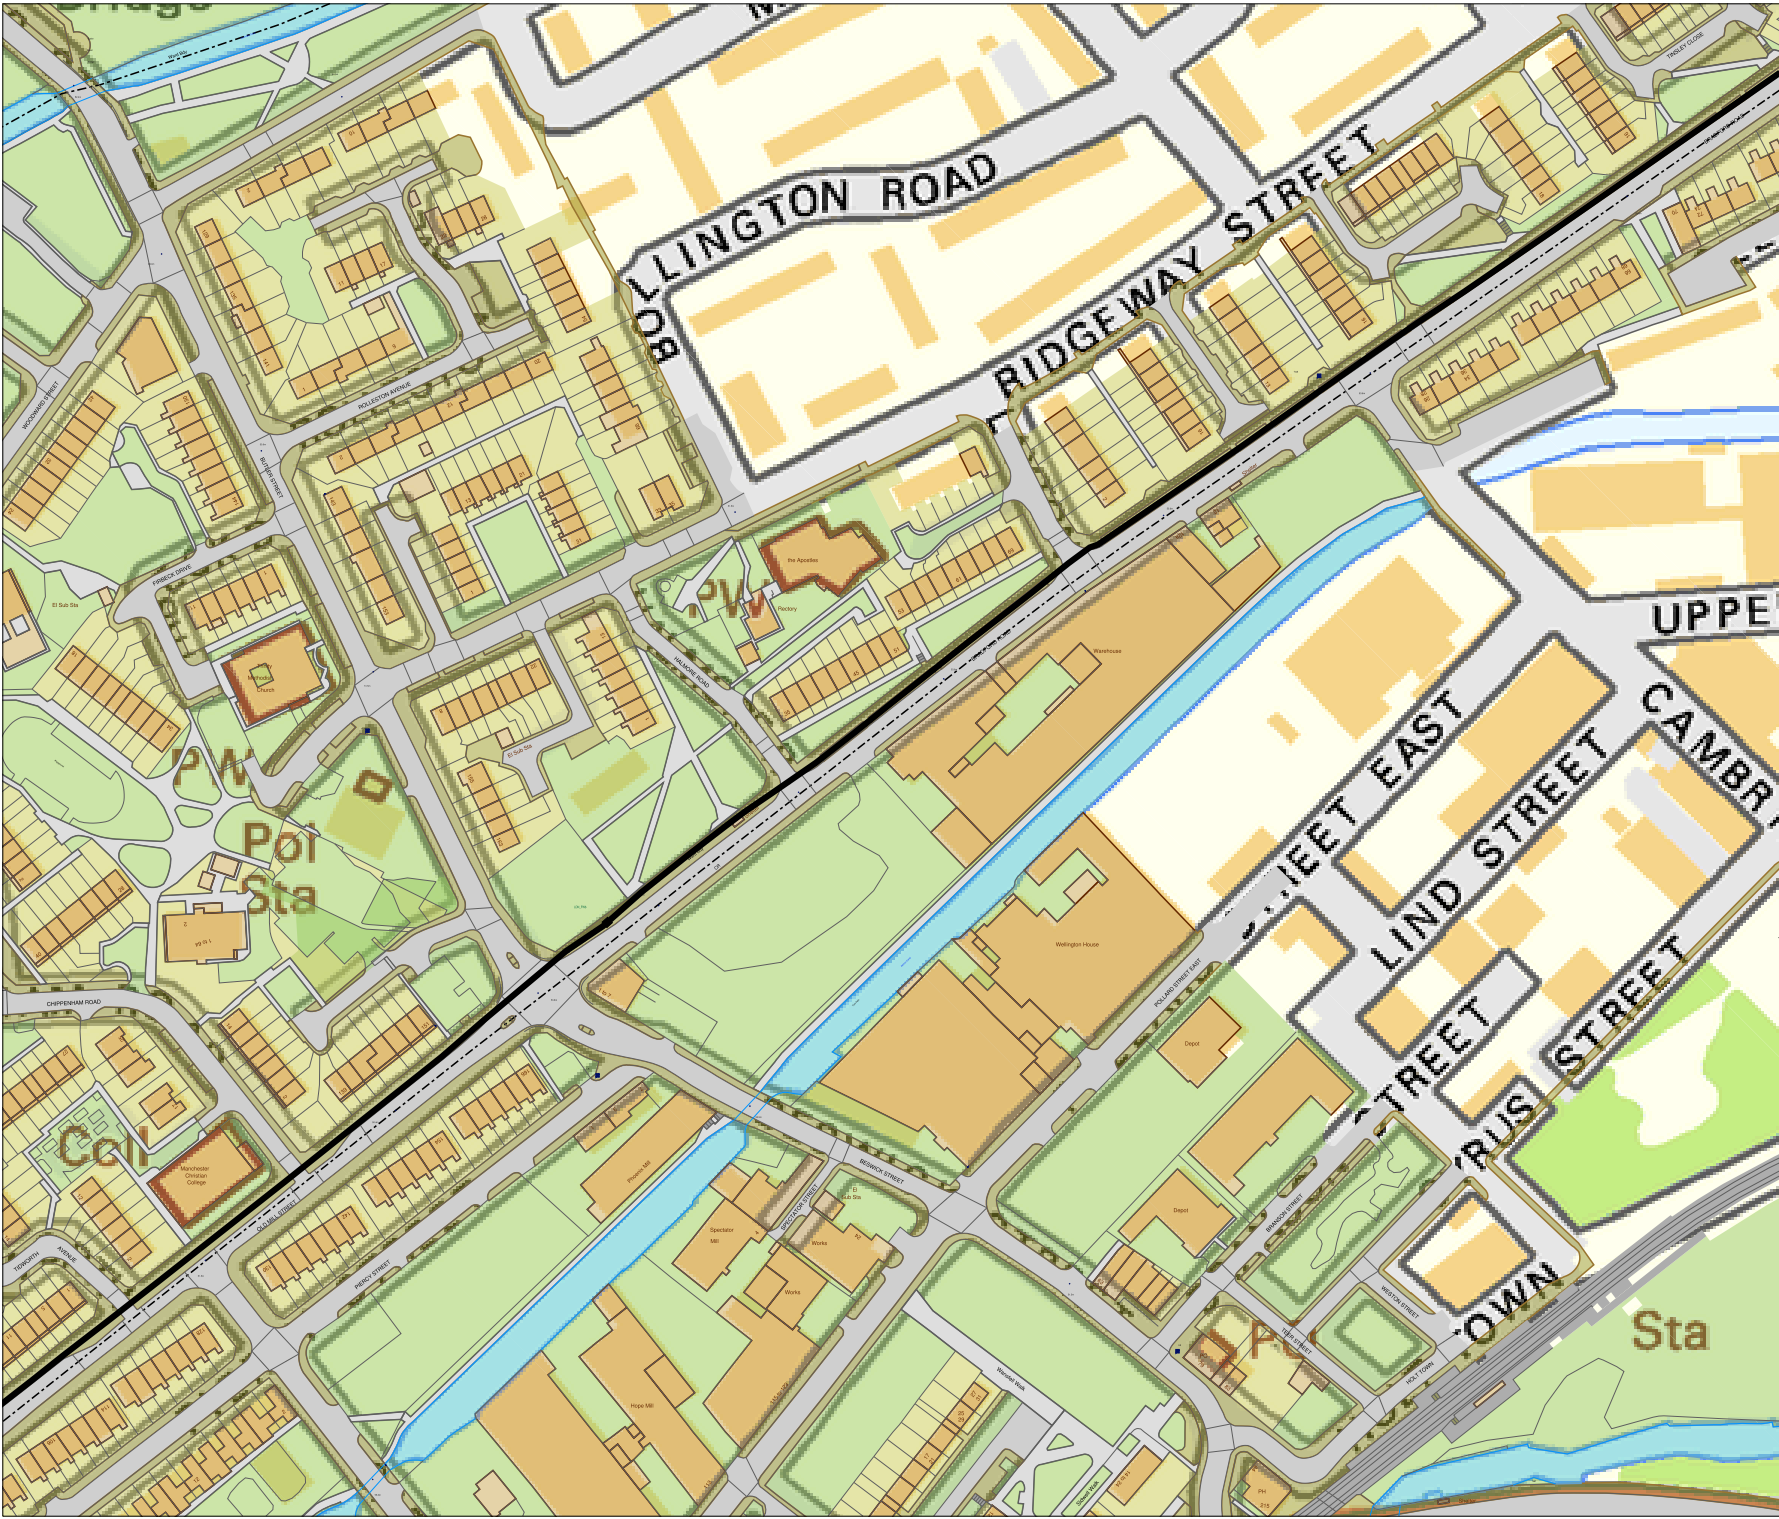

bitmap_layout select_raster

LEGEND

- EXISTING PLANT
- EXISTING PLANT

bitmap_layout select_raster

Head Office
CityFibre Holdings Ltd
15 Bedford Street,
London,
WC2E 9HE
Tel: 0845 293 0774
Web: www.cityfibre.com

Asset Office
CityFibre Holdings Ltd,
Rutherford House,
Birchwood,
Warrington,
WA3 6ZH
Email: asset.team@cityfibre.com

Disclaimer:
Information shown on this plan is for general guidance only.
No warranty is made as to its accuracy.
This plan must not be solely relied upon in the event of
excavation or other works being carried out in the vicinity
of Cityfibre plant.
No liability of any kind is accepted by Cityfibre, its agents or
servants for any error, omission, discrepancy or
deviation. This information is valid for the date printed.

Project
Plant Enquiry

Drawing
Existing Plant

Drawn by:
smallworld
Date: 09/08/2023

Drawing No.
CFH_EP_000001

Revision
001



Searches - Cornerstone Projects Ltd

From: Plantenquiries <Plantenquiries@ocugroup.com>
Sent: 11 August 2023 11:24
To: 'Searches - Cornerstone Projects Ltd'
Subject: E08-23-3098 RE: Plant Enquiries - Site Ref. Brunswick Brunswick Mill - Brunswick Mill, Manchester, M40 7EZ - NGR E385818 N398724

Dear Sir or Madam,

Thank you for your plant enquiry below.

We can confirm that Lumen Technologies (formerly CenturyLink Communications UK Limited, Level 3, Global Crossing (UK) Ltd, Global Crossing PEC, Fibernet UK Ltd and Fibrespan Ltd) do not have any apparatus within the indicated works area.

OCU responds to plant enquiries for all of the above and therefore you only need send one plant enquiry to cover all of these companies.

Please note that this response is only valid for 3 months. If your works do not commence within this time period, please resubmit your plant enquiry for assessment before any works commence.

Regards

Plant Enquiries Dept
OCU
Borehamwood Ind. Park
Rowley Lane
Borehamwood
WD6 5PZ

Office: +44 (0)208 731 4613
Fax: +44 (0)208 731 4601
Email: plantenquiries@ocugroup.com
Web: <http://www.ocugroup.com>



From: Searches - Cornerstone Projects Ltd <searches@cornerstoneprojects.co.uk>
Sent: Wednesday, August 9, 2023 10:17 AM
To: Searches - Cornerstone Projects Ltd <searches@cornerstoneprojects.co.uk>
Subject: Plant Enquiries - Site Ref. Brunswick Brunswick Mill - Brunswick Mill, Manchester, M40 7EZ - NGR E385818 N398724

Searches - Cornerstone Projects Ltd

From: UK OSP-Team . <osp-team@verizon.com>
Sent: 16 August 2023 19:03
To: Searches - Cornerstone Projects Ltd; UK OSP-Team
Subject: Re: Plant Enquiries - Site Ref. Brunswick Brunswick Mill - Brunswick Mill, Manchester, M40 7EZ - NGR E385818 N398724

Dear Sir/Madam

Verizon is a licensed Statutory Undertaker.

We have reviewed your plans and have determined that Verizon (Formally known as MCI WorldCom, MFS) has no apparatus in the areas concerned.

If you have any further queries please do not hesitate to get in touch.

Yours faithfully

Plant Protection Officer (GB) Email osp-team@uk.verizon.com

On Wed, 9 Aug 2023 at 10:24, Searches - Cornerstone Projects Ltd <searches@cornerstoneprojects.co.uk> wrote:
Dear Sir/Madam,

Re: - Underground Apparatus / Plant

Site Ref. Brunswick Brunswick Mill - Brunswick Mill, Manchester, M40 7EZ -
NGR E385818 N398724

Searches - Cornerstone Projects Ltd

From: zayo@safedigs.co.uk
Sent: 09 August 2023 10:20
To: searches@cornerstoneprojects.co.uk
Subject: LSBUD Job No 30451195
Attachments: LSBUD Job No 30451195 - Zayo Plan.pdf; Guide to Excavation within the Vicinity of Zayo Apparatus.pdf



Zayo Group UK Ltd
c/o JSM Group Ltd
Plant Protection Department
Sterling House
Mutton Lane
Potters Bar
Herts, EN6 3AR

Date: 09 Aug 2023

To: Mr Duncan Phillips

ZAYO GROUP LTD UK AFFECTED C2 PRELIMINARY PLANT ENQUIRY

Please DO NOT SEND A REPLY to this email as it has been automatically generated and replies are not monitored.

We acknowledge with thanks your LSBUD request (referenced below) dated 09 Aug 2023 10:17:39 AM for information on the location of our assets.

LSBUD REFERENCE:	30451195
YOUR REFERENCE:	Brunswick

Having examined our records, we can confirm that Zayo Group have apparatus within the specific search area of your enquiry detailed in the reference/location provided.

Please refer to the attached plan(s) showing the approximate position of our apparatus.

WARNING: When working in the vicinity of Zayo Group's assets you have a legal *Duty of Care* that must be observed.

Please note the attached plan(s) indicate approximate location only and their accuracy cannot be guaranteed. To determine the exact location a trial hole must be dug using extreme caution and hand dig methods only.

Please refer to the attached document "Guide to Excavation within the Vicinity of Zayo Apparatus".

If the attached plan(s) contain **no** OS background (ie, only shows red line(s) and nothing else) please email zayoplantenquiries@jsmgroup.com with copies of the plan(s) attached, together with location map **and** coordinates and/or postal code; we will then endeavour to reply to you within 10 working days.

Please forward all C3 and C4 Diversionary Estimate requests for diversionary works under the *New Roads and Street Works Act 1991* "Measures necessary where apparatus is affected by Major Works (Diversionary Works), A Code of Practice", to zayodiversions@jsmgroup.com.

Please do not hesitate to contact us for further assistance.

Yours faithfully,

Zayo Group UK Ltd c/o JSM Group Ltd

JSM Plant Protection Department

T: [01992 655 919](tel:01992655919)

E: zayoplantenquiries@jsmgroup.com

Important Notice

This enquiry response, including any associated documentation, has been assessed and compiled from the information detailed within the LSBUD enquiry outlined above. **Please ensure that the LSBUD enquiry details and this response accurately reflect your proposed works.**

This response is intended for use only by the addressee. If you have received the enquiry response in error, please let us know by telephone and delete all copies; you are advised that copying, distributing, disclosing or otherwise acting in reliance on the response is expressly prohibited. Full terms can be found at www.lsbud.co.uk

Disclaimer: While reasonable measures have been taken to ensure the accuracy of the information contained in this plan response, neither Zayo Group nor PelicanCorp shall have any liability whatsoever in relation to any loss, damage, cost or expense arising from the use of this plan response or the information contained in it or the completeness or accuracy of such information. Use of such information is subject to and constitutes acceptance of these terms. Full terms can be found at www.lsbud.co.uk

If you are unable to launch any of the files for viewing and printing, you may need to download and install free viewing and printing software such as [Adobe Acrobat Reader \(for PDF files\)](#)



Compiled with TicketAccess by PelicanCorp





Zayo Group UK Ltd
4th Floor Harmsworth House
13-15 Bouverie Street
London, EC4Y 8DP

JSM Group Ltd
Sterling House
Mutton Lane, Potters Bar
Hertfordshre, EN6 3AR
T: 01992 655 919
zayoplatenquiries@jsmgroup.com


Legend

-  Zayo Duct
-  Enquiry area

Date requested: 09 Aug 2023
Requested by: Mr Duncan Phillips
Company: Cornerstone Projects
Job reference: 30451195
Your reference: Brunswick

Scale on A3 paper: 1:1250

Warning: PDF designed for colour print only with no page scaling. This Information is given as a guide only and its accuracy cannot be guaranteed.

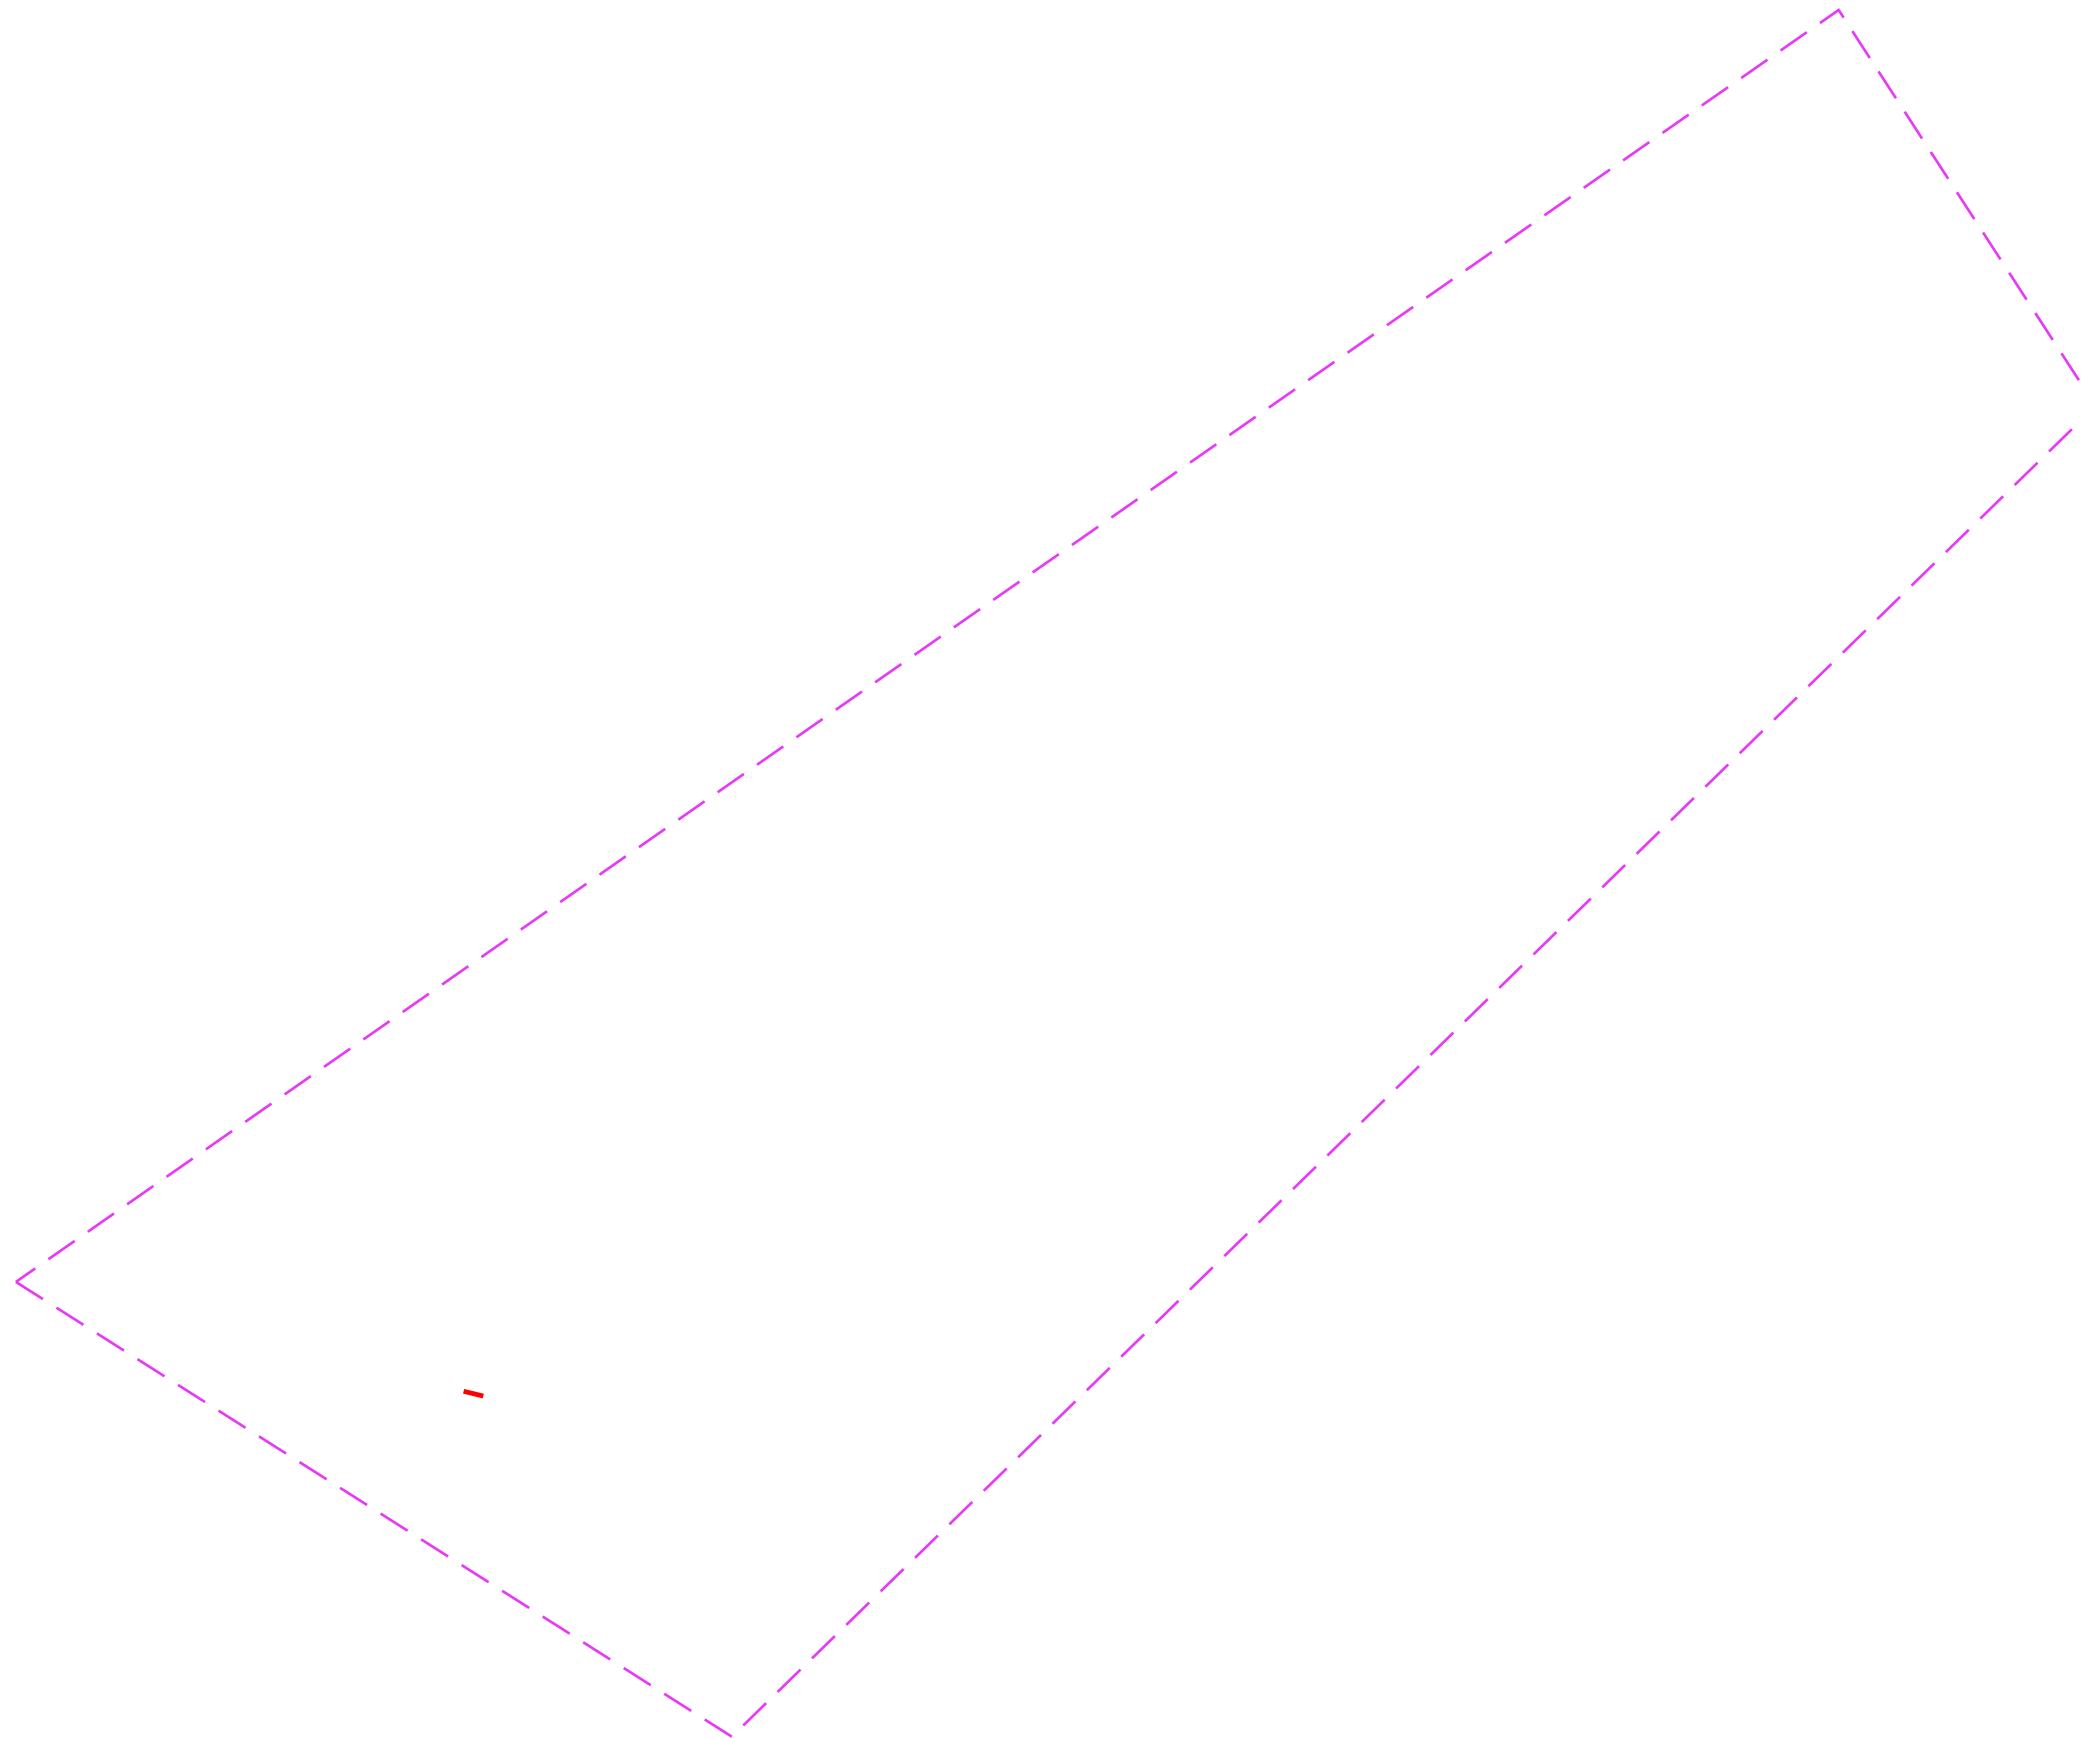

The information on this document is proprietary and shall not be used, copied, reporduced or disclosed in whole or in part without written consent of Zayo Group UK Ltd. Approximate location only is shown. To determine exact location a trial hole must be dug with a Zayo Group UK Ltd Supervisor present. Zayo Group UK Ltd accept no liability for any errors or omissions.



Protecting Lives, Cables & Pipes

**In Emergency Only and if Zayo Plant or Cables
damaged call: 0800 169 1646**

CROWN COPYRIGHT © All Rights Reserved. Ordnance Survey Licence number: 100040487


Tile No: 1

Searches - Cornerstone Projects Ltd

From: ZayoPlantEnquiries <ZayoPlantEnquiries@jsmgroup.com>
Sent: 09 August 2023 14:15
To: 'Searches - Cornerstone Projects Ltd'
Cc: Nicola Harris
Subject: RE: BG MAPPING MISSING LSBUD Job No 30451195

Good Afternoon

Please see below.

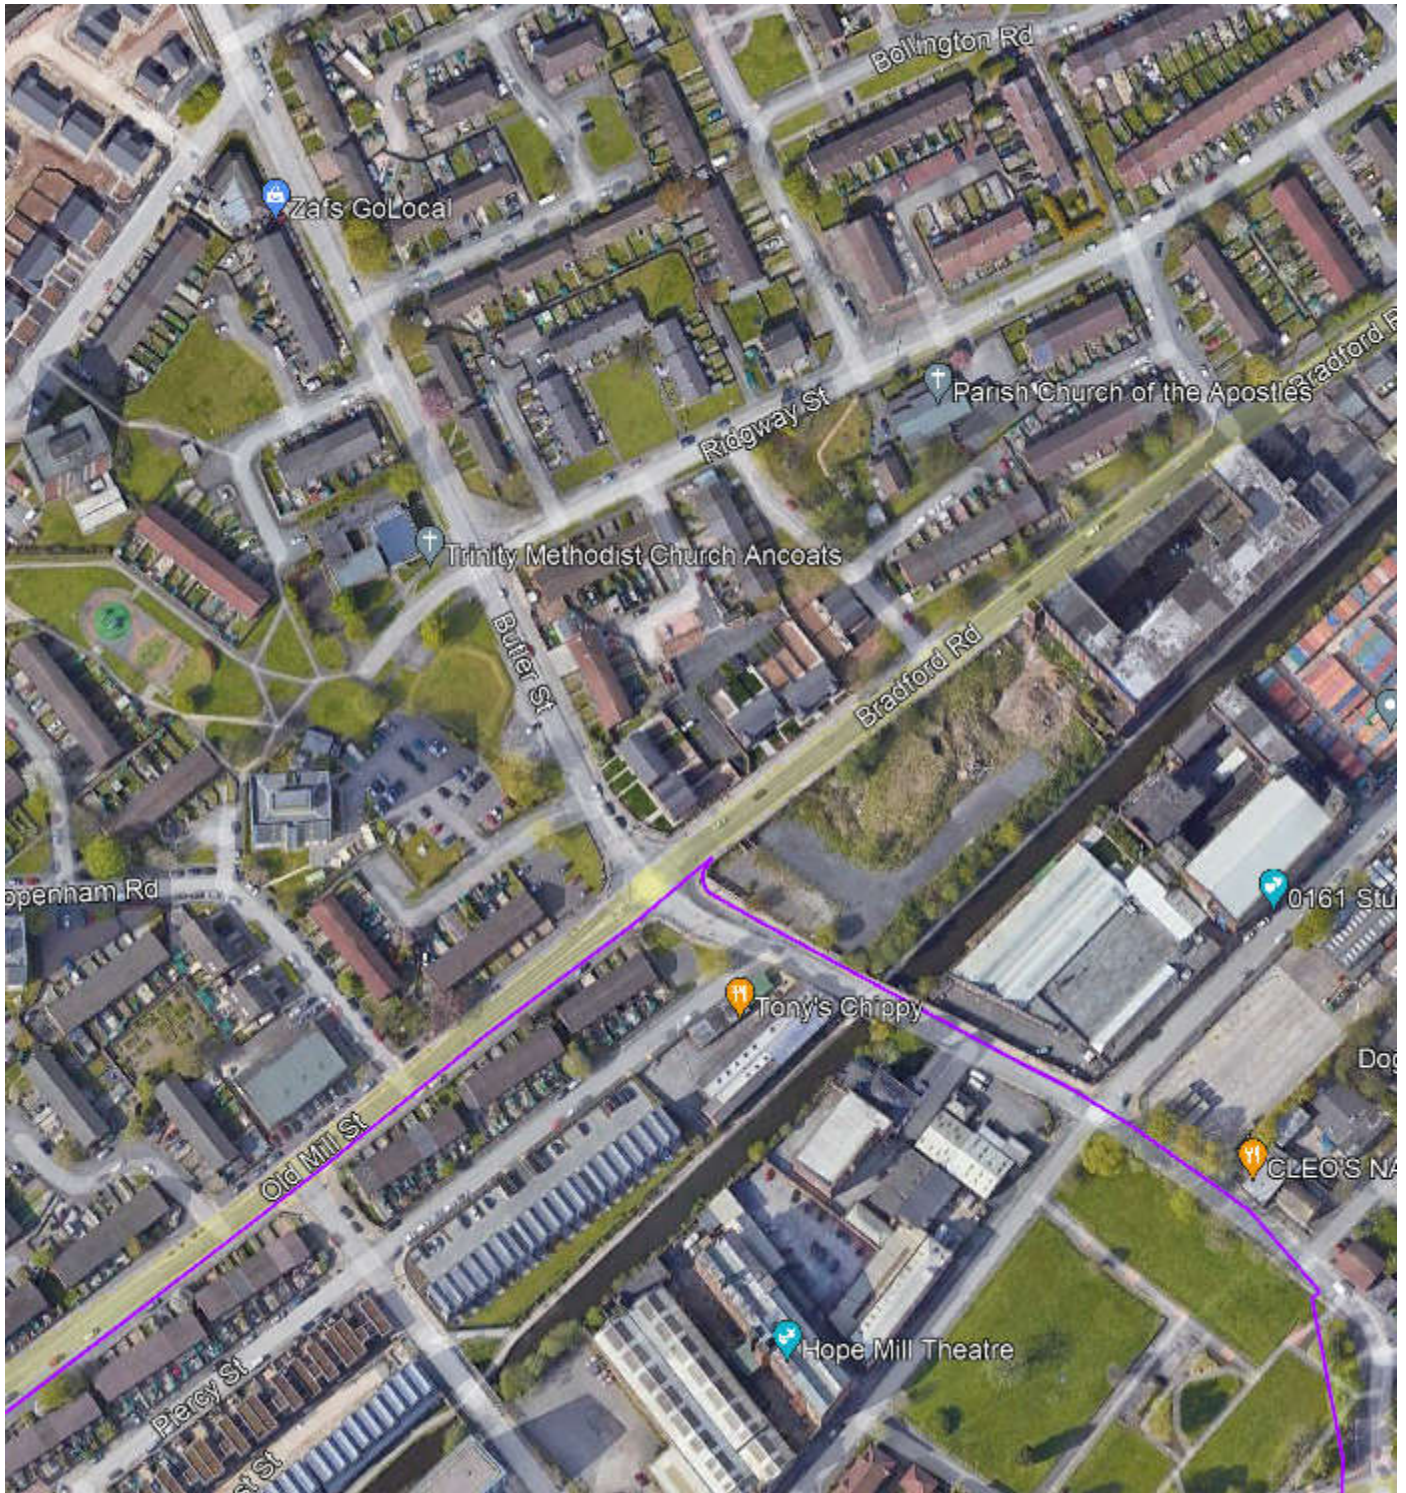

GUIDE TO CONTRACTORS UNDERTAKING EXCAVATIONS IN THE VICINITY OF ZAYO PLANT

1. Prior to commencing any work or moving heavy plant or equipment over any portion of the site, the Contractor shall confirm details of the location of the Zayo apparatus by contacting and requesting utility drawings from LinesearchbeforeUdig

All Enquirers should register free of charge for the Zayo plant enquiry service at LinesearchbeforeUdig <http://www.linesearchbeforeudig.co.uk/>

Or follow the direct link to register at <http://onecall.linesearchbeforeudig.co.uk/RegisterNewUser> and start your search there.

If you have any queries or wish to speak to a member of the JSM Plant Protection Team please call 01992 655 919.

The accuracy of information on the plans cannot be guaranteed and no liability can be accepted for errors or omissions.

2. Where the utility drawings show that the works or the movement of plant or equipment may endanger the Zayo Apparatus the Contractor must mark out the location of the Zayo Apparatus and ensure the apparatus is adequately protected from damage.
3. The contractor should note that damage to Zayo's Fibre-optic network is extremely disruptive and costly to reinstate. The Contractor shall make every effort to avoid the disturbance of Zayo's apparatus for the completion of the work.
4. When excavating, moving or backfilling around Zayo's apparatus The Contractor should note that the normal depth of cover for Zayo ducts are as follows:
 - Carriageway 600mm
 - Footway 350mm
 - Verge 350mm
5. With regard to excavation in the vicinity of Zayo's apparatus the Contractor should be aware of the possibility of reduced cover and the possibility of encountering Zayo apparatus at depths of cover less than that given above.
6. All excavation adjacent to Zayo apparatus is to be carried out by hand until the exact extent and/or location of the Zayo apparatus is known. Use spades and shovels in preference to other tools.

7. Do NOT use Mechanical borers and/or excavators within 0.5m of Zayo Apparatus.
8. To prevent any movement of Zayo apparatus during excavations, complete shuttering shall be used if:
 - The excavation is deeper than the depth of cover of the adjacent Zayo apparatus.
 - The excavation is within 1.0m of Zayo apparatus in stable ground.
 - The excavation is within 5.0m of Zayo apparatus in unstable ground.
9. If for the completion of the works the Contractor intends using any of the following:
 - Pile driving equipment within 10.0m of Company Apparatus.
 - Explosives within 20.0m of Company Apparatus.

Then the Contractor shall advise the Zayo Plant Protection Centre giving a minimum 10 working days written notice.

10. All Zayo manhole, joint box and /or other access points and chambers within the site shall be kept clear and unobstructed at all times to allow access by Zayo and /or their Contractor to carryout maintenance on the network. The Contractor should particularly note that footway type jointing chambers are not specified for carriageway loadings and will need to be adequately protected and/or demolished and rebuilt by Zayo where such chambers are likely to be placed at risk, either temporarily or permanently, from the movement of plant and/or equipment on the site.
11. The covers to Zayo chambers and/or apparatus shall only be lifted by means of appropriate manhole keys under the direct supervision of a Zayo Representative. No employee of the Contractor or of any sub-contractor employed by the Contractor shall enter any Zayo chamber and/or apparatus unless under the supervision of a Zayo Representative.
12. In the event of any damage whatsoever to Zayo apparatus, the Contractor shall immediately report the incidence to Zayo by contacting Zayo as follows:

Telephone: 0800 169 1646 (Zayo 24Hr Network Operations Centre)

Damage to Communications Plant is Expensive – Please Take Care

Please note these basic safety details are explained in detail in the HSE booklet HS(G)47 – Avoiding Danger from Underground Services.



LAYER SURVEYS LTD

SEE THE COMPLETE PICTURE

Independent Utilities

t 01772 611634
m 07341 953636
e darren@layersurveys.co.uk
w www.layersurveys.co.uk

Head Office:
Francis House,
Meadowcroft Business Park,
Pope Lane, Preston, PR4 4BA



Searches - Cornerstone Projects Ltd

From: plantenquiryservice@gtc-uk.co.uk
Sent: 09 August 2023 10:51
To: searches@cornerstoneprojects.co.uk
Subject: GTC Plant Enquiry - Ref- 3607544
Attachments: 3607544.png

GTC Apparatus Not Found In Search Area

Our Plant Enquiry Service Ref: 3607544

Your Enquiry Ref: Brunswick

Dear Duncan,

Thank you for your enquiry concerning apparatus in the vicinity of your proposed work. GTC can confirm that we have no apparatus in the vicinity but please note that other asset owners may have and ensure all utility owners have been consulted. For your records, the search area is shown in the attached map.

Please note our assets now include those owned and operated by:

- GTC Pipelines Limited
- Independent Pipelines Limited
- Quadrant Pipelines Limited
- Electricity Network Company Limited
- Independent Power Networks Limited
- Independent Water Networks Limited
- Open Fibre Networks Limited
- Independent Community Heating Limited

If you have any queries or require any further information please do not hesitate to contact us.

Your sincerely,

GTC Plant Enquiry Service.

GTC
Synergy House
Woolpit Business Park
Woolpit
Bury St Edmunds
Suffolk, IP30 9UP
Tel: 01359 240363
plant.enquiries@gtc-uk.co.uk

NOTE:

This E-Mail originates from GTC, Synergy House, Woolpit Business Park, Woolpit, Bury St Edmunds, Suffolk, IP30 9UP

VAT Number: GB688 8971 40. Registered No: 029431.

DISCLAIMER

The information in this E-Mail and in any attachments is confidential and may be privileged. If you are not the intended recipient, please destroy this message, delete any copies held on your system and notify the sender immediately. You

should not retain, copy or use this E-Mail for any purpose, nor disclose all or any part of its content to any other person. Whilst we run antivirus software on Internet E-Mails, we are not liable for any loss or damage. The recipient is advised to run their own up to date antivirus software.

Thank you

Searches - Cornerstone Projects Ltd

From: LastMile@safedigs.co.uk
Sent: 09 August 2023 10:19
To: searches@cornerstoneprojects.co.uk
Subject: Plant Enquiry Ref Job No. 30451195
Attachments: 30451195_LastMile.pdf

09/08/2023

LinesearchbeforeUdig ref: 30451195

Your ref: Brunswick

Dear Sir/Madam,

Thank you for contacting us regarding equipment and apparatus at the above site. Based on the information provided, I can confirm that Last Mile does not have any plant within the area(s) specified in your request.

No liability of any kind whatsoever is accepted by Last Mile, its agents, servants or contractors for any error, omission, or misstatement.

Safe digging practices, in accordance with HS(G)47, Avoiding Danger from underground services must be used to verify and establish the actual position of mains, pipes, cables, services and any other apparatus on site before any mechanical plant is used. Safe working procedures should be defined and practiced.

If you require advice in connection with your proposals, please contact the relevant number below.

Yours sincerely,

Last Mile Asset Management Limited

Gas Emergency Number:

In an emergency call 0800 111 999, 24 hours a day.

Electricity Emergency Number:

In an emergency call 105, 24 hours a day

Mapping Enquiries:

If you have an enquiry relating to this letter or the attached map plan, please contact us using the following information:

Email plantenquiries@lastmile-uk.com

LinesearchbeforeUdig:


If you have an enquiry relating to the use of the LinesearchbeforeUdig website, please contact

LinesearchbeforeUdig using the following information:

Telephone: 0845 437 7365

Email: enquiries@linesearchbeforeudig.co.uk

Website: www.linesearchbeforeudig.co.uk

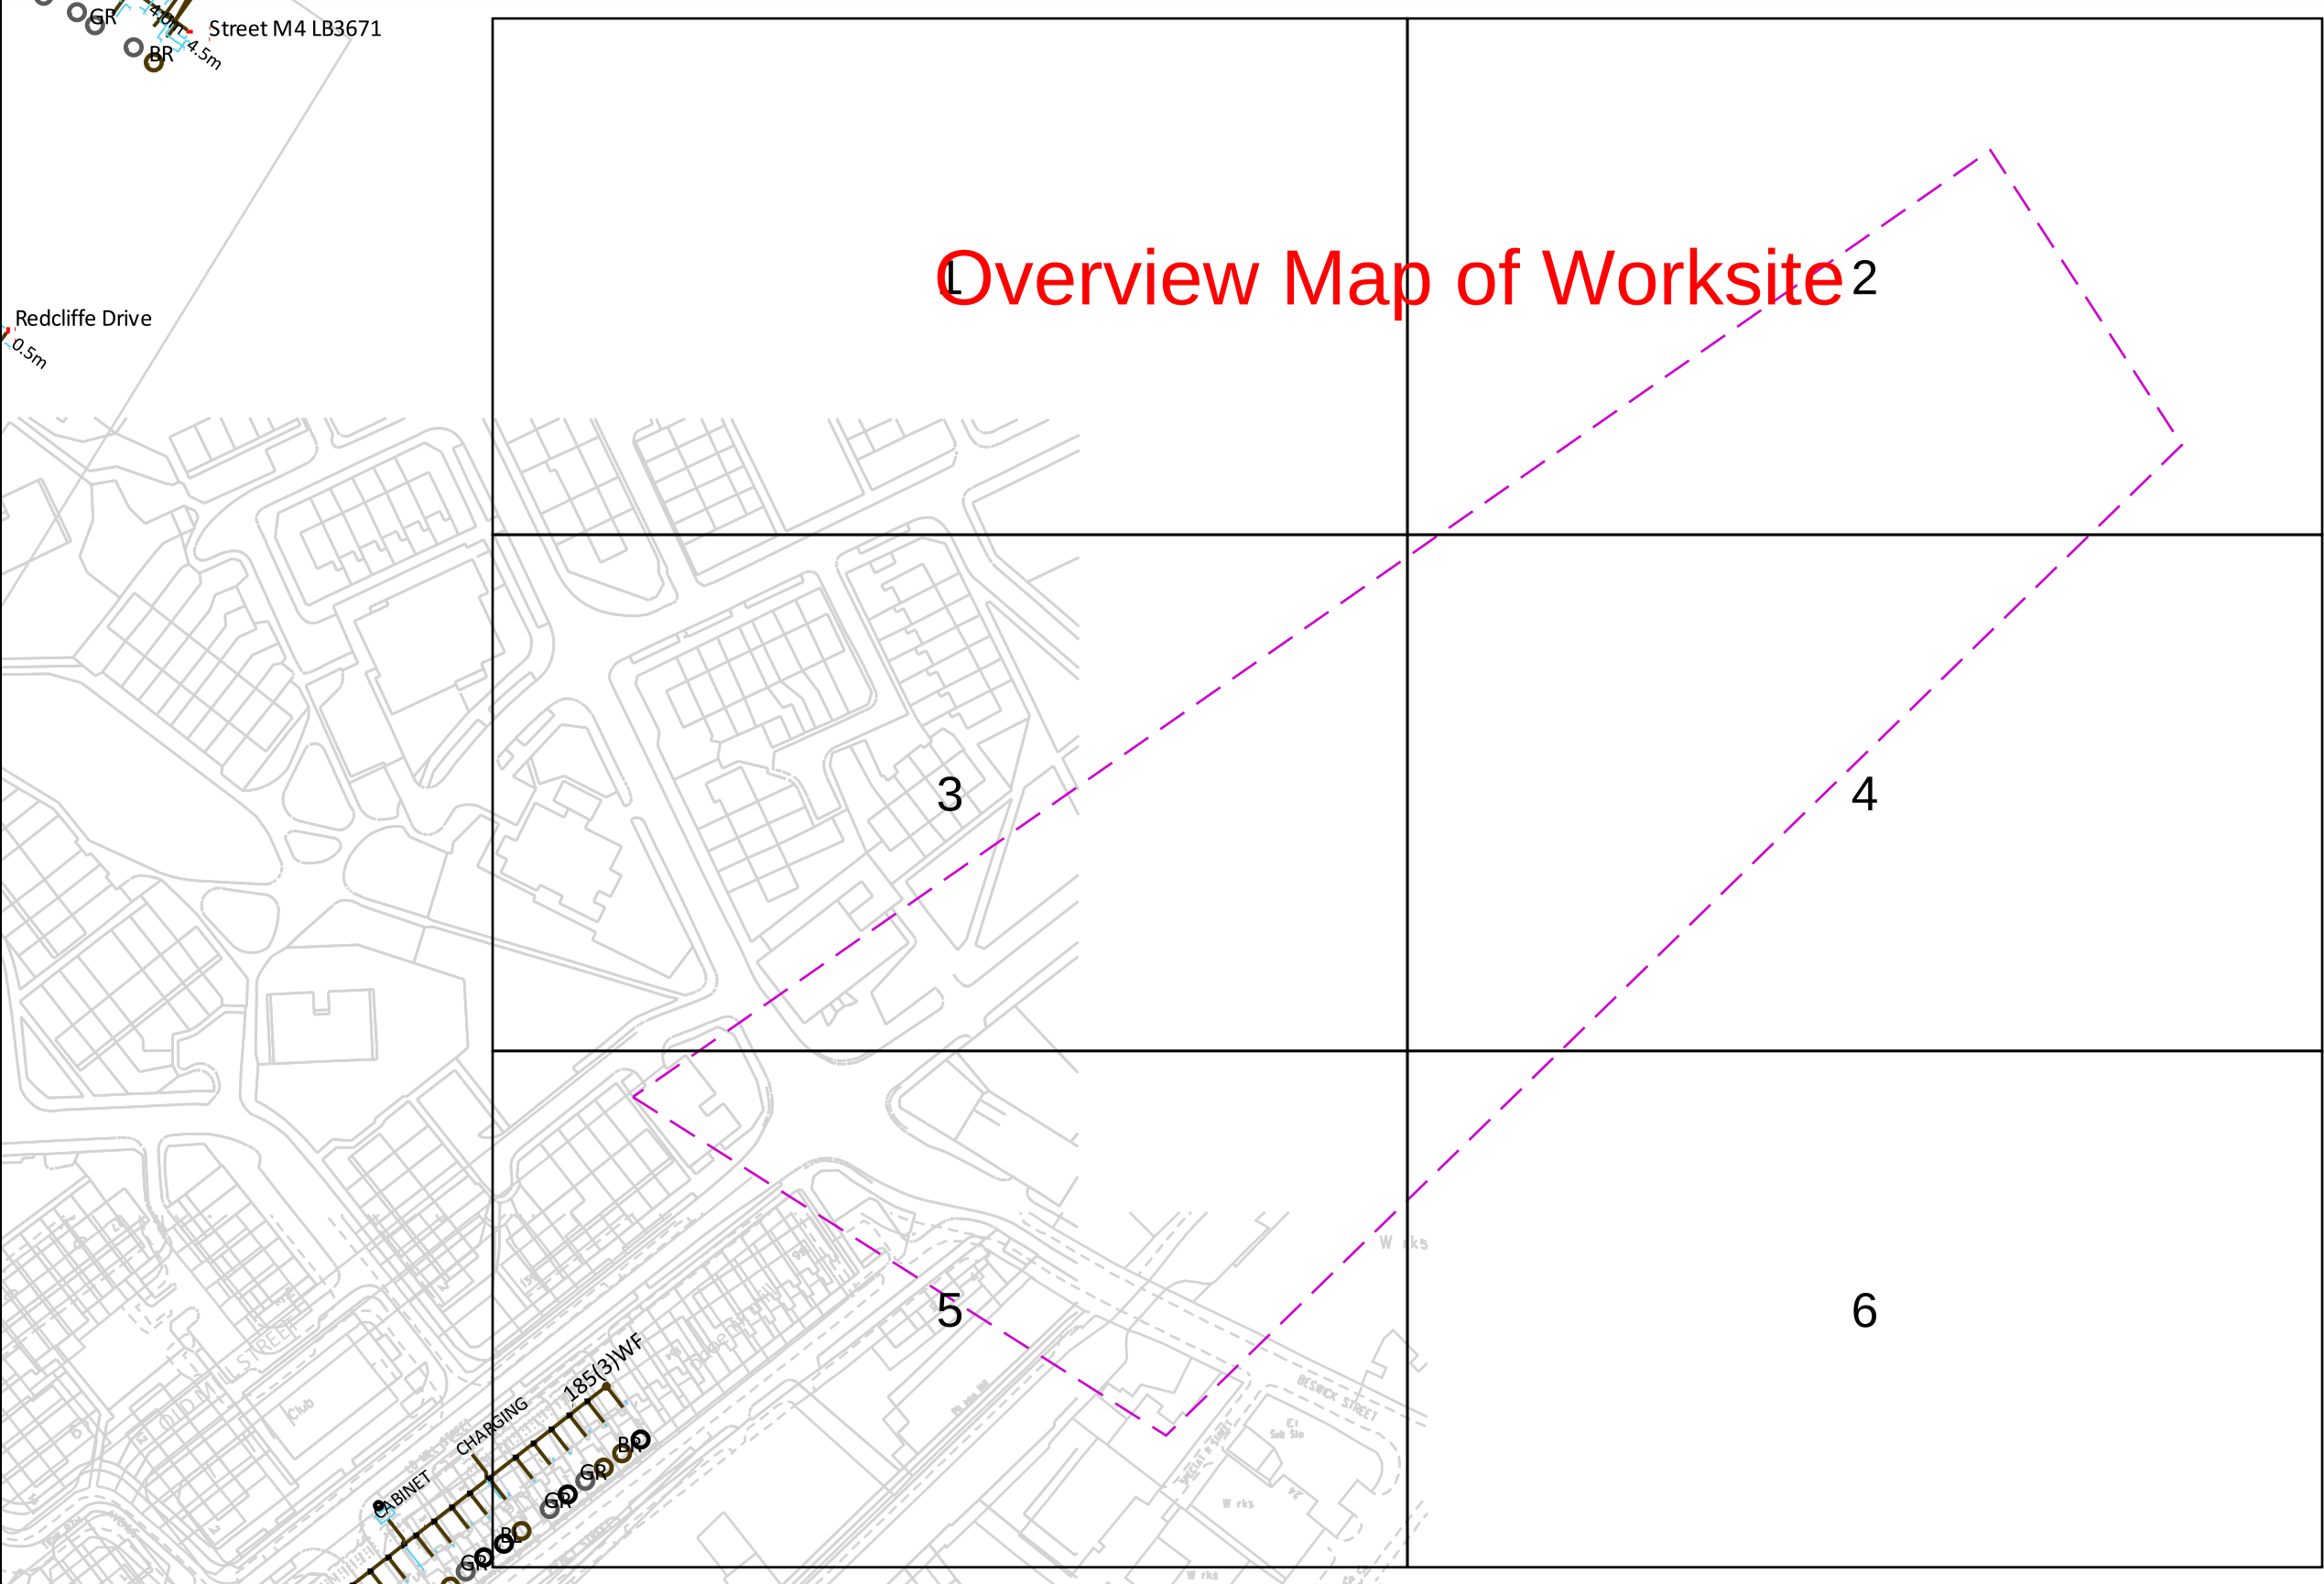

In an emergency call 105, 24 hours a day

Date Requested: 09/08/2023
Job Reference: 30451195
Site Location: 385659 398578
Requested by:
Mr Duncan Phillips

Your Scheme/Reference: Brunswick

Scale: 1:1537 (When plotted at A3)

IMPORTANT INFO

This plan shows cables owned by Last Mile Electricity Limited in their role as a Licensed Distributor (IDNO). Cables owned by other Distributors or privately owned cables (or, indeed, any other apparatus, equipment or infrastructure may also be present in the area. Information regarding such cables (or any such other apparatus, equipment, or infrastructure) should be obtained from the relevant owners.

The information shown on these plans is provided for general information purposes only and should not be relied on or treated as a substitute for your own enquiries. We make no warranty, representation, or guarantee, whether express or implied, regarding the content of the plans or that the content is accurate, complete, or up to date. No liability of any kind whatsoever is accepted by Last Mile Asset Management Limited, or their agents, servants or contractors for any error, omission, or misstatement.

Safe digging practices, in accordance with HS(G)47, must be used to verify and establish the actual position of all electrical cables and apparatus on site before any mechanical plant is used. It is your responsibility to ensure that this information is provided to all persons on or near electrical cables or apparatus. The information included on this plan should not be referred to beyond a period of 3 month from the date of issue.

ELECTRIC KEY

PROPOSED LV SERVICE	LV STRAIGHT JOINT
PROPOSED LV	LV BREACH JOINT
PROPOSED HV	HV STRAIGHT JOINT
PROPOSED EHV (UG)	HV BREACH JOINT
EXISTING/AS LAID LV SERVICE	STREET LIGHTING C.P
EXISTING/AS LAID LV (UG)	MINI PILLAR
EXISTING/AS LAID HV (UG)	LINK BOX
EXISTING/AS LAID EHV (UG)	EARTH SPIKE
EXISTING LV OVERHEAD	POT END
EXISTING HV OVERHEAD	SERVICE JOINT
EXISTING EHV OVERHEAD	
PROPOSING DISCONNECTED	

Dig Sites

Area:

Line:

Last Mile Asset Management Limited
Fenick House, Lister Way
Hamilton International Technology Park
Glasgow G72 0FT
Telephone 03300 587 443



**In an emergency call 105,
24 hours a day**

Date Requested: 09/08/2023
Job Reference: 30451195
Site Location: 385659 398578
Requested by:
Mr Duncan Phillips

Your Scheme/Reference: Brunswick

Scale: 1:500 (When plotted at A3)

IMPORTANT INFO

This plan shows cables owned by Last Mile Electricity Limited in their role as a Licensed Distributor (IDNO). Cables owned by other Distributors or privately owned cables (or, indeed, any other apparatus, equipment or infrastructure may also be present in the area. Information regarding such cables (or any such other apparatus, equipment, or infrastructure) should be obtained from the relevant owners.

The information shown on these plans is provided for general information purposes only and should not be relied on or treated as a substitute for your own enquiries. We make no warranty, representation, or guarantee, whether express or implied, regarding the content of the plans or that the content is accurate, complete, or up to date. No liability of any kind whatsoever is accepted by Last Mile Asset Management Limited, or their agents, servants or contractors for any error, omission, or misstatement.

Safe digging practices, in accordance with HS(G)47, must be used to verify and establish the actual position of all electrical cables and apparatus on site before any mechanical plant is used. It is your responsibility to ensure that this information is provided to all persons on or near electrical cables or apparatus. The information included on this plan should not be referred to beyond a period of 3 month from the date of issue.

ELECTRIC KEY

PROPOSED LV SERVICE	-----	LV STRAIGHT JOINT
PROPOSED LV	-----	LV BREACH JOINT
PROPOSED HV	-----	HV STRAIGHT JOINT
PROPOSED EHV (UG)	-----	HV BREACH JOINT
EXISTING/AS LAID LV SERVICE	-----	STREET LIGHTING C.P
EXISTING/AS LAID LV (UG)	-----	MINI PILLAR
EXISTING/AS LAID HV (UG)	-----	LINK BOX
EXISTING/AS LAID EHV (UG)	-----	EARTH SPIKE
EXISTING LV OVERHEAD	-----	POT END
EXISTING HV OVERHEAD	-----	SERVICE JOINT
EXISTING EHV OVERHEAD	-----	
PROPOSING DISCONNECTED	-----	

Dig Sites


Area:

Line:

Last Mile Asset Management Limited
Fenick House, Lister Way
Hamilton International Technology Park
Glasgow G72 0FT
Telephone 03300 587 443

Crown Copyright © - Reproduced by permission of Ordnance Survey on behalf of HMSO. And database right 2023. All rights reserved. Ordnance Survey Licence number 100061801

(Page 1)

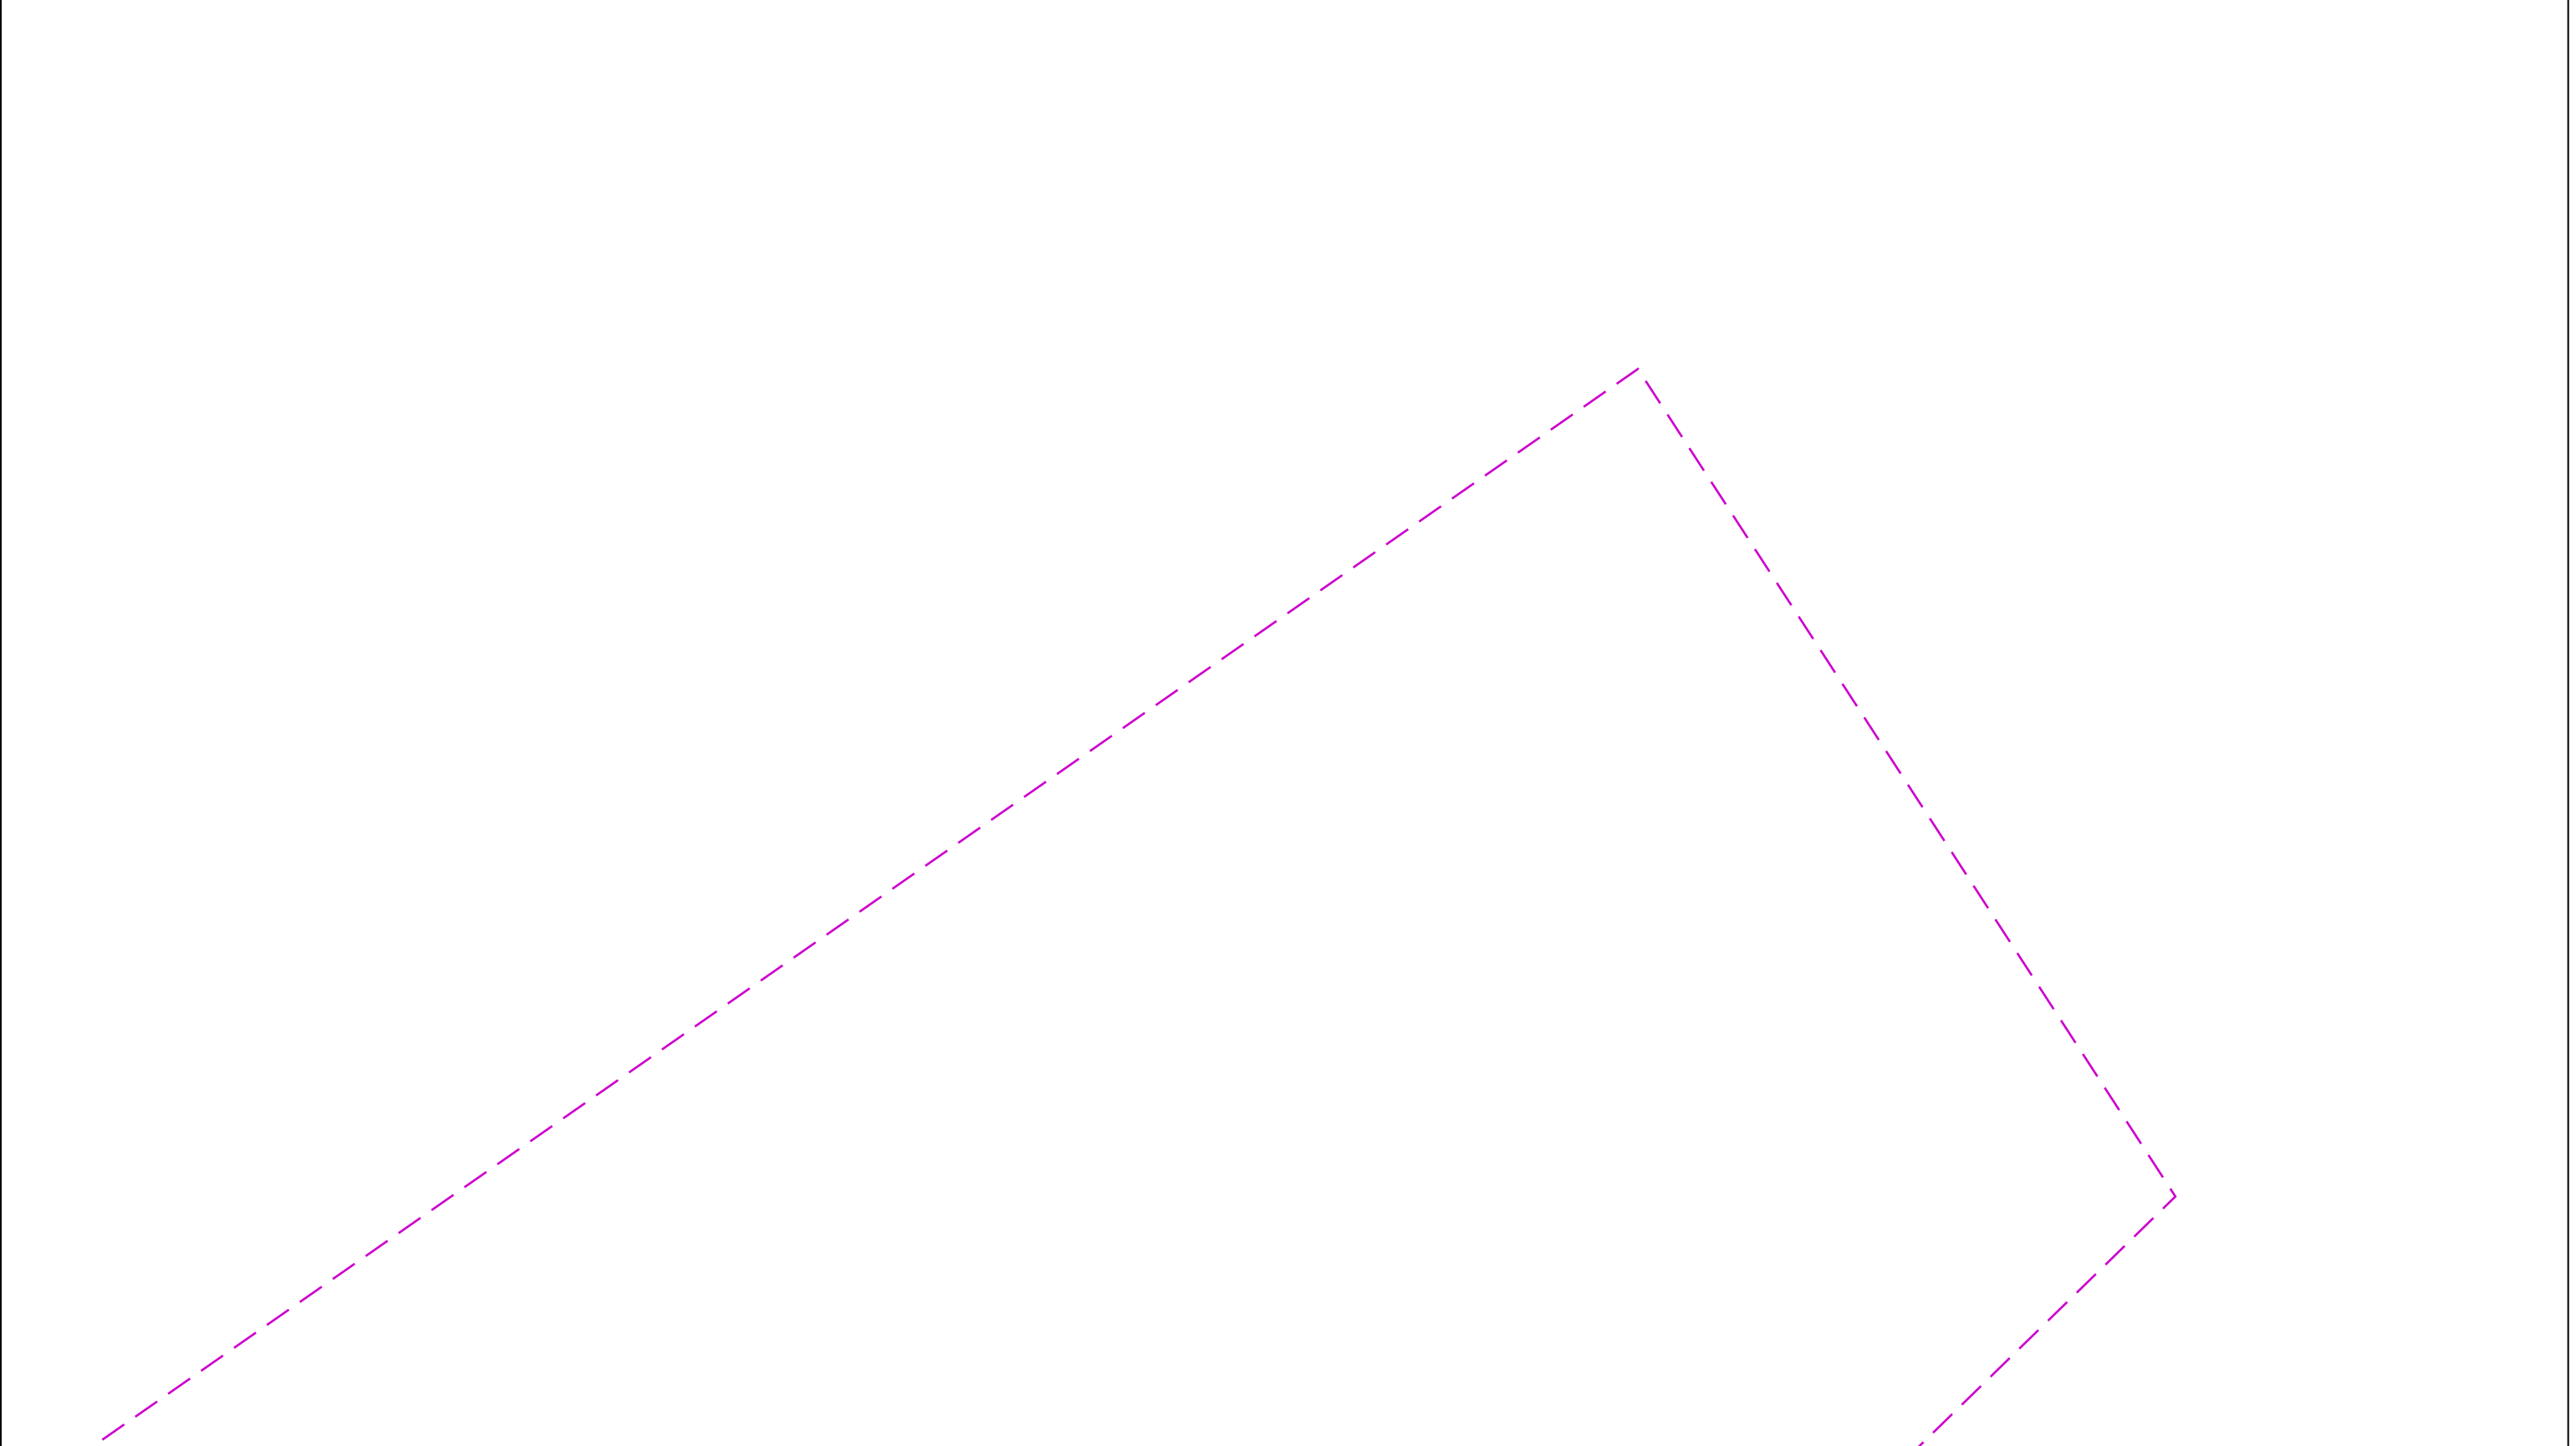

**In an emergency call 105,
24 hours a day**

Date Requested: 09/08/2023
Job Reference: 30451195
Site Location: 385659 398578
Requested by:
Mr Duncan Phillips
Your Scheme/Reference: Brunswick

Scale: 1:500 (When plotted at A3)

IMPORTANT INFO

This plan shows cables owned by Last Mile Electricity Limited in their role as a Licensed Distributor (IDNO). Cables owned by other Distributors or privately owned cables (or, indeed, any other apparatus, equipment or infrastructure may also be present in the area. Information regarding such cables (or any such other apparatus, equipment, or infrastructure) should be obtained from the relevant owners.

The information shown on these plans is provided for general information purposes only and should not be relied on or treated as a substitute for your own enquiries. We make no warranty, representation, or guarantee, whether express or implied, regarding the content of the plans or that the content is accurate, complete, or up to date. No liability of any kind whatsoever is accepted by Last Mile Asset Management Limited, or their agents, servants or contractors for any error, omission, or misstatement.

Safe digging practices, in accordance with HS(G)47, must be used to verify and establish the actual position of all electrical cables and apparatus on site before any mechanical plant is used. It is your responsibility to ensure that this information is provided to all persons on or near electrical cables or apparatus. The information included on this plan should not be referred to beyond a period of 3 month from the date of issue.

ELECTRIC KEY

PROPOSED LV SERVICE	-----	LV STRAIGHT JOINT
PROPOSED LV	- - - - -	LV BREACH JOINT
PROPOSED HV	- . - . -	HV STRAIGHT JOINT
PROPOSED EHV (UG)	- . - . -	HV BREACH JOINT
EXISTING/AS LAID LV SERVICE	-----	STREET LIGHTING C.P
EXISTING/AS LAID LV (UG)	- - - - -	MINI PILLAR
EXISTING/AS LAID HV (UG)	-----	LINK BOX
EXISTING/AS LAID EHV (UG)	-----	EARTH SPIKE
EXISTING LV OVERHEAD	— x —	POT END
EXISTING HV OVERHEAD	— x x —	SERVICE JOINT
EXISTING EHV OVERHEAD	— x x —	
PROPOSING DISCONNECTED	— x x —	

Dig Sites

Area: - - - - -

Line: - - - - -

100m

Last Mile Asset Management Limited
Fenick House, Lister Way
Hamilton International Technology Park
Glasgow G72 0FT
Telephone 03300 587 443

Crown Copyright © - Reproduced by permission of Ordnance Survey on behalf of HMSO. And database right 2023. All rights reserved. Ordnance Survey Licence number 100061801

(Page 2)



**In an emergency call 105,
24 hours a day**

Date Requested: 09/08/2023
Job Reference: 30451195
Site Location: 385659 398578
Requested by:
Mr Duncan Phillips

Your Scheme/Reference: Brunswick

Scale: 1:500 (When plotted at A3)

IMPORTANT INFO

This plan shows cables owned by Last Mile Electricity Limited in their role as a Licensed Distributor (IDNO). Cables owned by other Distributors or privately owned cables (or, indeed, any other apparatus, equipment or infrastructure may also be present in the area. Information regarding such cables (or any such other apparatus, equipment, or infrastructure) should be obtained from the relevant owners.

The information shown on these plans is provided for general information purposes only and should not be relied on or treated as a substitute for your own enquiries. We make no warranty, representation, or guarantee, whether express or implied, regarding the content of the plans or that the content is accurate, complete, or up to date. No liability of any kind whatsoever is accepted by Last Mile Asset Management Limited, or their agents, servants or contractors for any error, omission, or misstatement.

Safe digging practices, in accordance with HS(G)47, must be used to verify and establish the actual position of all electrical cables and apparatus on site before any mechanical plant is used. It is your responsibility to ensure that this information is provided to all persons on or near electrical cables or apparatus. The information included on this plan should not be referred to beyond a period of 3 month from the date of issue.

ELECTRIC KEY

PROPOSED LV SERVICE	-----	LV STRAIGHT JOINT
PROPOSED LV	-----	LV BREACH JOINT
PROPOSED HV	-----	HV STRAIGHT JOINT
PROPOSED EHV (UG)	-----	HV BREACH JOINT
EXISTING/AS LAID LV SERVICE	-----	STREET LIGHTING C.P
EXISTING/AS LAID LV (UG)	-----	MINI PILLAR
EXISTING/AS LAID HV (UG)	-----	LINK BOX
EXISTING/AS LAID EHV (UG)	-----	EARTH SPIKE
EXISTING LV OVERHEAD	-----	POT END
EXISTING HV OVERHEAD	-----	SERVICE JOINT
EXISTING EHV OVERHEAD	-----	
PROPOSING DISCONNECTED	-----	

Dig Sites


Area: -----

Line: -----

Last Mile Asset Management Limited
Fenick House, Lister Way
Hamilton International Technology Park
Glasgow G72 0FT
Telephone 03300 587 443

Crown Copyright © - Reproduced by permission of Ordnance Survey on behalf of HMSO. And database right 2023. All rights reserved. Ordnance Survey Licence number 100061801

(Page 3)

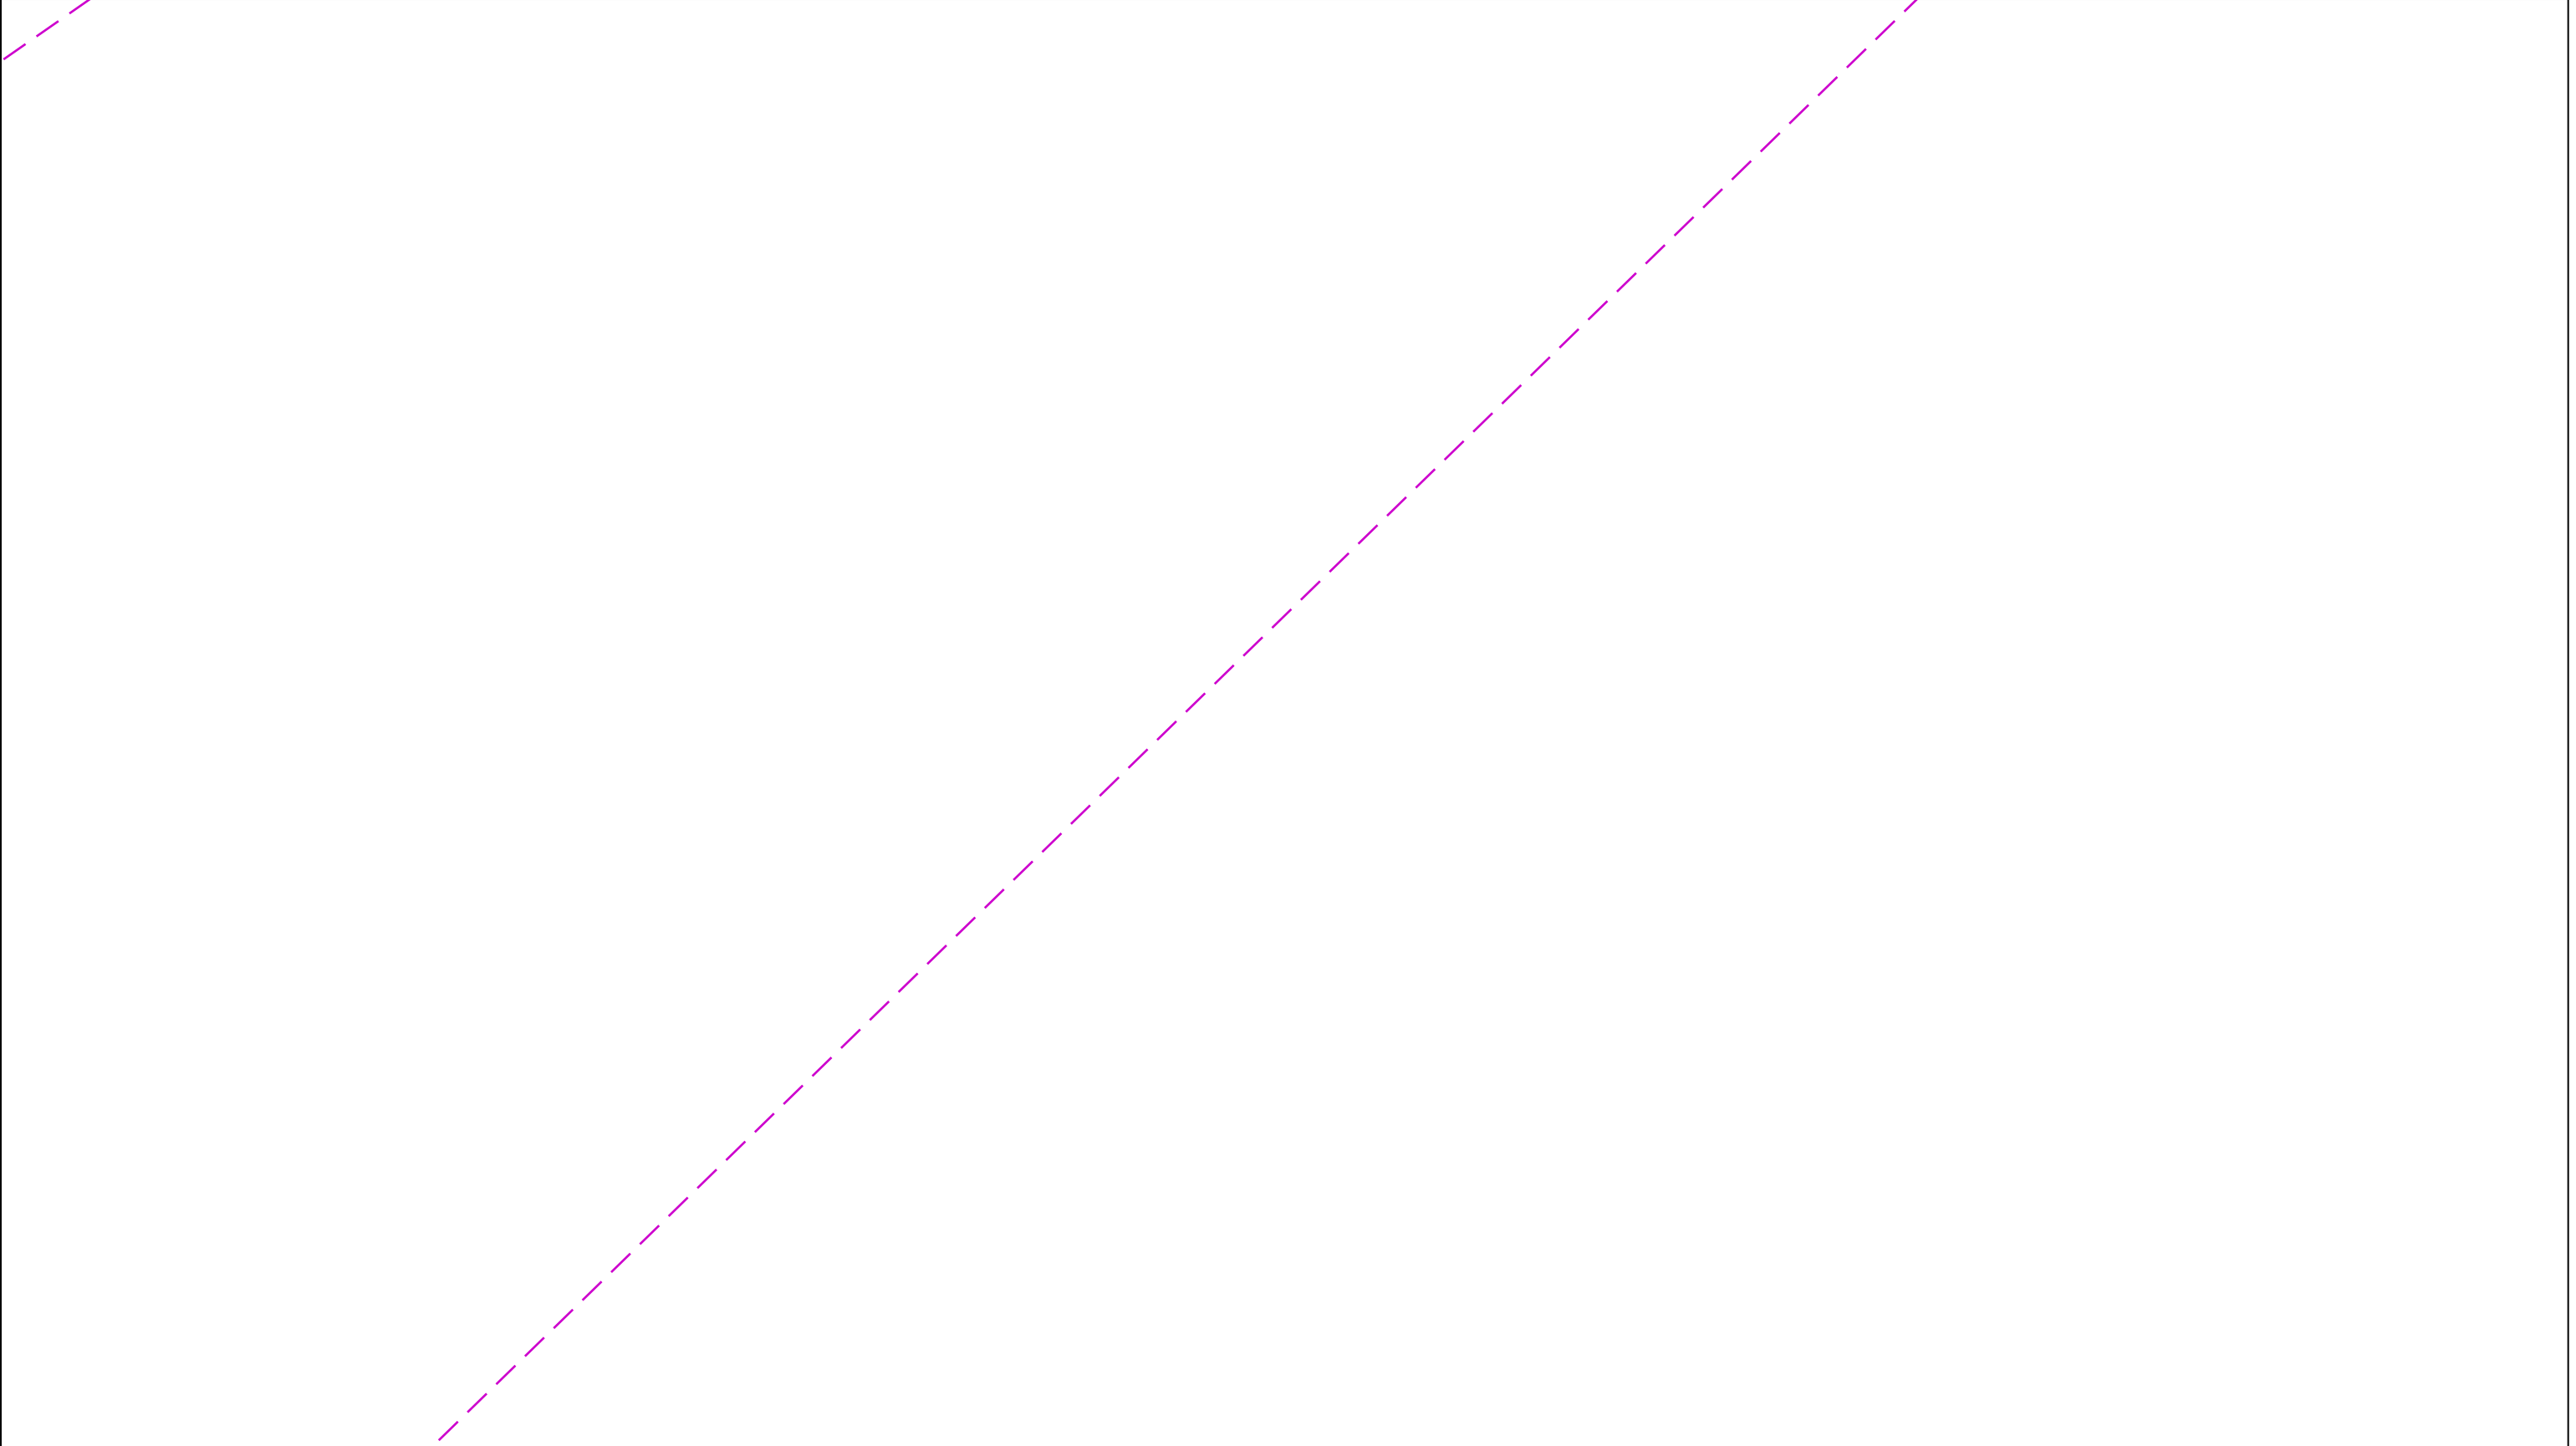

**In an emergency call 105,
24 hours a day**

Date Requested: 09/08/2023
Job Reference: 30451195
Site Location: 385659 398578
Requested by:
Mr Duncan Phillips

Your Scheme/Reference: Brunswick

Scale: 1:500 (When plotted at A3)

IMPORTANT INFO

This plan shows cables owned by Last Mile Electricity Limited in their role as a Licensed Distributor (IDNO). Cables owned by other Distributors or privately owned cables (or, indeed, any other apparatus, equipment or infrastructure may also be present in the area. Information regarding such cables (or any such other apparatus, equipment, or infrastructure) should be obtained from the relevant owners.

The information shown on these plans is provided for general information purposes only and should not be relied on or treated as a substitute for your own enquiries. We make no warranty, representation, or guarantee, whether express or implied, regarding the content of the plans or that the content is accurate, complete, or up to date. No liability of any kind whatsoever is accepted by Last Mile Asset Management Limited, or their agents, servants or contractors for any error, omission, or misstatement.

Safe digging practices, in accordance with HS(G)47, must be used to verify and establish the actual position of all electrical cables and apparatus on site before any mechanical plant is used. It is your responsibility to ensure that this information is provided to all persons on or near electrical cables or apparatus. The information included on this plan should not be referred to beyond a period of 3 month from the date of issue.

ELECTRIC KEY

PROPOSED LV SERVICE	-----	LV STRAIGHT JOINT
PROPOSED LV	- - - - -	LV BREACH JOINT
PROPOSED HV	- . - . -	HV STRAIGHT JOINT
PROPOSED EHV (UG)	- . - . -	HV BREACH JOINT
EXISTING/AS LAID LV SERVICE	-----	STREET LIGHTING C.P
EXISTING/AS LAID LV (UG)	-----	MINI PILLAR
EXISTING/AS LAID HV (UG)	-----	LINK BOX
EXISTING/AS LAID EHV (UG)	-----	EARTH SPIKE
EXISTING LV OVERHEAD	— x —	POT END
EXISTING HV OVERHEAD	— x x —	SERVICE JOINT
EXISTING EHV OVERHEAD	— x x —	
PROPOSING DISCONNECTED	— x x —	



100m

Dig Sites

Area: 


Line: 



Last Mile Asset Management Limited
Fenick House, Lister Way
Hamilton International Technology Park
Glasgow G72 0FT
Telephone 03300 587 443

Crown Copyright © - Reproduced by permission of Ordnance Survey on behalf of HMSO. And database right 2023. All rights reserved. Ordnance Survey Licence number 100061801

(Page 4)

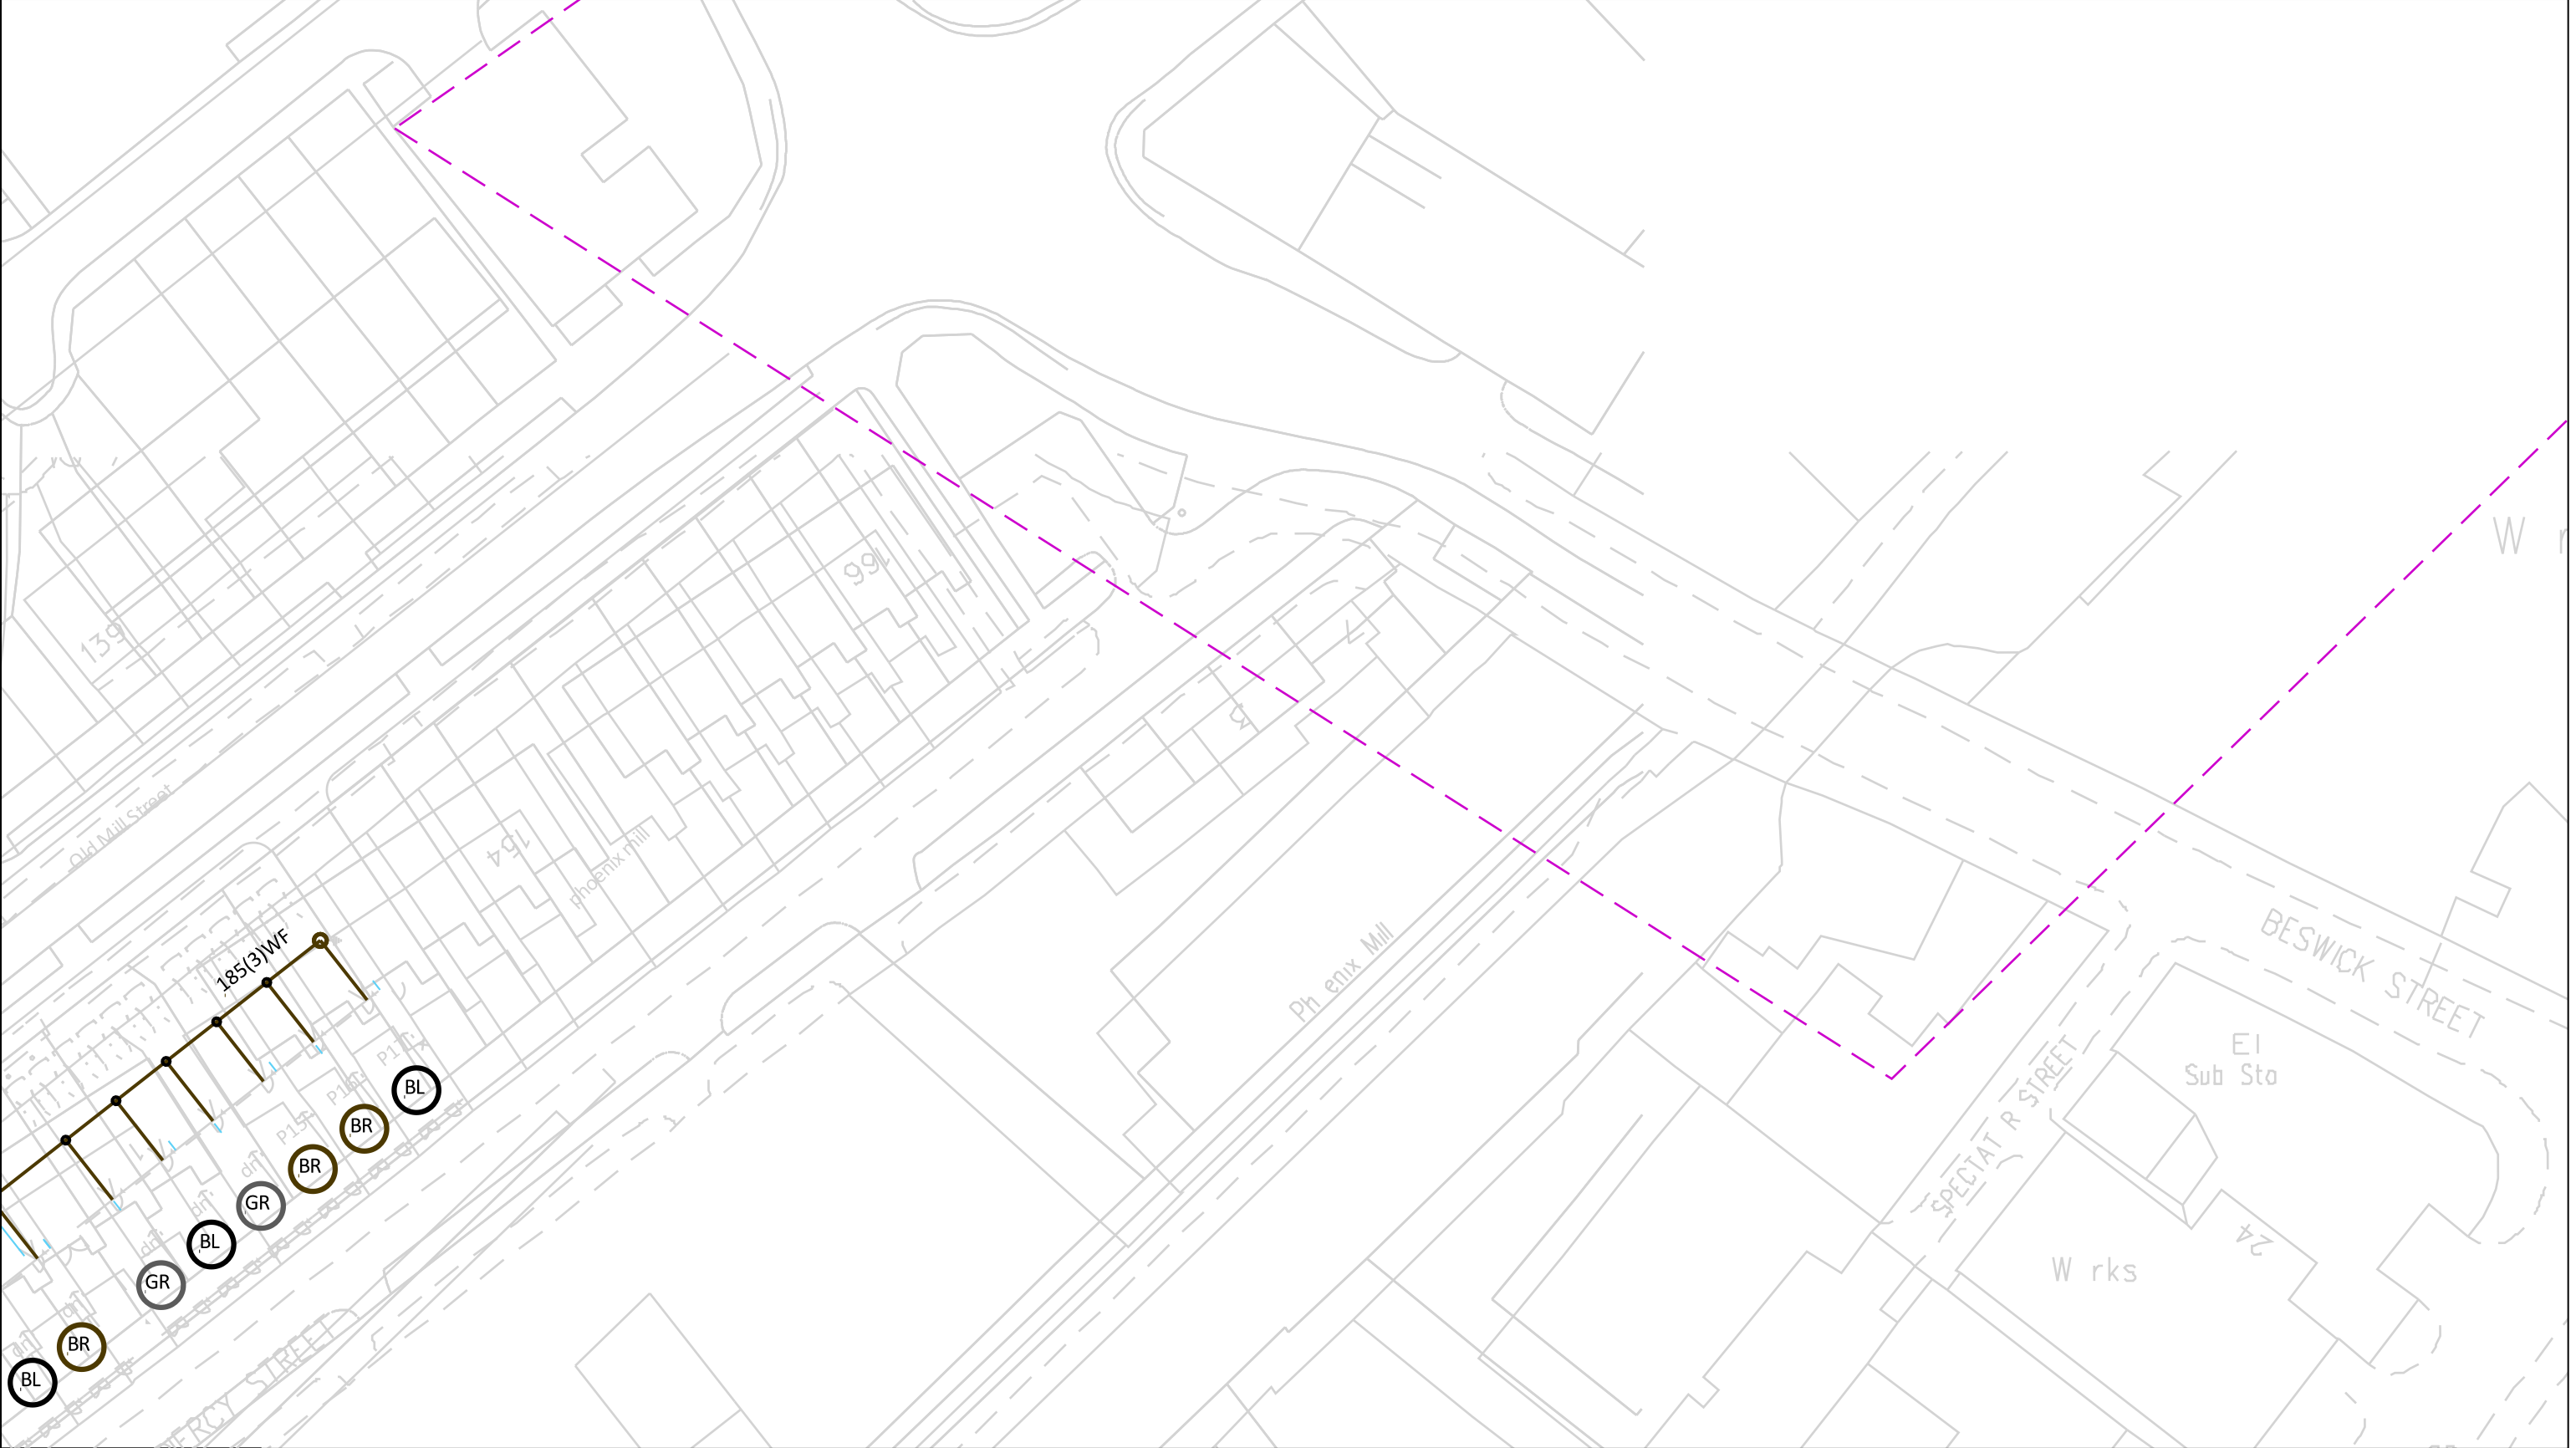

**In an emergency call 105,
24 hours a day**

Date Requested: 09/08/2023
Job Reference: 30451195
Site Location: 385659 398578
Requested by:
Mr Duncan Phillips

Your Scheme/Reference: Brunswick

Scale: 1:500 (When plotted at A3)

IMPORTANT INFO

This plan shows cables owned by Last Mile Electricity Limited in their role as a Licensed Distributor (IDNO). Cables owned by other Distributors or privately owned cables (or, indeed, any other apparatus, equipment or infrastructure) may also be present in the area. Information regarding such cables (or any such other apparatus, equipment, or infrastructure) should be obtained from the relevant owners.

The information shown on these plans is provided for general information purposes only and should not be relied on or treated as a substitute for your own enquiries. We make no warranty, representation, or guarantee, whether express or implied, regarding the content of the plans or that the content is accurate, complete, or up to date. No liability of any kind whatsoever is accepted by Last Mile Asset Management Limited, or their agents, servants or contractors for any error, omission, or misstatement.

Safe digging practices, in accordance with HS(G)47, must be used to verify and establish the actual position of all electrical cables and apparatus on site before any mechanical plant is used. It is your responsibility to ensure that this information is provided to all persons on or near electrical cables or apparatus. The information included on this plan should not be referred to beyond a period of 3 month from the date of issue.

ELECTRIC KEY

PROPOSED LV SERVICE	LV STRAIGHT JOINT
PROPOSED LV	LV BREACH JOINT
PROPOSED HV	HV STRAIGHT JOINT
PROPOSED EHV (UG)	HV BREACH JOINT
EXISTING/AS LAID LV SERVICE	STREET LIGHTING C.P
EXISTING/AS LAID LV (UG)	MINI PILLAR
EXISTING/AS LAID HV (UG)	LINK BOX
EXISTING/AS LAID EHV (UG)	EARTH SPIKE
EXISTING LV OVERHEAD	POT END
EXISTING HV OVERHEAD	SERVICE JOINT
EXISTING EHV OVERHEAD	
PROPOSING DISCONNECTED	

Dig Sites

Area:

Line:

Last Mile Asset Management Limited
Fenick House, Lister Way
Hamilton International Technology Park
Glasgow G72 0FT
Telephone 03300 587 443

100m

Crown Copyright © - Reproduced by permission of Ordnance Survey on behalf of HMSO. And database right 2023. All rights reserved. Ordnance Survey Licence number 100061801

(Page 5)



**In an emergency call 105,
24 hours a day**

Date Requested: 09/08/2023
Job Reference: 30451195
Site Location: 385659 398578
Requested by:
Mr Duncan Phillips

Your Scheme/Reference: Brunswick

Scale: 1:500 (When plotted at A3)

IMPORTANT INFO

This plan shows cables owned by Last Mile Electricity Limited in their role as a Licensed Distributor (IDNO). Cables owned by other Distributors or privately owned cables (or, indeed, any other apparatus, equipment or infrastructure may also be present in the area. Information regarding such cables (or any such other apparatus, equipment, or infrastructure) should be obtained from the relevant owners.

The information shown on these plans is provided for general information purposes only and should not be relied on or treated as a substitute for your own enquiries. We make no warranty, representation, or guarantee, whether express or implied, regarding the content of the plans or that the content is accurate, complete, or up to date. No liability of any kind whatsoever is accepted by Last Mile Asset Management Limited, or their agents, servants or contractors for any error, omission, or misstatement.

Safe digging practices, in accordance with HS(G)47, must be used to verify and establish the actual position of all electrical cables and apparatus on site before any mechanical plant is used. It is your responsibility to ensure that this information is provided to all persons on or near electrical cables or apparatus. The information included on this plan should not be referred to beyond a period of 3 month from the date of issue.

ELECTRIC KEY

PROPOSED LV SERVICE	-----	LV STRAIGHT JOINT	
PROPOSED LV	- - - - -	LV BREACH JOINT	
PROPOSED HV	- . - . -	HV STRAIGHT JOINT	
PROPOSED EHV (UG)	- - - - -	HV BREACH JOINT	
EXISTING/AS LAID LV SERVICE	-----	STREET LIGHTING C.P	
EXISTING/AS LAID LV (UG)	- - - - -	MINI PILLAR	
EXISTING/AS LAID HV (UG)	-----	LINK BOX	
EXISTING/AS LAID EHV (UG)	- . - . -	EARTH SPIKE	
EXISTING LV OVERHEAD	-----	POT END	
EXISTING HV OVERHEAD	- - - - -	SERVICE JOINT	
EXISTING EHV OVERHEAD	- . - . -		
PROPOSING DISCONNECTED	---		

Dig Sites

Area:

Line:

Last Mile Asset Management Limited
Fenick House, Lister Way
Hamilton International Technology Park
Glasgow G72 0FT
Telephone 03300 587 443

Searches - Cornerstone Projects Ltd

From: Virtual Utilities <no-reply@virtual-utilities.co.uk>
Sent: 09 August 2023 10:34
To: Duncan Phillips
Subject: Your UK Power Distribution Order - #23254
Attachments: invoice-23254.pdf

Thank you for your order

Thanks for your recent enquiry to UK Power Distribution.

Please find attached your invoice. The details of your order are also below:

According to our database there are no UK Power Distribution records within your search area.

Please note that any recent additions or alterations to our network may not be shown. Cables or pipes owned by other network owners or private companies will not be shown.
Before any excavations are undertaken you should always verify exact locations of cables using a cable locator, and by careful use of hand tools in accordance with HSE guidance note HSG47 "Avoiding danger from underground services"
Other useful documents to read prior to undertaking any works are HSE GS6, "Avoiding danger from overhead power lines" and HSE "Avoiding concealed services and overhead power lines"

Order number: #23254

Description	Date	Qty	Amount (£)
Utility Records Search View Map	09-08-2023 09:33:42	1	12.50
		VAT (@ 20%)	2.50
		Grand Total	15.00

Your Details

Duncan Phillips

searches@cornerstoneprojects.co.uk

Billing Address

Hoylake,
Wirral,
Merseyside,
CH47 5AA

<https://ukpd.virtual-utilities.co.uk>





Searches - Cornerstone Projects Ltd

From: Leep Electricity Networks <lenl@leeputilities.co.uk>
Sent: 10 August 2023 09:46
To: Searches - Cornerstone Projects Ltd
Subject: RE: Plant enquiry - Site Ref. Brunswick Brunswick Mill - Brunswick Mill, Manchester, M40 7EZ - NGR E385818 N398724

Hi,

There are no assets or cables owned by Leep Utilities in the located search area. **PLEASE NOTE** the absence of any Leep asset/cable records does not negate the requirement to use approved Cable Avoidance Tools and safe digging techniques as defined in HSG47.

Thanks,
Serah

Leep Electricity Networks
Take a look at our [website](#)

e: lenl@leeputilities.co.uk
w: www.leeputilities.co.uk
[Privacy Notice](#)



Leep Holdings (Utilities) Limited : Registered in England & Wales : Company Number 06729159 : Registered Office: Level 2, Metro, 33 Trafford Road, Manchester, Salford, M5 3NN

Please consider the environment before printing this email.

This message may contain confidential information. If you have received this message by mistake, please inform the sender by sending an e-mail reply. At the same time please delete the message and any attachments from your system without making, distributing or retaining any copies. Although all our e-mails messages and any attachments upon sending are automatically virus scanned we assume no responsibility for any loss or damage arising from the receipt and/or use.

From: Searches - Cornerstone Projects Ltd <searches@cornerstoneprojects.co.uk>
Sent: Wednesday, August 9, 2023 10:17 AM
To: Searches - Cornerstone Projects Ltd <searches@cornerstoneprojects.co.uk>

Searches - Cornerstone Projects Ltd

From: Networks Enquiries <assetenquiries@eclipsepower.co.uk>
Sent: 09 August 2023 10:51
To: Searches - Cornerstone Projects Ltd
Subject: RE: Plant enquiry - Site Ref. Brunswick Brunswick Mill - Brunswick Mill, Manchester, M40 7EZ - NGR E385818 N398724

Dear Sir/ Madam,

Thank you for your email. I can confirm that we have no present projects in the illustrated area as demonstrated in your email.

This response is valid for 3 months, after this time has commenced, we request you submit another email demonstrating the location of your plans.

If you have any further queries, do not hesitate to contact me.

Kindest regards,
Harry Constantine
Eclipse Power
Office: +44 (0) 1234 486487
www.eclipsepower.co.uk
<https://www.linkedin.com/company/eclipse-power-networks>



This e-mail is intended exclusively for the individual(s) to whom it is addressed and may contain information that is privileged, or confidential. If you are not the addressee, you must not read, use or disclose the contents of this e-mail. If you receive this e-mail in error, please notify enquiries@eclipsepower.co.uk giving the name of the sender and delete the e-mail immediately. Eclipse Power has taken every reasonable precaution to ensure that an attachment to this e-mail has been checked for any viruses. Eclipse Power cannot, however, accept liability for any damage sustained as a result of software viruses and would strongly advise that you carry out your own virus checks before opening any attachment.



Please don't print this e-mail unless you really need to!

From: Searches - Cornerstone Projects Ltd <searches@cornerstoneprojects.co.uk>
Sent: Wednesday, August 9, 2023 10:17 AM
To: Searches - Cornerstone Projects Ltd <searches@cornerstoneprojects.co.uk>
Subject: Plant enquiry - Site Ref. Brunswick Brunswick Mill - Brunswick Mill, Manchester, M40 7EZ - NGR E385818 N398724