



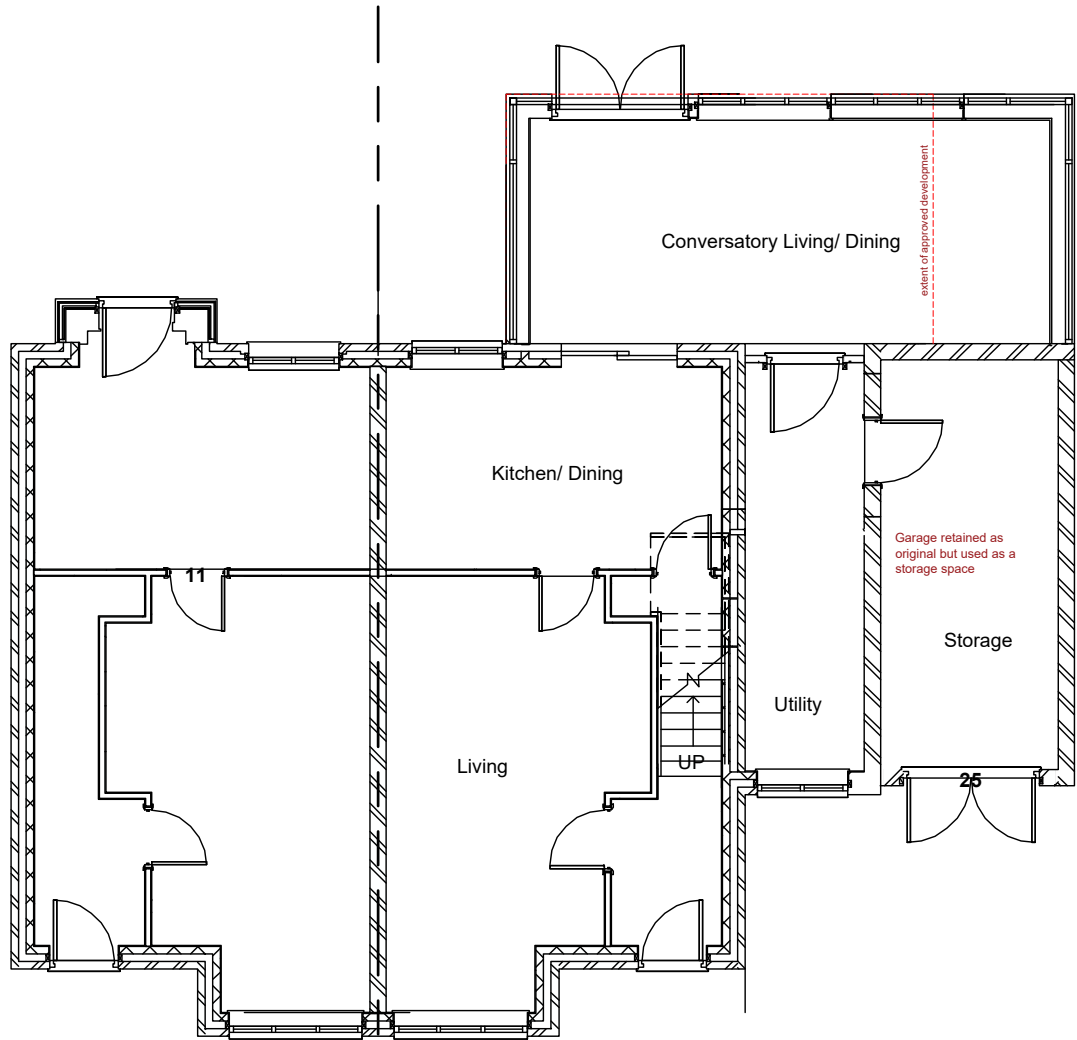


Existing (As-Built) Ground Floor Plan

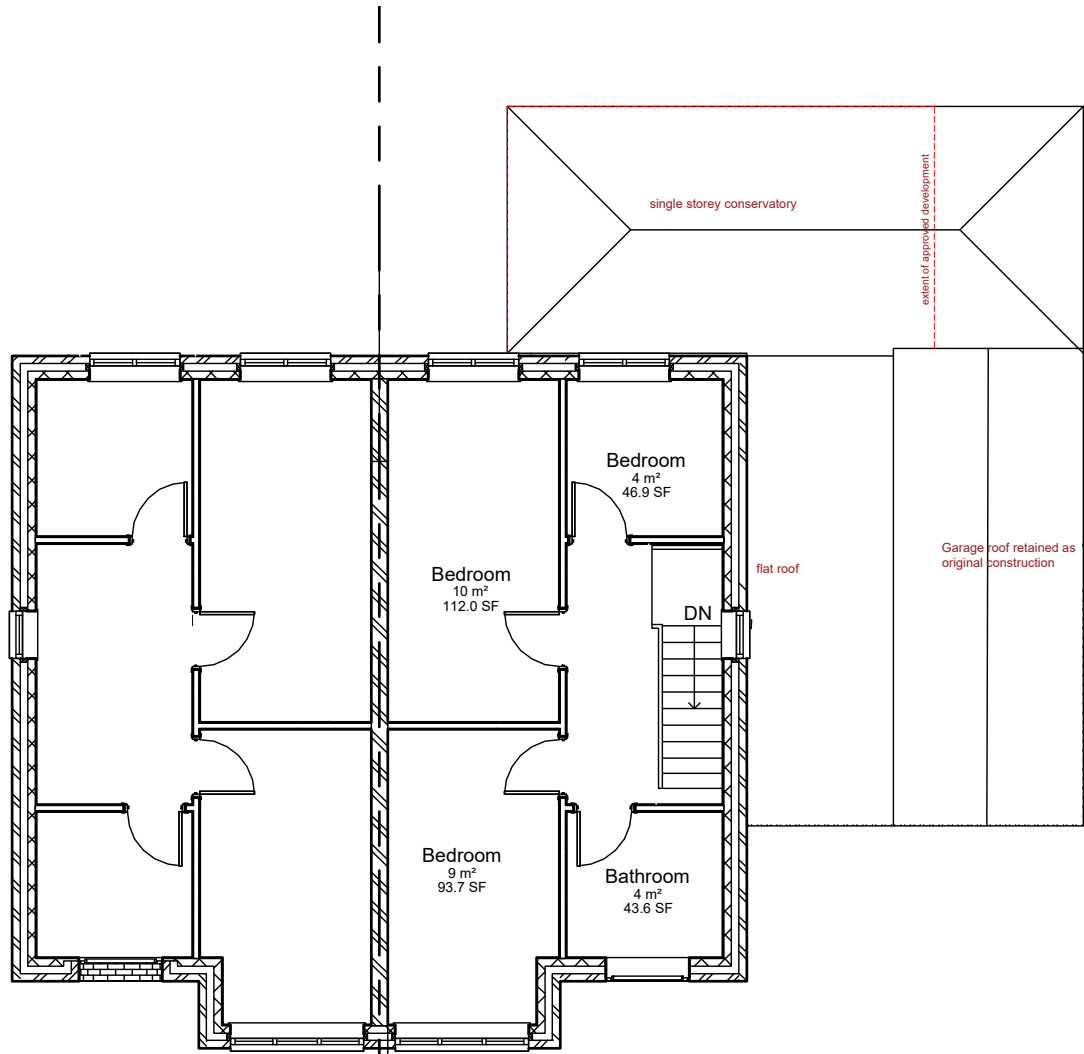

Existing (As-Built) First Floor Plan




Aerial View 01

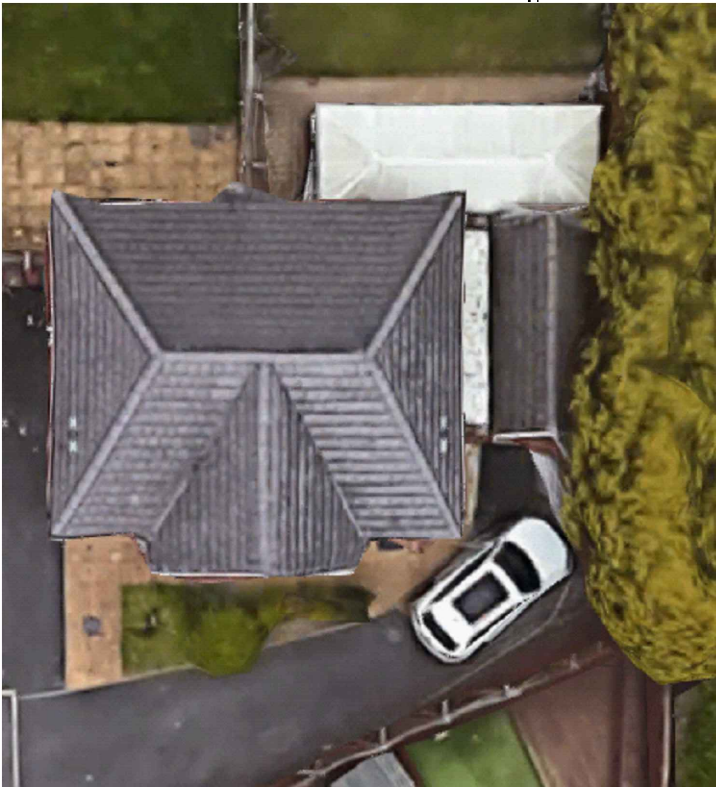

Aerial View 02

5 Stonemead Drive, Manchester, M9 6AF: Existing (As-Built) Drawings

NB: All boundary and party wall matters to be confirmed by client and subject to necessary boundary surveys

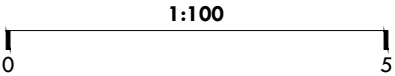

Rev	Amendments	Date
Project Title: Proposed Certificate of Lawful Development		
Client: Mr & Mrs H Aloo		
Site Address: 5 Stonemead Drive, Manchester		Postcode: M9 6AF
Drawing Sheet: Existing (As-Built) Plans and Elevations		
Drawing Status: Planning		
Proj No: 22-147	Dwg No: P-100	Scale: 1:100 @ A3
Designed By: TMK	Drawn By: GM	Checked By: MKWA
		Date of 1st Issue: 23.10.2023
Only figured dimensions are to be used. All dimensions to be checked on the prior to construction, order or manufacture of any element. In the event of any discrepancy, notify MKW Architecture Ltd immediately. This drawing remains the copyright of MKW Architecture Ltd and shall not be copied in whole or part without prior written consent of the Company Director.		
MKW Architecture Ltd Suite 31, East Business Centre, Dowry St, Oldham, OL8 2PF T: +44(0)7932932599 E: info@mkwarchitecture.com W: www.mkwarchitecture.com		