




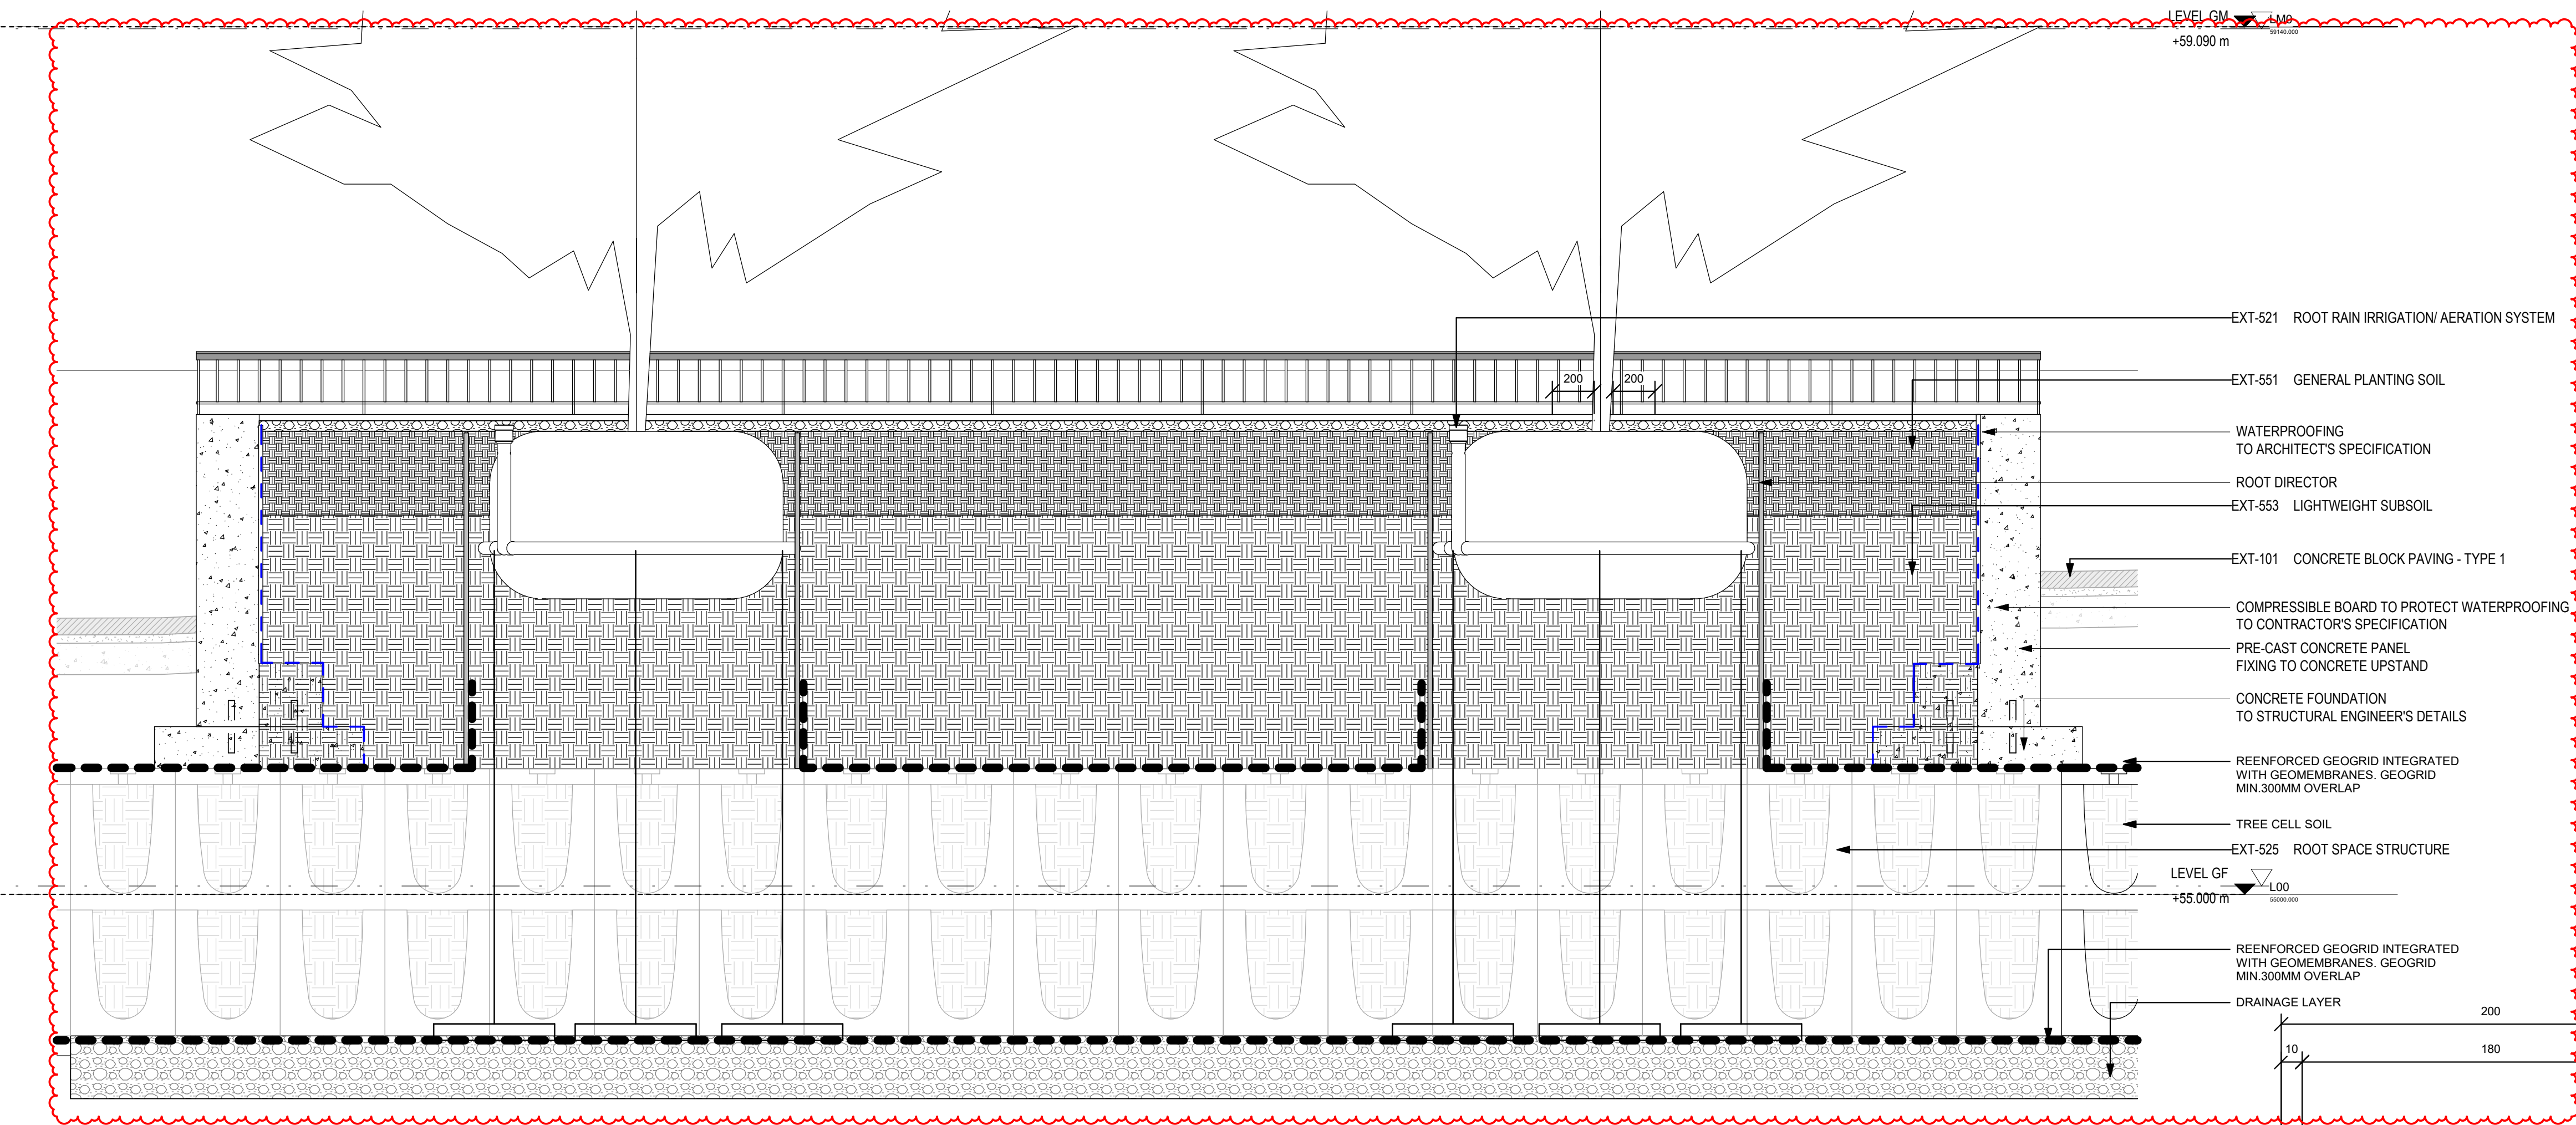


1 TYPICAL PRECAST CONCRETE PLANTER ON GROUND_GF_SECTION 1

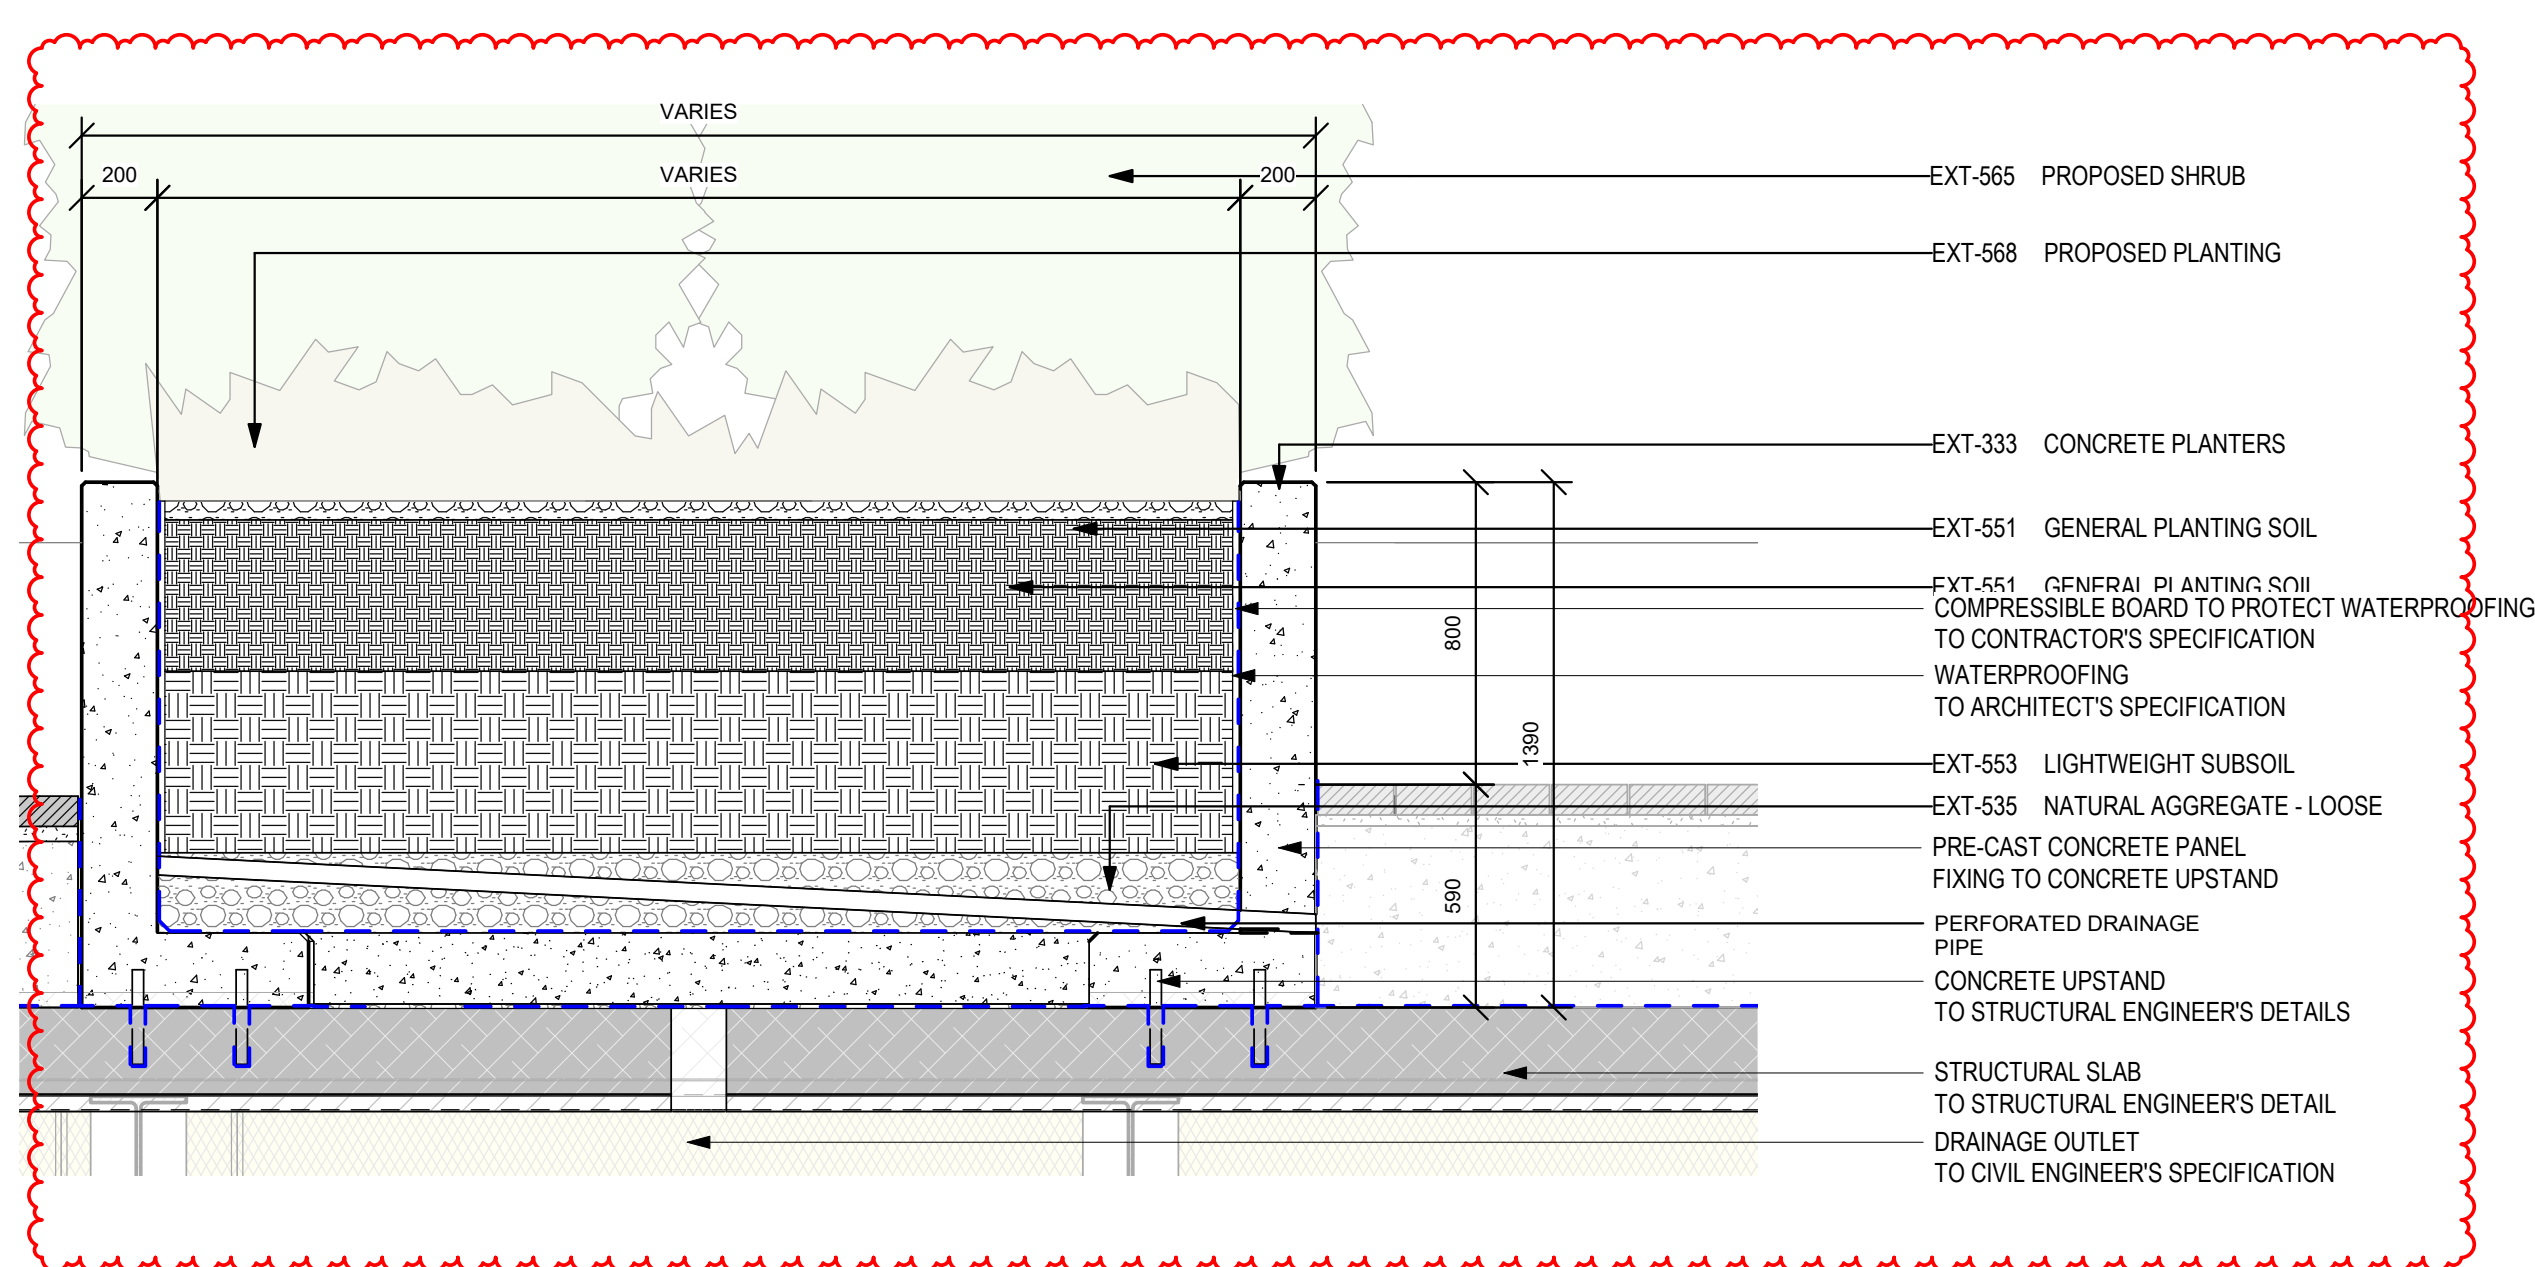


4 TYPICAL PRECAST CONCRETE PLANTER ON SLAB_LEVEL 01_SECTION 1

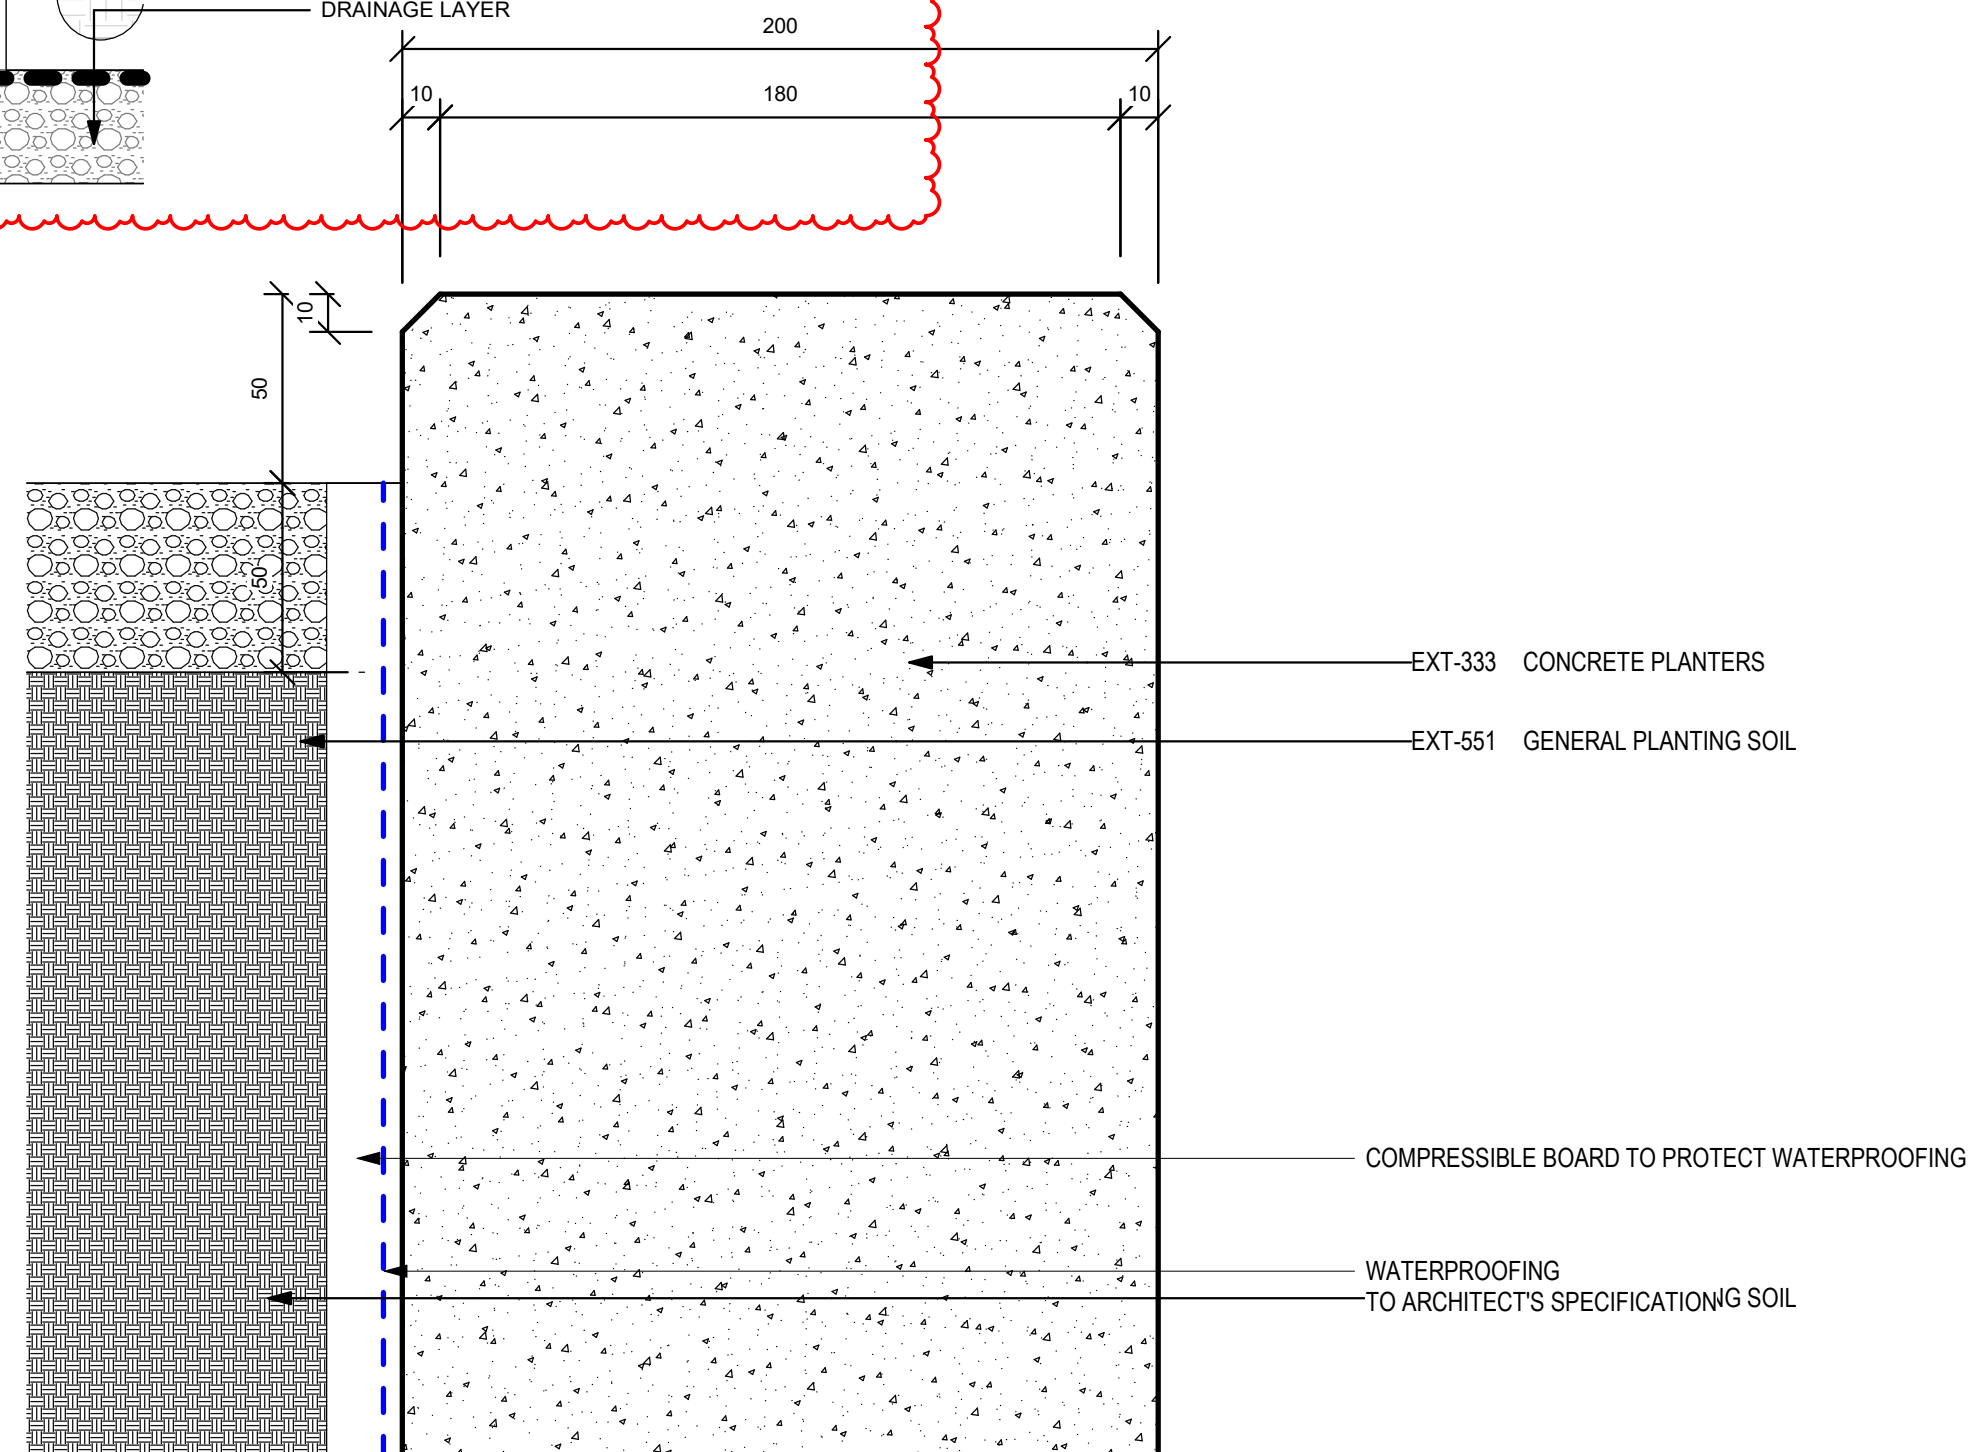


7 TYPICAL PRECAST CONCRETE PLANTER TOP_DETAIL

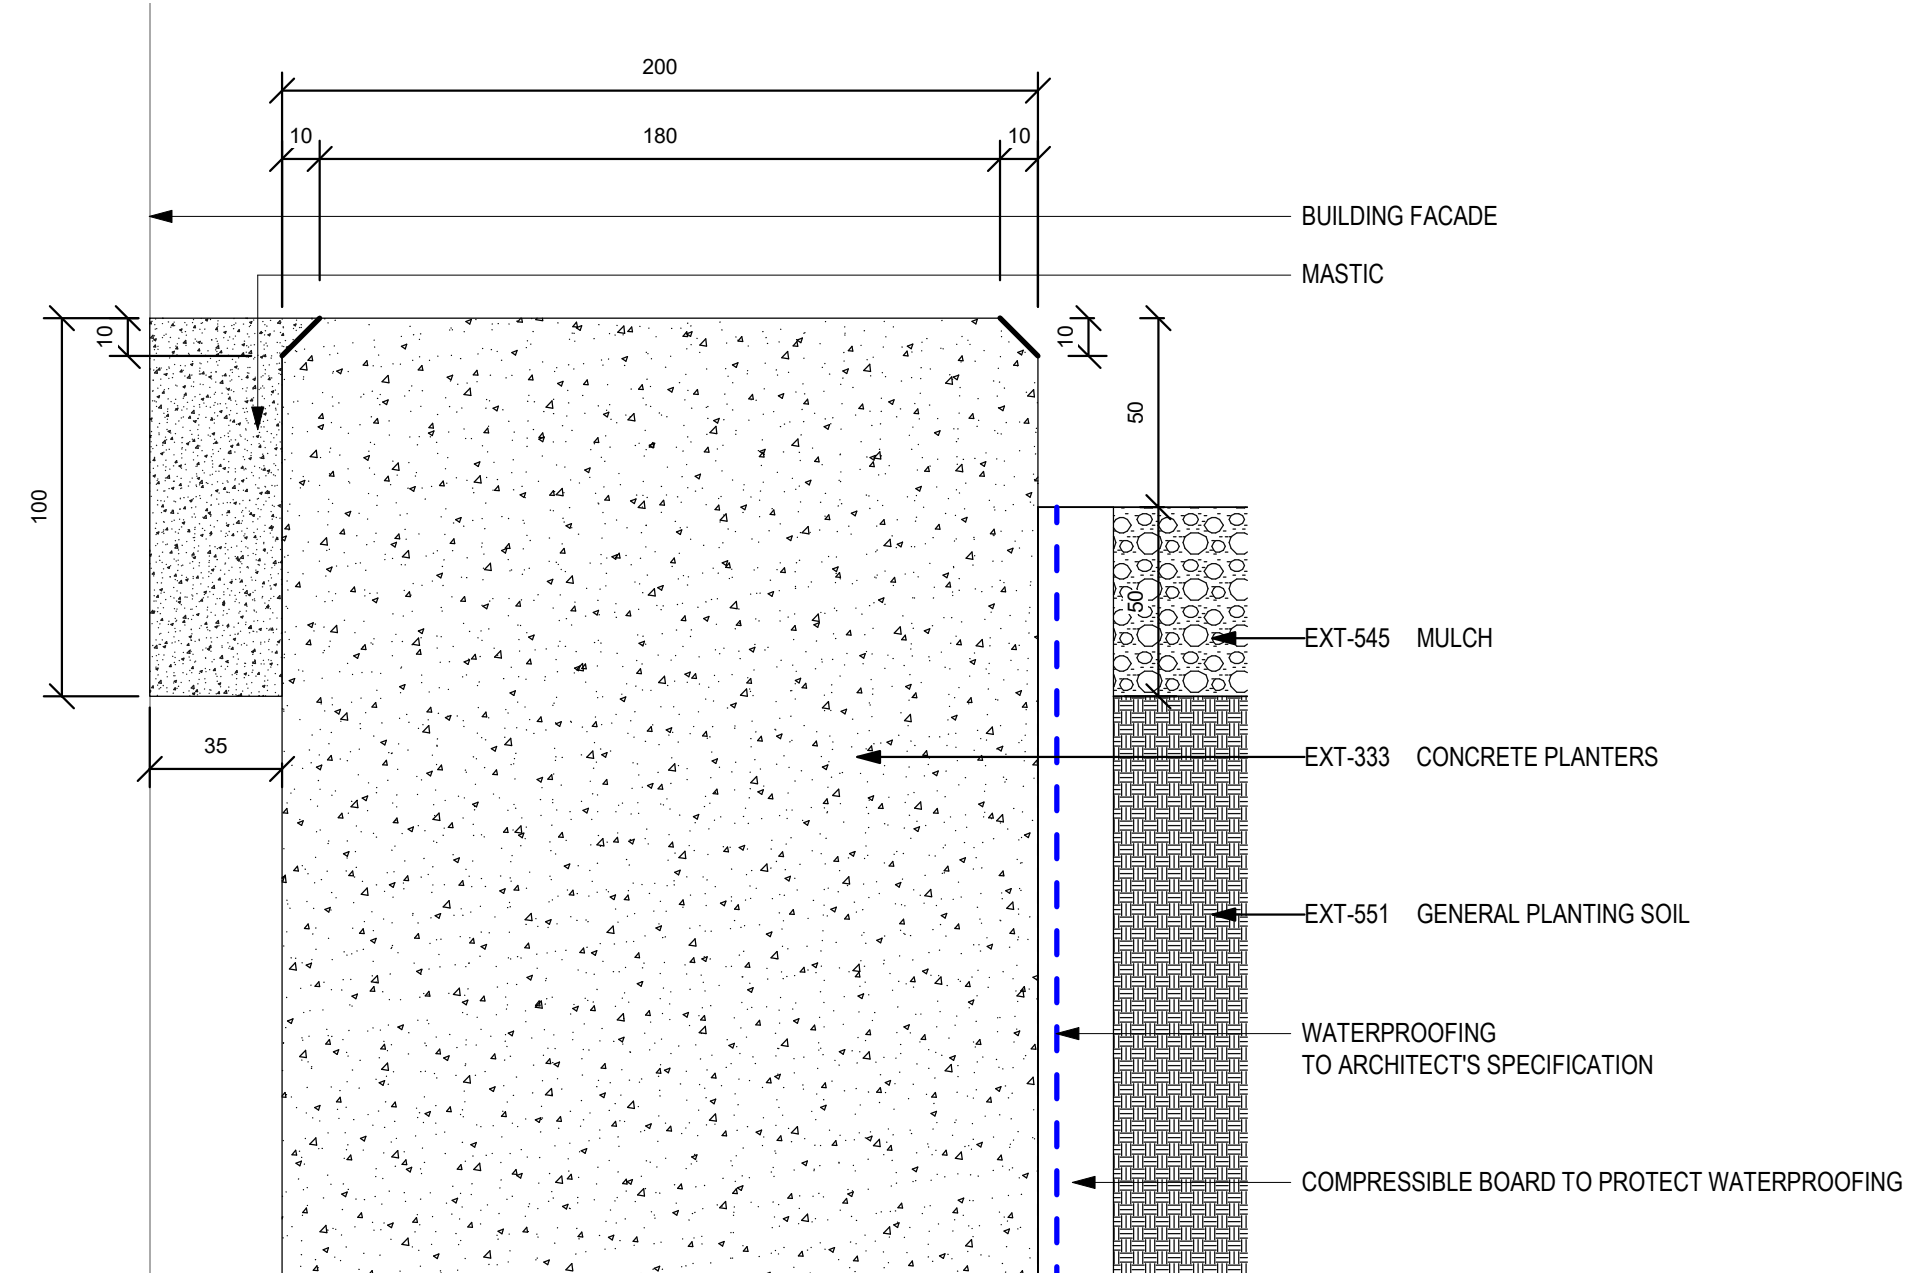

8 TYPICAL PRECAST CONCRETE PLANTER TOP - BUILDING FACADE_DETAIL

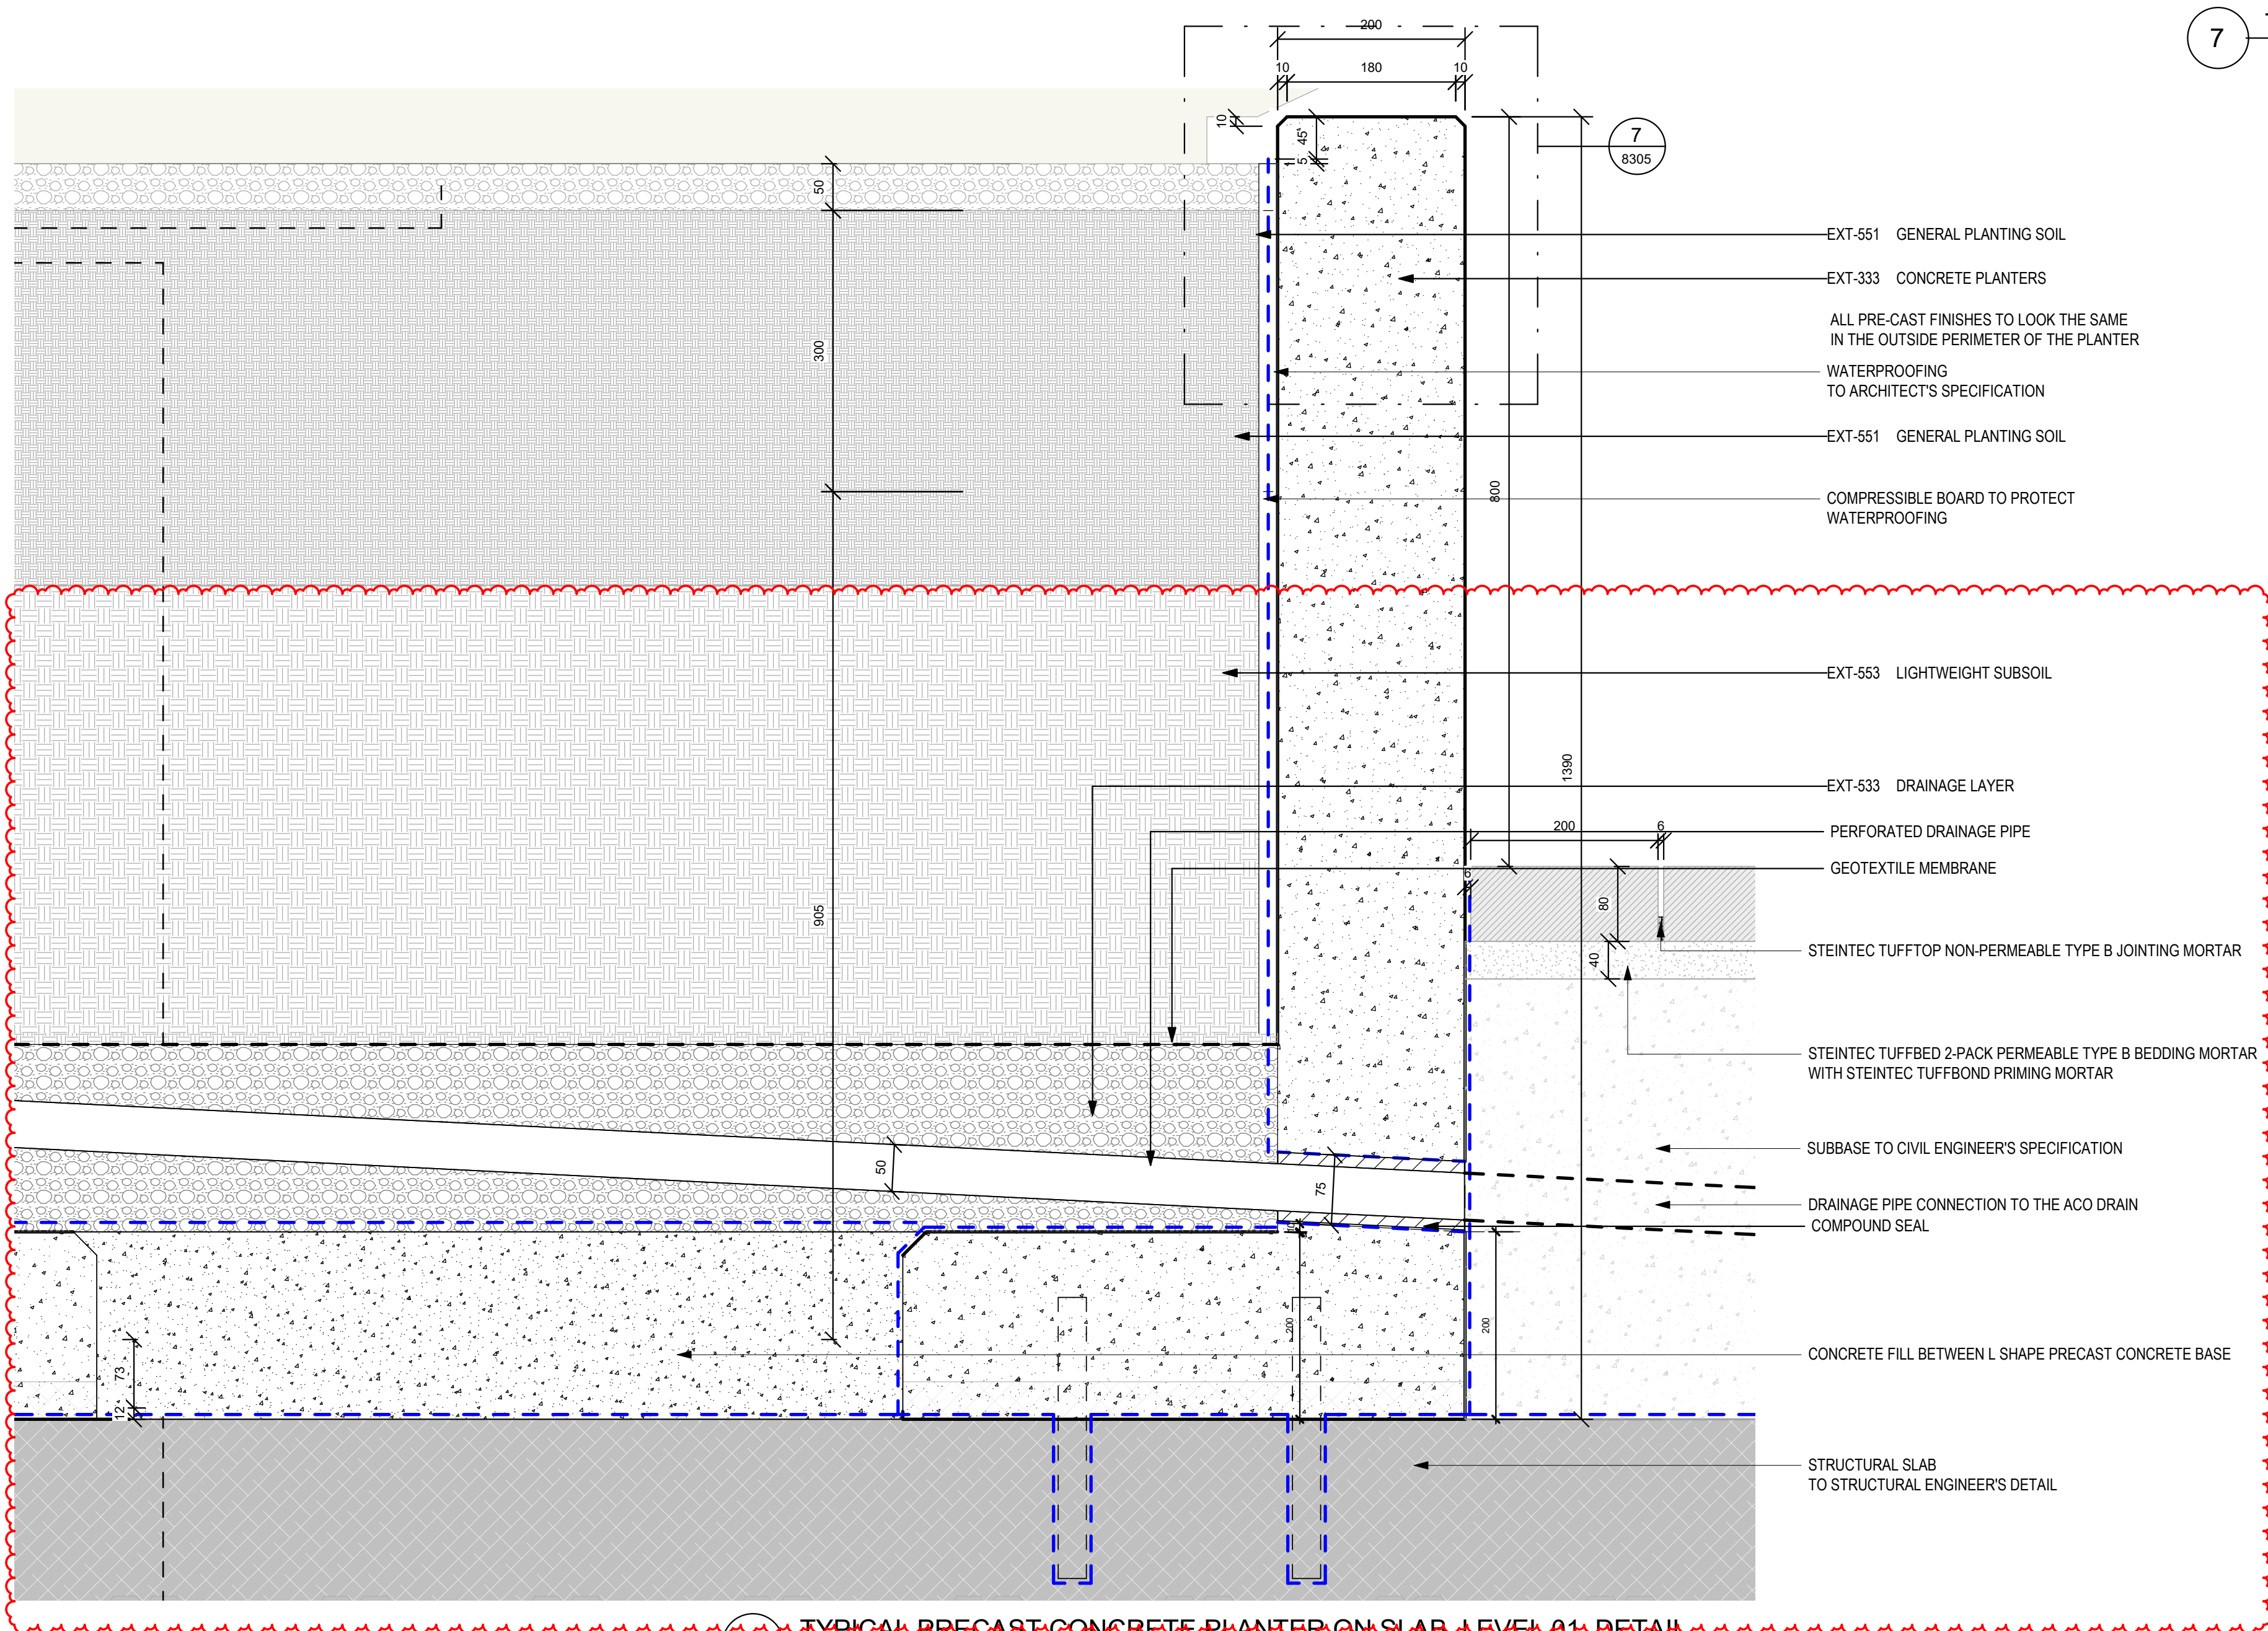

6 TYPICAL PRECAST CONCRETE PLANTER ON SLAB_LEVEL 01_DETAIL

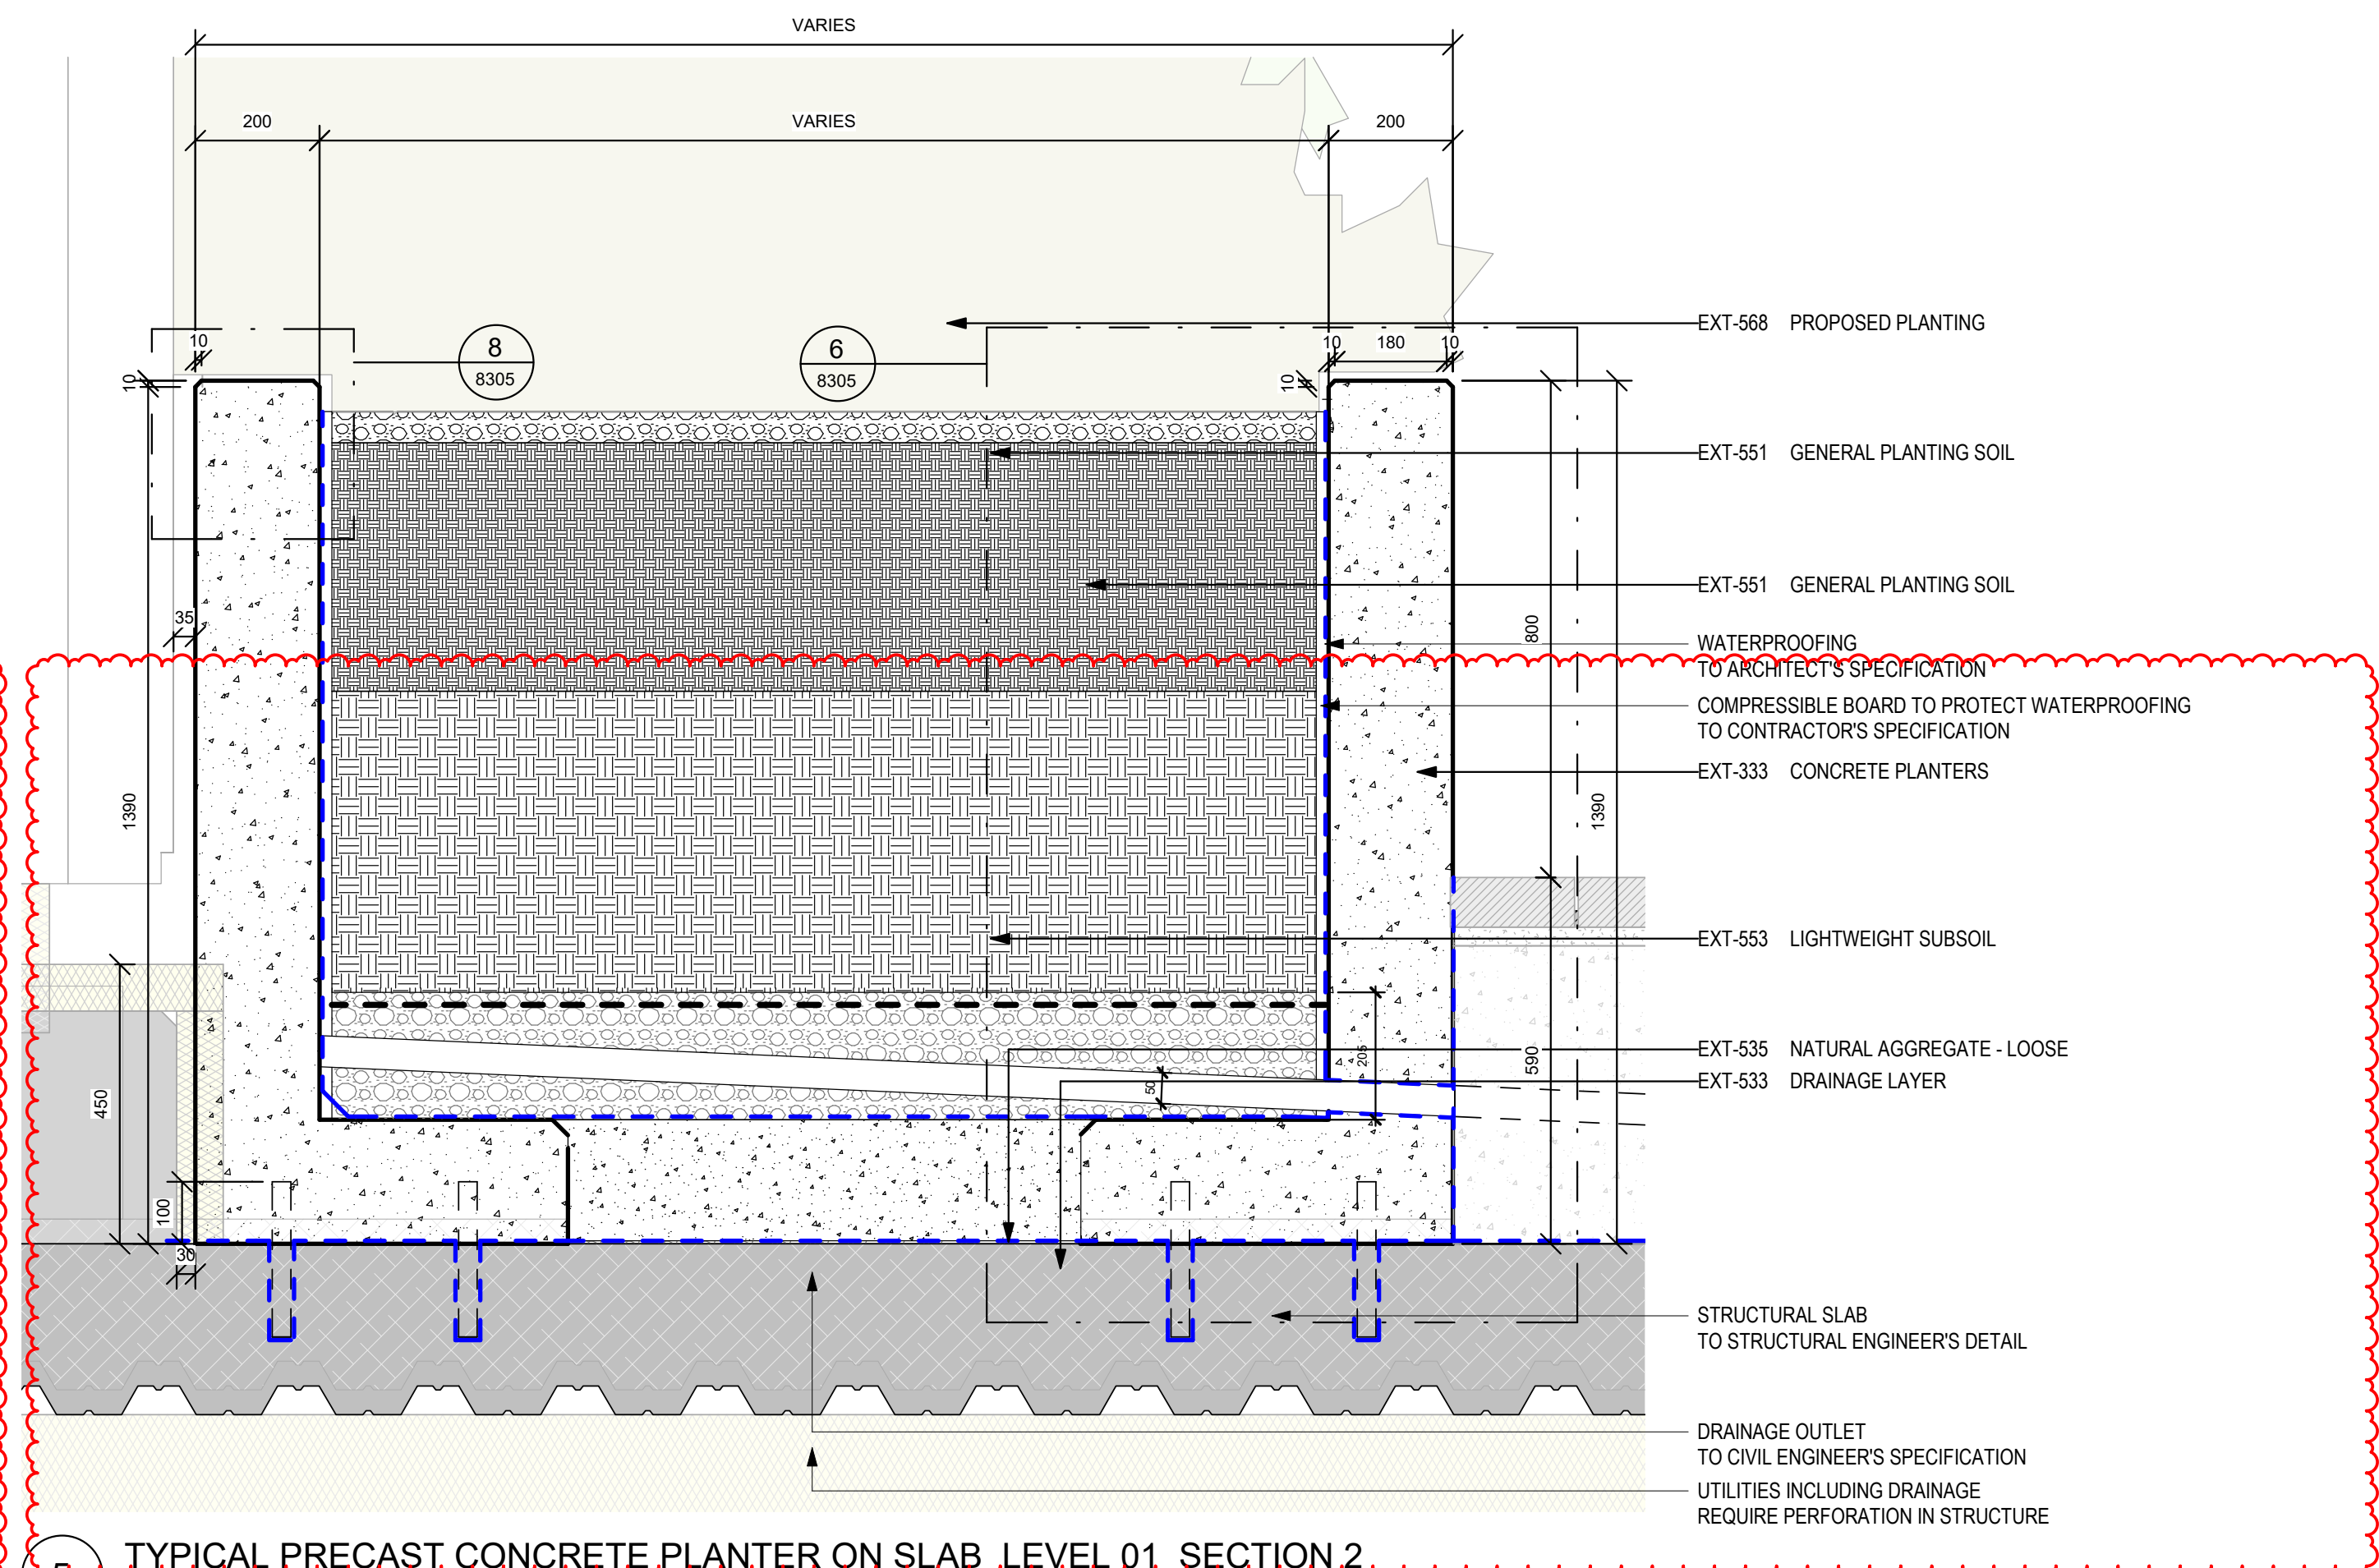


5 TYPICAL PRECAST CONCRETE PLANTER ON SLAB_LEVEL 01_SECTION 2

NOTES: TYPICAL PRECAST CONCRETE PLANTER ON GROUND DETAIL REFER TO DRAWING: BRA-POP-ZZ-DR-L-8401

Stability Code (as defined in ISO 19650-2:2018)

Work in Progress (WIP)
S0 - Initial Status
S1 - Suitable for co-ordination
S2 - Suitable for information
S3 - Suitable for review & comment
S4 - Suitable for review & approval
S5 - Withdrawn
S6 - Suitable for PM authorisation
S7 - Suitable for AIA authorisation
Published (Contractual)
A1, A2, A3, etc. - Authorised and accepted
B1, B2, B3, etc. - Partial sign-off (with comments)
Published (AIM Acceptance)
CR - As constructed record document

KEY PLAN

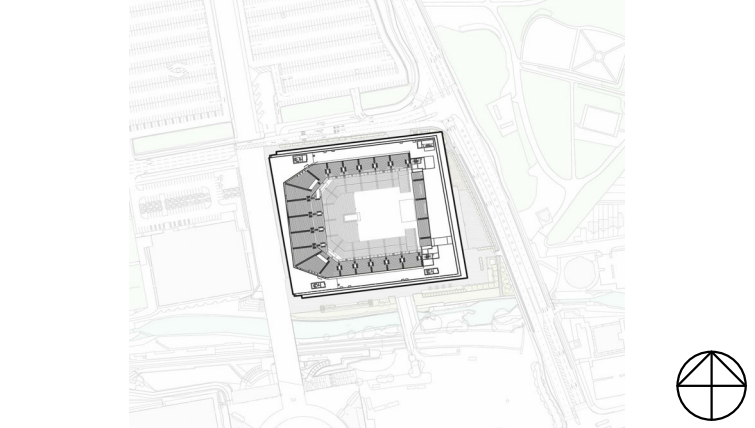

NOTES:

1. PRECAST CONCRETE PLANTERS ON GROUND FLOOR TO FOLLOW HVM REQUIREMENTS
2. FOR PRECAST CONCRETE PLANTERS REFER TO DRAWINGS BRA-POP-ZZ-DR-L-8331 AND BRA-POP-ZZ-DR-L-8332
3. FOR CAST IN SITU CONCRETE PLANTERS REFER TO DRAWINGS BRA-POP-ZZ-DR-L-8334 AND BRA-POP-ZZ-DR-L-8335

THIS DRAWING IS ONLY TO SCALE IF IT IS REPRODUCED AT THE CORRECT PAPER SIZE

1:20@A0
0 0.4 0.8 1.6

ALL INTERNAL LAYOUTS AND USES ARE SHOWN FOR ILLUSTRATIVE PURPOSES ONLY AND ARE NOT FOR DETERMINATION

THIS DRAWING IS ONLY TO SCALE IF IT IS REPRODUCED AT THE CORRECT PAPER SIZE

1:10@A0
0 0.1 0.2 0.3 0.4

ALL INTERNAL LAYOUTS AND USES ARE SHOWN FOR ILLUSTRATIVE PURPOSES ONLY AND ARE NOT FOR DETERMINATION

THIS DRAWING IS ONLY TO SCALE IF IT IS REPRODUCED AT THE CORRECT PAPER SIZE

1:5@A0
0 0.05 0.1 0.15 0.2

ALL INTERNAL LAYOUTS AND USES ARE SHOWN FOR ILLUSTRATIVE PURPOSES ONLY AND ARE NOT FOR DETERMINATION

THIS DRAWING IS ONLY TO SCALE IF IT IS REPRODUCED AT THE CORRECT PAPER SIZE

1:2@A0
0 0.025 0.05 0.075 0.1

ALL INTERNAL LAYOUTS AND USES ARE SHOWN FOR ILLUSTRATIVE PURPOSES ONLY AND ARE NOT FOR DETERMINATION

Safety, Health and Environmental Information

In addition to the hazards / risks normally associated with the types of work detailed on this drawing, note the following risks and information:

Construction See risk register No abnormal risks identified with this package of work.

For information relating to Use, Covering and Maintenance see the Health and Safety File. It is assumed that all works will be carried out by a competent contractor working, where appropriate, to an approved method statement.

date



© COPYRIGHT. ALL RIGHTS RESERVED

THIS WORK IS COPYRIGHTED AND CANNOT BE REPRODUCED OR COPIED IN ANY FORM OR BY ANY MEANS WITHOUT THE WRITTEN PERMISSION OF POPULOUS. ANY UNLAWFUL REPRODUCTION OF THIS DOCUMENT OR ANY PART THEREOF IS PROHIBITED TO THE FULLEST EXTENT OF THE LAW. THE AGREEMENT OR IMPLIED AGREEMENT BETWEEN POPULOUS AND THE INSTRUCTING PARTY.

USE FOR ALL DIMENSIONS IN PREFERENCE TO SCALED. CHECK ALL DIMENSIONS ON SITE BEFORE FABRICATION OR SETTING OUT.

address

POPULOUS®

14 BLADES COURT | DEodar ROAD | LONDON | SW15 2NU | UNITED KINGDOM
TELEPHONE +44 (0)20 8874 7666 FACSIMILE +44 (0)20 8874 7470
ALL PRODUCTION & INTELLECTUAL PROPERTY RIGHTS RESERVED © POPULOUS 2019

REVISIONS

REV	DATE	DESCRIPTION
01	29.11.2019	DRAFT RIBA STAGE 3
02	14.04.2020	ISSUED FOR T1 DRAFT STAGE 4A
03	22.06.2020	ISSUED FOR T2 STAGE 4a
04	20.07.2021	STAGE 4B EXTERNAL FURNITURE
05	12.01.2022	EXTERNAL FURNITURE ISSUED FOR CONSTRUCTION
06	17.03.2023	ADDITIONAL INFORMATION INCLUDED
07	15.04.2023	ADDITIONAL INFORMATION INCLUDED
08	05.05.2023	PLANTERS UPDATE
09	02.06.2023	PLANTERS UPDATE
10	24.07.2023	POPULOUS DRAINAGE OUTLET UPDATE

project name

Co-op Live

the TYPICAL CONCRETE PLANTER DETAILS

purpose of issue
CONSTRUCTION

scale 1:20, 1:10, 1:5, 1:2@ down FP Project no. 4933

date 20/11/19 checked TJ 4933

project code originator volume level type role number
revisions BRA-POP-ZZ-DR-L-8305 C06