


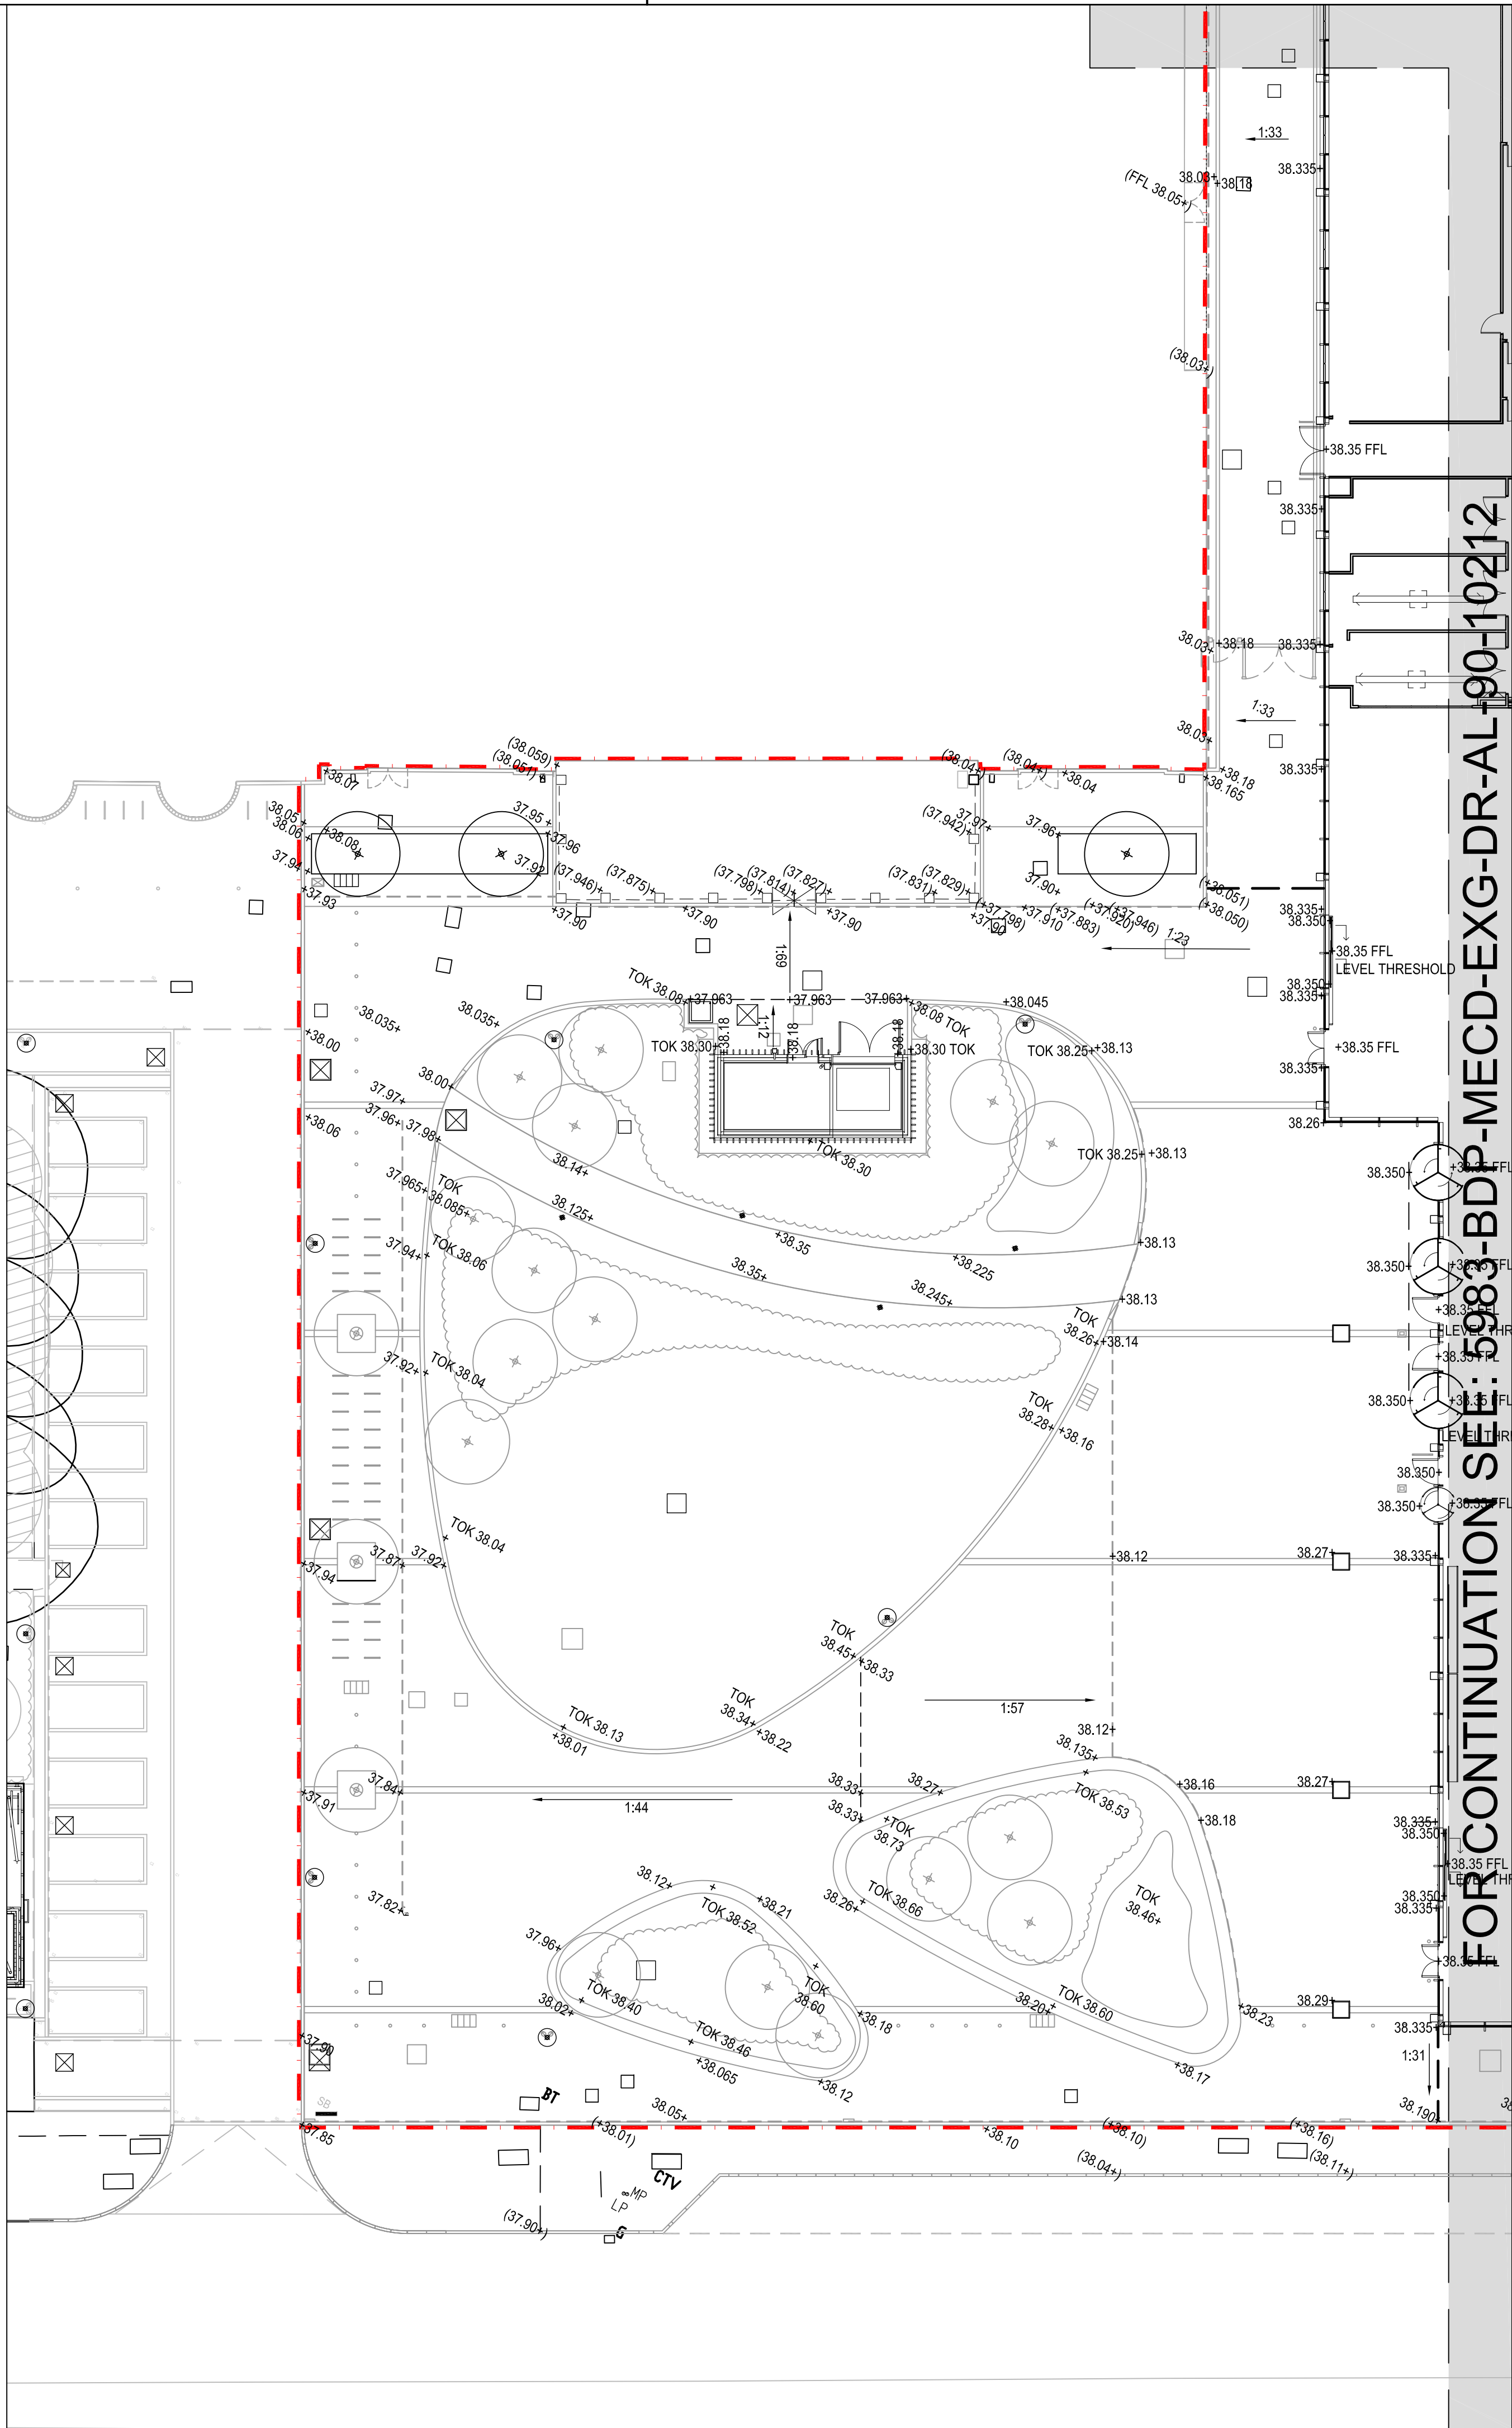

KEY	
	MAIN WORKS BOUNDARY
	EXISTING LEVEL RETAINED
	PROPOSED LEVEL
	PROPOSED FALL
	PROPOSED S278 LEVEL BY ARUP
	Spot heights/levels amended from previous design intent to coordinate with amended as built levels. Levels provided by ABC

The University of Maryland

NOTES:

TO BE READ IN CONJUNCTION WITH MANHOLE WORKS DRAWINGS:

5583-BD-MEJC-MEJC-GR-AL-90-102011 - 10203 - GENERAL ARRANGEMENTS

5583-BD-MEJC-MEJC-GR-AL-90-102111 - 10213 - PROPOSED LEVELS PLANS

5583-BD-MEJC-MEJC-GR-AL-90-60401 - 10402 - DETAIL DETAILS

5583-BD-MEJC-MEJC-GR-AL-90-60701 - CONSTRUCTION DETAILS SHEET 1 OF 2

5583-BD-MEJC-MEJC-GR-AL-90-60702 - CONSTRUCTION DETAILS SHEET 2 OF 2

5583-BD-MEJC-MEJC-GR-AL-90-60703 - "G3 & G4" GATE DETAILS

5583-BD-MEJC-MEJC-GR-AL-90-60704 - "G5 & G6" GATE DETAILS

5583-BD-MEJC-MEJC-GR-AL-90-60705 - "G7 & G8" GATE DETAILS

5583-BD-MEJC-MEJC-GR-AL-90-60706 - TYPICAL SEPT WALL DETAILS

5583-BD-MEJC-MEJC-GR-AL-90-60707 - "P2" PLANTER DETAILS


5583-BD-MEJC-MEJC-GR-AL-93-10201 - 10203 PLANTING PLANS

5583-BD-MEJC-MEJC-GR-AL-93-60701 - PLANTING DETAILS

5583-BD-MEJC-MEJC-GR-SP-AL-98-90901 - LANDSCAPE SPECIFICATION

ALL EXISTING AND PROPOSED MANHOLE COVERS TO BE RECESSED COVER TO TYPE AND ALIGNED WITH PAVING.

TO BE READ IN CONJUNCTION WITH ARUP DRAINAGE AND LIGHTING DRAWINGS

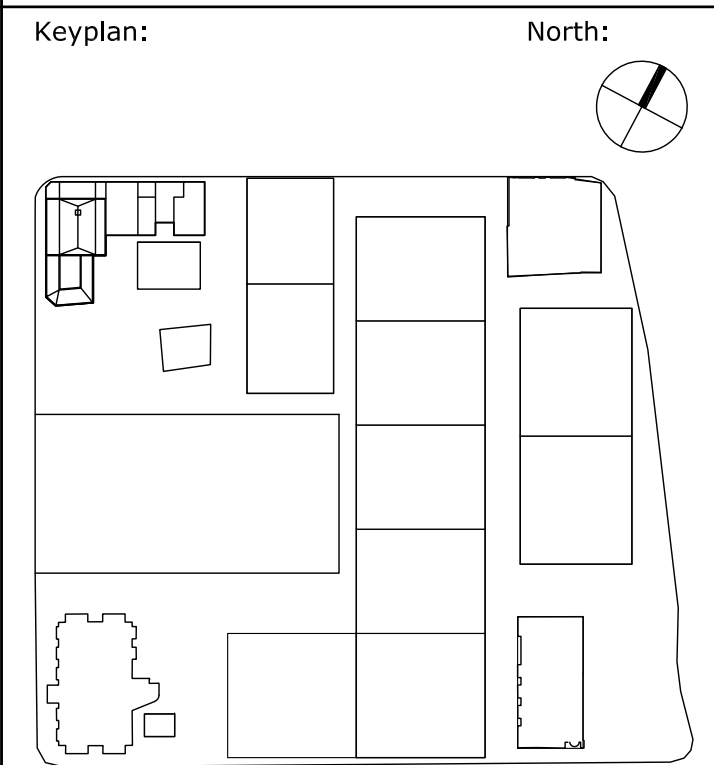[illegible]

The drawing represents 'Final Construction' status; being the last construction status drawing produced by BDP. This does not represent 'As Built' information based on site surveys or site inspection by BDP, main contractor or client. Any work to be progressed on the basis of the information contained in this drawing should be verified by site investigation and/or survey to ensure that work can proceed safely and in accordance with all necessary requirements. These necessary requirements would include, but are not limited to things such as: the structural design, fire strategy, thermal performance, acoustic strategy, security/ access strategy etc.

FC01	FINAL CONSTRUCTION ISSUE	IF	31.03.21	NMS	JRM
Rev	Description	By	Date	Chk'd	Auth

MANCHESTER
1824
The University of Manchester

Directorate of Estates and Facilities
Beyer Building
The University of Manchester
Oxford Road
Manchester
M13 9PL

6th Floor, 3 St Paul's Place,
129 Norfolk St, Sheffield, S1 2JE

Tel. 0114 273 1641
www.bdp.com, sheffield@bdp.com

Drawing Status			
Final Construction Issue			
Project Manchester Engineering Campus Development 5983			
Building Name -			
Sub Site Name -			
Site Name MECD			
Drawing Title MAIN WORKS PROPOSED LEVELS PLAN SHEET 3 OF 3			
PM -	Drawn IF	Checked YZ	Authorised JRM
Scale @ A1 1:200	Date 10.01.17	Date 10.01.17	Date 10.01.17
Drawing No. 5983-BDP-MECD-EXG-DR-AL-90-10213			Revision FC01