



EXISTING STRUCTURE SHOWN AS INDICATED ON EXISTING DRAWINGS.
NEW LOUVRES TO SUIT AS-BUILT SETTING OUT - TBC ON SITE

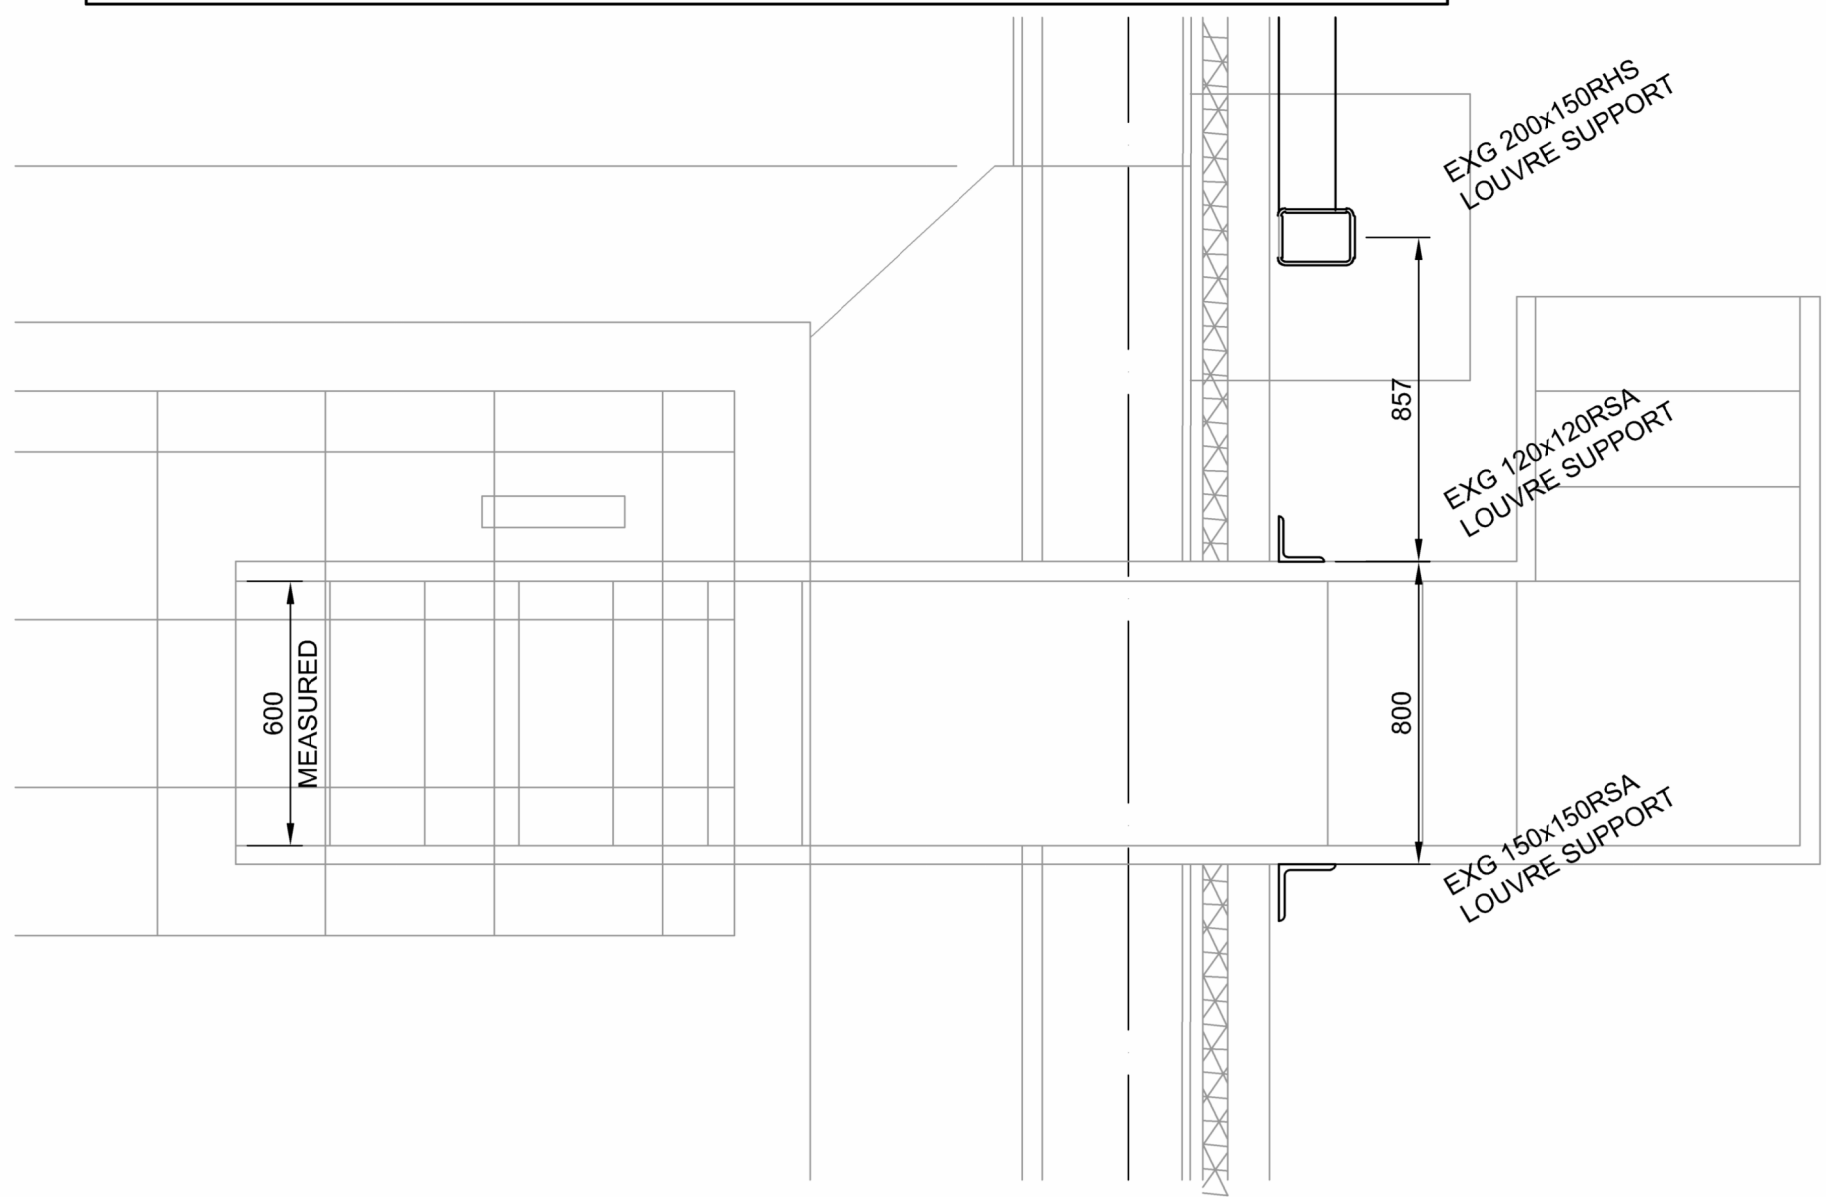


DETAIL 1 - ROOF ACCESS WALKWAY - EXISTING
(SCALE 1:20)

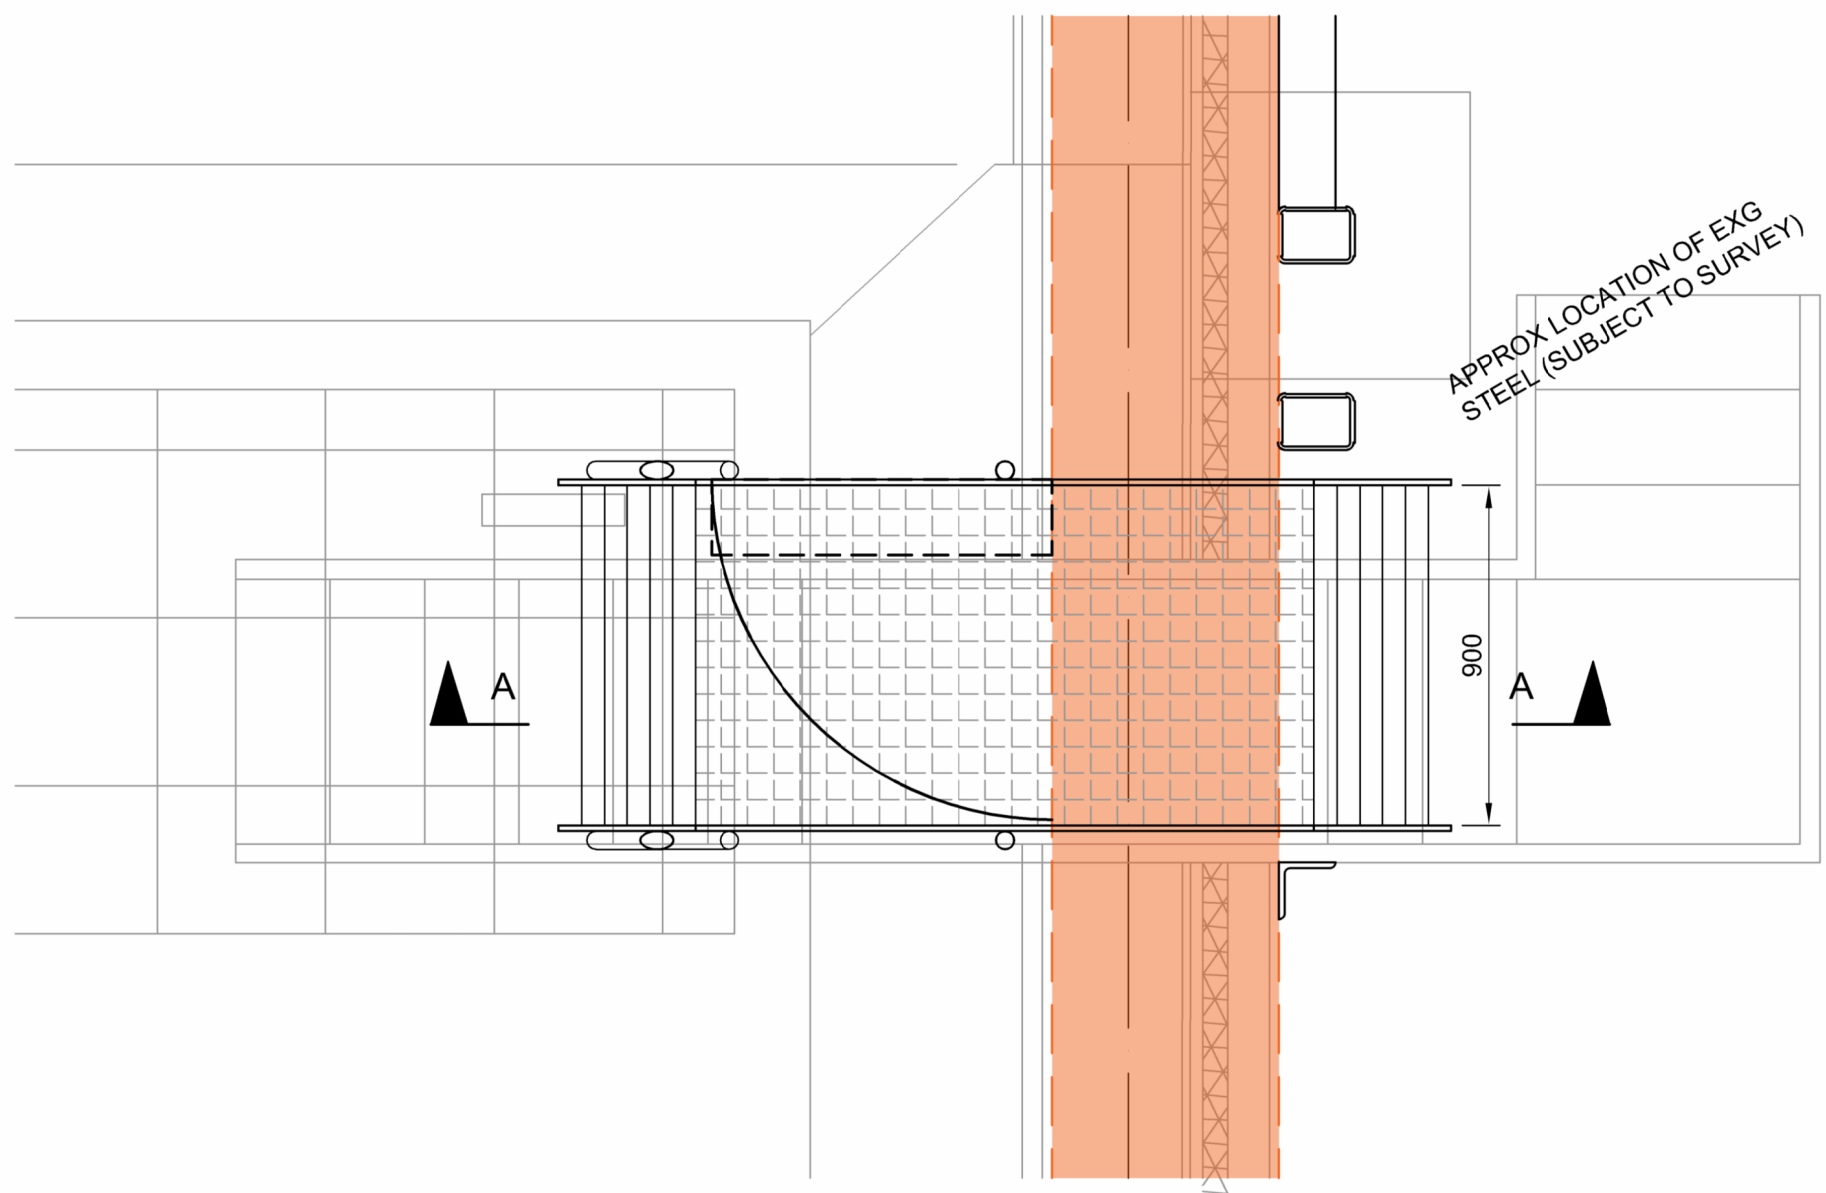

DETAIL 1 - ROOF ACCESS WALKWAY - PROPOSED
(SCALE 1:20)

ALL STEELWORK TO BE HOT-DIPPED GALVANISED

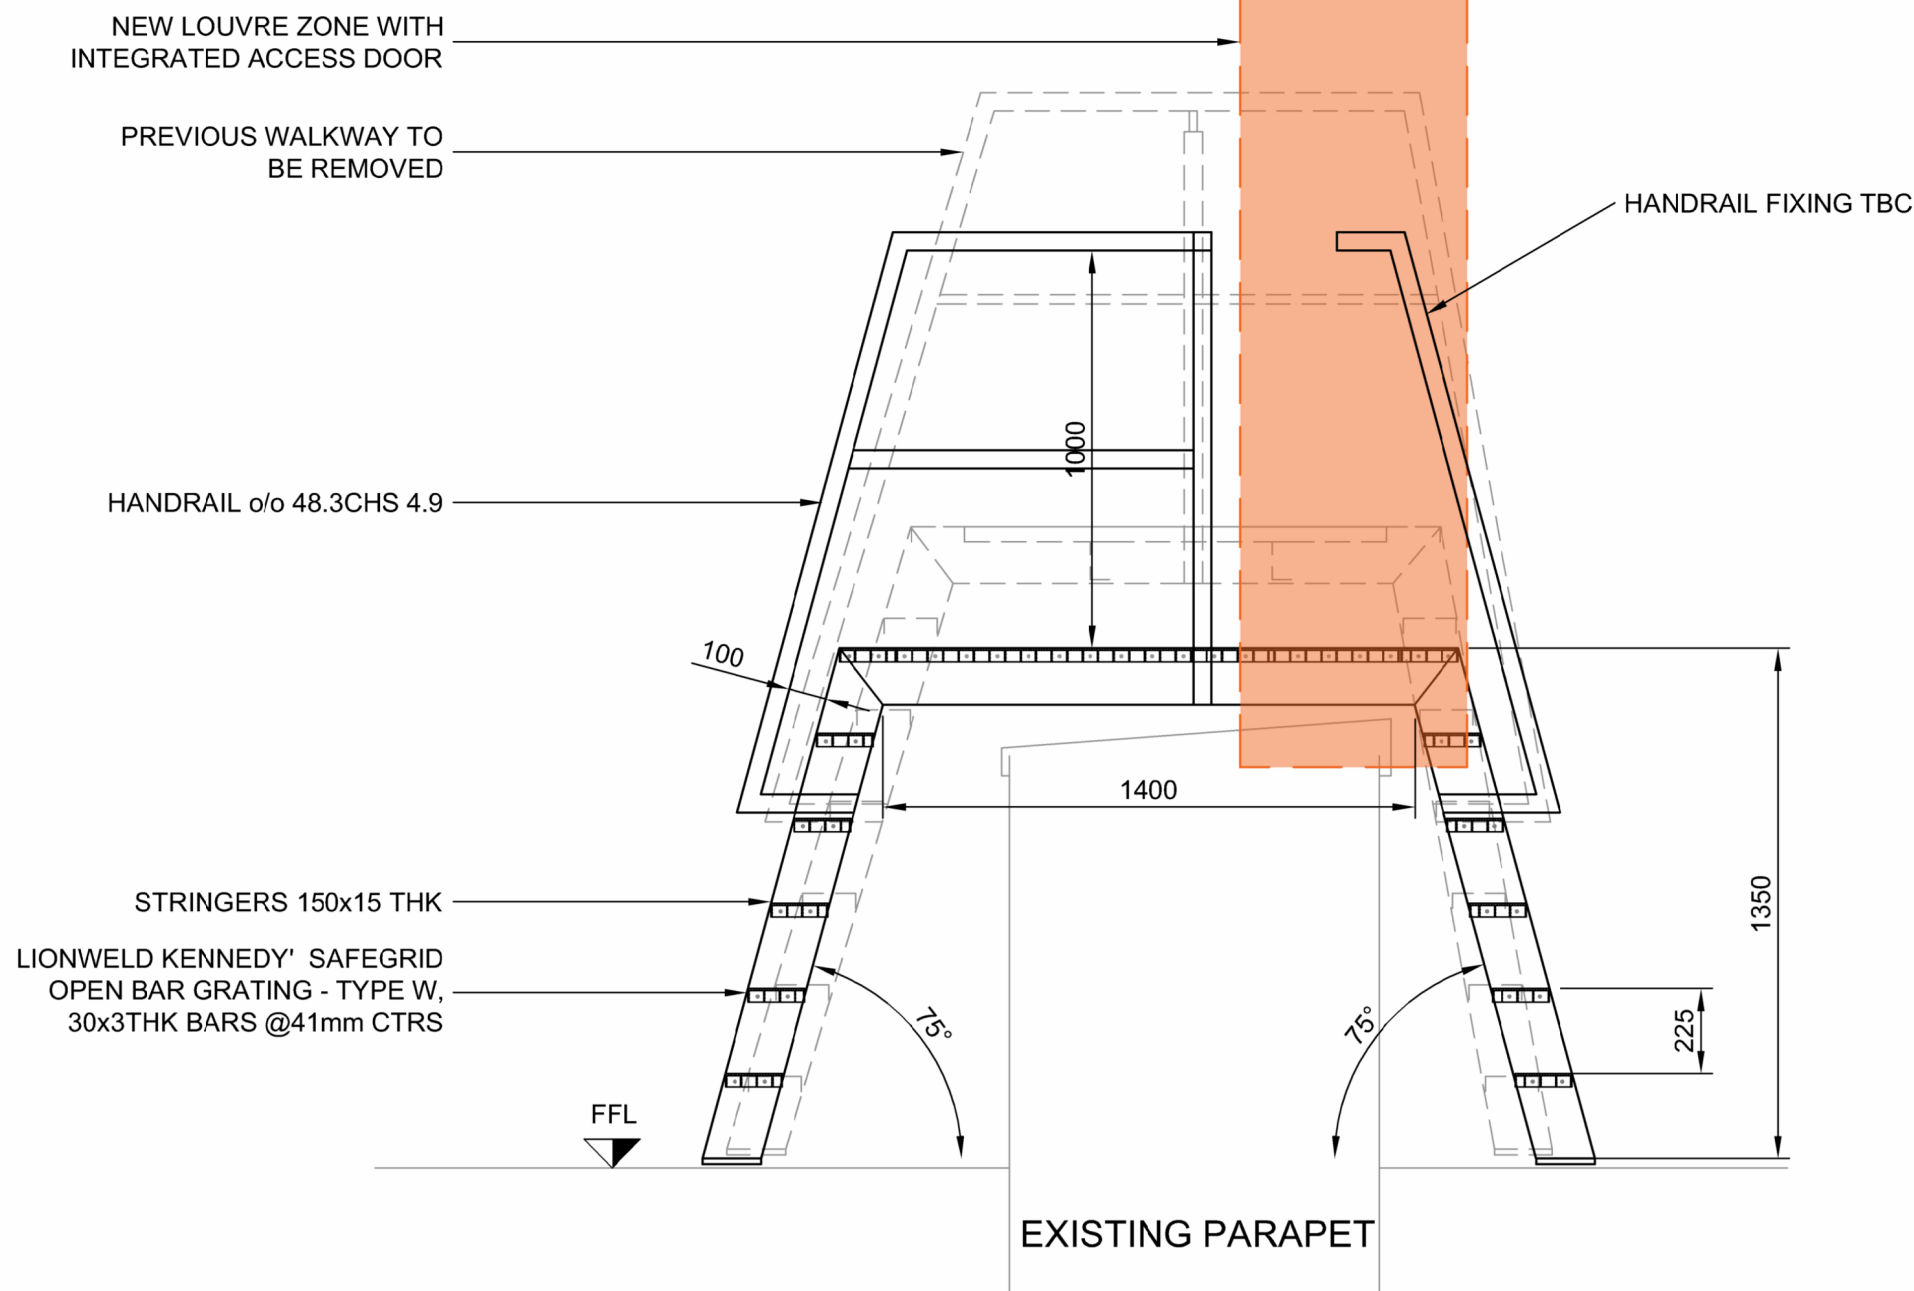

SECTION A
(SCALE 1:20)

NOTES

This drawing is copyright and owned by Marston and Grundy LLP, and is for use on this site only unless contractually stated otherwise.

DO NOT SCALE this drawing (printed or electronic versions). Contractors must check all dimensions from site.

All other design team elements, where indicated, have been imported from the consultant's drawings and reference should be made to the individual consultant's drawings for exact setting out, size and type of component.

Discrepancies and / or ambiguities within this drawing, between it and information given elsewhere, must be reported immediately to the architect for clarification before proceeding.

All works are to be carried out in accordance with the latest British Standards and Codes of Practice unless specifically directed otherwise in the specification.

Responsibility for the reproduction of this drawing in paper form, or if issued in electronic format, lies with the recipient to check that all information has been replicated in full and is correct when compared to the original paper or electronic Graphical representations of equipment on this drawing have been co-ordinated, but are approximations Please refer to the Specifications and / or Details for actual sizes and / or specific contractor construction information.

This original document is issued for the purpose indicated below and contains information of confidential nature. Further copies and circulation will be strictly in accordance with the confidentiality agreement under the contract. This original must be destroyed or returned to the contractor.

DRAWING STATUS

S0 = Work In Progress S1 = Co-Ordination S2 = Information
S3 = Review / Comment S4 = Approval D1 = Costing D2 = Tender
D3 = Contractor Design D4 = Construction FC = Final Construction

SAFETY, HEALTH AND ENVIRONMENTAL INFORMATION

IN ADDITION TO THE HAZARDS/RISKS NORMALLY ASSOCIATED WITH THE TYPES OF WORK DETAILED ON THIS DRAWING, NOTE THE FOLLOWING:

CONSTRUCTION

NO ABNORMAL RESIDUAL RISKS.

MAINTENANCE / CLEANING

NO ABNORMAL RESIDUAL RISKS.

DECOMMISSIONING / DEMOLITION

NO ABNORMAL RESIDUAL RISKS.

IT IS ASSUMED THAT ALL WORKS WILL BE CARRIED OUT BY A COMPETENT CONTRACTOR WORKING, WHERE APPROPRIATE, TO AN APPROVED METHOD STATEMENT

P1	ISSUED FOR INFORMATION	PJK	18.08.23	PK
Rev	Description	By	Date	Chkd
<div><div></div><div>Marston & Grundy LLP Consulting Engineers Priory House, Ellesmere Ave Marple, Stockport, Cheshire, SK6 7AN Telephone: 0161 427 7231 Email: mail@marstonandgrundy.com</div></div>				
Client EQUANS BUILDINGS LTD.				
Project ATTENUATED LOUVRES, MANCHESTER ROYAL INFIRMARY				
Drawing PROPOSED LOUVRES DETAILS - SHEET 1				
Purpose of Issue PRELIMINARY			Status S1	
Project No. 13820	Scale @ A1 1:125	Date JUL '23	Drawn PJK	Checked AMT
Drawing Identifier project origin zone level file type role number Rev 0114-MaG-Z3-RF-D4-S-11-501 P1				