


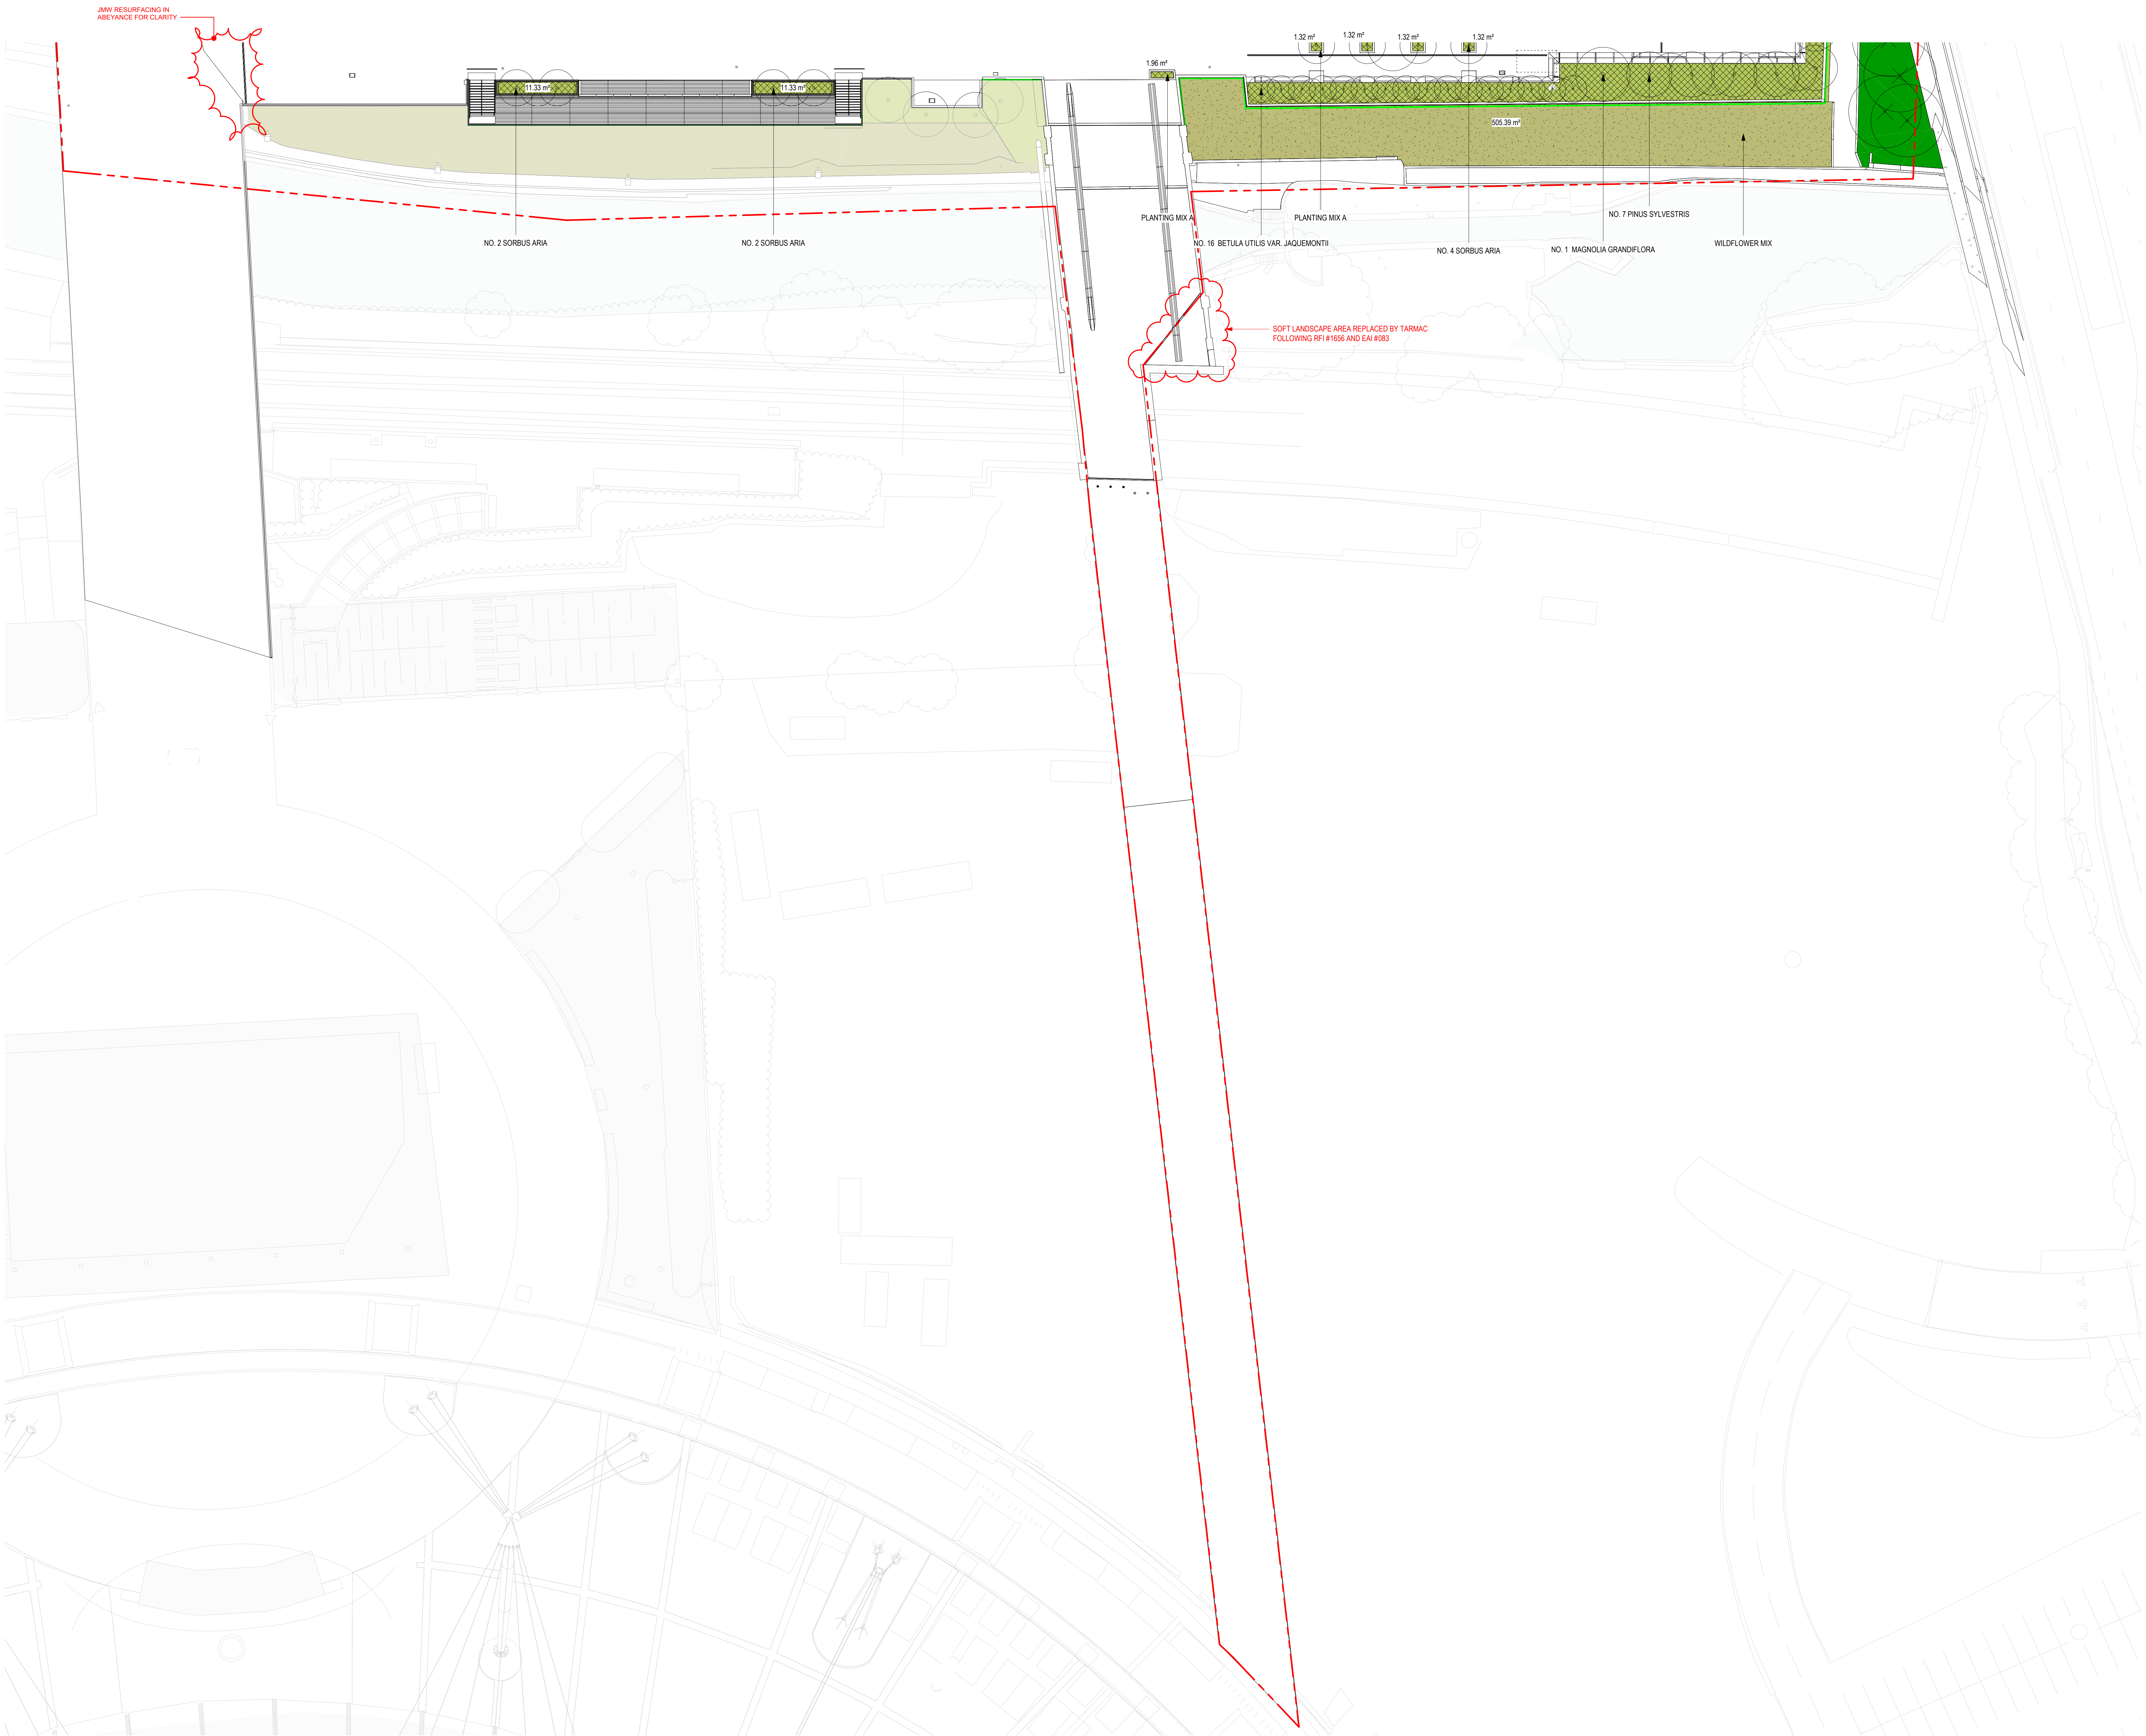

Suitability Code (as defined in ISO 19650-2:2018)

Work in Progress (WIP)

S0 - Initial Status

Shared (Non-Contractual)

S1 - Suitable for co-ordination

S2 - Suitable for information

S3 - Suitable for review & comment

S4 - Suitable for stage approval

S5 - Withdrawn

S6 - Suitable for RIM authorisation

S7 - Suitable for AIM authorisation

Published (Contractual)

A1, A2, A3, Etc - Authorised and accepted

B1, B2, B3, Etc - Partial sign-off (with comments)

Published (AIM Acceptance)

CR - As constructed record document

KEY PLAN

KEY

PROJECT BOUNDARY

EXISTING TREES TO BE REMOVED

EXISTING TREES TO BE RETAINED

EXT-561 PROPOSED TREES

EXT-565 PROPOSED SHRUB

EXT-568 PLANTING MIX A

EXT-568 PLANTING MIX B

EXT-568 PLANTING MIX C

EXT-571 WILDFLOWER MIX

EXISTING PLANTING

EXT-541 GREEN SCREEN

EXT-525 ROOT SPACE STRUCTURE

EXT-544 LIVING WALL

NOTES

FOR TREE PIT DETAILS REFER TO BRA-POP-ZZ-ZZ-DR-L-8401

FOR PLANTING DETAILS REFER TO BRA-POP-ZZ-ZZ-DR-L-8402

FOR GREEN SCREEN DETAILS REFER TO BRA-POP-ZZ-ZZ-DR-L-8403

FOR PLANTING SCHEDULE REFER TO BRA-POP-ZZ-ZZ-SHL-7801

THIS DRAWING IS ONLY TO SCALE IF IT IS

REPRODUCED AT THE CORRECT PAPER SIZE

1:250@A0

0 5 10 20

m

ALL INTERNAL LAYOUTS AND USES ARE SHOWN

FOR ILLUSTRATIVE PURPOSES ONLY AND ARE

NOT FOR DETERMINATION

drawn

OVG

INTERNATIONAL

© COPYRIGHT. ALL RIGHTS RESERVED

THIS WORK IS COPYRIGHT AND CANNOT BE REPRODUCED OR COPIED IN ANY FORM OR BY

ANY MEANS (ELECTRONIC, MECHANICAL, OR OTHERWISE), WITHOUT THE WRITTEN PERMISSION OF POPULOUS. ANY UNAUTHORIZED REPRODUCTION OR USE OF THIS DOCUMENT OR ANY PART THEREOF IS STRICTLY PROHIBITED.

TO USE THIS DOCUMENT OR ANY PART THEREOF IN ANY MANNER IS A BREACH OF THE AGREEMENT OR IMPLIED AGREEMENT BETWEEN POPULOUS AND THE INSTRUCTING PARTY.

USE FOR RED DIMENSIONS IN PREFERENCE TO SCALED. CHECK ALL DIMENSIONS ON SITE BEFORE FABRICATION OR SETTING OUT.

drawn

POPULOUS®

14 BLADES COURT | DEODAR ROAD | LONDON | SW15 2NU | UNITED KINGDOM

TELEPHONE +44 (0)20 8874 7666 FACSIMILE +44 (0)20 8874 7470

ALL PRODUCTION & INTELLECTUAL PROPERTY RIGHTS RESERVED © POPULOUS 2019

REVISIONS

REV DATE DESCRIPTION

00 30.10.2020 STAGE 4A - INCREASE IN SCOPE TO PLANNING

01 18.06.2021 STAGE 4B REVISSED TO INCORPORATE VE

001 02.12.2021 HARD LANDSCAPE PACKAGE FOR CONSTRUCTION

002 11.04.2022 LANDSCAPE UPDATE RFI #1656 AND EAI #583

project name

Co-op Live

the FLB AND CONNECTION PATH

SOFT LANDSCAPE PLAN

LEVEL 01

scale 1 : 250 @ A0

drawn FP

Project no.

4933

date 30.10.2020

checked TJ

drawn

revisions

BRA-POP-ZZ-01-DR-L-8144

C02