



DO NOT SCALE FROM DRAWING.
ALL DIMENSIONS & LEVELS TO BE CHECKED ON SITE BEFORE COMMENCING WORK AND ANY DISCREPANCIES TO BE NOTIFIED TO C.A. IMMEDIATELY.
IF IN DOUBT ASK?

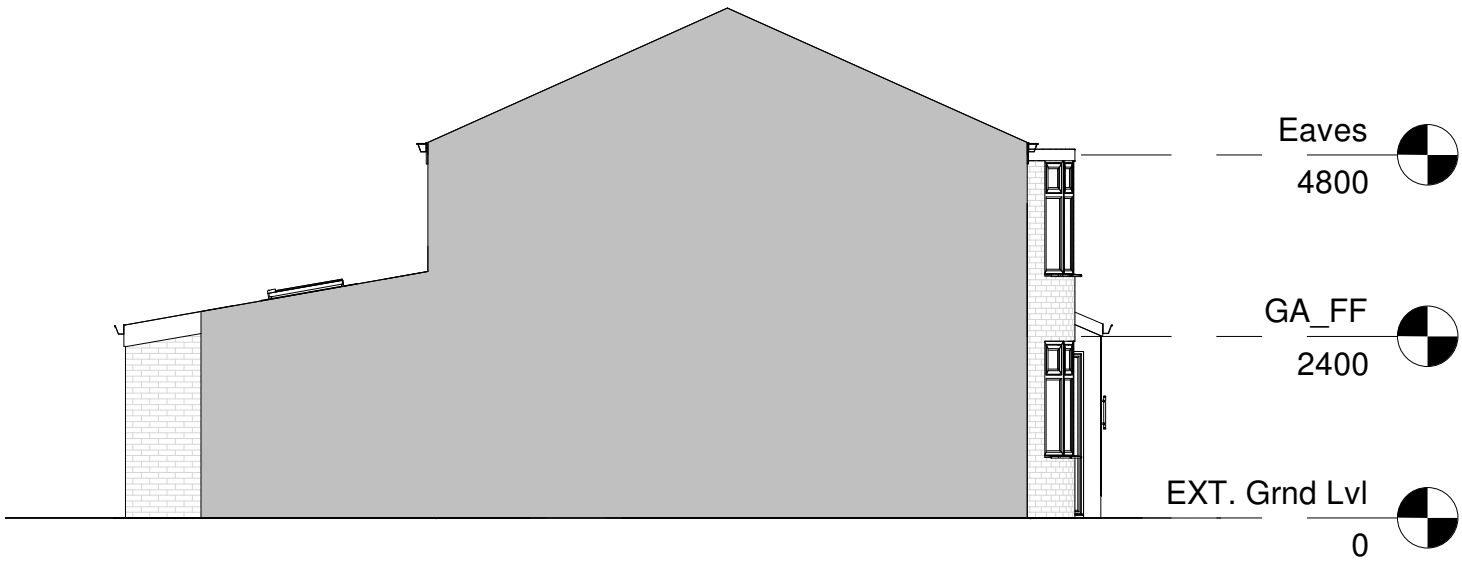


Proposed Elevation West
1 : 100

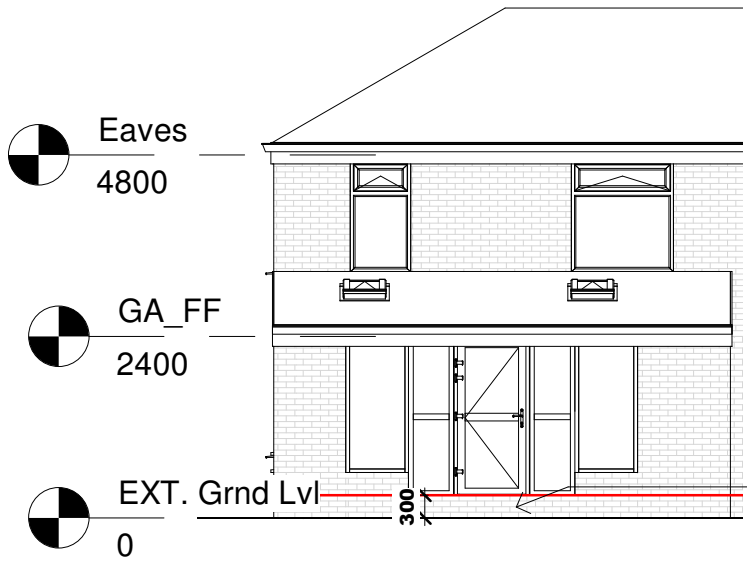

Proposed North Elevation
1 : 100

Note: Internal Proposed Floor level to match exisitng or be greater than 300mm above finished floor level.

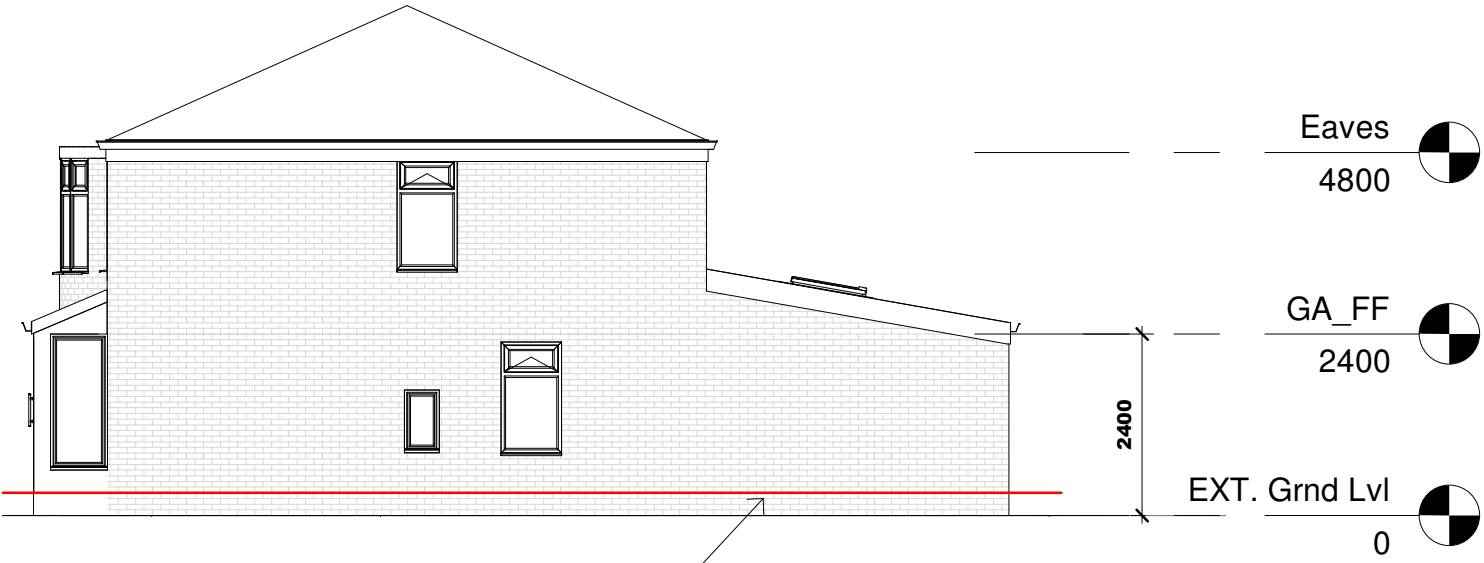

Proposed Elevation East
1 : 100

Key:
Red Line - Any weep vents laid higher than 300mm from external ground level.



Proposed South Elevation
1 : 100

NOTE!!
ANY CHANGES OR DEVIATIONS FROM THE APPROVED PLANS REQUIRED BY CLIENT/BUILDER TO BE SANCTIONED BY ALL RELEVANT LOCAL AUTHORITY DEPARTMENTS AND ENGINEERS TO REGAIN APPROVAL PRIOR TO ANY COMMENCEMENT OF WORK.
ALL SPECIFICATION AND DESIGNS ARE TO BE CHECKED AND APPROVED BY THE LOCAL PLANNING AUTHORITY AND RELEVANT BUILDING CONTROL DEPARTMENTS PRIOR TO THE COMMENCEMENT OF ANY WORKS.
IT IS THE CONTRACTOR/APPLICANT RESPONSIBILITY FOR RECTIFYING ANYTHING THAT HAS BEEN CARRIED OUT PRIOR TO ANY APPROVALS BEING GRANTED.
CONTRACTOR/BUILDER IS/ARE RESPONSIBLE TO SITE CHECK ALL DIMENSIONS AND LEVELS BEFORE STARTING WORK.
EXACT BOUNDARY POSITIONS TO BE IDENTIFIED PRIOR TO ANY SITE WORKS COMMENCING.
CONTRACTOR/BUILDER IS/ARE TO ENSURE THAT NO PERSONS/MATERIALS OR MACHINERY TO ENCROACH OVER ANY BOUNDARIES WITHOUT THE CORRECT WRITTEN CONSENT OF THE ADJOINING LAND/PROPERTY OWNERS.
PARTY WALL ACT 1996
IT IS THE RESPONSIBILITY OF THE APPLICANT TO NOTIFY THE ADJOINING PROPERTY OWNERS OF THEIR INTENTION TO BUILD ON, OR WITHIN 3 METRES OF THE BOUNDARY LINE UNDER THE ABOVE LEGISLATION. THIS SHOULD TAKE THE FORM OF A WRITTEN NOTICE, DETAILS OF WHICH CAN BE FOUND AT THE O.D.P.M. WEBSITE, OR FROM THE LOCAL AUTHORITY DEVELOPMENT CONTROL DEPARTMENT.

rev	comments	initials	date
 Anything PROPERTY 529 Wilbraham Road, Manchester, M21 0UE Telephone: 01614640323 Email: admin@anything-property.co.uk Web: www.anything-property.co.uk client / project / content Building Elevation rev date 12/06/2023 19:39:00 scale 1 : 100 sheet A3 project number / drawing number 105 purpose of issue Write here			