


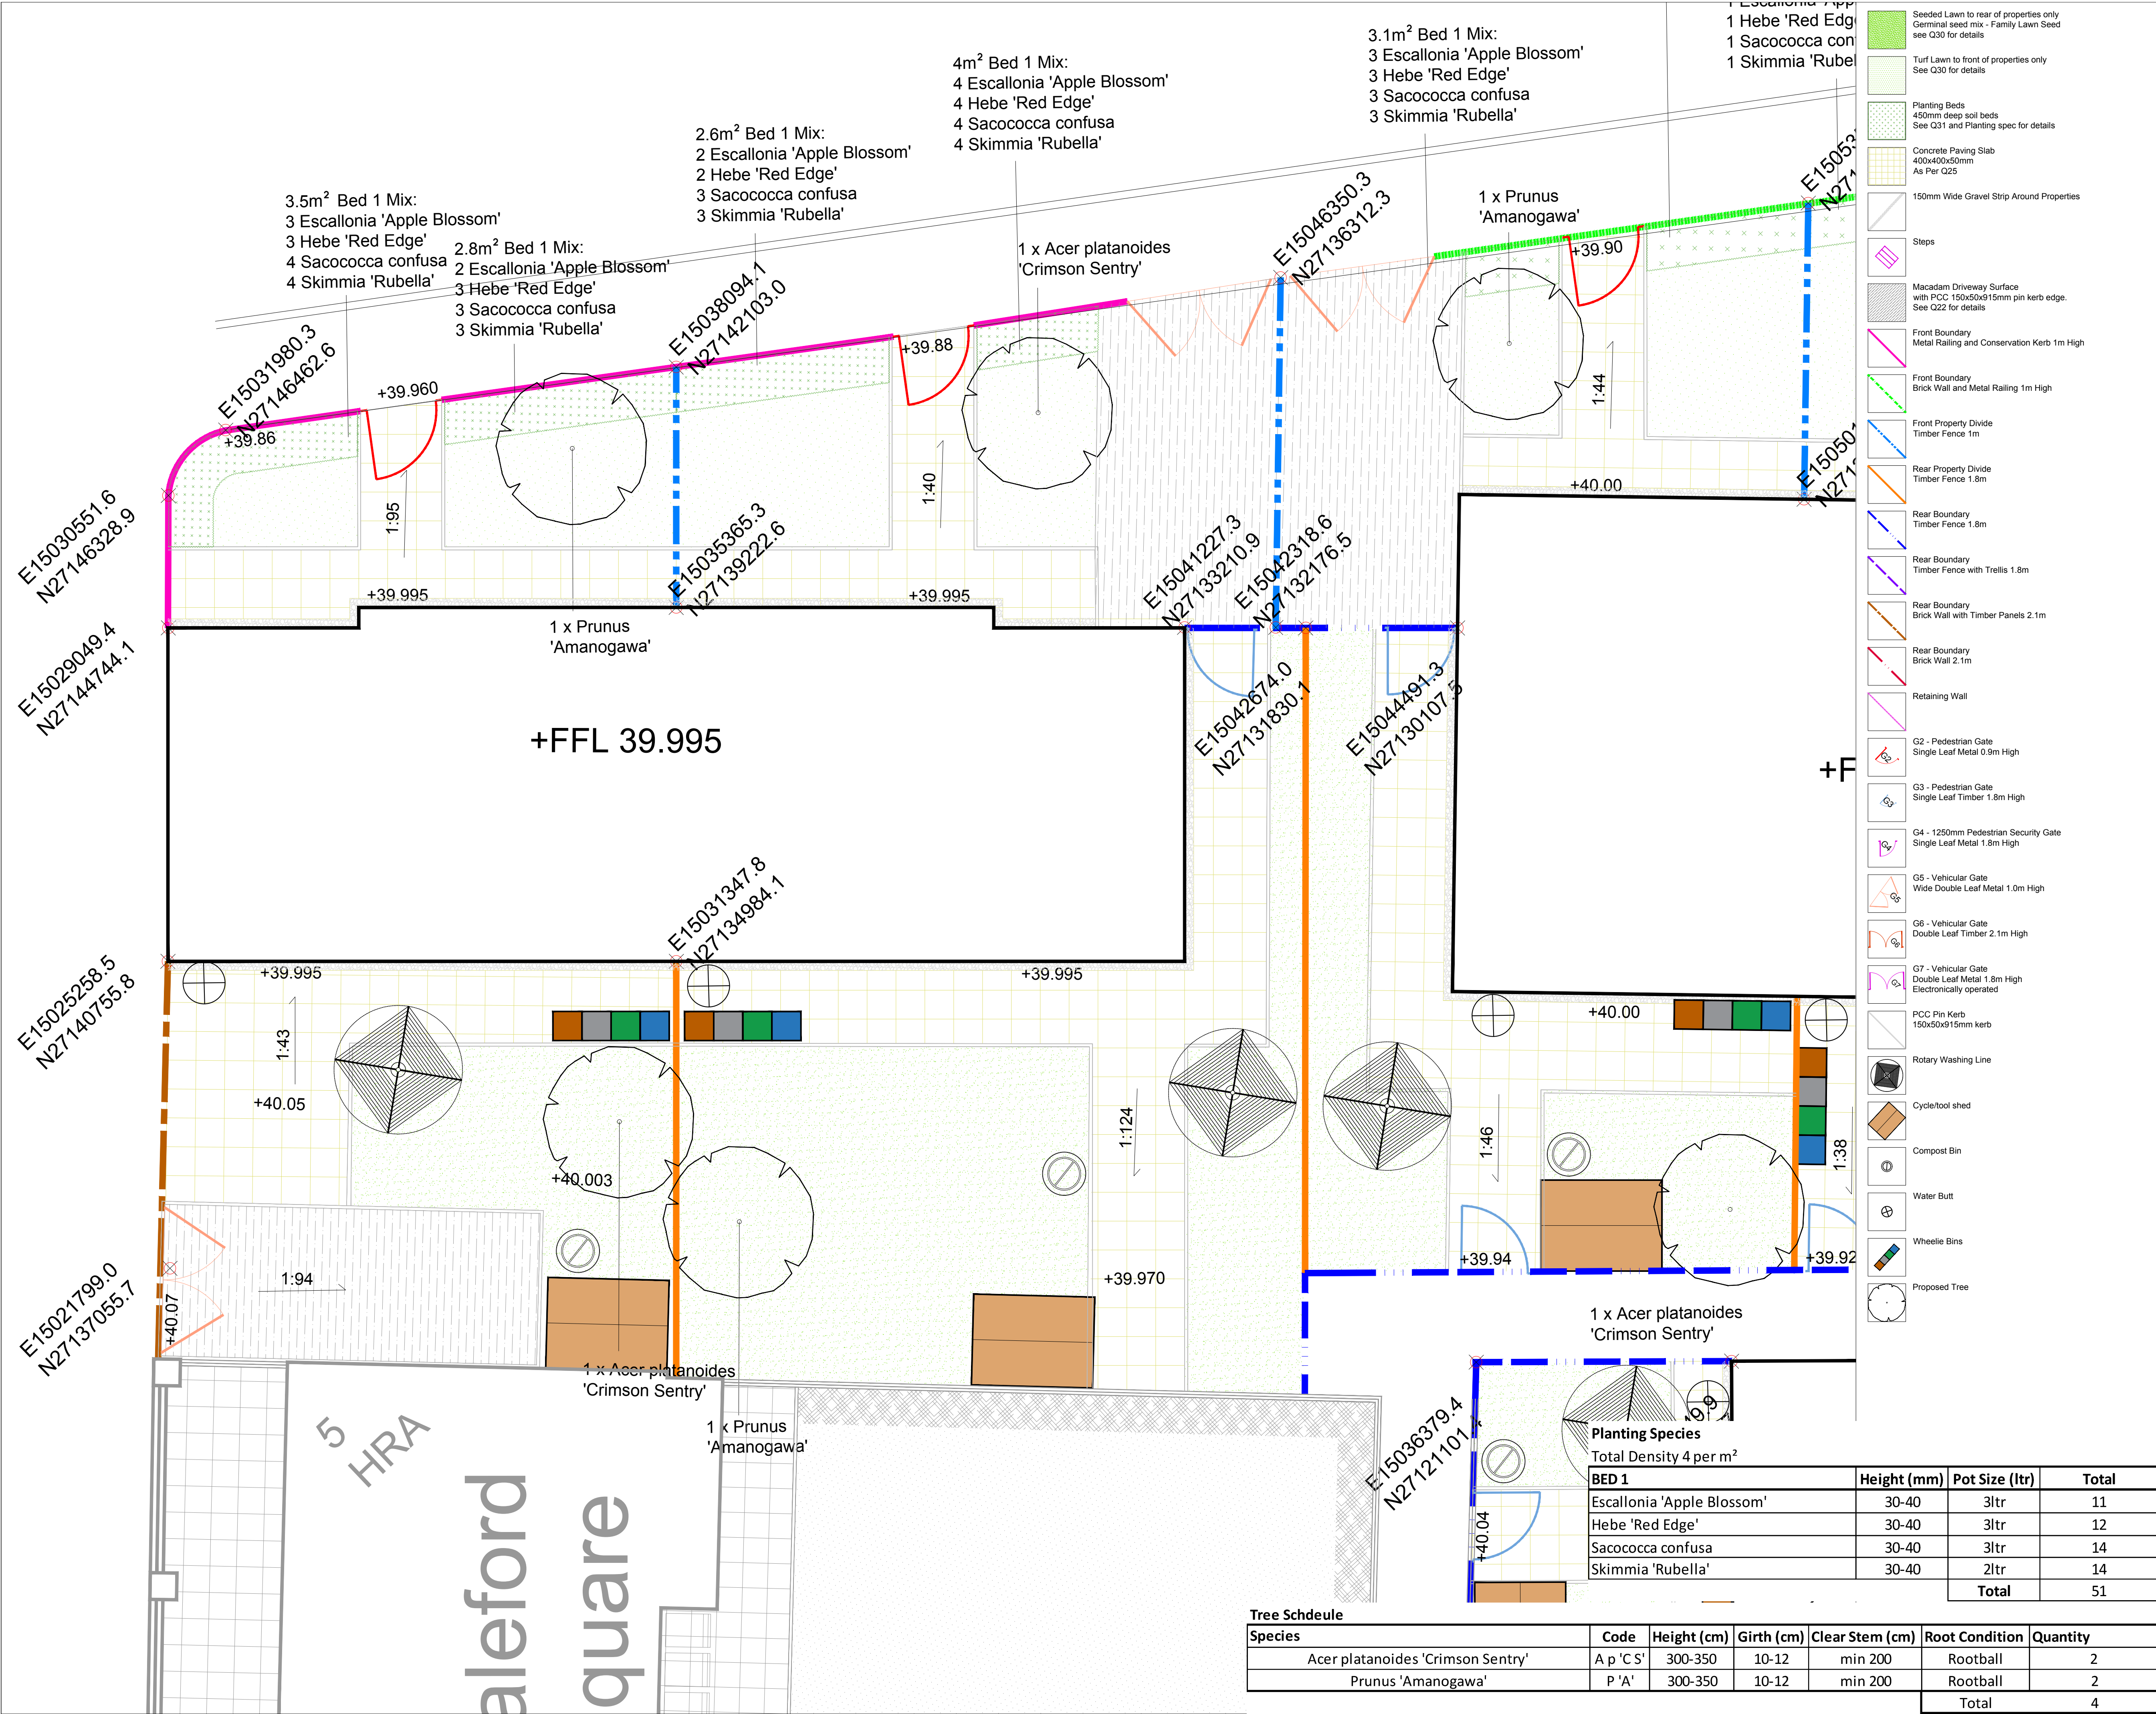

Do not scale from this drawing.
All dimensions should be checked on site.
Refer to architects for further information.

06	16.06.20	As Built	LB	WGC	JG
05	11.06.20	Measurements added	LB	WGC	JG
04	06.08.19	Key updated and gravel strip shown	LB	WGC	JG
03	24.04.19	Driveway added to plot 246	LB	WGC	JG
02	12.11.18	Updated Planting Plan	SK	WGC	JG
01	16.04.18	General amendments	JPF	WGC	JG
00	07.08.17	For Construction	DCS	WGC	JG
Rev	Date	Detail	Made	Chk'd	App'd

☐ PLANNING ☐ DRAFT ☐ FOR COMMENT ☐ TENDER ☒ CONSTRUCTION

Client:		GallifordTry	
Project:		Galliford Try Brunswick PFI	
Title:		Phase R General Arrangement	
Design: DCS		Sheet Size - A1 (594mm x 841mm)	
Drawn: DCS		Date: 08.03.18	
Chk'd: WC		Scale: 1:50	
App'd: JG			

GILLESPIES

GILLESPIES LLP
Westgate House
44 Hale Road
Hale
Cheshire
WA14 2EX
T: 0161 928 7715
F: 0161 927 7680
E: admin.manchester@gillespies.co.uk

File Location	R:\M4976 Brunswick PB Stage\DRAWINGS\Layouts	Rev	06
No.	M4976-164-R		

Tree Schedule						
Species	Code	Height (cm)	Girth (cm)	Clear Stem (cm)	Root Condition	Quantity
Acer platanoides 'Crimson Sentry'	A p 'C S'	300-350	10-12	min 200	Rootball	2
Prunus 'Amanogawa'	P 'A'	300-350	10-12	min 200	Rootball	2
Total						4

Planting Species			
Total Density 4 per m²			
BED 1	Height (mm)	Pot Size (ltr)	Total
Escallonia 'Apple Blossom'	30-40	3ltr	11
Hebe 'Red Edge'	30-40	3ltr	12
Sacococca confusa	30-40	3ltr	14
Skimmia 'Rubella'	30-40	2ltr	14
Total			51